

|              | 18:20 | 19:00 |
|--------------|-------|-------|
| 507A WELDING | 25    | X     |
|              | 225   | X     |
|              | 20    | X     |
|              | 25    | X     |
|              | 20    | X     |
|              | 25    | X     |

79-4803 2000

LABORATORY  
 EQUIPMENT  
 JAN 19 1987  
 Dr. Dennis DeGroot  
 PROJECT # 1333X

**FORM U-1A MANUFACTURER'S DATA REPORT FOR PRESSURE VESSELS**  
**(Alternative Form for Single Chamber, Completely Shop or Field Fabricated Vessels Only)**  
**As Required by the Provisions of the ASME Code Rules, Section VIII, Division 1**

1. Manufactured and certified by: Bota Welding, LLC 402 - 56<sup>th</sup> Street, Niagara Falls, NY 14304  
(Name and address of manufacturer)

2. Manufactured for: Thermal Kinetics Systems, LLC 667 Tift Street Buffalo, NY 14220  
(Name and address of purchaser)

3. Location of installation: Unknown  
(Name and address)

4. Type: Horizontal TP-4303 6018-MQ-4305 120 2007  
(Horiz. or vert. tank) (MW's serial No.) (CRN) (Drawing No.) (Next Id. No.) (Year built)

5. The chemical and physical properties of all parts meet the requirements of material specifications of the ASME BOILER AND PRESSURE VESSEL CODE The design, construction, and workmanship conform to ASME Rules, Section VIII, Div. 1  
Year

to 2005 ASME Code No.  
SA-240 TP-304L .188 0 3' 5-5/8" 5' 7-7/8"  
Year (Spec. No. Grade) Min. The (in.) Corr. Allow (in.) Diam. I.D. (ft. & in.) Length (overall) (ft. & in.)

7. Seams: Type 1 None N/A Type 1 None 1  
Long. (Welded, Del. Stagn., Lap, Butt) R.T. (Spot or Full) Eff. (%) Time (hr) Climb (Welded, Del. Stagn., Lap, Butt) R.T. (Spot or Full) or Full) No. of Courses

8. Heads: (a) Matl SA-240 TP-304L (b) Matl SA-240 TP-304L  
(Spec. No., Grade) (Spec. No., Grade)

| Location (Top, Bottom, Ends) | Minimum Thickness | Corrosion Allowance | Crown Radius | Knuckle Radius | Elliptical Ratio | Conical Apex Angle | Hemispherical Radius | Flat Diameter | Side to Pressure (Convex or Concave) |
|------------------------------|-------------------|---------------------|--------------|----------------|------------------|--------------------|----------------------|---------------|--------------------------------------|
| (a) Top                      | .125              | 0                   |              |                | 2:1              |                    |                      |               | Concave                              |
| (b) Bottom                   | .125              | 0                   |              |                | 2:1              |                    |                      |               | Concave                              |

If removable, bolts used (describe other fastenings)

9. MAWP 25 15 psi at max temp. 220 220 °F  
(internal) (external) (internal) (external)

Min. design metal temp. -20 °F at 25 psi. Hydro. pneu., or comb. test press. 32.5 psi

10. Nozzles, inspection, and safety valve openings:

| Purpose                | Diam. or Size | Type    | Matl           | Norm. Thk | Reinforcement Material | How Attached | Location   |
|------------------------|---------------|---------|----------------|-----------|------------------------|--------------|------------|
| (Inlet, Outlet, Drain) | 2             | C150Fg  | SA-312 TP-304L | .1450     | N/A                    | UW16.1⊙      | shell      |
| Overflow & Spare       | 3             | C150Fg  | SA-312 TP-304L | .2160     | N/A                    | UW16.1⊙      | head-shell |
| Leve & Spare           | 2             | C150Fg  | SA-312 TP-304L | .2800     | SA-240 TP-304L         | UW16.1⊙      | shell      |
| In let & Outlet        | 1             | studpad | SA-240 TP-304L | 2.000     | N/A                    | UW16.1⊙      | shell      |

11. Supports: Skirt \_\_\_\_\_ Lugs \_\_\_\_\_ (No.) \_\_\_\_\_ Legs \_\_\_\_\_ (No.) \_\_\_\_\_ Others 2 saddle Attached Welded  
(Where and how)

12. Remarks: Manufacturer's Partial Data Reports properly identified and signed by Commissioned Inspectors have been furnished for the following items of the report:

Impact Test Exempt Per UHA-51(d) UCS 66(G), Owner/User responsible for Pressure Relief Valve  
Cr seam 70% E. 2 Lifting Lugs welded to heads.

**CERTIFICATE OF SHOP/FIELD COMPLIANCE**

We certify that the statements made in this report are correct and that all details of design, material, construction and workmanship of this vessel conform to the ASME Code for Pressure Vessels, Section VIII, Division 1. U Certificate of Authorization No. 32004 Expires 7-26, 2009

Date 1/2/07 Co. Name Bota Welding, LLC Signed [Signature]  
(Manufacturer)

**CERTIFICATE OF SHOP/FIELD INSPECTION**





Vessel constructed by Bota Welding, LLC at 402 - 56<sup>th</sup> Street, Niagara Falls, NY 14304  
I, the undersigned, holding a valid commission issued by the National Board of Boiler and Pressure Vessel Inspectors and/or the State or Province of New York and employed by HSB CT

have inspected the component described in this Manufacturer's Data Report on 1/2/07 and state that, to the best of my knowledge and belief, the Manufacturer has constructed this pressure vessel in accordance with ASME Code, Section VIII, Division 1. By signing this certificate neither the inspector nor his employer makes any warranty, expressed or implied, concerning the pressure vessel described in this Manufacturer's Data Report. Furthermore, neither the inspector nor his employer shall be liable in any manner for any personal injury or property damage or a loss of any kind arising from or connected with this inspection.




Date 1/2/07 Signed [Signature] Commissions NB11103ANY5078

| NOZZ. | SERVICE             | SIZE | RATING | TYPE  | REMARKS    |
|-------|---------------------|------|--------|-------|------------|
| W1    | SIGHT GLASS 6" VIEW |      |        | W/PAD |            |
| N7    | FR EP4303           | 150# | 3"     | LJ    |            |
| N6    | TO ET-4301          | 150# | 1.5"   | LJ    |            |
| N5    | TO FC-4303          | 150# | 6"     | LJ    |            |
| N4    | FR PV-4301          | 150# | 1.5"   | LJ    |            |
| N3    | LIQUID INLET        | 6"   | 150#   | LJ    | FR ET-4301 |
| N2    | LEVEL TRANS. CONN.  | 3"   | 150#   | LJ    | LT-005     |
| N1    | LEVEL TRANS. CONN.  | 3"   | 150#   | LJ    | LT-005     |



NOTES:  
 1) ALL BOLT HOLES TO STRADDLE NATURAL CENTERLINES UNLESS NOTED OTHERWISE.  
 2) ALL STAINLESS STEEL TO BE 1 GRADE AND CERTIFIED. THERMAL KINETICS CLEANING AND BLASTING SPEC. GE-1,8.0 CLASS ]  
 3) FOR ALL INTERIOR AND EXTERIOR SURFACES SEE THERMAL KINETICS CLEANING AND BLASTING SPEC. GE-1,8.0 CLASS ]  
 4) ALL TOLERANCES PER ASME PRESSURE VESSEL CODE LATEST EDITION, SECTION VIII, DIVISION 1  
 5) WIND 80 MPH, EXP. C WVF = 1.0  
 6) ALL FILLET WELDS TO BE 3/16" UNLESS NOTED

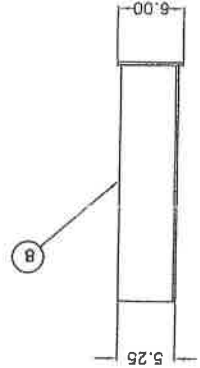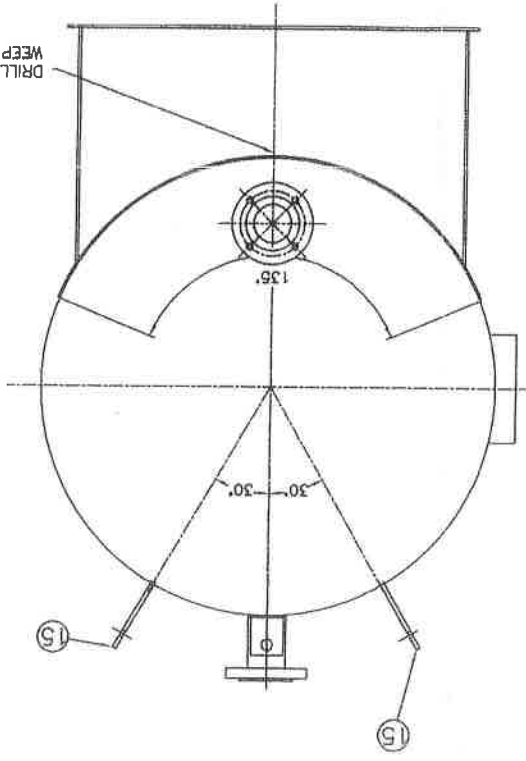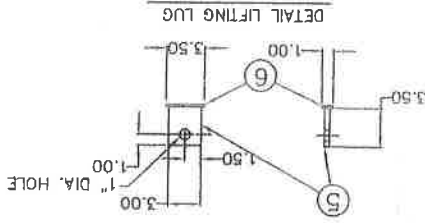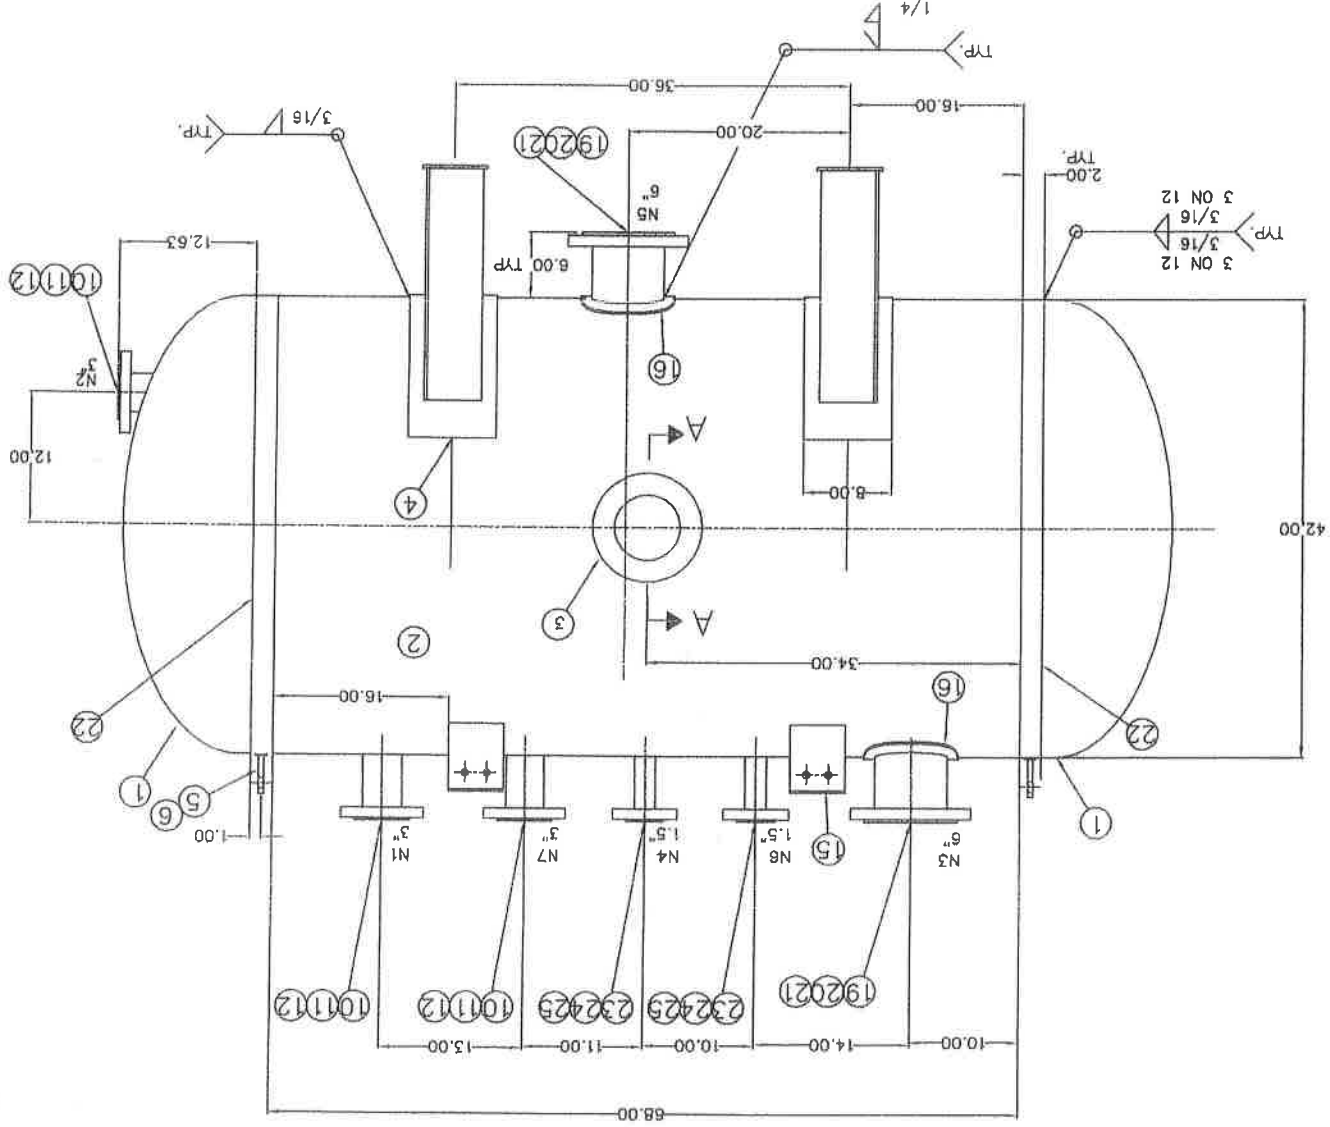

SECTION A-A

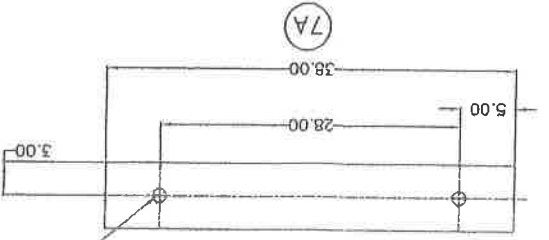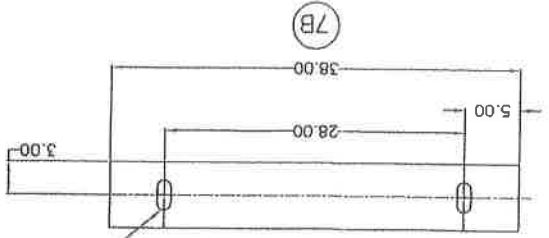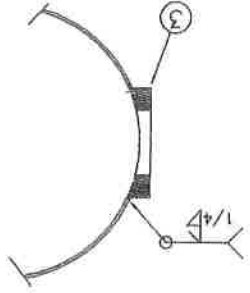

⑤ FIRE PROTECTION CLIP

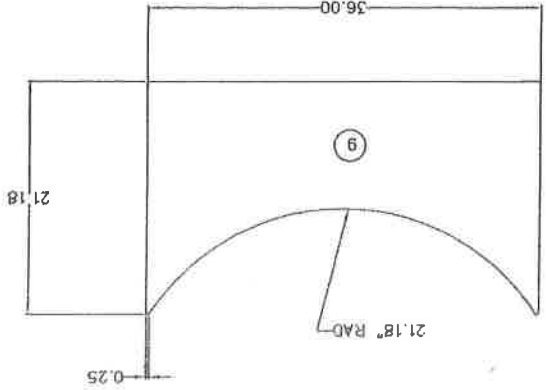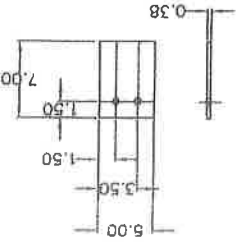

DESIGN DATA

|   |
|---|
| CODE: ASME VIII DIVI STAMPED AND REGISTERED |
| SPECIFIC GRAVITY/CONTENTS: 0.838            |
| DESIGN PRESS. 25/FV (psig)                  |
| DESIGN TEMP.: 220 (F)                       |
| OPERATING PRESS.: 2.0 (psig)                |
| OPERATING TEMP.: 120 (F)                    |
| MDMT: -20 DEG. F                            |
| CORROSION ALLOWANCE: NONE                   |
| HYDRAULIC TEST PRESSURE: 32.5 PSI           |

AS BUILT DRAWING

**BOTA WELDING**  
 Customer: THERMAL-KINETICS  
 FABRICATION  
 EQUIPMENT # TP-4303

|       |            |                |
|-------|------------|----------------|
| SIZE  | Dwg Number | D 6018-MQ-4305 |
| Sheet | Cont. On   | 2              |
| Rev   | Plot Scale | 10             |









|  |
|--|
| UNLESS OTHERWISE NOTED, ALL MACHINE SURFACES TO HAVE 125 RMS FINISH. |
| TOLERANCES ARE:  |
| FINISHES:  |
| FRACTIONS: $\pm 1/16"$   |
| DECIMALS: $\pm 0.03$   |
| INSTR. APPR.:  |
| PIPING APPR.:  |

| UNLESS OTHERWISE NOTED | REVISIONS |
|------------------------|-----------|
| REV                    | BY DATE   |
| DESCRIPTION            |           |

| NOZZ | SERVICE             | SIZE | RATING | TYPE  | REMARKS    |
|------|---------------------|------|--------|-------|------------|
| W1   | SIGHT GLASS 6" VIEW |      |        | W/PAD |            |
| N7   | FR EP4303           | 3"   | 150#   | LJ    |            |
| N6   | TO ET-4301          | 1.5" | 150#   | LJ    |            |
| N5   | OUTLET              | 6"   | 150#   | LJ    | TO PC-4303 |
| N4   | OVERFLOW            | 1.5" | 150#   | LJ    | FR PV-4301 |
| N3   | LIQUID INLET        | 6"   | 150#   | LJ    | FR ET-4301 |
| N2   | LEVEL TRANS. CONN.  | 3"   | 150#   | LJ    | LT-005     |
| N1   | LEVEL TRANS. CONN.  | 3"   | 150#   | LJ    | LT-005     |

NOTES:

- 1) ALL BOLT HOLES TO STRADDLE NATURAL CENTERLINES UNLESS NOTED OTHERWISE.
- 2) ALL STAINLESS STEEL TO BE L GRADE AND CERTIFIED.
- 3) FOR ALL INTERIOR AND EXTERIOR SURFACES SEE THERMAL KINETICS CLEANING AND BLASTING SPEC.
- 4) ALL TOLERANCES PER ASME PRESSURE VESSEL CODE GE-1.8.0 CLASS.
- 5) WIND 80 MPH, EXP. C WIF = 1.0
- 6) ALL FILLET WELDS TO BE 3/16" UNLESS NOTED.

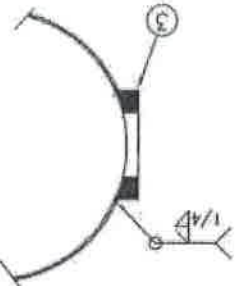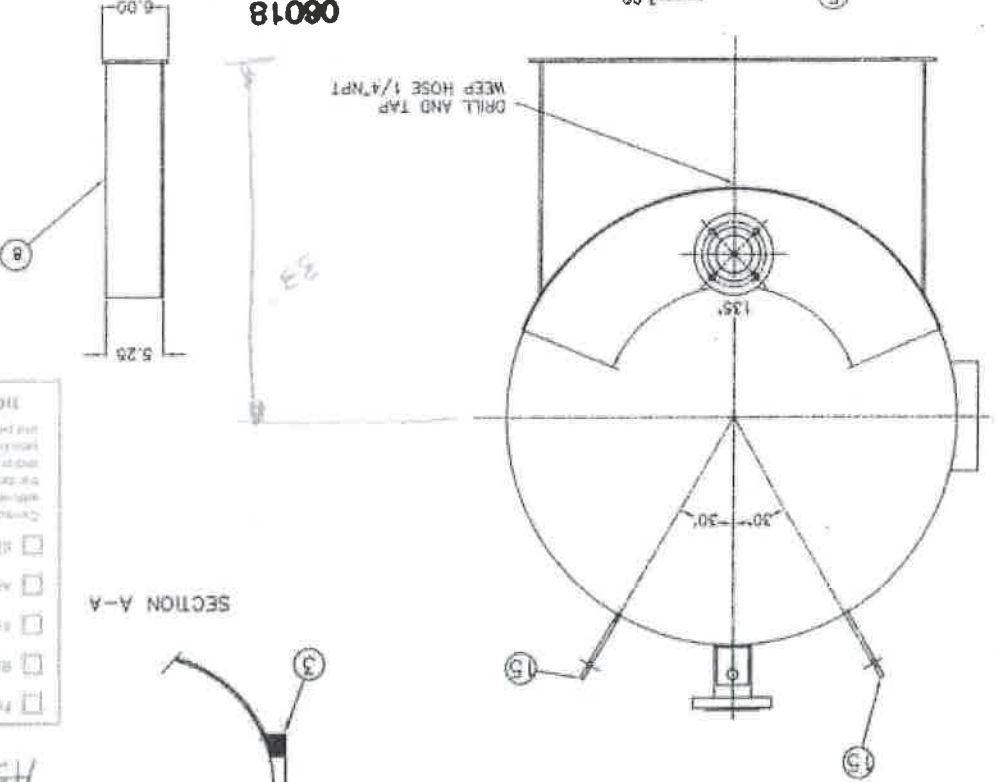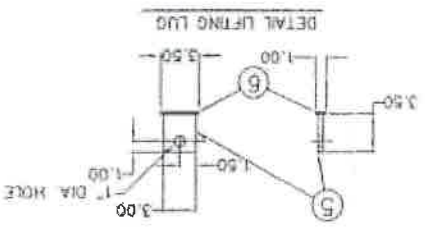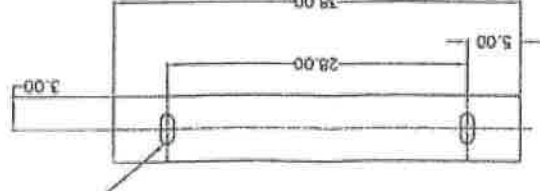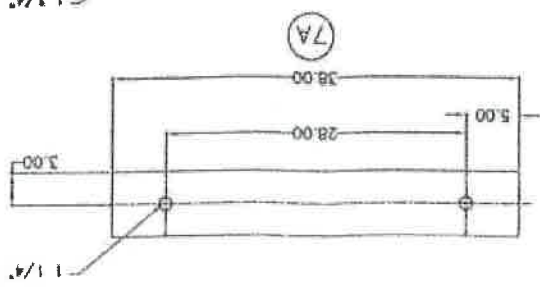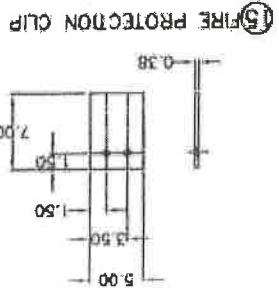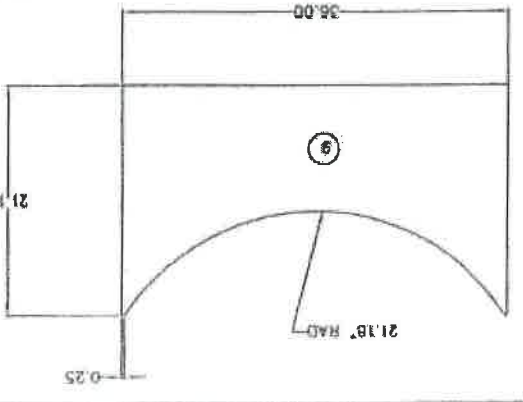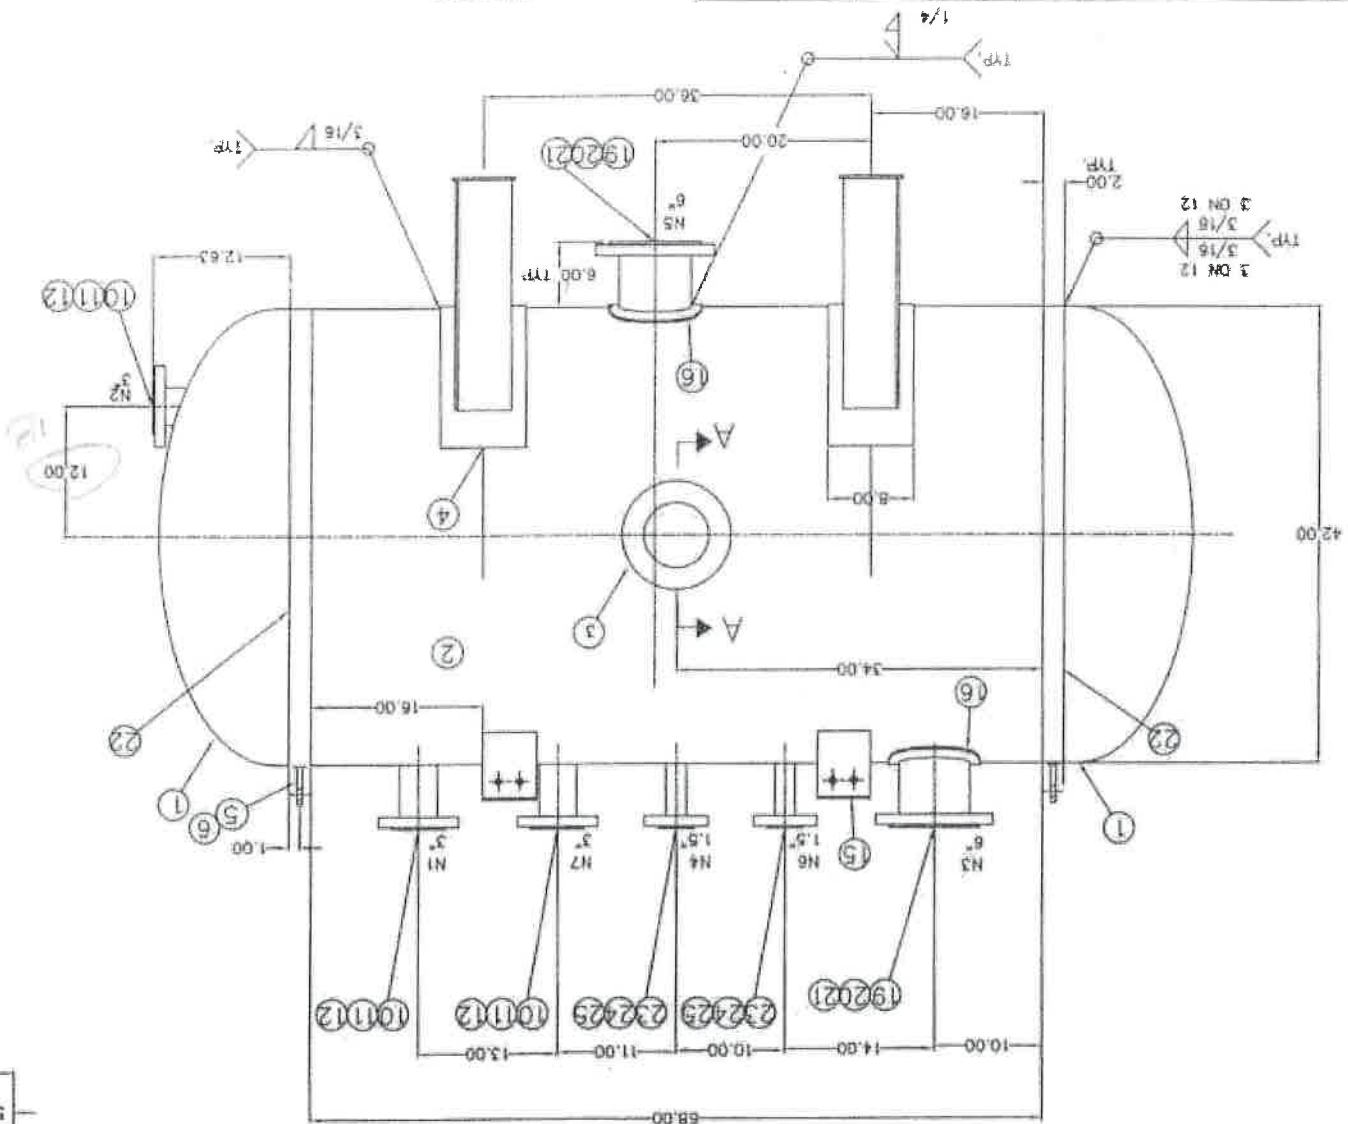

| REV | BY | DATE | DESCRIPTION |
|-----|----|------|-------------|
|     |    |      |             |

CHECKED BY: [Signature]  
 DRAWN BY: [Signature]  
 DATE: 8/28/06  
 PROJECT: 0180002099  
 EQUIPMENT # TP-4303  
 FABRICATION  
 THERMAL-KINETICS  
 BOTTA WELDING

06018  
 CIE: ETHANOL  
 Canton, Illinois  
 05.22.07  
 Page 17.11724303  
 0180002099

THERMAL-KINETICS SYSTEMS, LLC  
 RECEIVED  
 PROJECT # 132338

| DESIGN DATA                                 |
|---|
| CODE: ASME VIII DIVI STAMPED AND REGISTERED |
| SPECIFIC GRAVITY/CONTENTS: 0.838            |
| DESIGN PRESS. 25/FV (psig)                  |
| DESIGN TEMP: 220 (F)                        |
| OPERATING PRESS: 2.0 (psig)                 |
| OPERATING TEMP: 120 (F)                     |
| MDMT: -20 DEG. F                            |
| CORROSION ALLOWANCE: NONE                   |

As built dugs. Received 8/24/06

**FIELD FILE**