
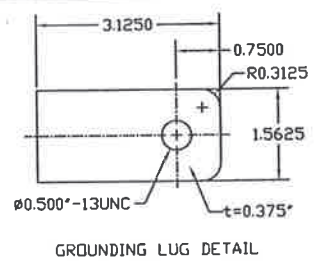
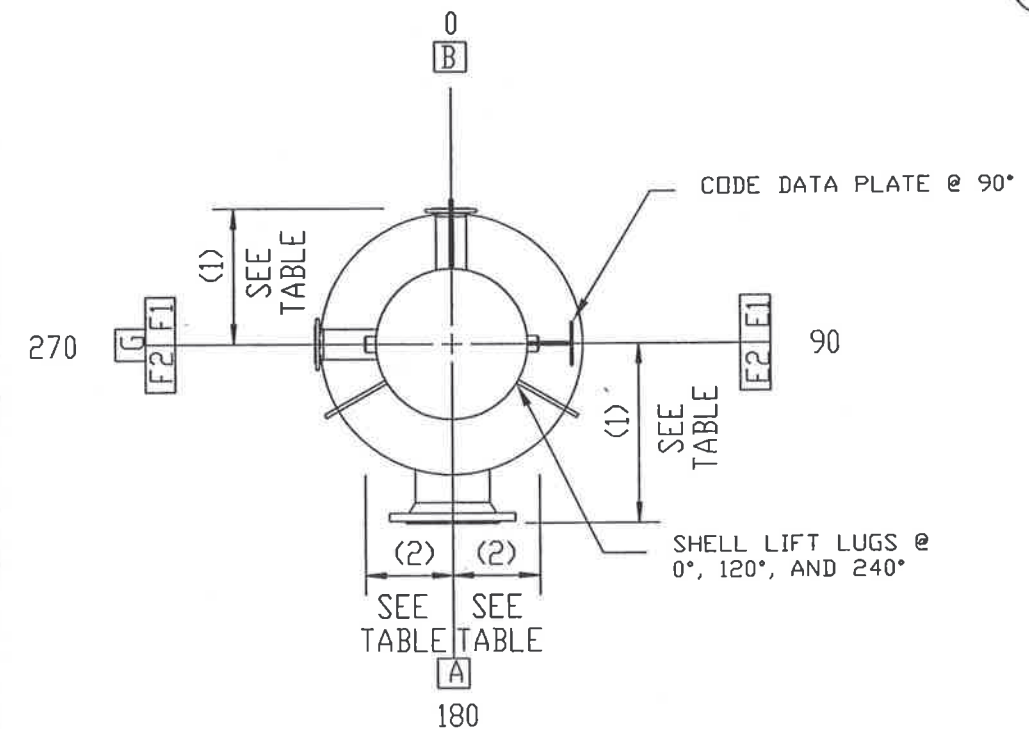
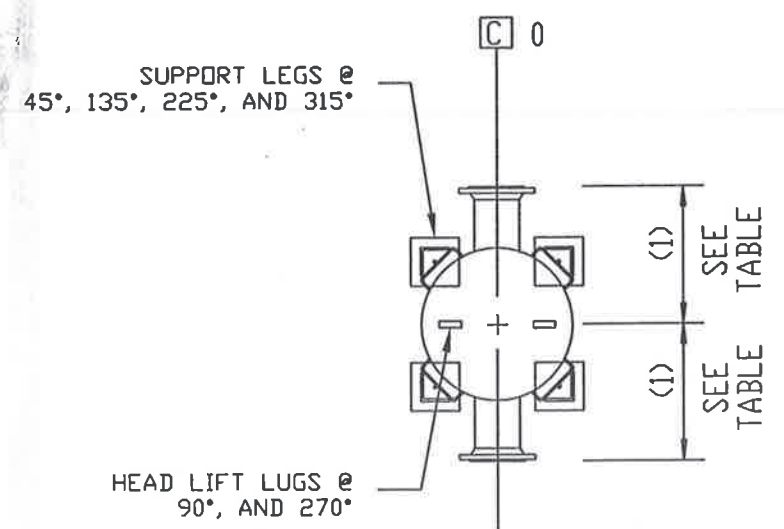


Dimensions: in

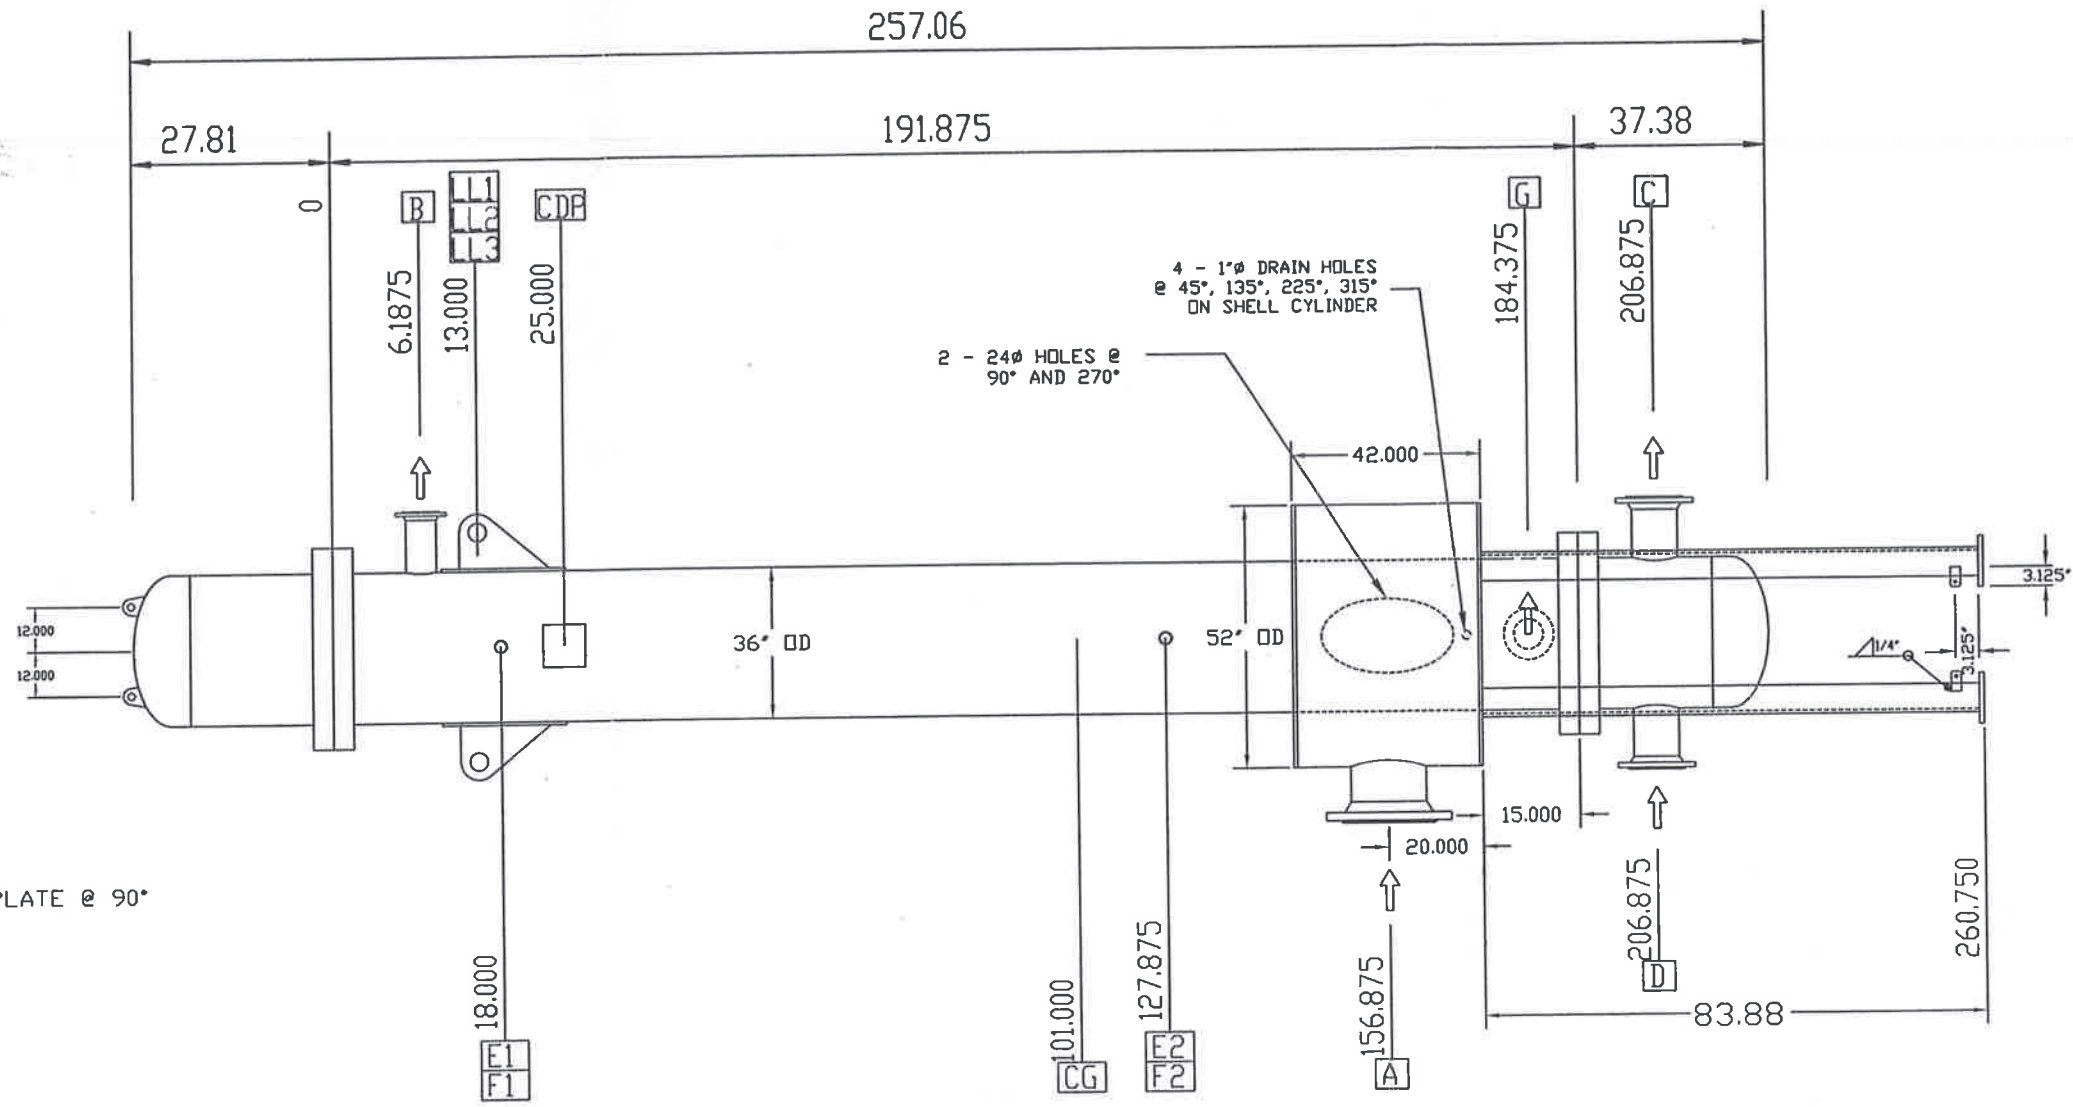

HT/DCR
Engineering, Inc.

This drawing contains intellectual property of HT/DCR Engineering, Inc. All ideas, designs, arrangements and know-how remain the property of HT/DCR Engineering, Inc. Any use of this information by entities other than the title block named entity is prohibited. Use of this drawing by the title block named entity is limited to the specific title block named project. Use on other projects is strictly prohibited.

2830 Parkway Street • Lakeland, FL 33811
Phone: 863-964-2800 • Fax: 863-913-1951
Florida Engineering Business License No. 20522

Company: DCR
Location: Bunge-Ergon
Product Condenser
Item No: E-4401
Date: February 26, 2007 Job No: 7793


DCR Construction, Inc.
Lakeland, Florida

Nozzles (1)			Couplings / Supports (2)			Design Specifications		Shell	Tube	
Label	Size:	Description	Project.	Label	Size: Description	Project.	Design Pressure	75/FV	150/FV	
A	24"	150 # ANSI S.D.R.F	32	E1	0.5 3000 # Half Length	18.9375	Test Pressure	98	195	
B	2"	150 # ANSI S.D.R.F	24	E2	0.5 3000 # Half Length	18.9375	Min. Design Temperature F	-20	-20	
C	10"	150 # ANSI S.D.R.F	24	F1	0.75 3000 # Half Length	19	Max. Design Temperature F	300	300	
D	10"	150 # ANSI S.D.R.F	24	F2	0.75 3000 # Half Length	19	Number of Passes	1	4	
G	6"	150 # ANSI S.D.R.F	24	LL1	Lifting Lug 1	22.5 To Hole	Corrosion Allowance	0.0	0.0625	
				LL2	Lifting Lug 2	22.5 To Hole	Radiographing	None	None	
				LL3	Lifting Lug 3	22.5 To Hole	Post-Weld Heat Treatment	None	None	
							Wt Empty: 13911 Full: 22005 Bundle: 8881 lb			
							Rev: 2 Date: 12-04-07 Description: Certified As-Built	Dwg: AGB	Ckd: DGB	Appd: PW

ASME VIII-1 2004 A06
TEMA Type: BEM
Size: 35-192
TEMA Class: C

Setting Plan
Dwg No: E-4401 01
Rev: 2

All Dimensions
In Inches

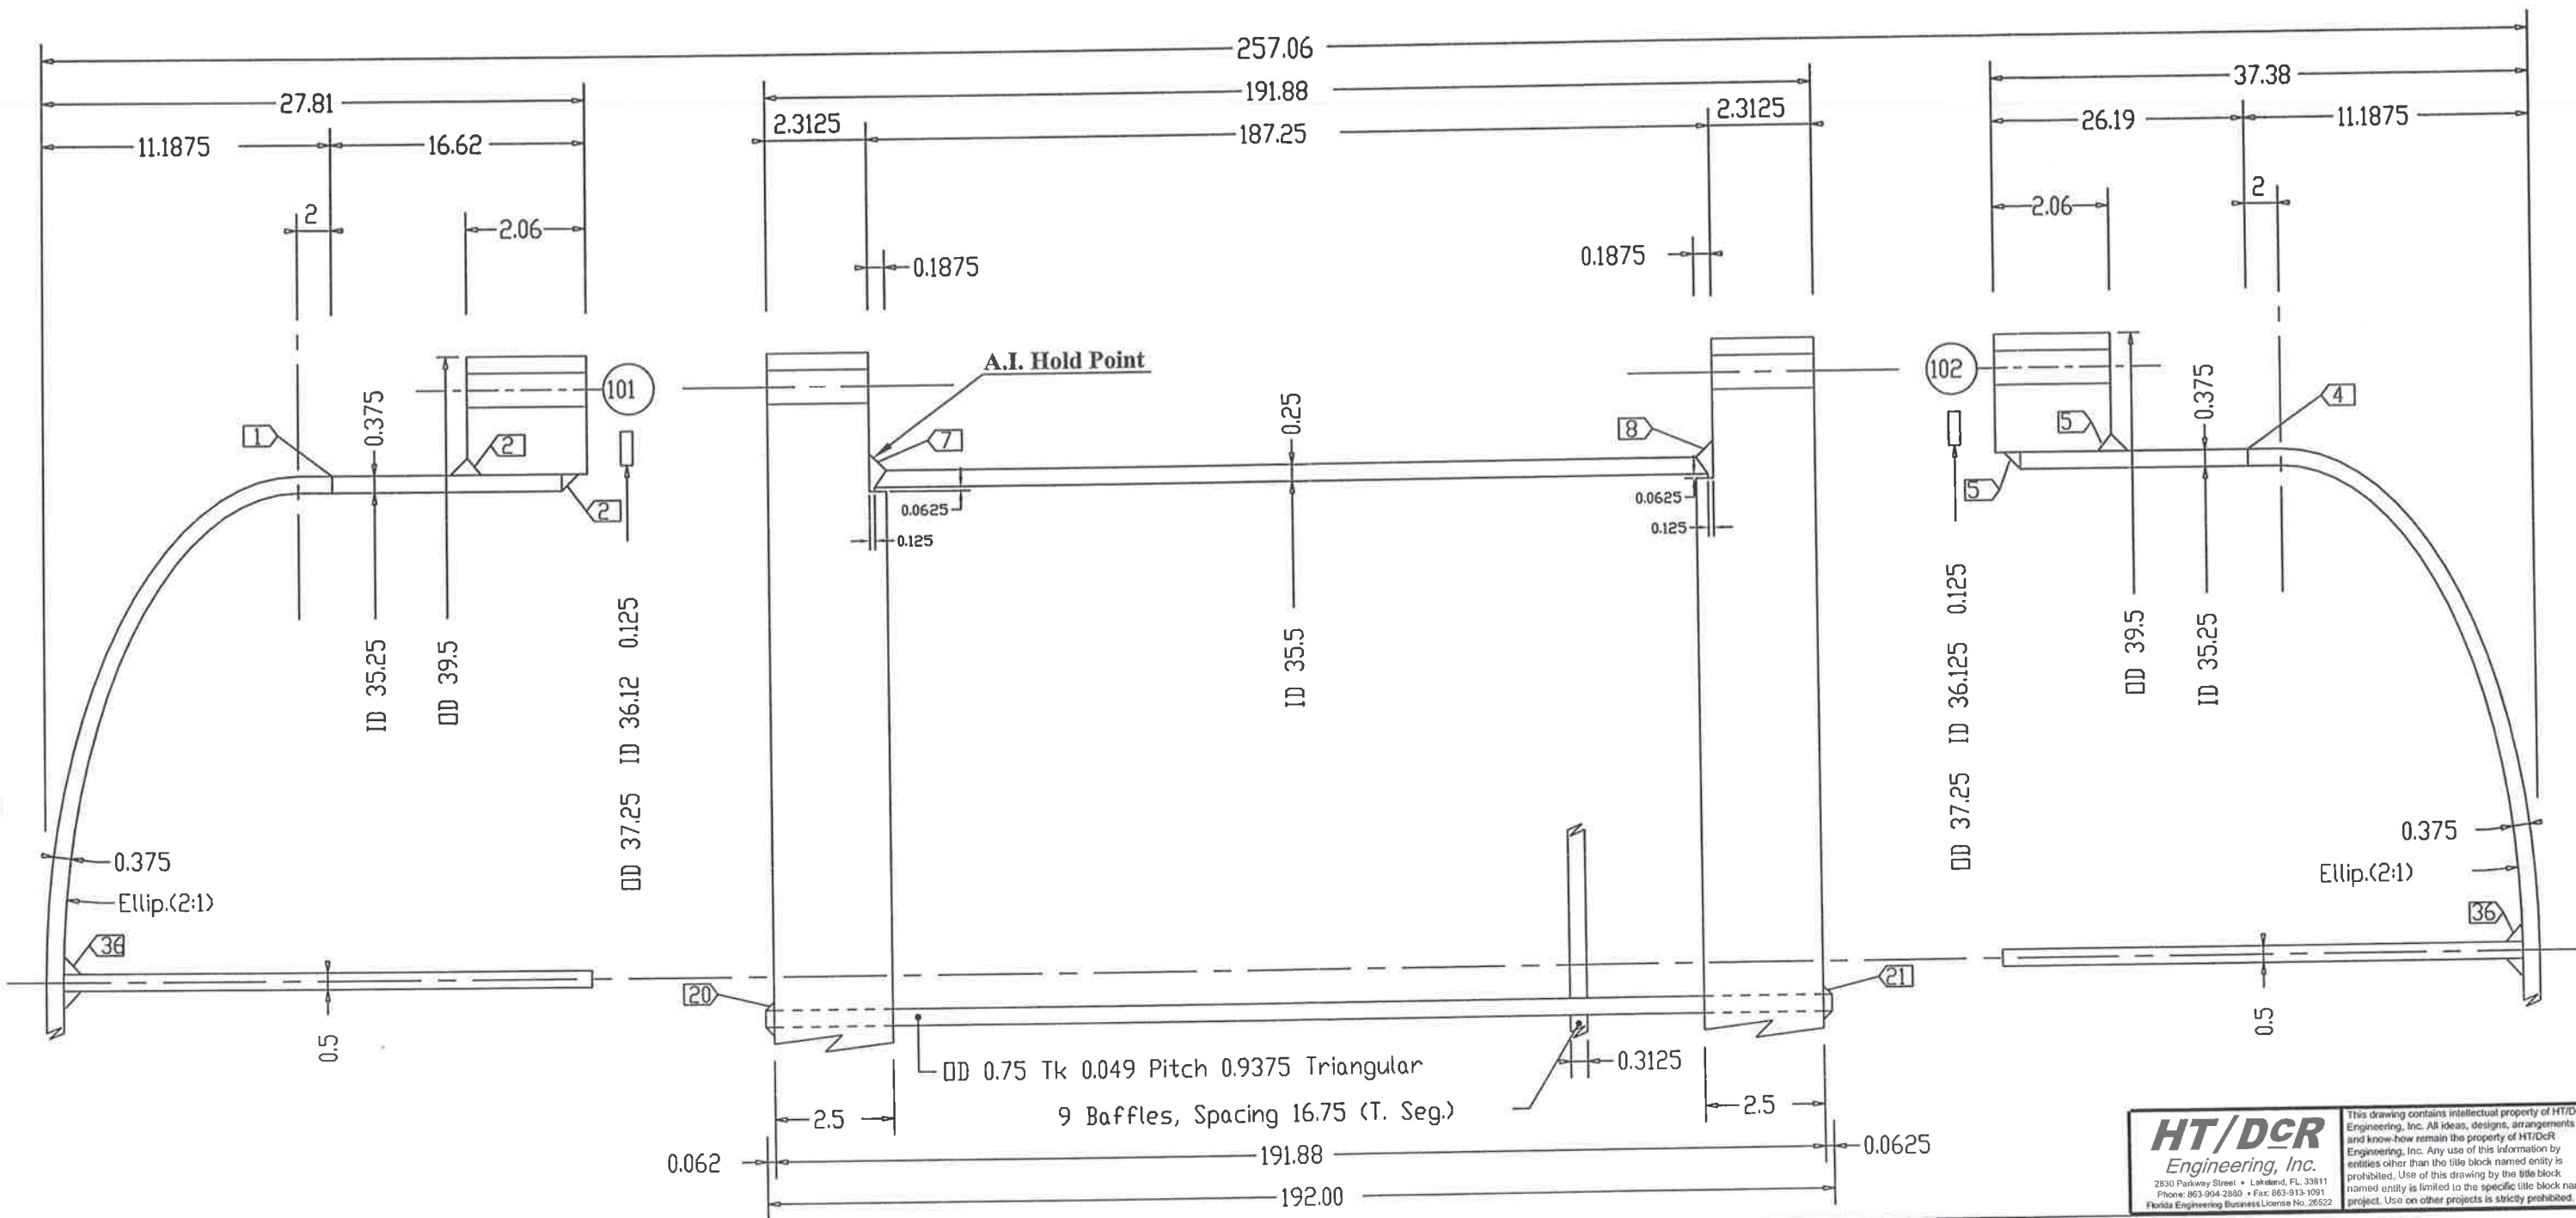

HT/DCR Engineering, Inc.	This drawing contains intellectual property of HT/DCR Engineering, Inc. All ideas, designs, arrangements and know-how remain the property of HT/DCR Engineering, Inc. Any use of this information by entities other than the title block named entity is prohibited. Use of this drawing by the title block named entity is limited to the specific title block named project. Use on other projects is strictly prohibited.	
	2830 Parkway Street • Lakeland, FL 33811	
	Phone: 863-994-2880 • Fax: 863-913-1091	
	Florida Engineering Business License No. 25522	

Company: DCR
Location: Bunge-Ergon
Product Condenser
Item No: E-4401
Date: March 13, 2007 Job No: 7793

DCR Construction, Inc
Lakeland, FL

Notes:

Scale: NTS

Ref	No	Bolt Dia.	Bolt Length	Bolt Circle	Bolt Hole
102	60	0.5	7	38.25	0.625
101	60	0.5	7	38.25	0.625

Bolting

Rev:	Date:	Description	Dwg	Ckd	Appd
1	08-23-07	Issued for Construction	KFF	DGB	PW
2	12-04-07	Certified As-Built	AGB	DGB	PW

ASME VIII-1 2004 A06
TEMA Type: BEM
Size: 35-192
TEMA Class: C

Sectional Plan


Dwg No:
E-4401 03

Rev:
2


Dimensions: in

TEMA Type: E







Front

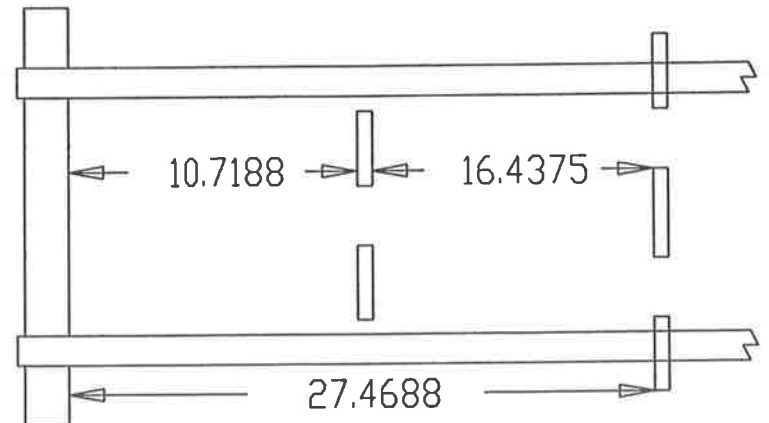



Top View

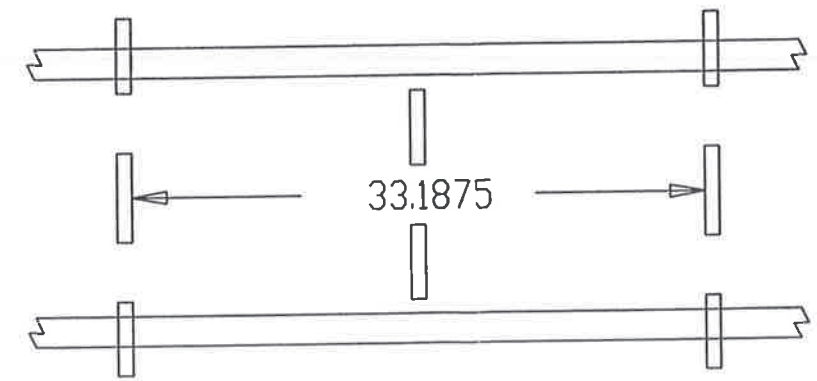

Rear

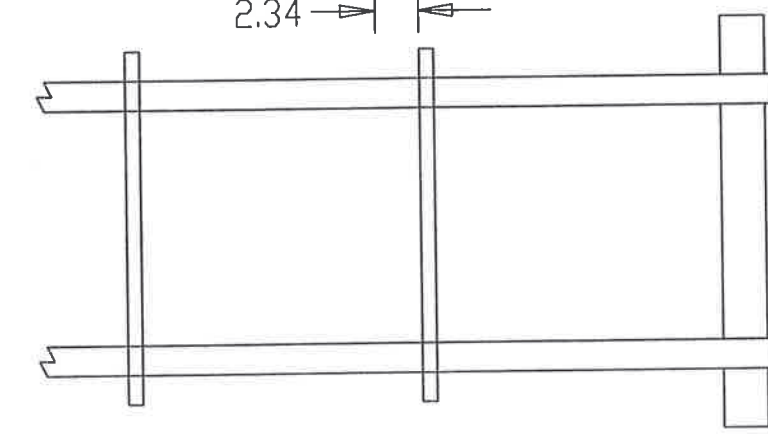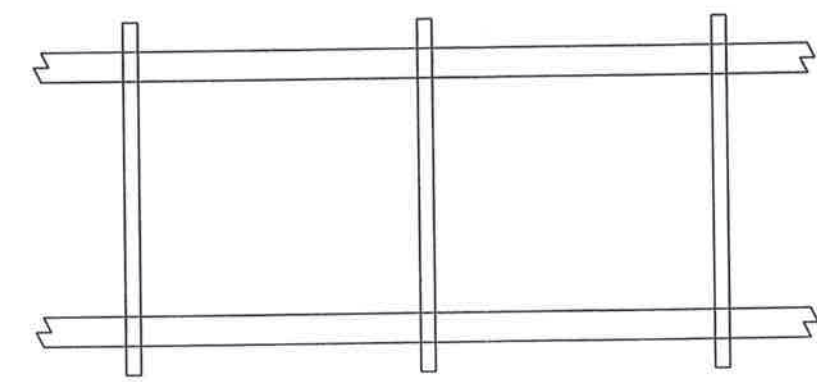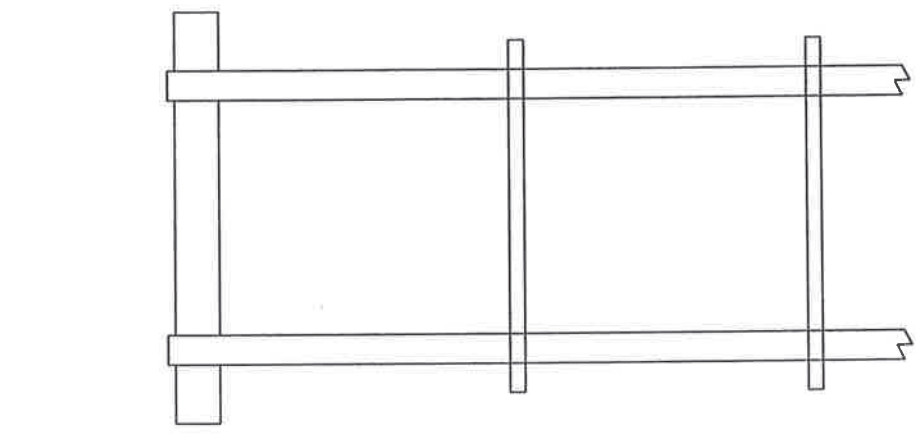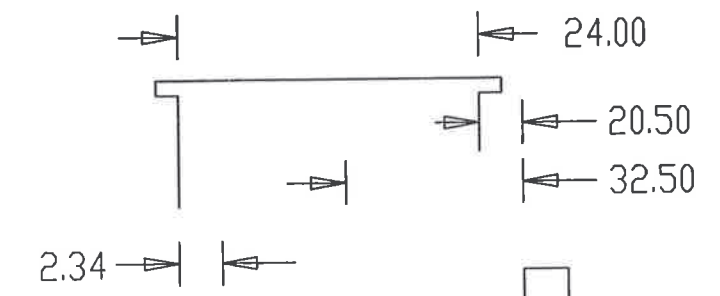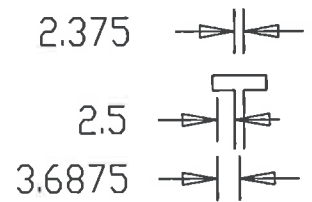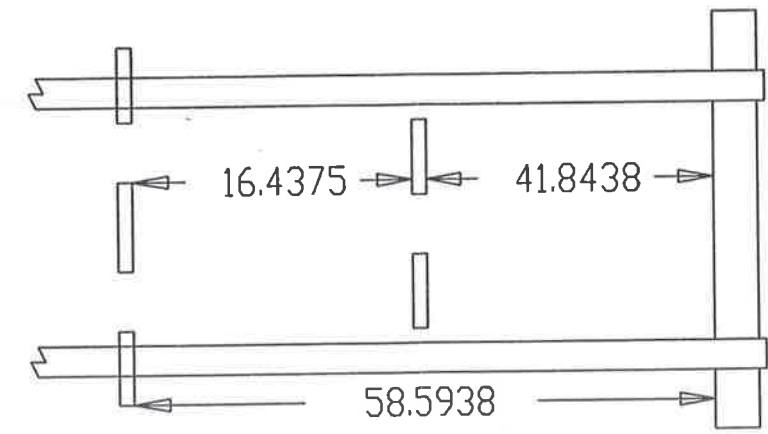

Side View
0.3125

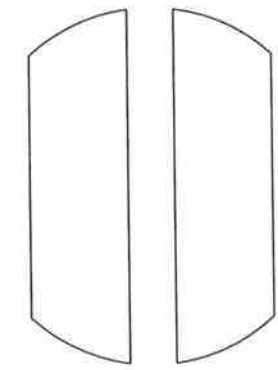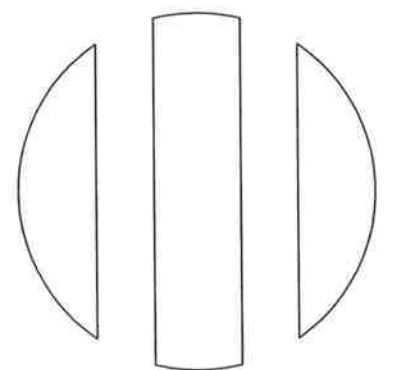


Baffles

HT/DCR
Engineering, Inc.
2630 Parkway Steel • Lakeland, FL 33811
Phone: 863-904-2880 • Fax: 863-913-1091
Florida Engineering Business License No. 26522



This drawing contains intellectual property of HT/DCR Engineering, Inc. All ideas, designs, arrangements and know-how remain the property of HT/DCR Engineering, Inc. Any use of this information by entities other than the title block named entity is prohibited. Use of this drawing by the title block named entity is limited to the specific title block named project. Use on other projects is strictly prohibited.

Notes:						Company: DCR		DCR Construction, Inc. Lakeland, Florida	
						Location: Bunge-Ergon			
Scale: NTS						Item No: E-4401		Date: February 26, 2007 Job No: 7793	
						ASME VIII-1 2004 A06		Bundle Detail	
Rev:	Date:	Description	Dwg	Ckd	Appd	TEMA Type: BEM		Dwg No.: E-4401 04	
1	08-23-07	Issued for Construction	KFF	DGB	PW	Size: 35-192			
2	12-04-07	Certified As-Built	AGB	DGB	PW	TEMA Class: C		Rev:	2


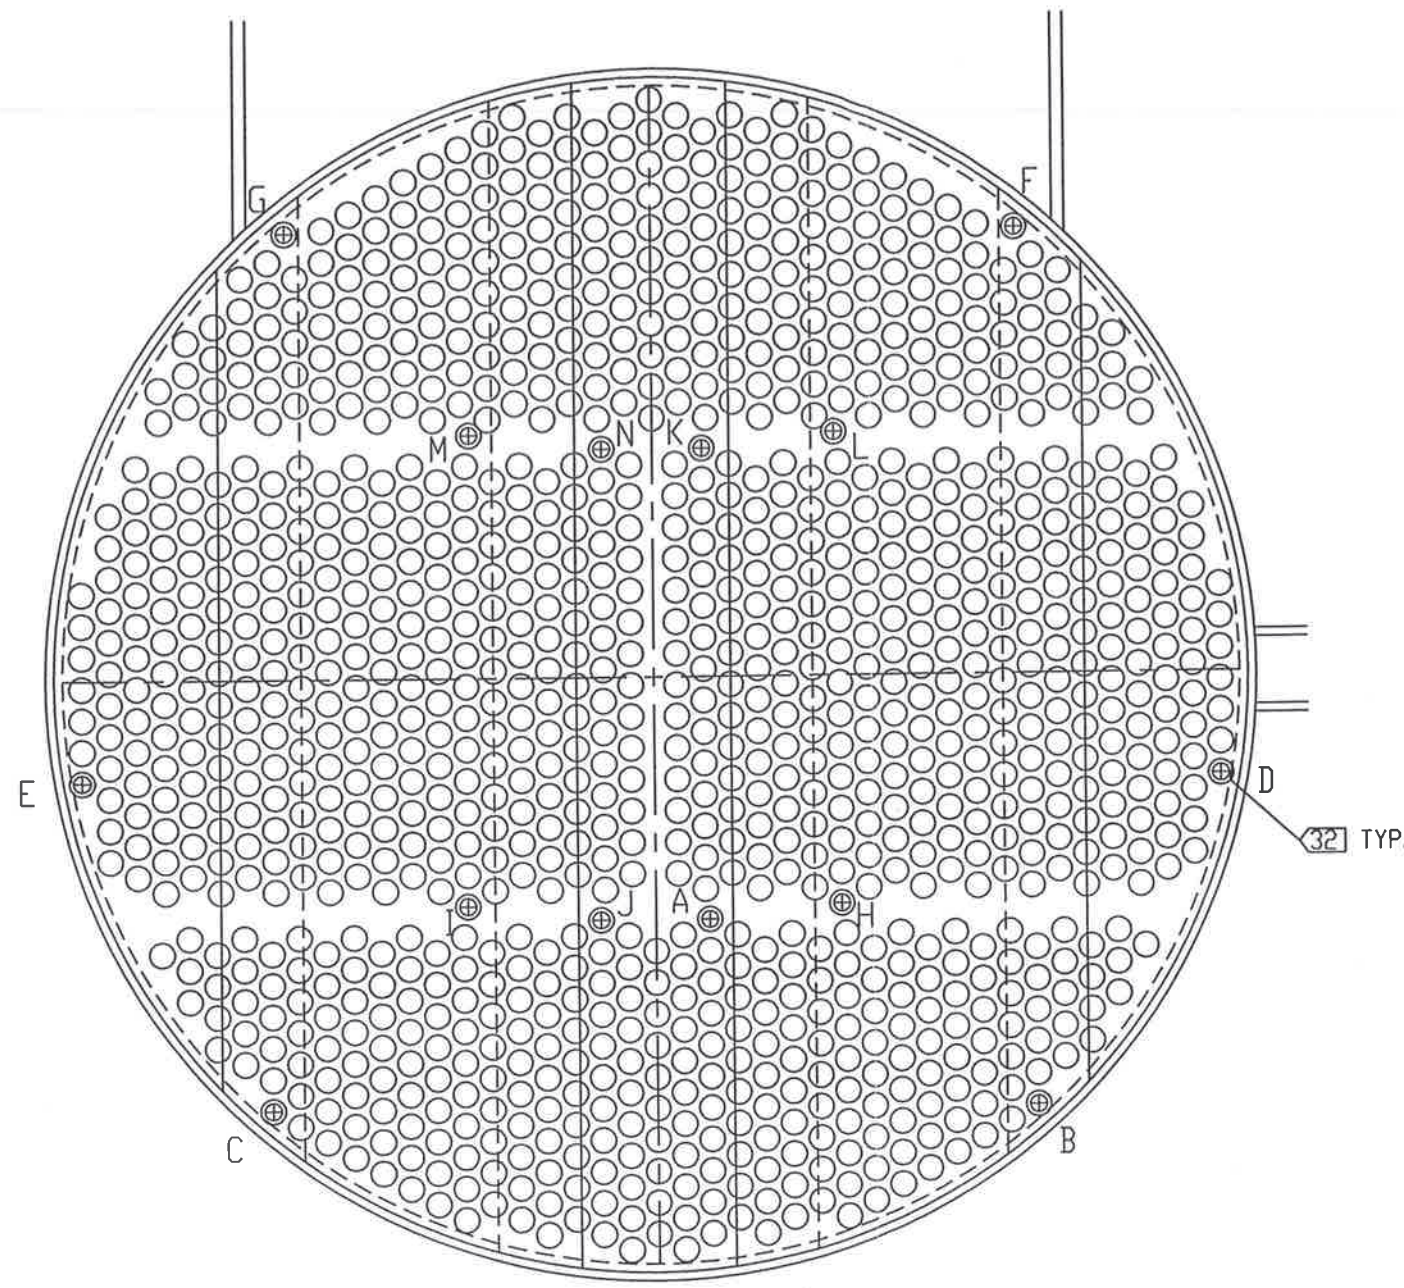

Shell ID 35.5 in
 O.T.L. 35 in
 Baffle cut to C/L 2.311 in
 4.747 in
 10.43 in
 12.866 in

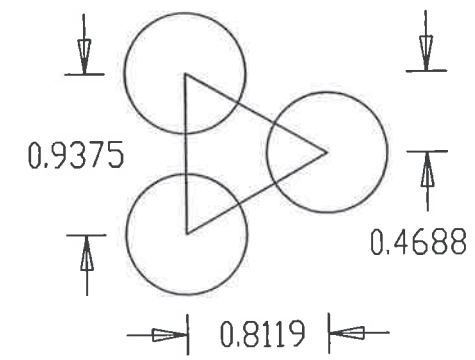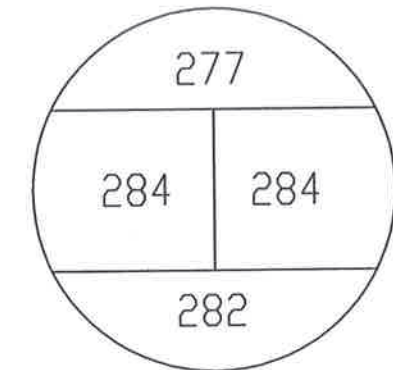


HT/DCR
 Engineering, Inc.
 2830 Parkway Street • Lakeland, FL 33811
 Phone: 863-904-2860 • Fax: 863-913-1091
 Florida Engineering Business License No. 26522


This drawing contains intellectual property of HT/DCR Engineering, Inc. All ideas, designs, arrangements and know-how remain the property of HT/DCR Engineering, Inc. Any use of this information by entities other than the title block named entity is prohibited. Use of this drawing by the title block named entity is limited to the specific title block named project. Use on other projects is strictly prohibited.

Design Specifications	
Number of Tube Holes	1127
Tube Outside Diameter	0.75 in
Tube Pitch	0.9375 in
Tube Pattern	Triangular
Tube Passes	4 Mixed
Number of Tie Rods	6
Tie Rod Diameter	0.5 in
Baffle Diameter	35.3125 in
Baffle Type	Triple Segmental
Baffle Cut	13%
Tube Thickness	0.049 in

Tie Rod Locations Cont.					
K	1.4994 6.765				
L	4.0595 7.2338				
M	-4.0595 7.2338				
N	-1.4994 6.765				
Drill and Tap Tie Rods A, H, I, J, K, L, M, N From Shell Side					
Scale: NTS					
Rev:	Date:	Description	Dwg	Ckd	Appd
1	08-23-07	Issued for Construction	KFF	DGB	PW
2	12-04-07	Certified As-Built	AGB	DGB	PW

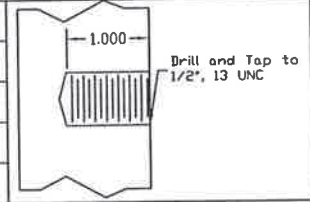

Company: DCR Location: Bunge-Ergon Product Condenser Item No: E-4401 Date: March 6, 2007 Job No: 7793	
DCR Construction, Inc. Lakeland, Florida	
ASME VIII-1 2004 A06 TEMA Type: BEM Size: 35-192 TEMA Class: C	Tube Layout Dwg No: E-4401 05 Rev: 2

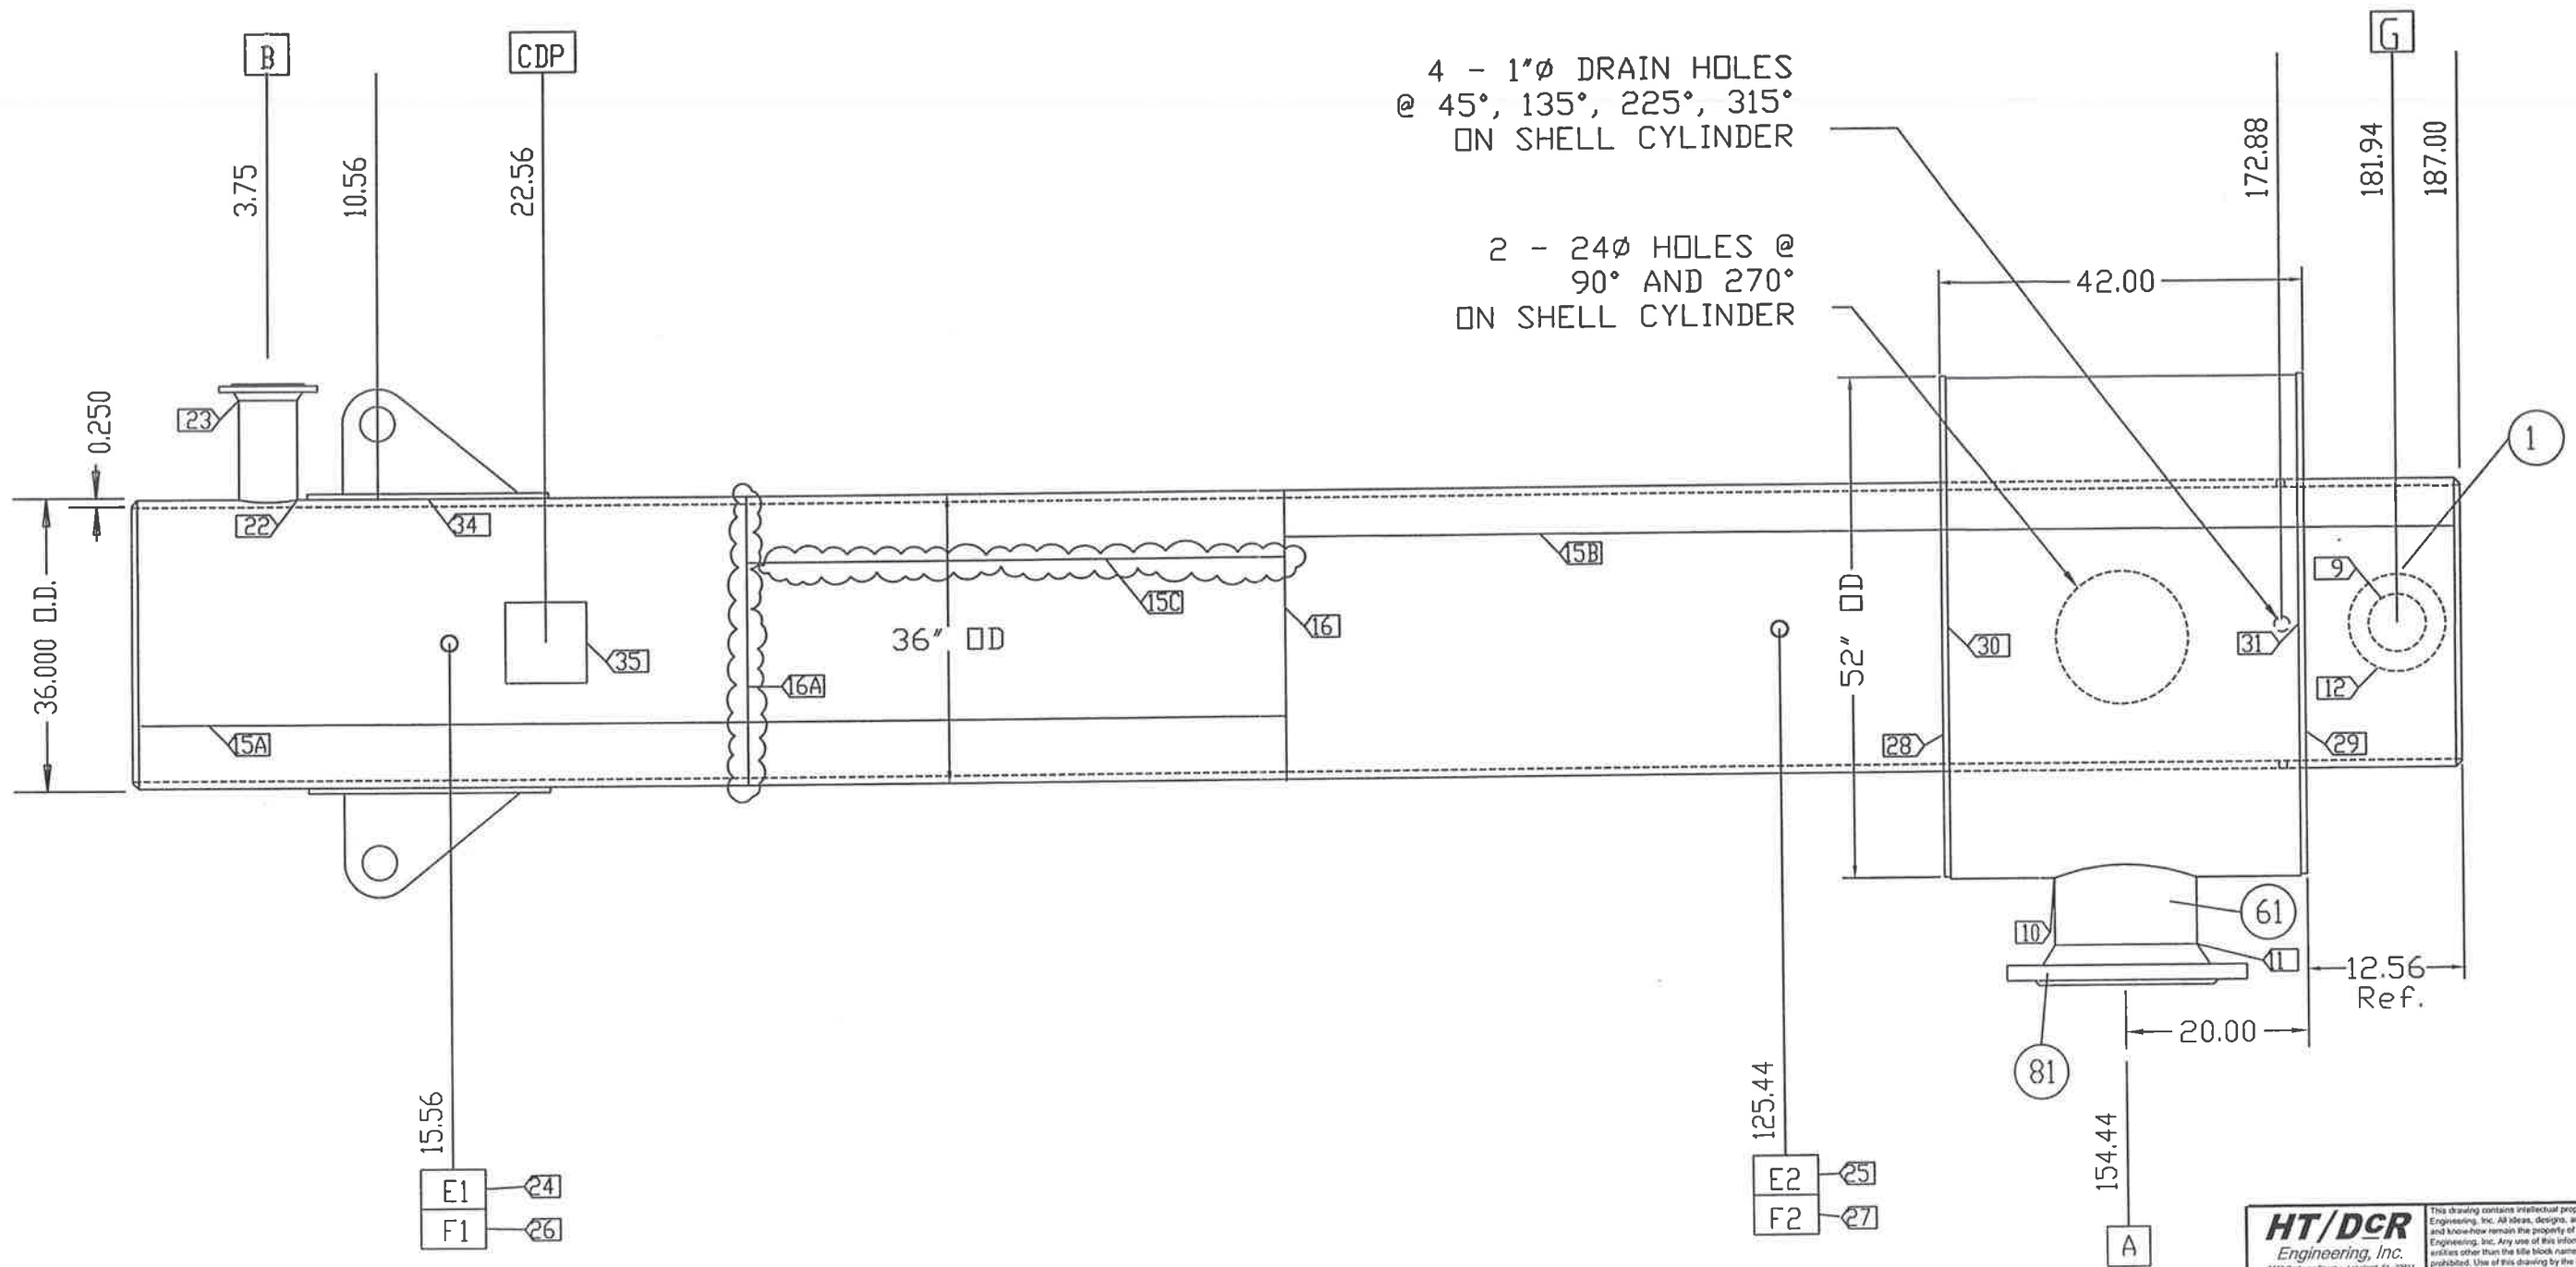

Side View

Notes:
 All Dimensions In Inches
 Bolt holes to straddle centerlines
 Weld joint details per drawing 20

Company: DCR
 Location: Bunge-Ergon
 Product Condenser
 Item No: E-4401
 Date: March 13, 2007 Job No: 7793

DCR Construction, Inc
 Lakeland, FL

Scale: NTS

Rev:	Date:	Description	Dwg	Ckd	Appd
1	08-23-07	Issued for Construction	KFF	DGB	PW
2	10-4-07	Added Weld Seam	KFF	DGB	PW
3	12-04-07	Certified As-Built	AGB	DGB	PW


ASME VIII-1 2004 A06
 TEMA Type: BEM
 Size: 35-192
 TEMA Class: C

Shell Detail
 Dwg No:
 E-4401 06A

Rev:
 3

HT/DCR
 Engineering, Inc.
3820 Parkway Street - Lakeland, FL 33811
 Phone: 813-949-2300 • Fax: 813-943-1051
 Florida Engineering Business License No. 25522

This drawing contains intellectual property of HT/DCR Engineering, Inc. All ideas, designs, arrangements and know-how remain the property of HT/DCR Engineering, Inc. Any use of this information by entities other than the title block named entity is prohibited. Use of this drawing by the title block named entity is limited to the specific title block named project. Use on other projects is strictly prohibited.

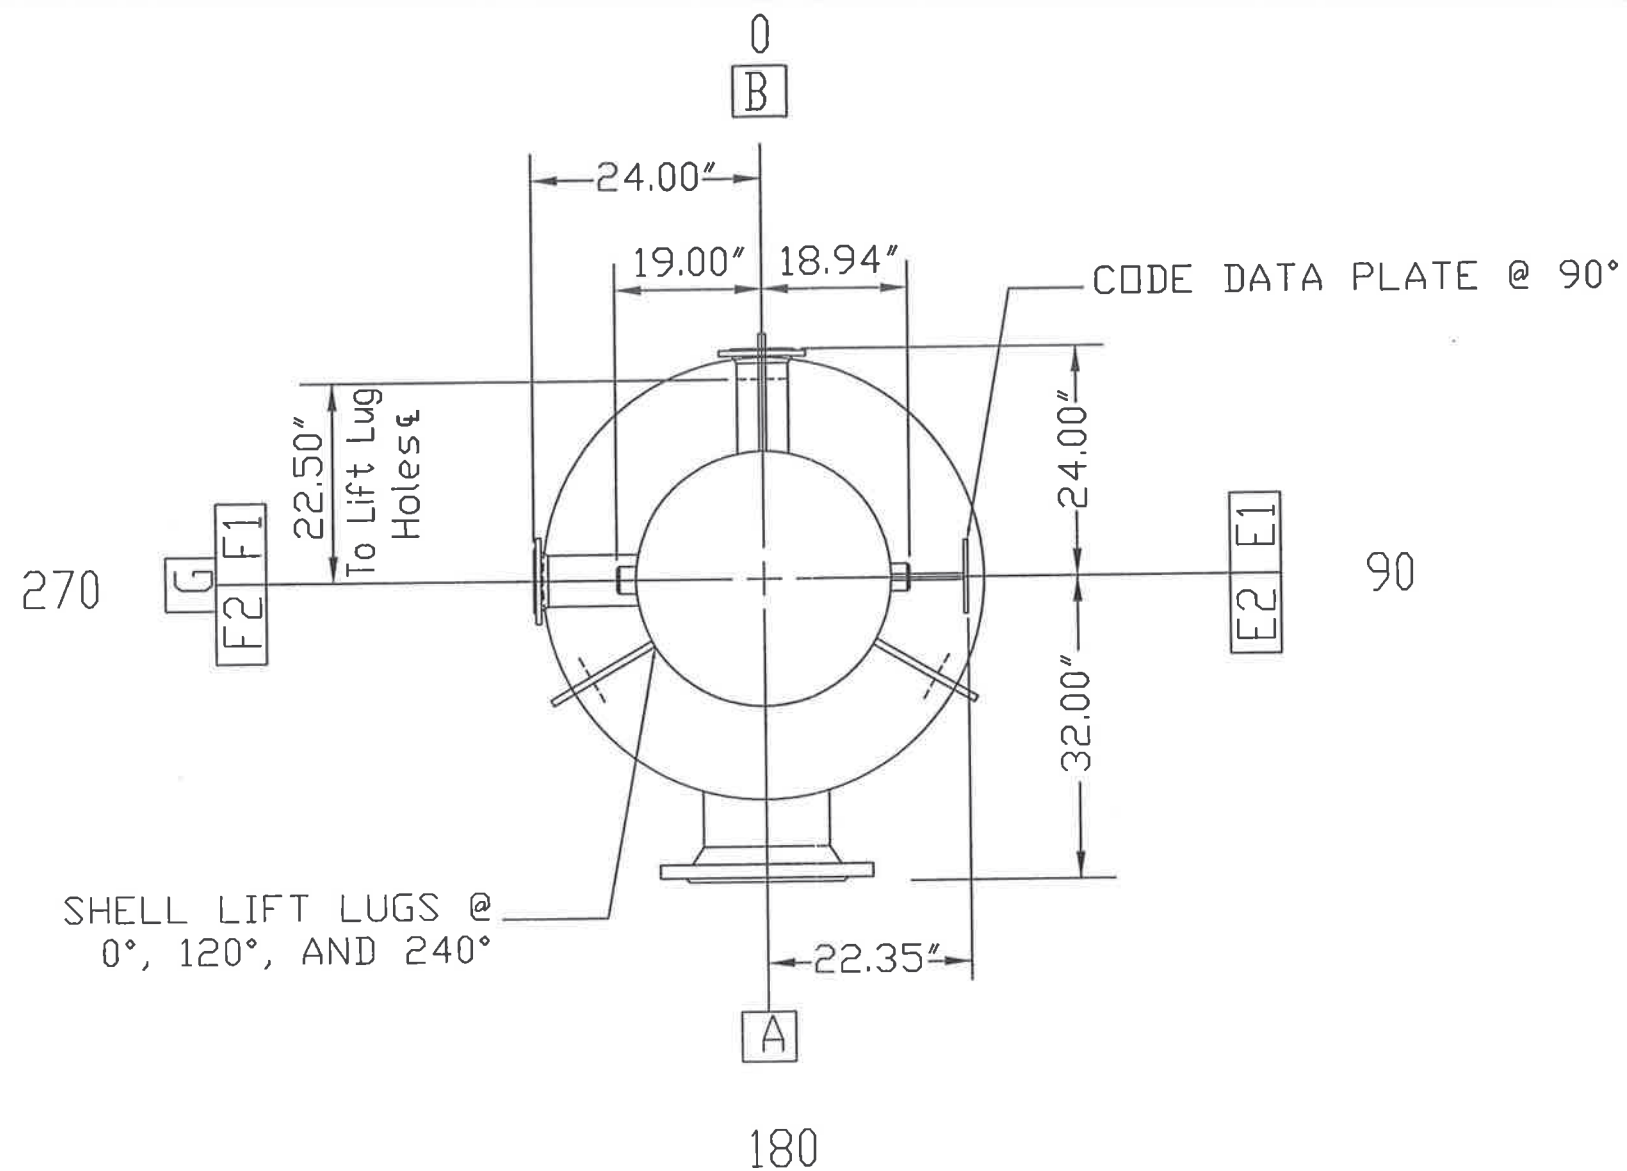

Front End View

HT/DCR
Engineering, Inc.
 2830 Parkway Street • Lakeland, FL 33811
 Phone: 863-904-2888 • Fax: 863-915-1091
 Florida Engineering Business License No. 25522

This drawing contains intellectual property of HT/DCR Engineering, Inc. All ideas, designs, arrangements and know-how remain the property of HT/DCR Engineering, Inc. Any use of this information by entities other than the title block named entity is prohibited. Use of this drawing by the title block named entity is limited to the specific title block named project. Use on other projects is strictly prohibited.


Notes:
 All Dimensions In Inches
 Bolt holes to straddle centerlines
 Weld joint details per drawing 20

Company: DCR
 Location: Bunge-Ergon
 Product Condenser
 Item No.: E-4401
 Date: February 26, 2007 Job No.: 7793

DCR Construction, Inc
 Lakeland, FL

Scale: NTS

Rev:	Date:	Description	Dwg	Ckd	Appd	ASME VIII-1 2004 A06	Shell Detail	Rev:
1	08-23-07	Issued for Construction	KFF	DGB	PW	TEMA Type: BEM		
2	12-04-07	Certified As-Built	AGB	DGB	PW	Size: 35-192	Dwg No.: E-4401 06B	2
						TEMA Class: C		

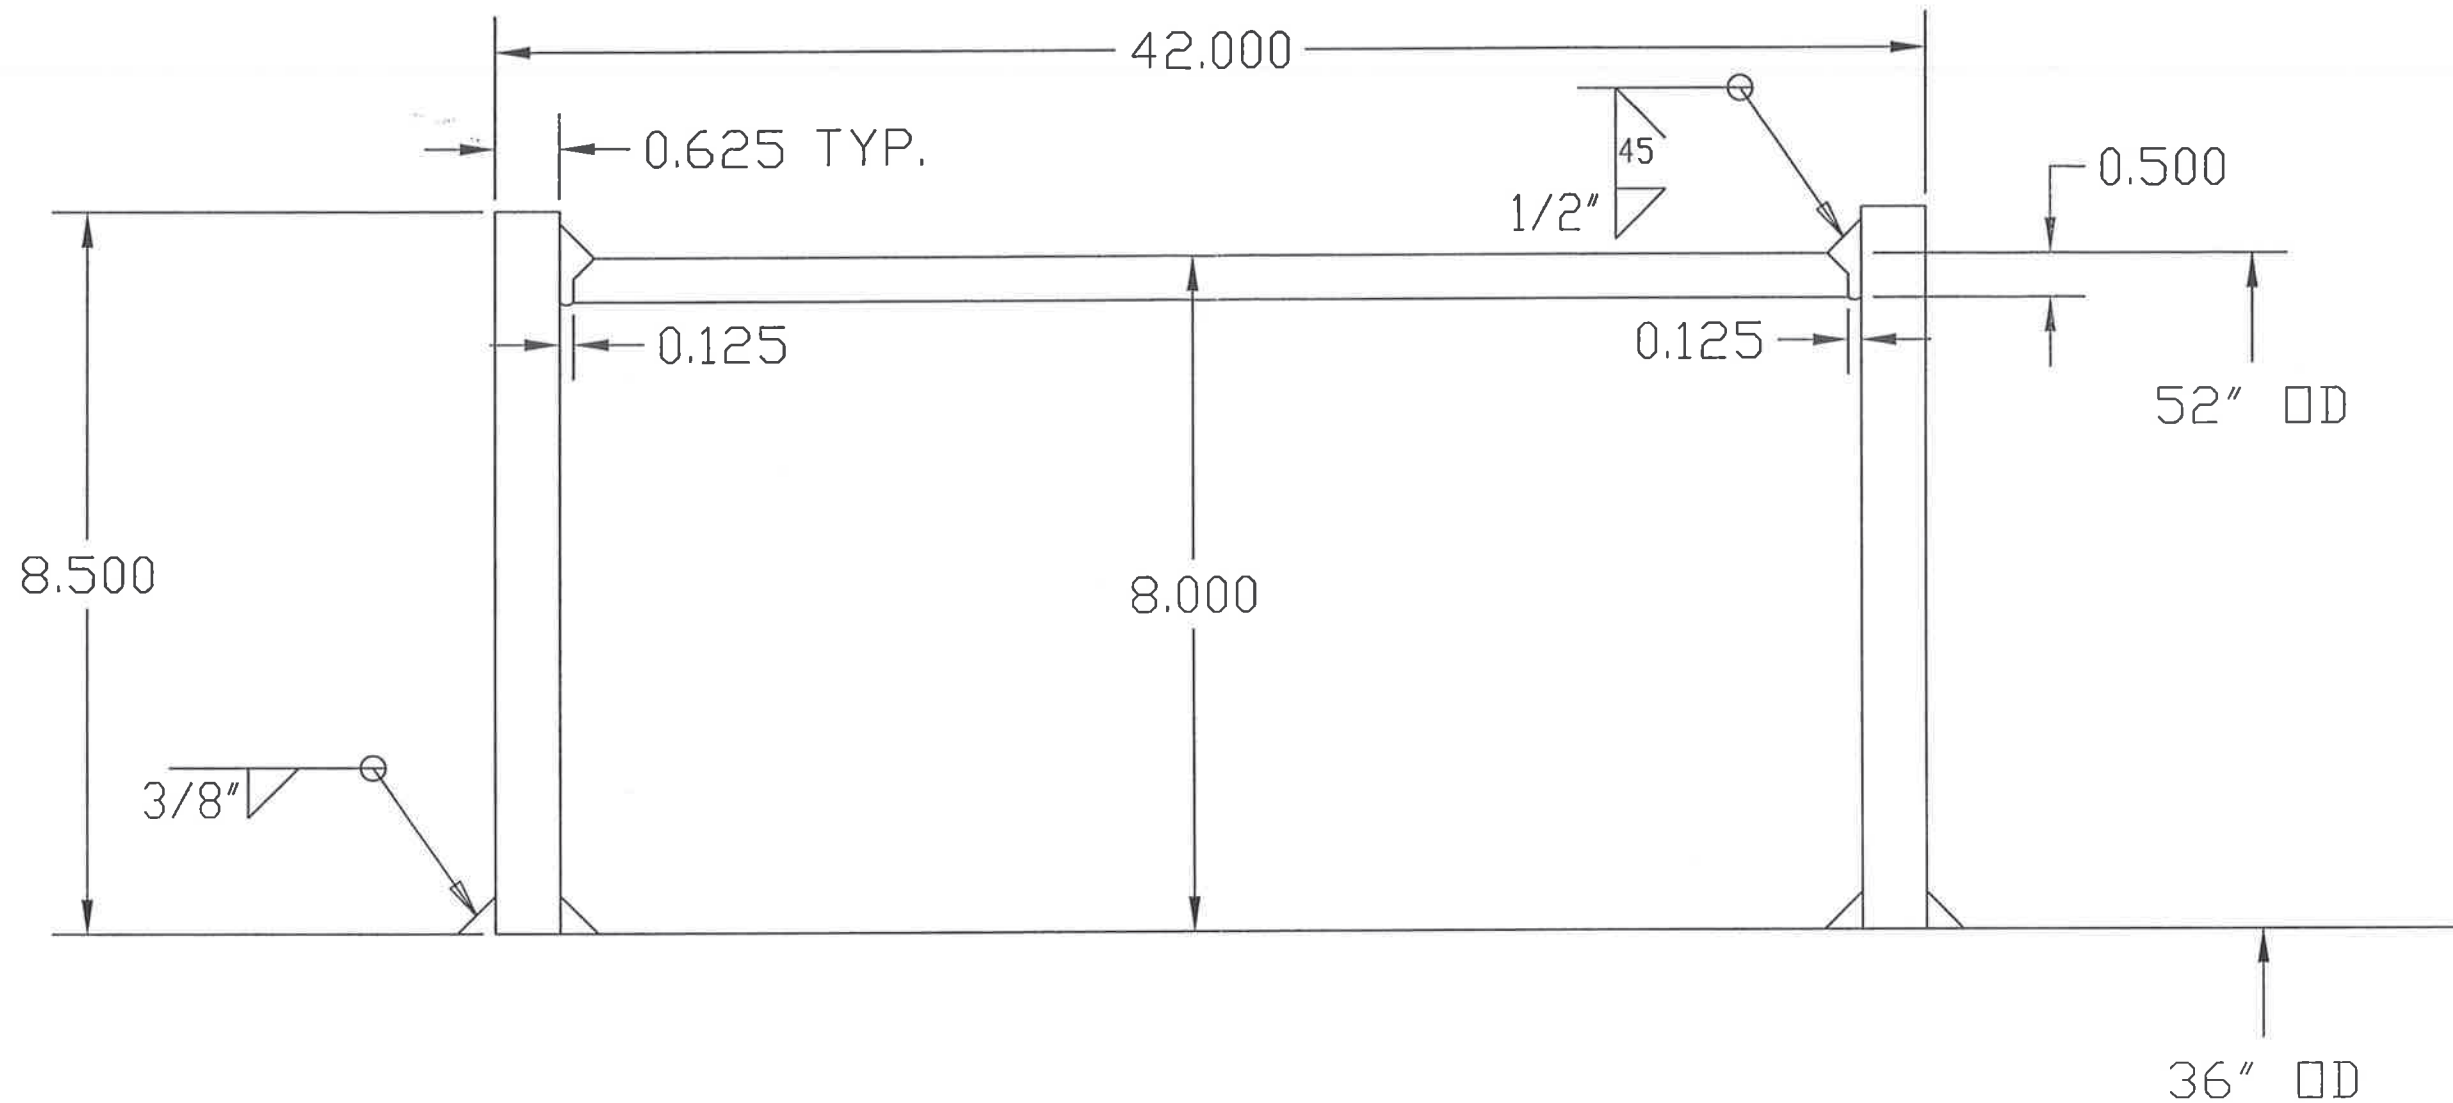

HT/DCR
Engineering, Inc.

Notes:
All Dimensions In Inches

Company: DCR
Location: Bunge-Ergon
Product Condenser
Item No: E-4401
Date: April 16, 2007 Job No: 7790

DCR Construction, Inc
Lakeland, FL


Scale: NTS

Rev:	Date:	Description	Dwg	Ckd	Appd	ASME VIII-1 2004 A06
1	08-23-07	Issued for Construction	KFF	DGB	PW	TEMA Type: BEM
2	12-04-07	Certified As-Built	AGB	DGB	PW	Size: 35-192
						TEMA Class: C

Vapor Belt Detail


Dwg No:
E-4401 07

Rev:
2

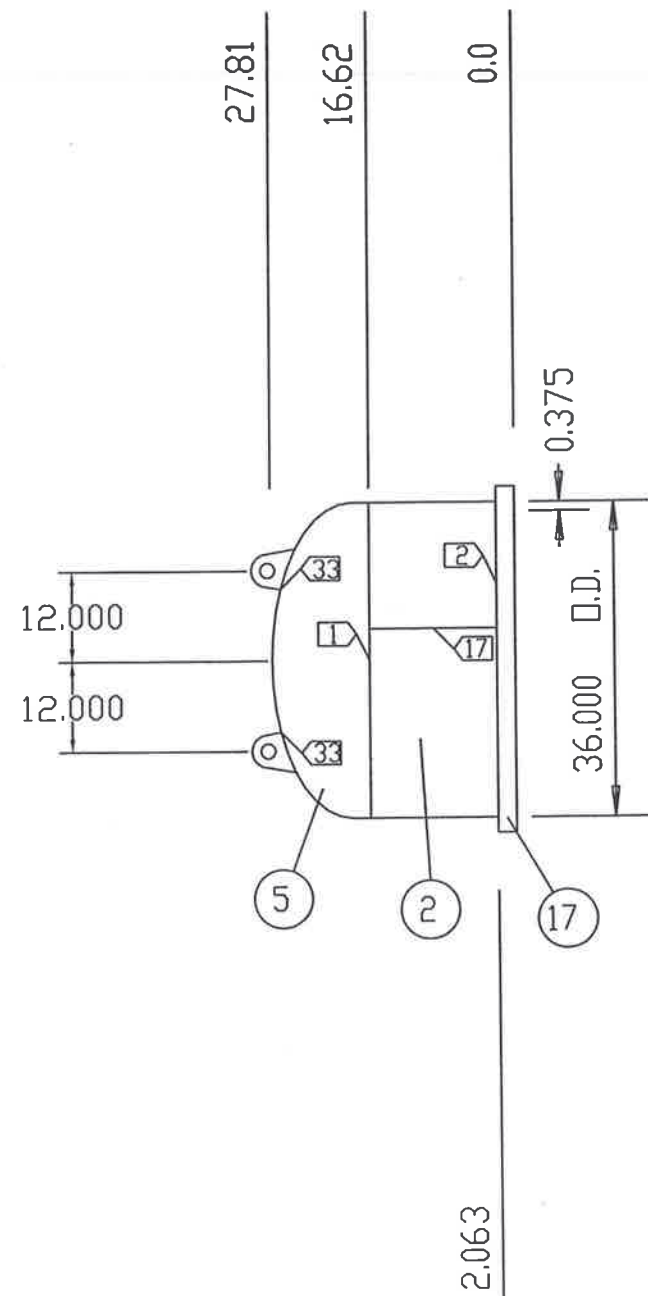

Side View

HEAD LIFT LUGS
@ 90° AND 270°

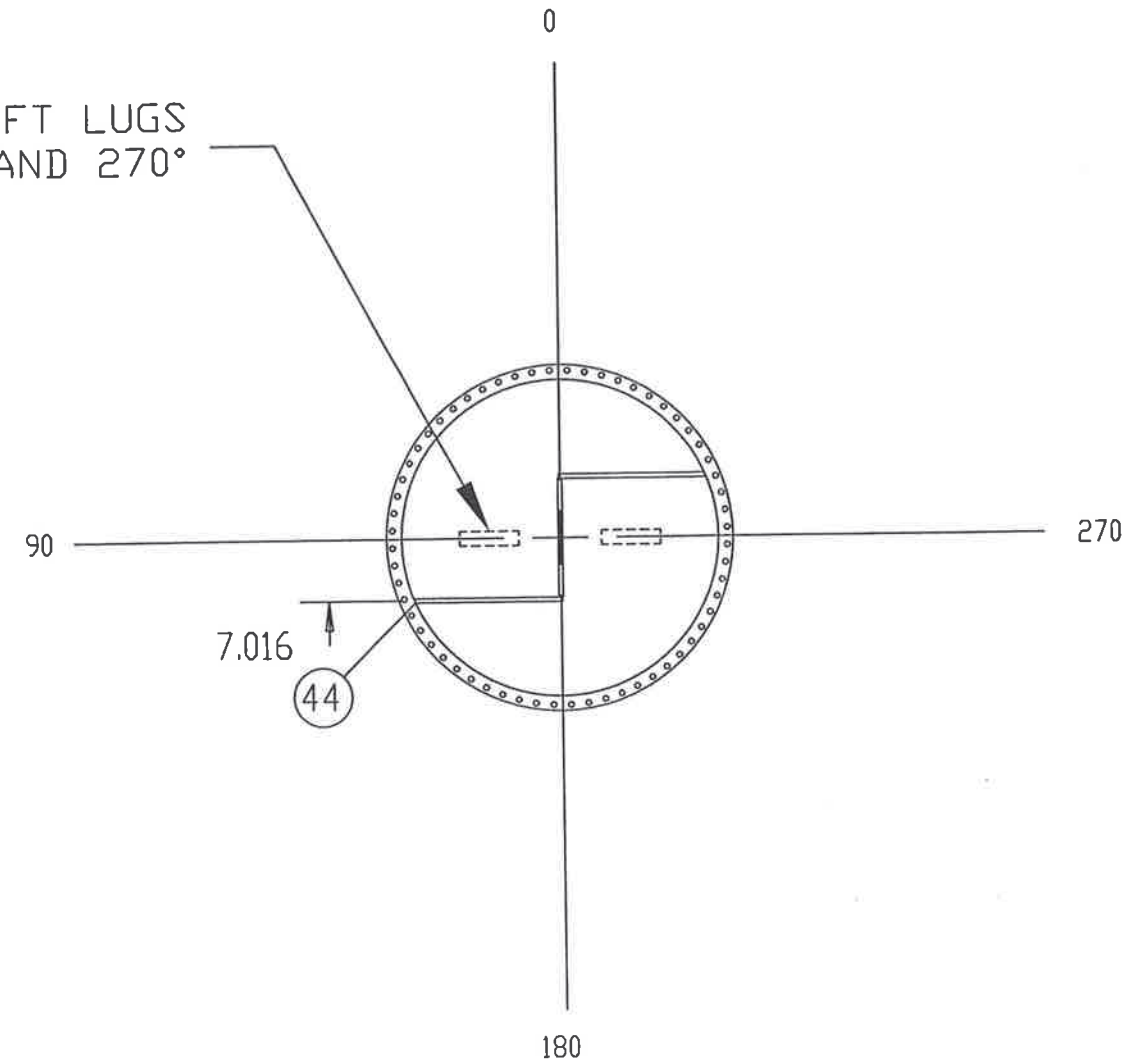

Rear End View

HT/DCR
Engineering, Inc.
2530 Parkway Street • Lakeland, FL 33811
Phone: 863-904-2900 • Fax: 863-913-1081
Florida Engineering Business License No. 26522

This drawing contains intellectual property of HT/DCR Engineering, Inc. All ideas, designs, arrangements and know-how remain the property of HT/DCR Engineering, Inc. Any use of this information by entities other than the title block named entity is prohibited. Use of this drawing by the title block named entity is limited to the specific title block named project. Use on other projects is strictly prohibited.


Notes:
All Dimensions In Inches
Bolt holes to straddle centerlines
Weld joint details per drawing 20

Company: DCR
Location: Bunge-Ergon
Product Condenser
Item No: E-4401
Date: February 26, 2007 Job No: 7793


DCR Construction, Inc
Lakeland, FL

Scale: NTS

Rev:	Date:	Description	Dwg	Ckd	Appd	ASME VIII-1 2004 A06	Front Head Detail	
1	08-23-07	Issued for Construction	KFF	DGB	PW	TEMA Type: BEM	Dwg No: E-4401 08	Rev: 2
2	12-04-07	Certified As-Built	AGB	DGB	PW	Size: 35-192 TEMA Class: C		

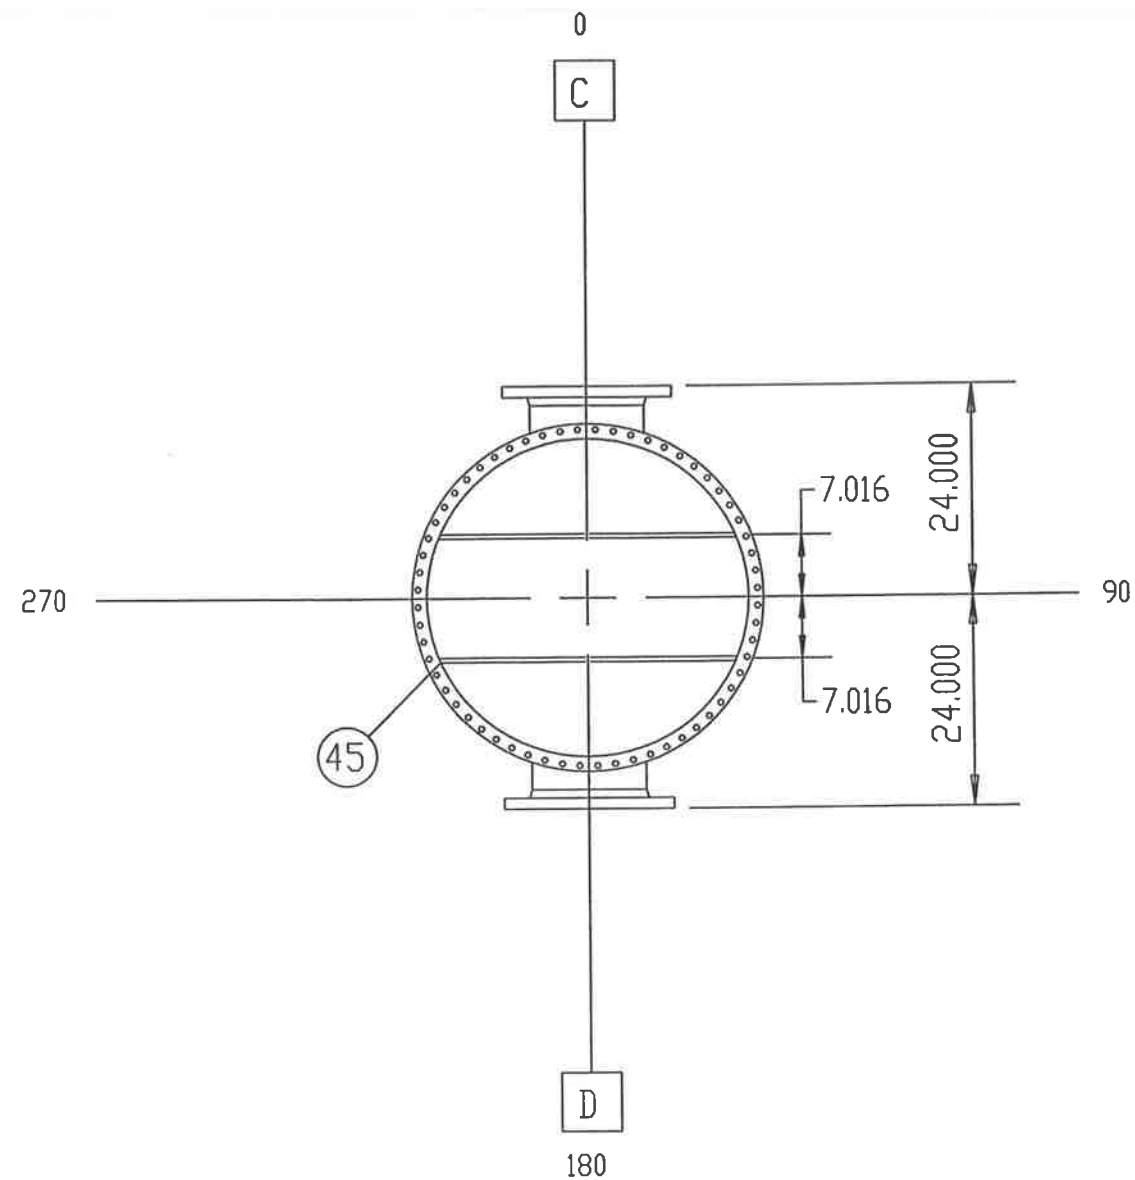

Front End View

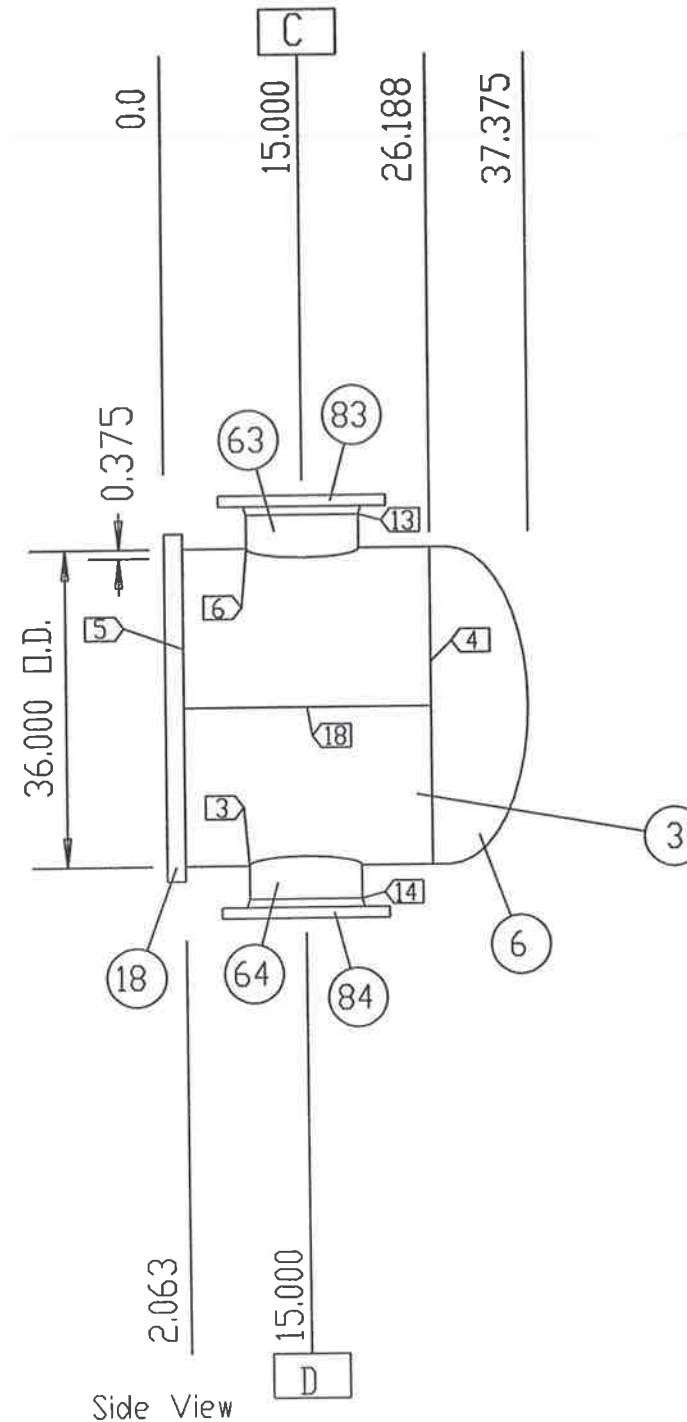

Side View

HT/DCR
Engineering, Inc.
2830 Parkway Street • Lakeland, FL 33811
Phone: 863-904-2880 • Fax: 863-913-1091
Florida Engineering Business License No. 20522

This drawing contains intellectual property of HT/DCR Engineering, Inc. All ideas, designs, arrangements and know-how remain the property of HT/DCR Engineering, Inc. Any use of this information by entities other than the title block named entity is prohibited. Use of this drawing by the title block named entity is limited to the specific title block named project. Use on other projects is strictly prohibited.


Notes:
All Dimensions In Inches
Bolt holes to straddle centerlines
Weld joint details per drawing 20

Company: DCR
Location: Bunge-Ergon
Product Condenser
Item No: E-4401
Date: February 26, 2007 Job No: 7793

DCR Construction, Inc
Lakeland, FL

Scale: NTS

Rev:	Date:	Description	Dwg	Ckd	Appd	ASME VIII-1 2004 A06	Rear Head Detail	Dwg No: E-4401 09	Rev: 2
1	08-23-07	Issued for Construction	KFF	DGB	PW	TEMA Type: BEM			
2	12-04-07	Certified As-Built	AGB	DGB	PW	Size: 35-192 TEMA Class: C			

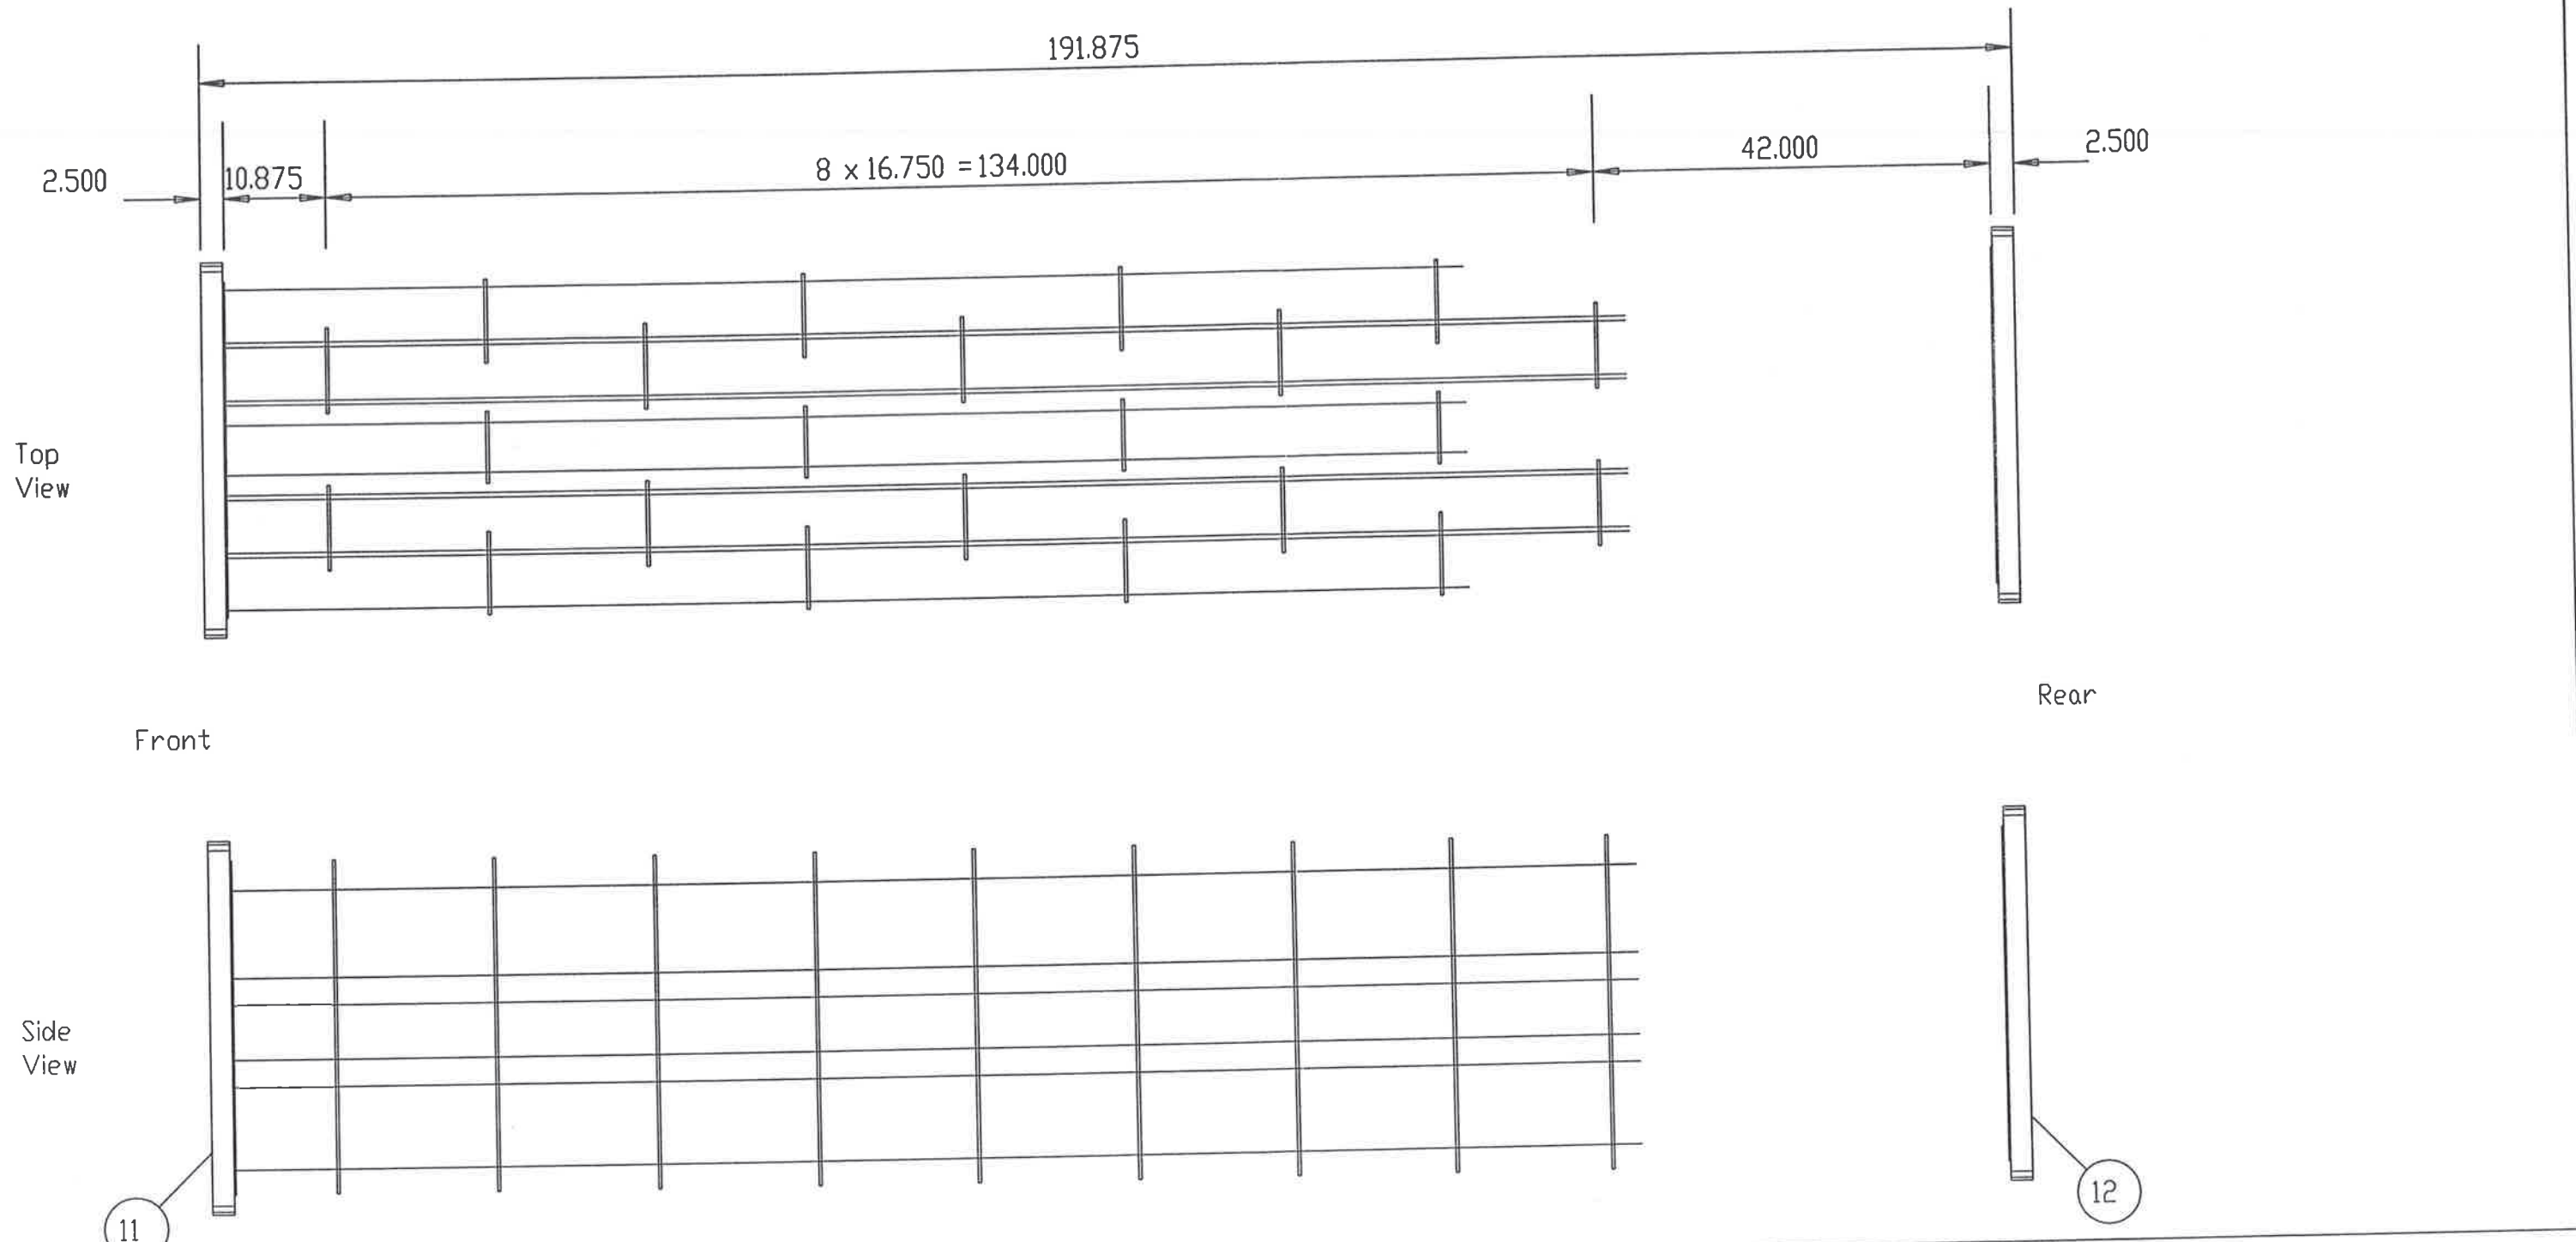

# of Spacers	Length (in.)
16	16.438
3	33.188
2	10.719
1	27.469

Notes:
 All Dimensions In Inches
 Bolt holes to straddle centerlines
 Weld joint details per drawing 20


HT/DCR
 Engineering, Inc.
2830 Parkway Street • Lakeland, FL 33811
 Phone: 863-904-2800 • Fax: 863-913-1091
 Florida Engineering Business License No. 26522

This drawing contains intellectual property of HT/DCR Engineering, Inc. All ideas, designs, arrangements and know-how remain the property of HT/DCR Engineering, Inc. Any use of this information by entities other than the title block named entity is prohibited. Use of this drawing by the title block named entity is limited to the specific title block named project. Use on other projects is strictly prohibited.


Company: DCR
 Location: Bunge-Ergon
 Product Condenser
 Item No.: E-4401
 Date: February 26, 2007 Job No.: 7793

DCR Construction, Inc.
 Lakeland, Florida

Rev:	Date:	Description	Dwg	Ckd	Appd	ASME VIII-1 2004 A06	Bundle Detail	Dwg No.: E-4401 11	Rev: 2
1	08-23-07	Issued for Construction	KFF	DGB	PW	TEMA Type: BEM			
2	12-04-07	Certified As-Built	AGB	DGB	PW	Size: 35-192 TEMA Class: C			

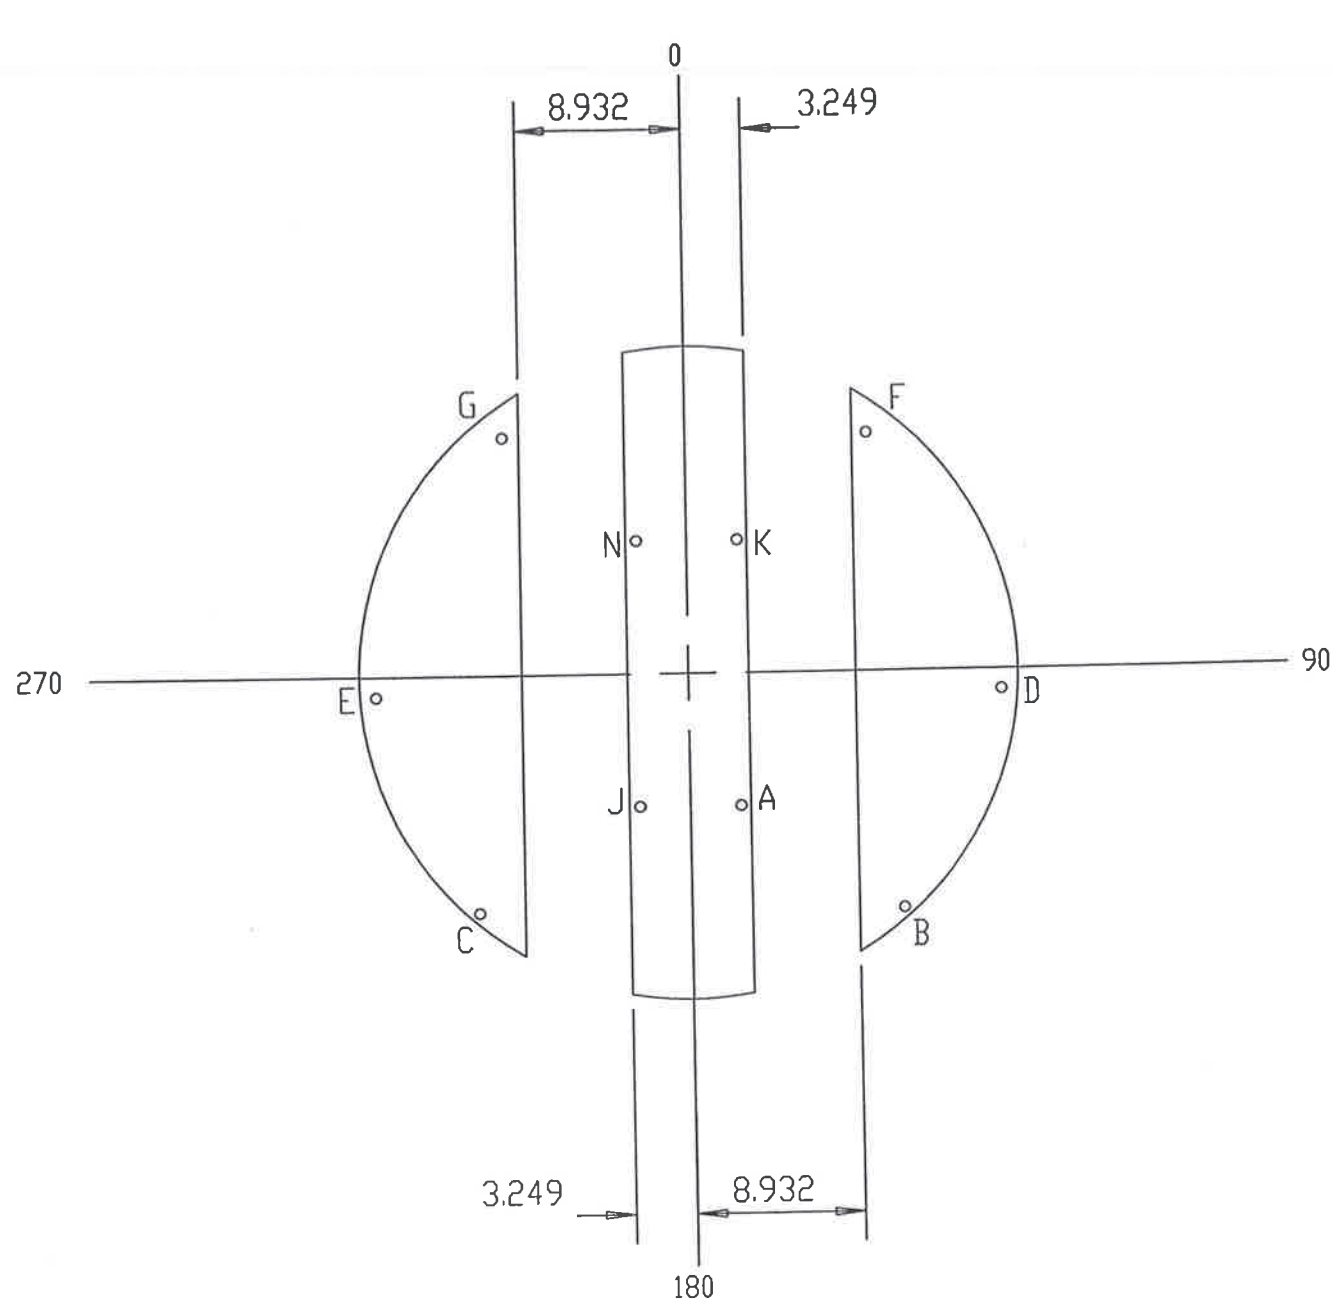

39 A 4 Baffles 35.313 O.D. 0.313 Tk

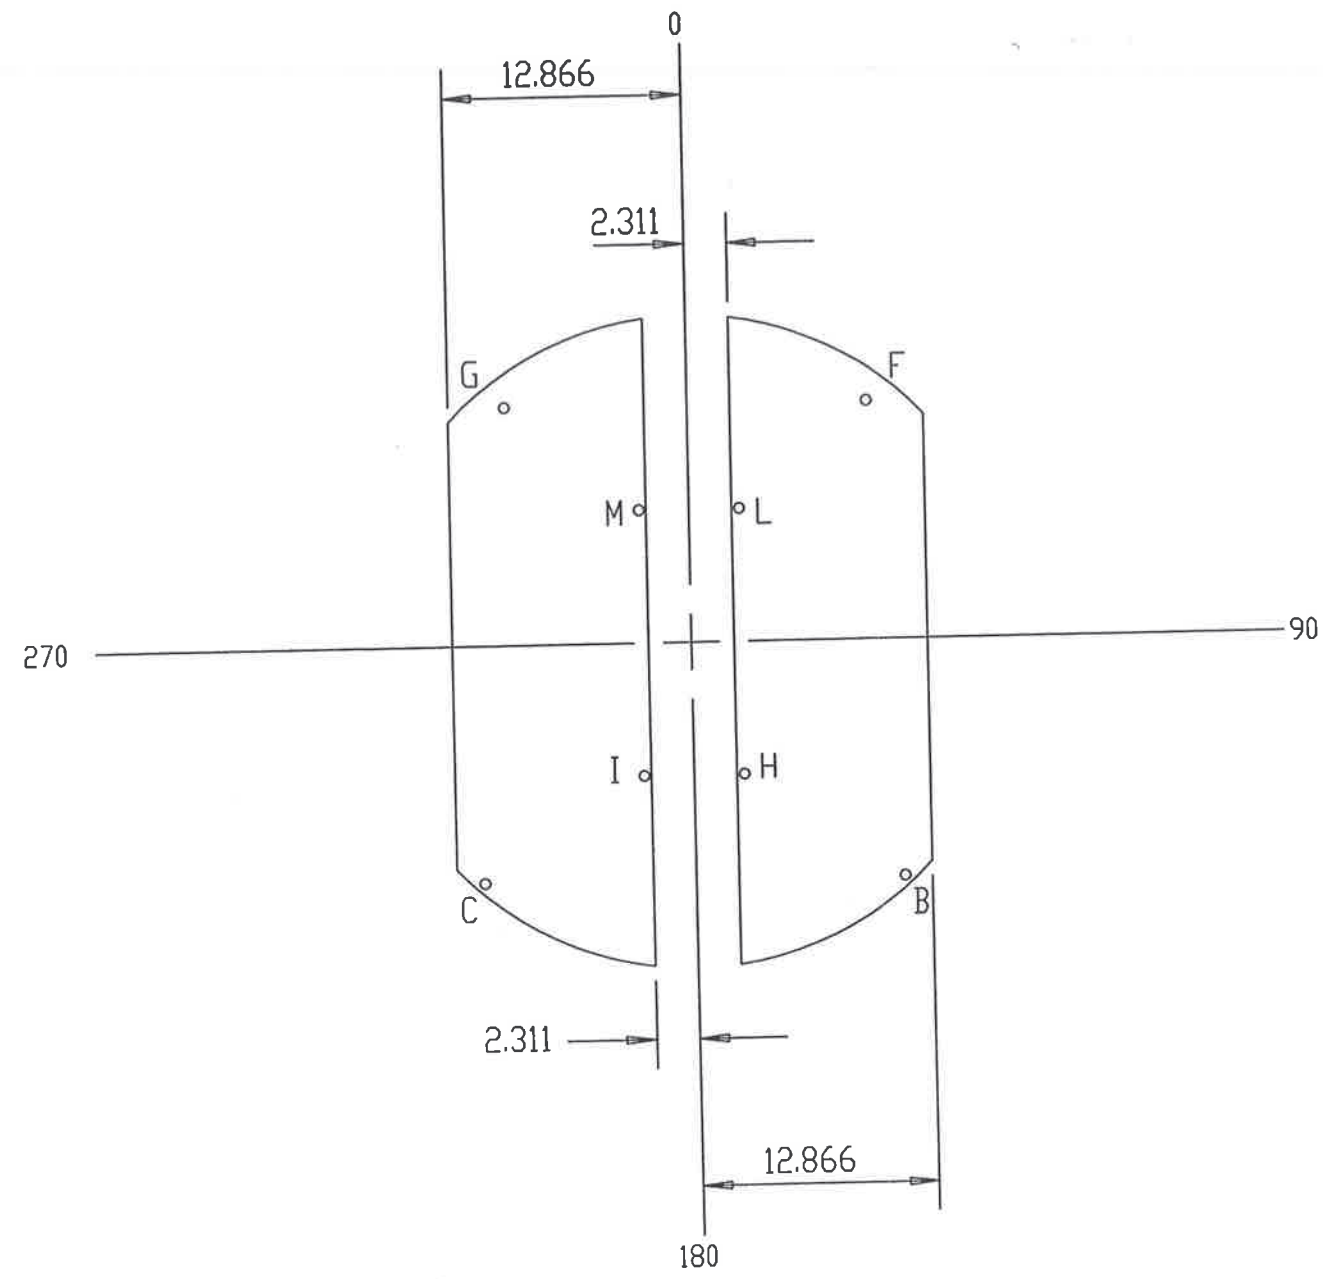

39 B 5 Baffles 35.313 O.D. 0.313 Tk

Notes:
 All Dimensions In Inches
 Weld joint details per drawing 20

Company: DCR
 Location: Bunge-Ergon
 Product Condenser
 Item No: E-4401
 Date: February 26, 2007 Job No: 7793



HT/DCR
 Engineering, Inc.
2830 Parkway Street • Lakeland, FL 33811
 Phone: 863-904-2880 • Fax: 863-913-1091
 Florida Engineering Business License No. 26522

This drawing contains intellectual property of HT/DCR Engineering, Inc. All ideas, designs, arrangements and know-how remain the property of HT/DCR Engineering, Inc. Any use of this information by entities other than the title block named entity is prohibited. Use of this drawing by the title block named entity is limited to the specific title block named project. Use on other projects is strictly prohibited.

DCR Construction, Inc.
 Lakeland, Florida

Scale: NTS						ASME VIII-1 2004 A06	Baffle Detail
Rev:	Date:	Description	Dwg	Ckd	Appd		
1	08-23-07	Issued for Construction	KFF	DGB	PW	TEMA Type: BEM	Dwg No: E-4401 12
2	12-04-07	Certified As-Built	AGB	DGB	PW	Size: 35-192	
						TEMA Class: C	

Rev: 2

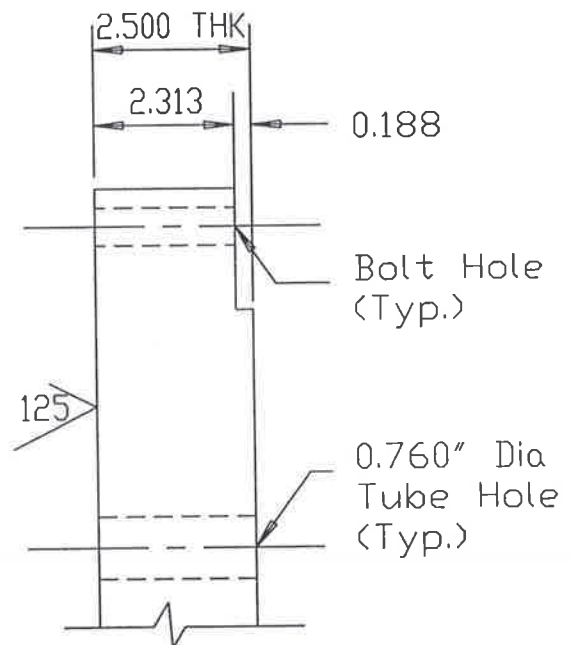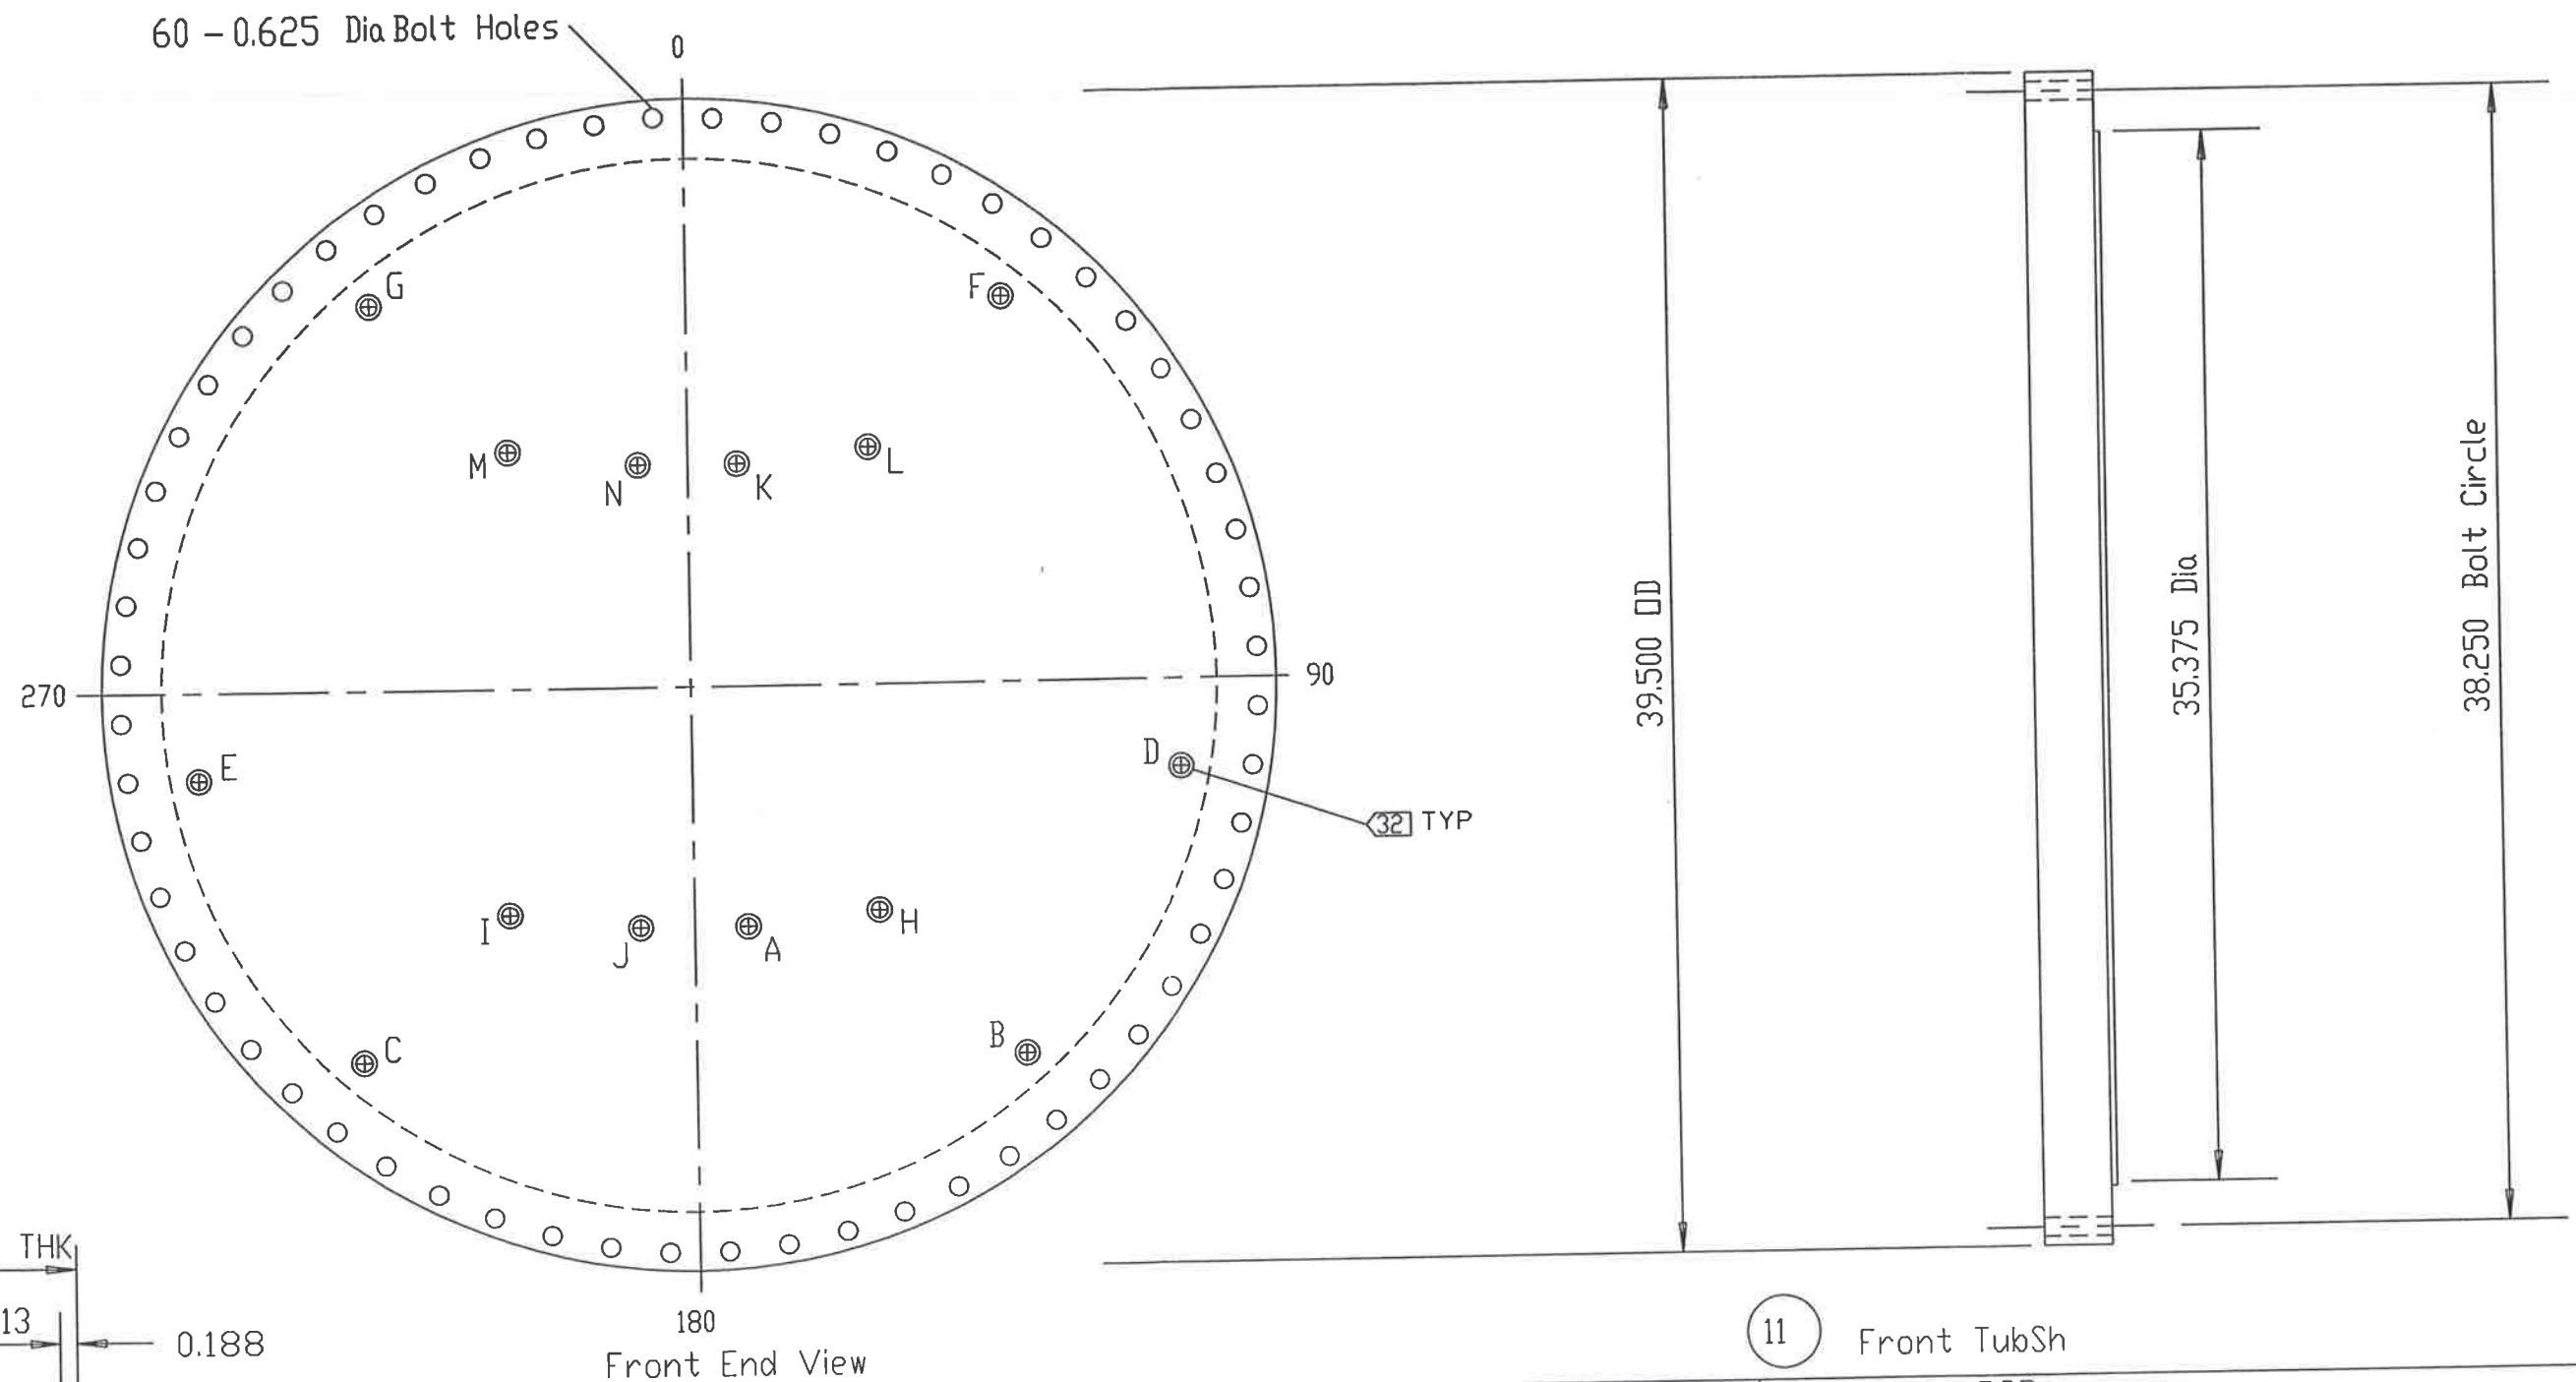

Notes:
 All Dimensions In Inches
 Bolt holes to straddle centerlines
 See Tube Layout E-4401 05 For Tube Hole Locations


HT/DCR
 Engineering, Inc.
 2830 Parkway Street • Lakeland, FL 33811
 Phone: 863-904-2800 • Fax: 863-913-1091
 Florida Engineering Business License No. 26522

This drawing contains intellectual property of HT/DCR Engineering, Inc. All ideas, designs, arrangements and know-how remain the property of HT/DCR Engineering, Inc. Any use of this information by entities other than the title block named entity is prohibited. Use of this drawing by the title block named entity is limited to the specific title block named project. Use on other projects is strictly prohibited.

Company: DCR
 Location: Bunge-Ergon
 Product Condenser
 Item No.: E-4401
 Date: February 26, 2007 Job No.: 7793

DCR Construction, Inc
 Lakeland, FL

Scale: NTS						ASME VIII-1 2004 A06	Front Tubesheet Detail	
Rev:	Date:	Description	Dwg	Ckd	Appd	TEMA Type: BEM	Dwg No: E-4401 14	Rev: 2
1	08-23-07	Issued for Construction	KFF	DGB	PW	Size: 35-192		
2	12-04-07	Certified As-Built	AGB	DGB	PW	TEMA Class: C		

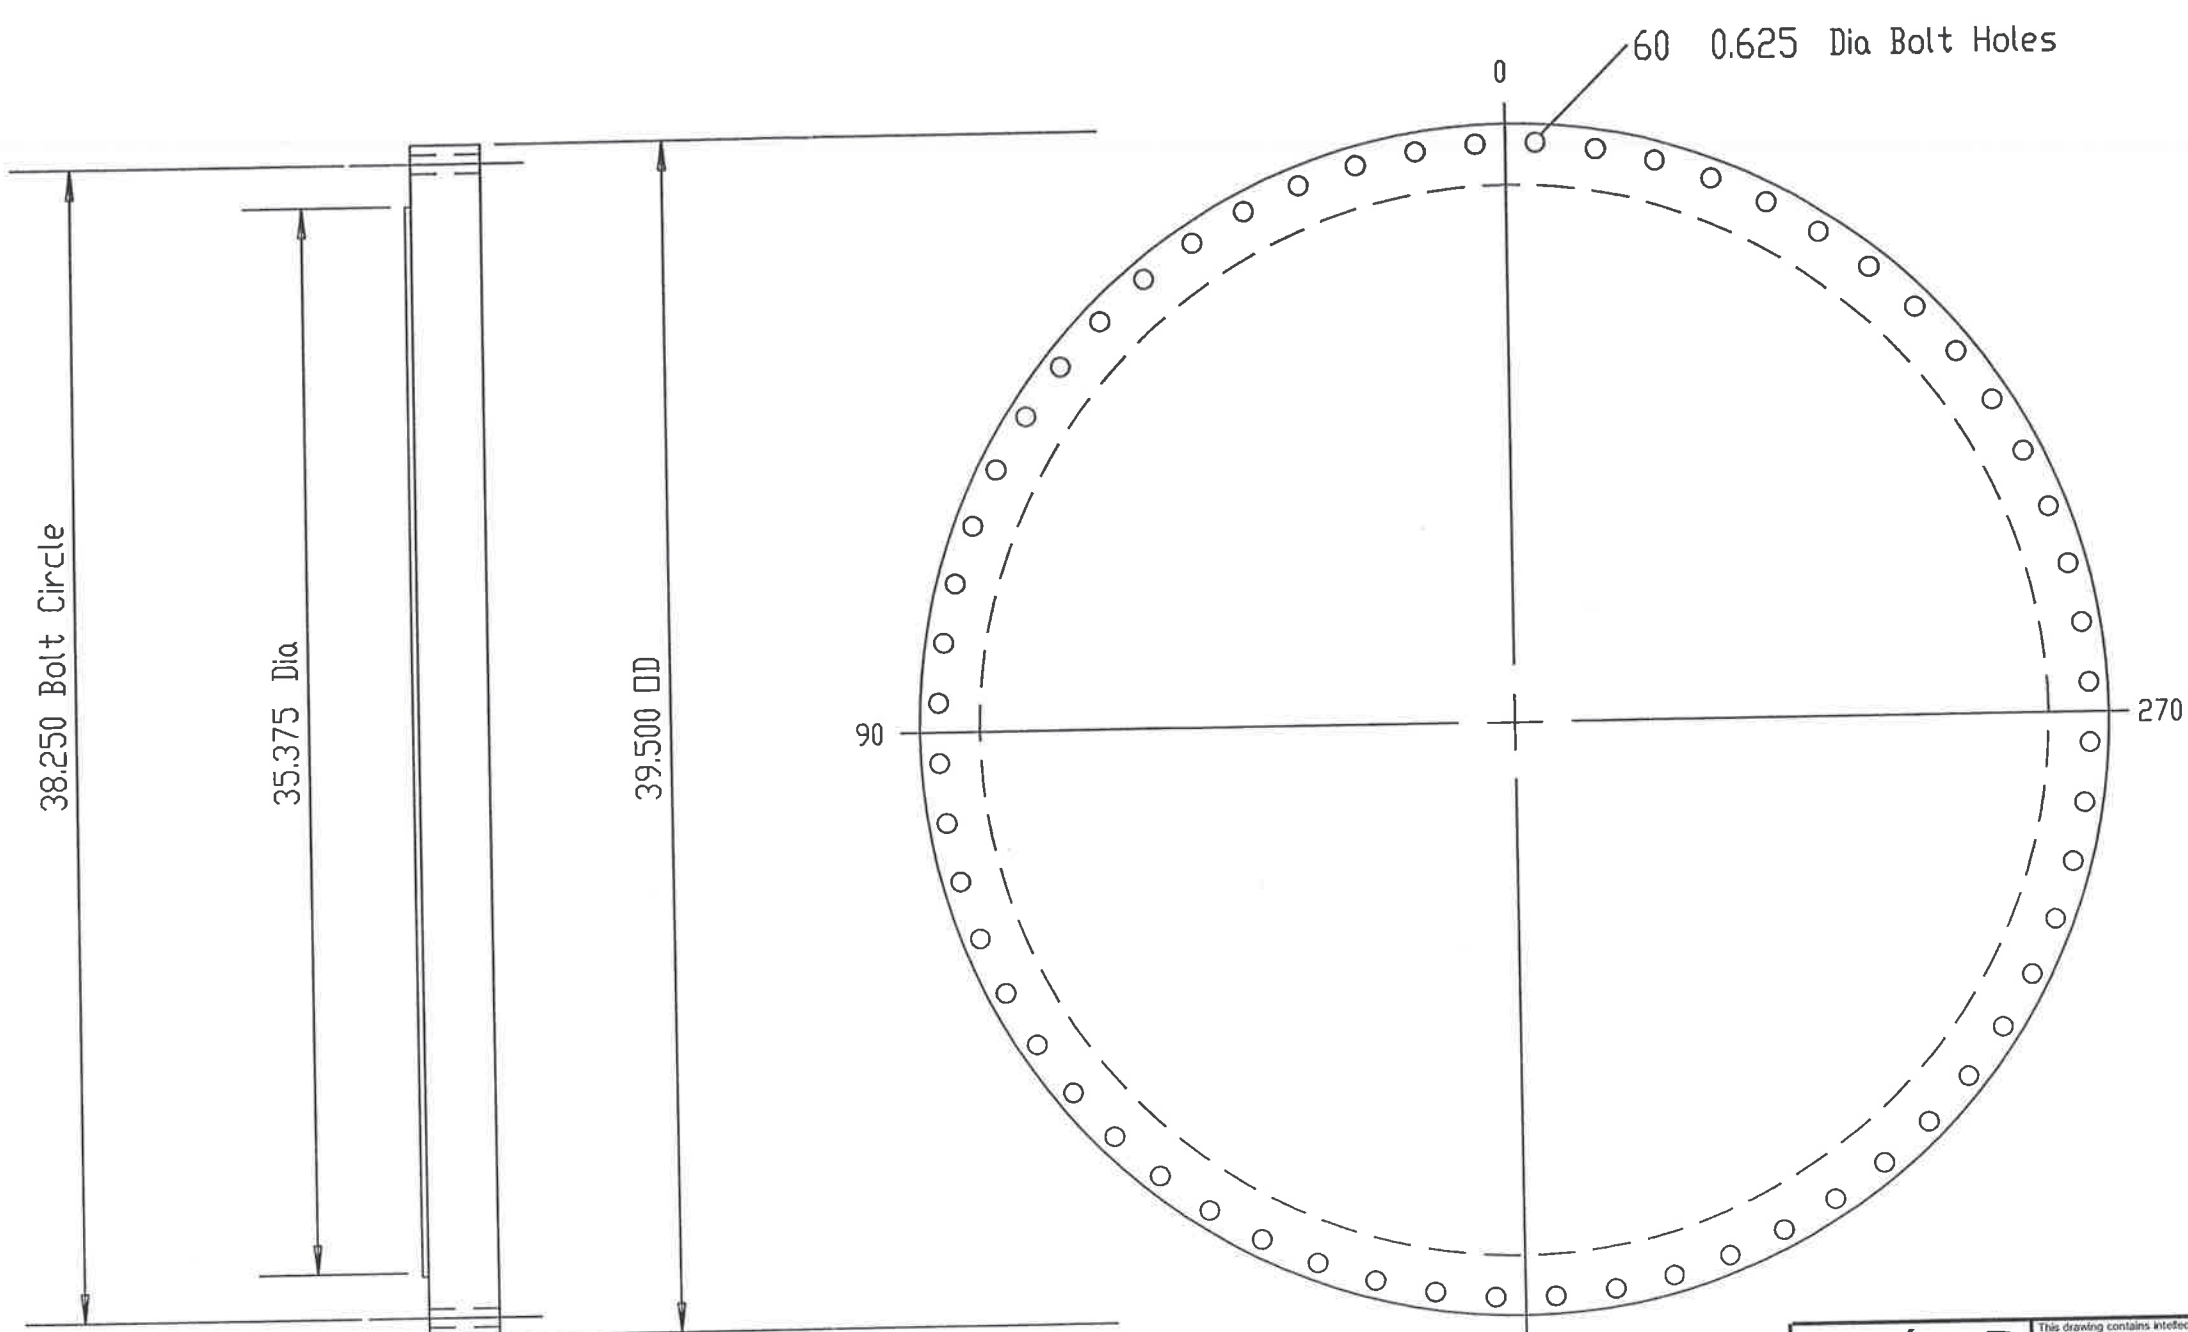

60 0.625 Dia Bolt Holes

38.250 Bolt Circle

35.375 Dia

39.500 OD

90


180

Rear End View

12 Rear TubSh

HT/DCR
Engineering, Inc.
2830 Parkway Street • Lakeland, FL 33811
Phone: 863-964-2880 • Fax: 863-913-1091
Florida Engineering Business License No. 28522

This drawing contains intellectual property of HT/DCR Engineering, Inc. All ideas, designs, arrangements and know-how remain the property of HT/DCR Engineering, Inc. Any use of this information by entities other than the title block named entity is prohibited. Use of this drawing by the title block named entity is limited to the specific 180 block named project. Use on other projects is strictly prohibited.

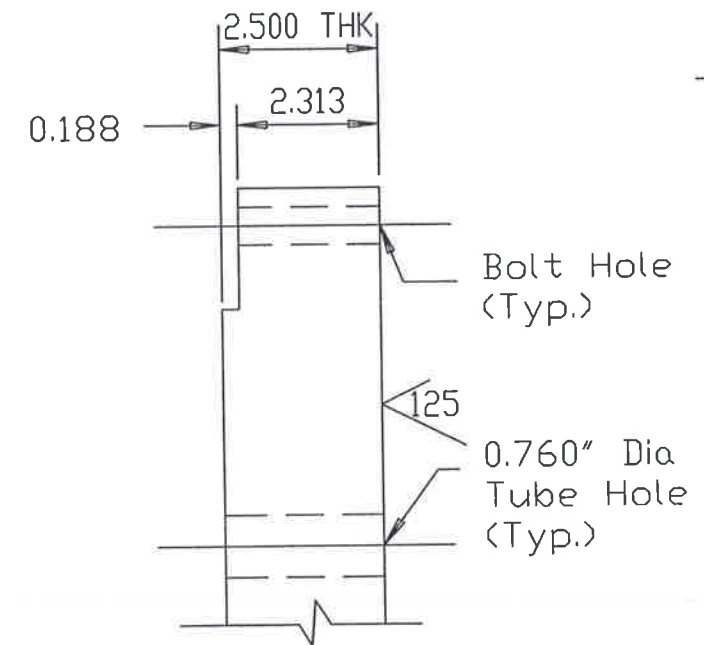


Notes:
All Dimensions In Inches
Bolt holes to straddle centerlines
See Tube Layout E-4401 05 For Tube Hole Locations

Company: DCR
Location: Bunge-Ergon
Product: Condenser
Item No: E-4401
Date: February 26, 2007 Job No: 7793

DCR Construction, Inc
Lakeland, FL

Scale: NTS						ASME VIII-1 2004 A06	Rear Tubesheet Detail	Rev: 2
Rev:	Date:	Description	Dwg	Ckd	Appd	TEMA Type: BEM		
1	08-23-07	Issued for Construction	KFF	DGB	PW	Size: 35-192	Dwg No: E-4401 15	
2	12-04-07	Certified As-Built	AGB	DGB	PW	TEMA Class: C		

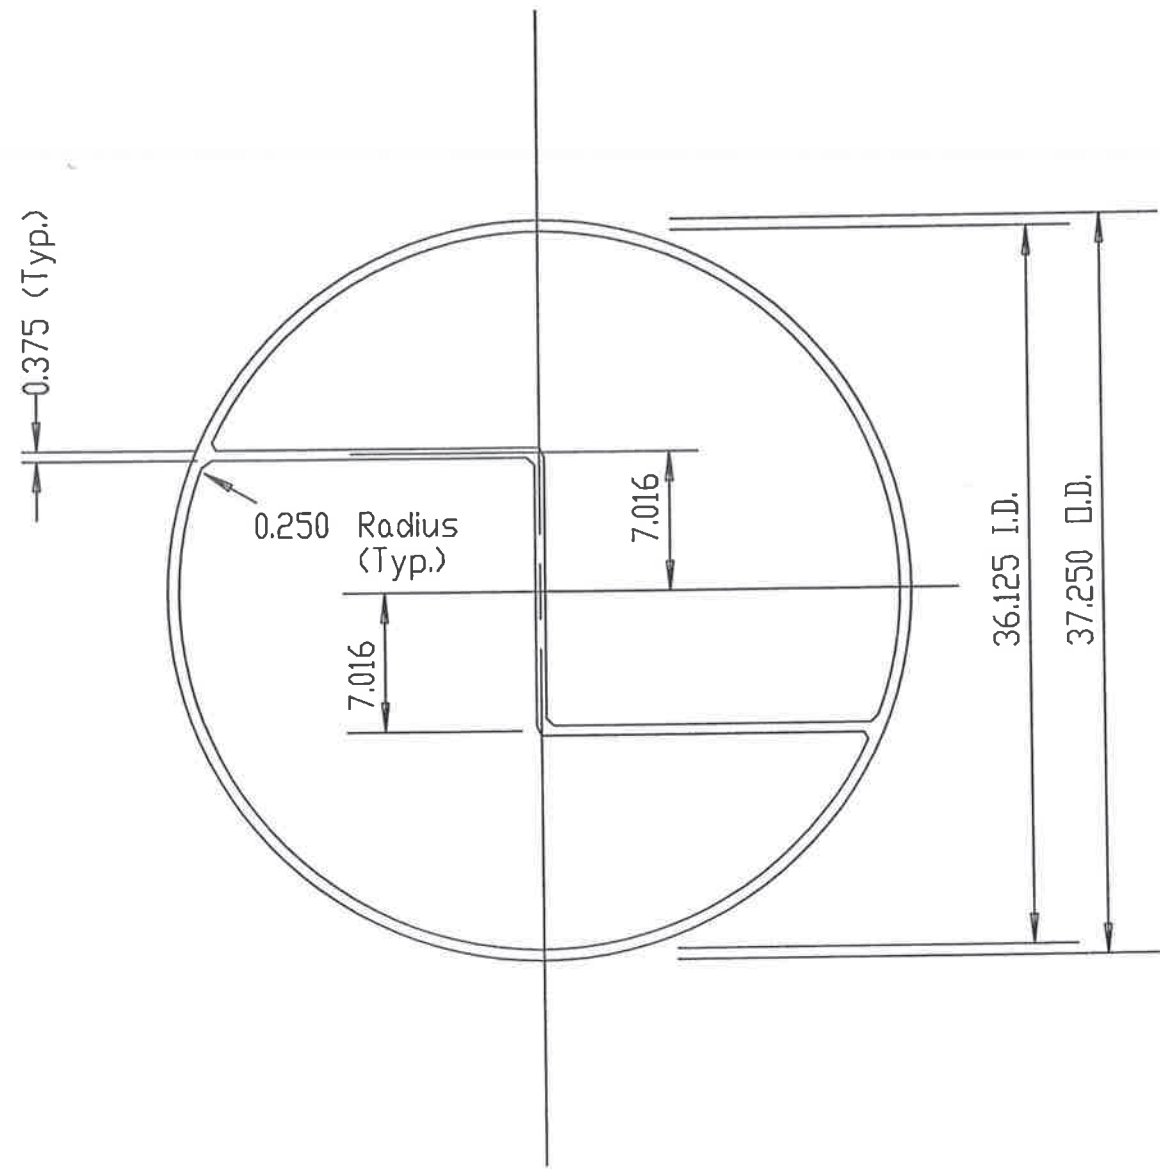

31 Front Head Gaskets at Tbshts

0.125 Thk.

HT/DCR
Engineering, Inc.
2830 Parkway Street • Lakeland, FL 33811
Phone: 863-904-2880 • Fax: 863-913-1091
Florida Engineering Business License No. 26522

This drawing contains intellectual property of HT/DCR Engineering, Inc. All ideas, designs, arrangements and know-how remain the property of HT/DCR Engineering, Inc. Any use of this information by entities other than the title block named entity is prohibited. Use of this drawing by the title block named entity is limited to the specific title block named project. Use on other projects is strictly prohibited.


Notes:
All Dimensions In Inches
Bolt holes to straddle centerlines

Company: DCR
Location: Bunge-Ergon
Product Condenser
Item No.: E-4401
Date: February 26, 2007 Job No.: 7793

DCR Construction, Inc
Lakeland, FL

Scale: NTS

Rev:	Date:	Description	Dwg	Ckd	Appd	ASME VIII-1 2004 A06	Gasket Detail	
1	08-23-07	Issued for Construction	KFF	DGB	PW	TEMA Type: BEM	Dwg No: E-4401 17A	Rev: 2
2	12-04-07	Certified As-Built	AGB	DGB	PW	Size: 35-192 TEMA Class: C		

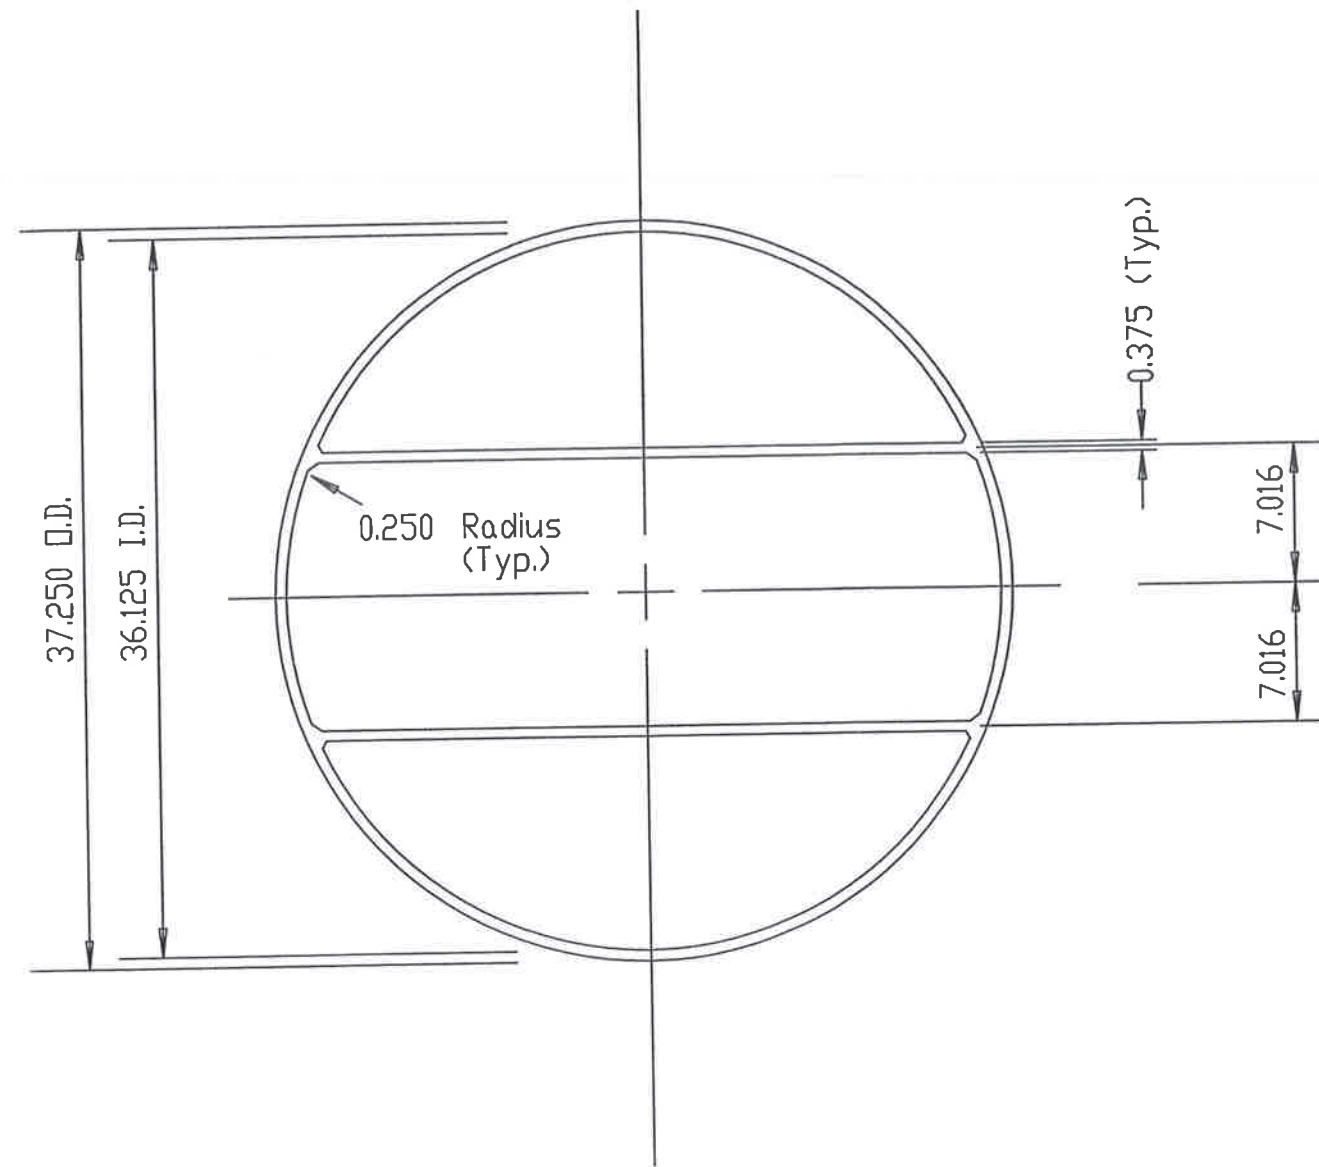

32 Rear Head Gaskets at Tbshts

0.125 Thk.

HT/DCR
Engineering, Inc.
2630 Parkway Street • Lakeland, FL 33811
Phone: 863-904-2800 • Fax: 863-913-1091
Florida Engineering Business License No. 26522

This drawing contains intellectual property of HT/DCR Engineering, Inc. All ideas, designs, arrangements and know-how remain the property of HT/DCR Engineering, Inc. Any use of this information by entities other than the title block named entity is prohibited. Use of this drawing by the title block named entity is limited to the specific title block named project. Use on other projects is strictly prohibited.

Notes:
All Dimensions In Inches
Bolt holes to straddle centerlines

Company: DCR
Location: Bunge-Ergon
Product Condenser
Item No.: E-4401
Date: February 26, 2007 Job No.: 7793

DCR Construction, Inc
Lakeland, FL


Scale: NTS

Rev:	Date:	Description	Dwg	Ckd	Appd	ASME VIII-1 2004 A06
1	08-23-07	Issued for Construction	KFF	DGB	PW	TEMA Type: BEM
2	12-04-07	Certified As-Built	AGB	DGB	PW	Size: 35-192
						TEMA Class: C

Gasket Detail

Dwg No.:
E-4401 17B

Rev:
2

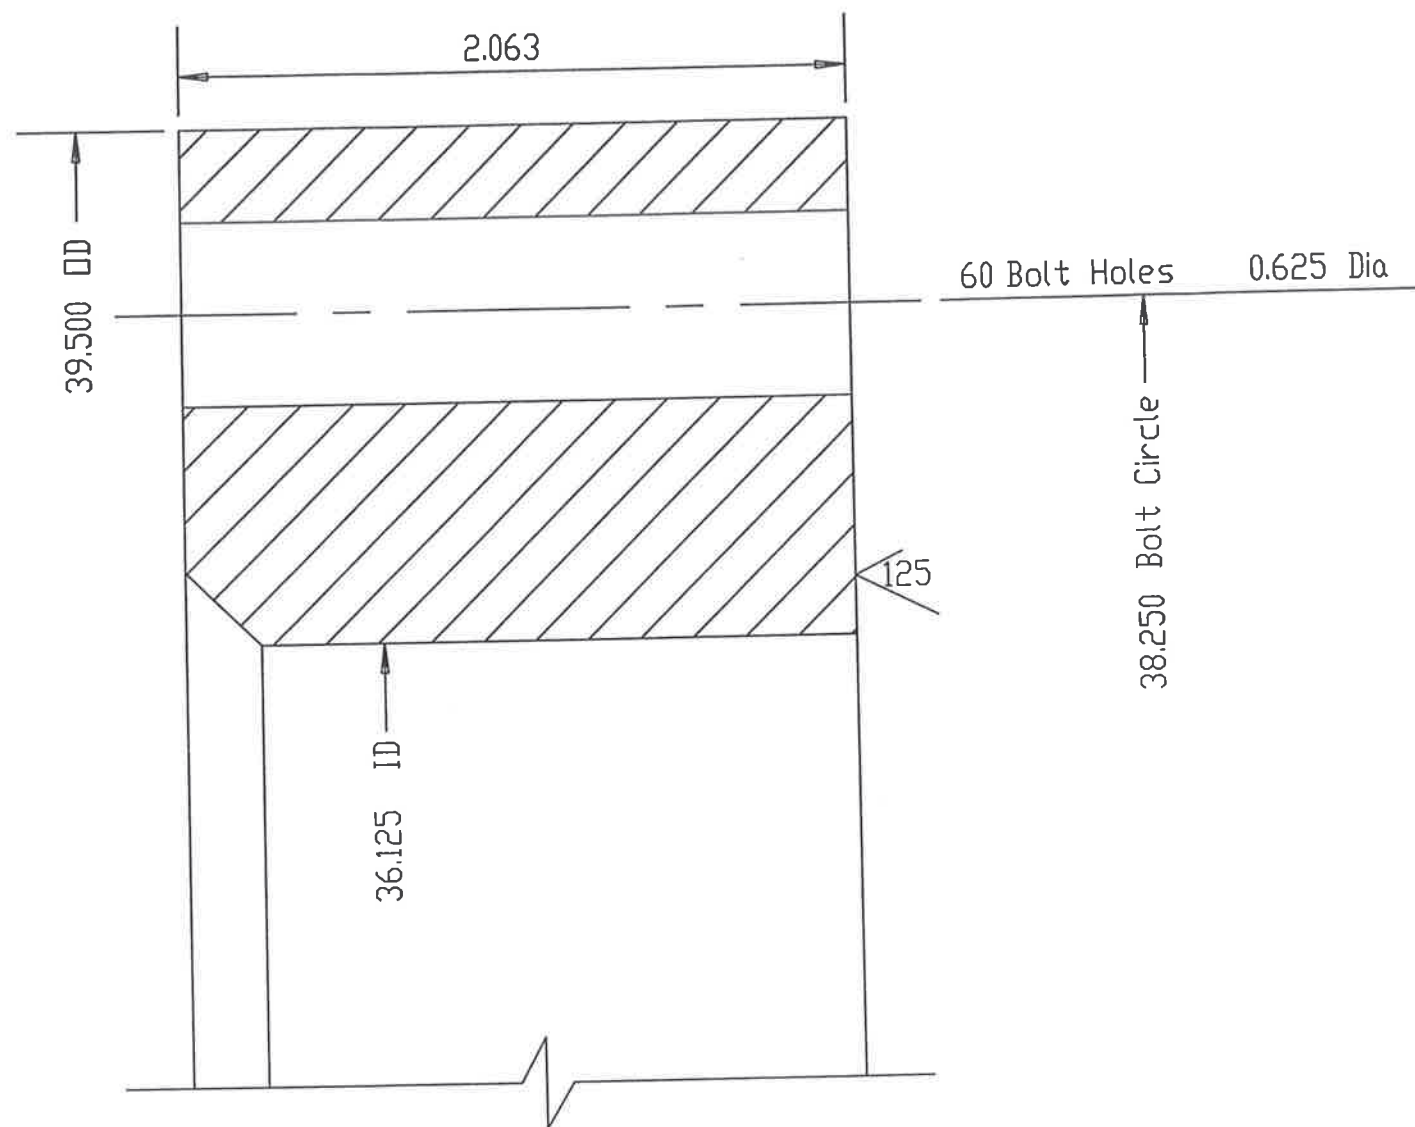

17 Fr Hd Flng TubSh

HT/DCR
Engineering, Inc.
2830 Parkway Street • Lakeland, FL 33811
Phone: 863-904-2890 • Fax: 863-913-1991
Florida Engineering Business License No. 26522


This drawing contains intellectual property of HT/DCR Engineering, Inc. All ideas, designs, arrangements and know-how remain the property of HT/DCR Engineering, Inc. Any use of this information by entities other than the sole block named entity is prohibited. Use of this drawing by the title block named entity is limited to the specific title block named project. Use on other projects is strictly prohibited.

Notes:
All Dimensions In Inches
Bolt holes to straddle centerlines

Company: DCR
Location: Bunge-Ergon
Product Condenser
Item No: E-4401
Date: March 14, 2007 Job No: 7793

DCR Construction, Inc.
Lakeland, Florida

Scale: NTS						ASME VIII-1 2004 A06	Flange Detail	Dwg No: E-4401 18A	Rev: 2
Rev:	Date:	Description	Dwg	Ckd	Appd	TEMA Type: BEM			
1	08-23-07	Issued for Construction	KFF	DGB	PW	Size: 35-192			
2	12-04-07	Certified As-Built	AGB	DGB	PW	TEMA Class: C			

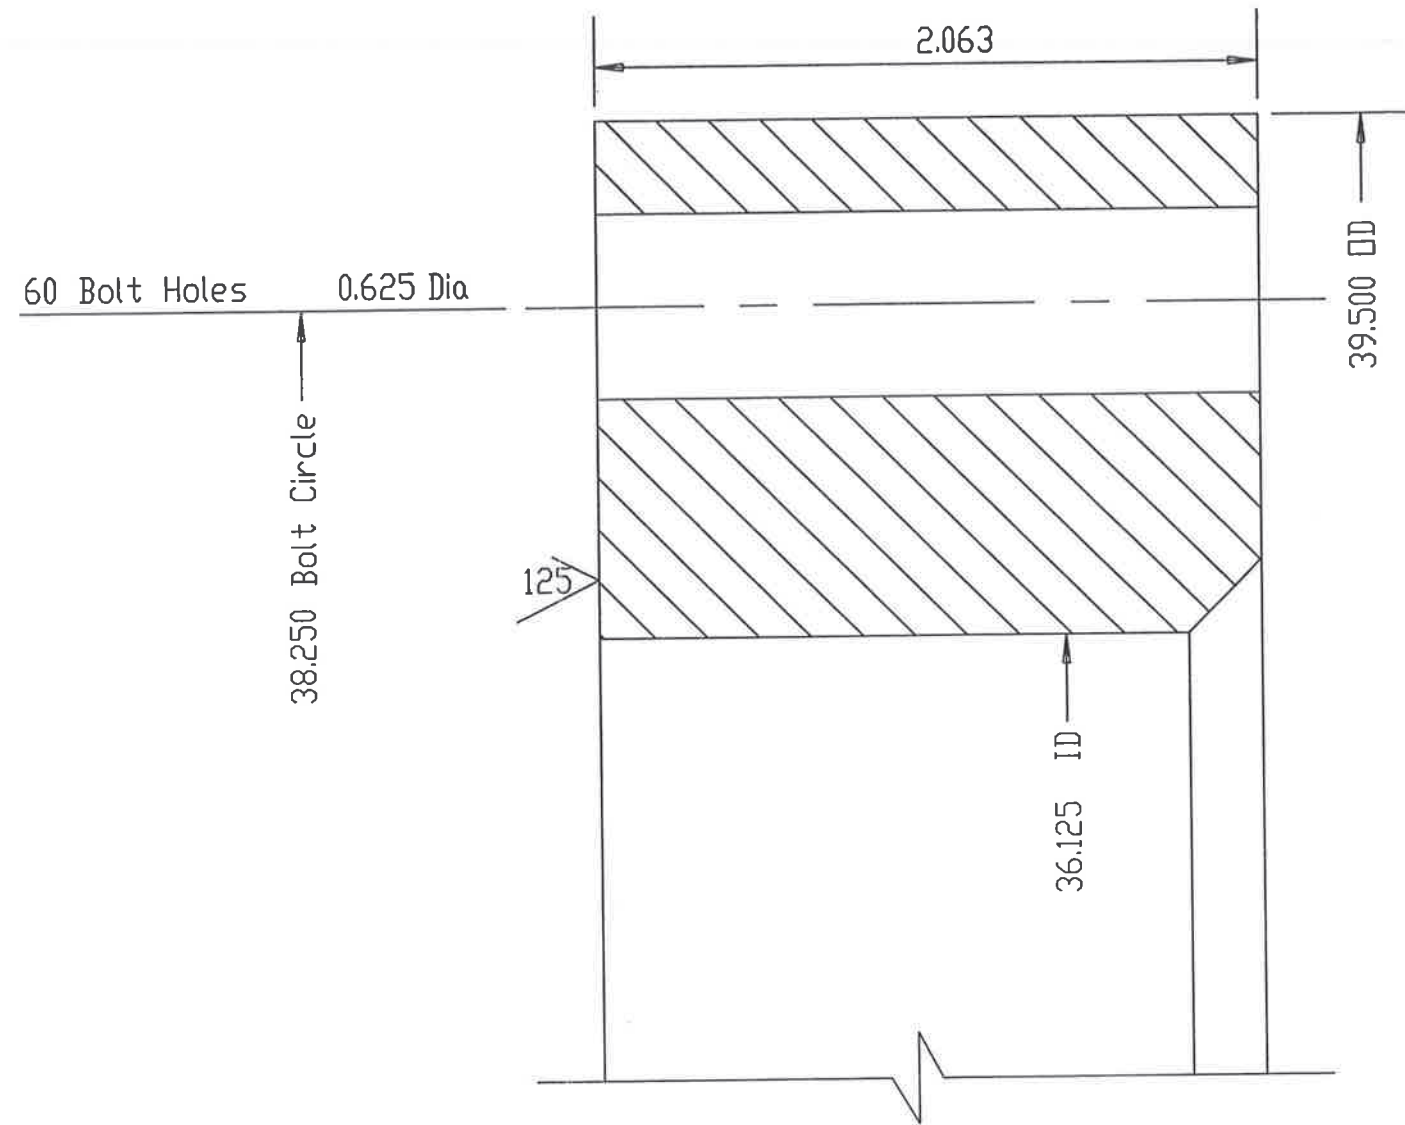


18 Re Hd Flng TubSh


HT/DCR
 Engineering, Inc.
 2830 Parkway Street • Lakeland, FL 33811
 Phone: 863-904-2890 • Fax: 863-913-1091
 Florida Engineering Business License No. 26522

This drawing contains intellectual property of HT/DCR Engineering, Inc. All ideas, designs, arrangements and know-how remain the property of HT/DCR Engineering, Inc. Any use of this information by entities other than the title block named entity is prohibited. Use of this drawing by the title block named entity is limited to the specific title block named project. Use on other projects is strictly prohibited.

Notes: All Dimensions In Inches Bolt holes to straddle centerlines						Company: DCR Location: Bunge-Ergon Product Condenser Item No.: E-4401 Date: March 14, 2007 Job No.: 7793	
						DCR Construction, Inc. Lakeland, Florida	
Scale: NTS						ASME VIII-1 2004 A06	
Rev:	Date:	Description	Dwg	Ckd	Appd	TEMA Type: BEM	
1	08-23-07	Issued for Construction	KFF	DGB	PW	Size: 35-192	
2	12-04-07	Certified As-Built	AGB	DGB	PW	TEMA Class: C	
						Dwg No.: E-4401 18B	Rev: 2

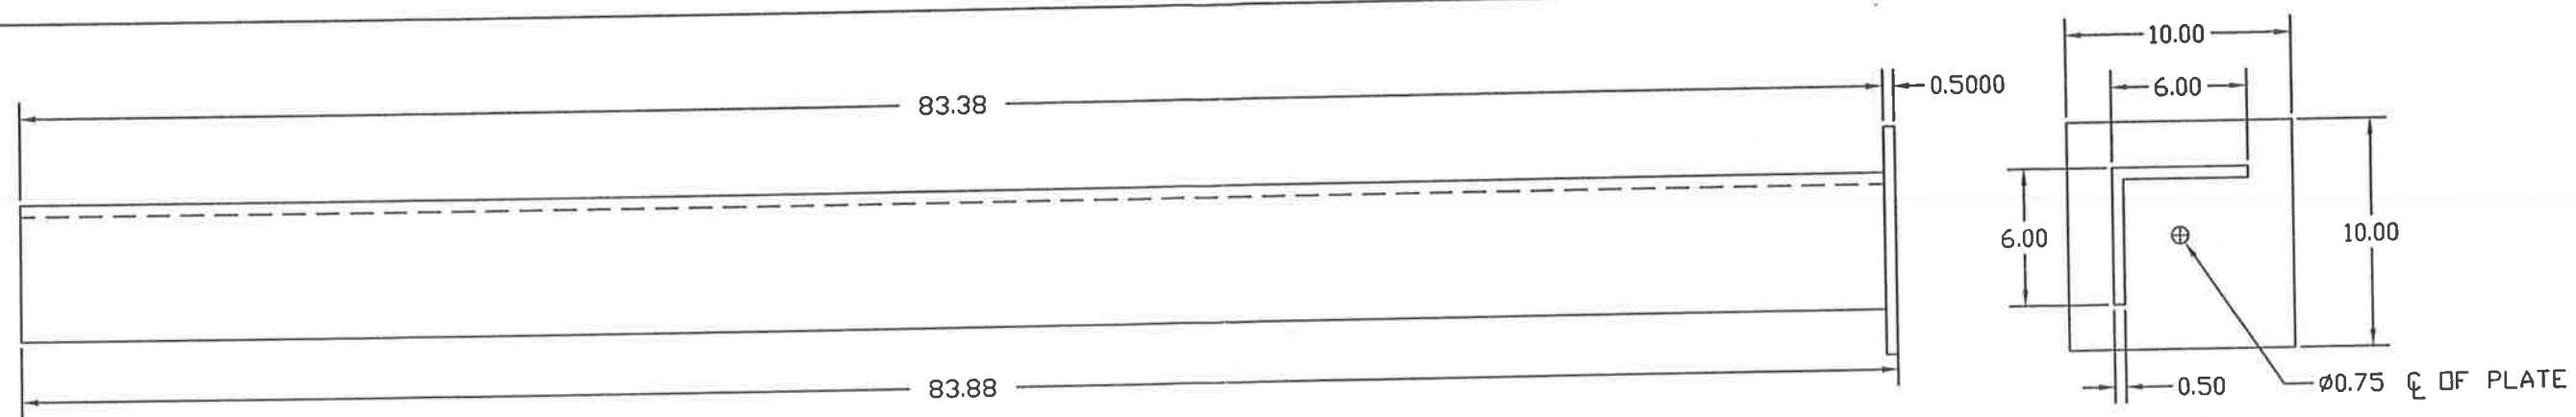


Support Legs - 3 Required

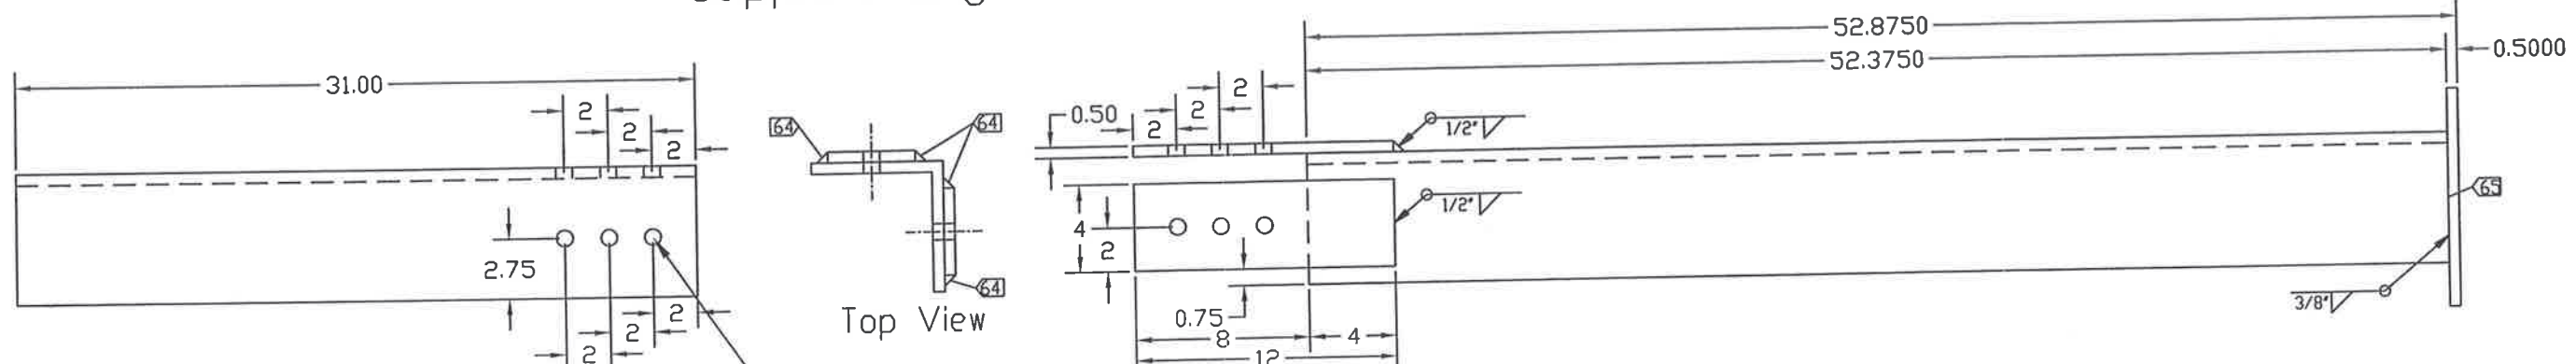

Support Leg - 1 Required
Top Section


Support Leg - 1 Required
Bottom Section

7/8" ϕ holes. Fasten with
3/4" ϕ x 2.25"-A236 Bolt assembly.
Stake nuts to inside of leg.

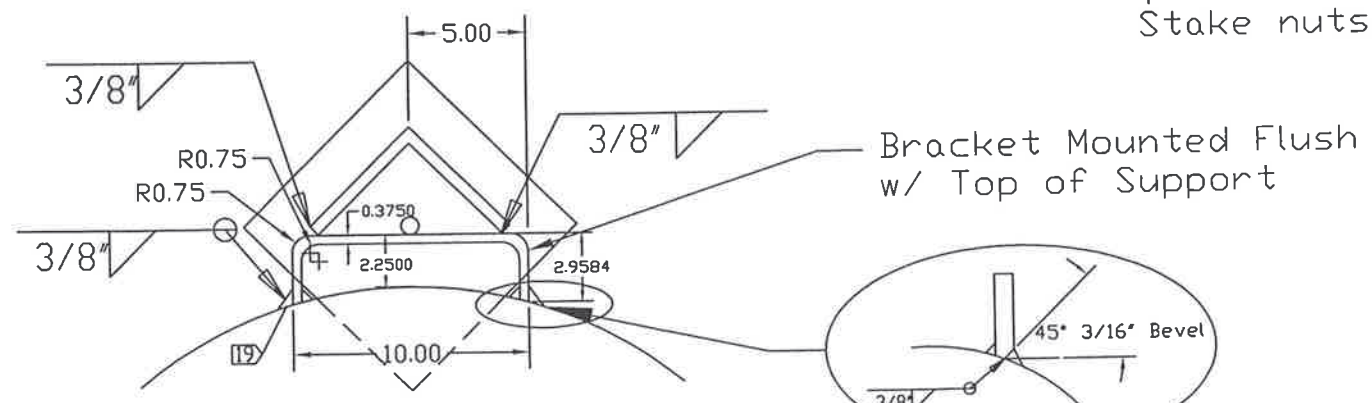

Bracket Mounted Flush
w/ Top of Support

Top View

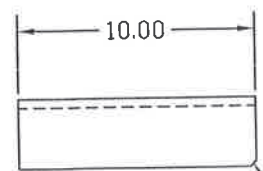

Side View

NOTCH TO CLEAR
WELD ON CLOSURE
PLATE

Support Bracket
4 Required

HT/DCR
Engineering, Inc.


This drawing contains intellectual property of HT/DCR Engineering, Inc. All ideas, designs, arrangements and know-how remain the property of HT/DCR Engineering, Inc. Any use of this information by entities other than the title block named entity is prohibited. Use of this drawing by the title block named entity is limited to the specific title block named project. Use on other projects is strictly prohibited.

Notes:
All Dimensions In Inches

Company: DCR
Location: Bunge-Ergon
Product Condenser
Item No.: E-4401
Date: February 26, 2007 Job No.: 7793

DCR Construction, Inc
Lakeland, FL

Scale: NTS						ASME VIII-1 2004 A06		Leg Support	
Rev:	Date:	Description	Dwg	Ckd	Appd	TEMA Type: BEM		Dwg No.:	
1	08-23-07	Issued for Construction	KFF	DGB	PW	Size: 35-192		E-4401 19	
2	12-04-07	Certified As-Built	AGB	DGB	PW	TEMA Class: C		Rev: 2	

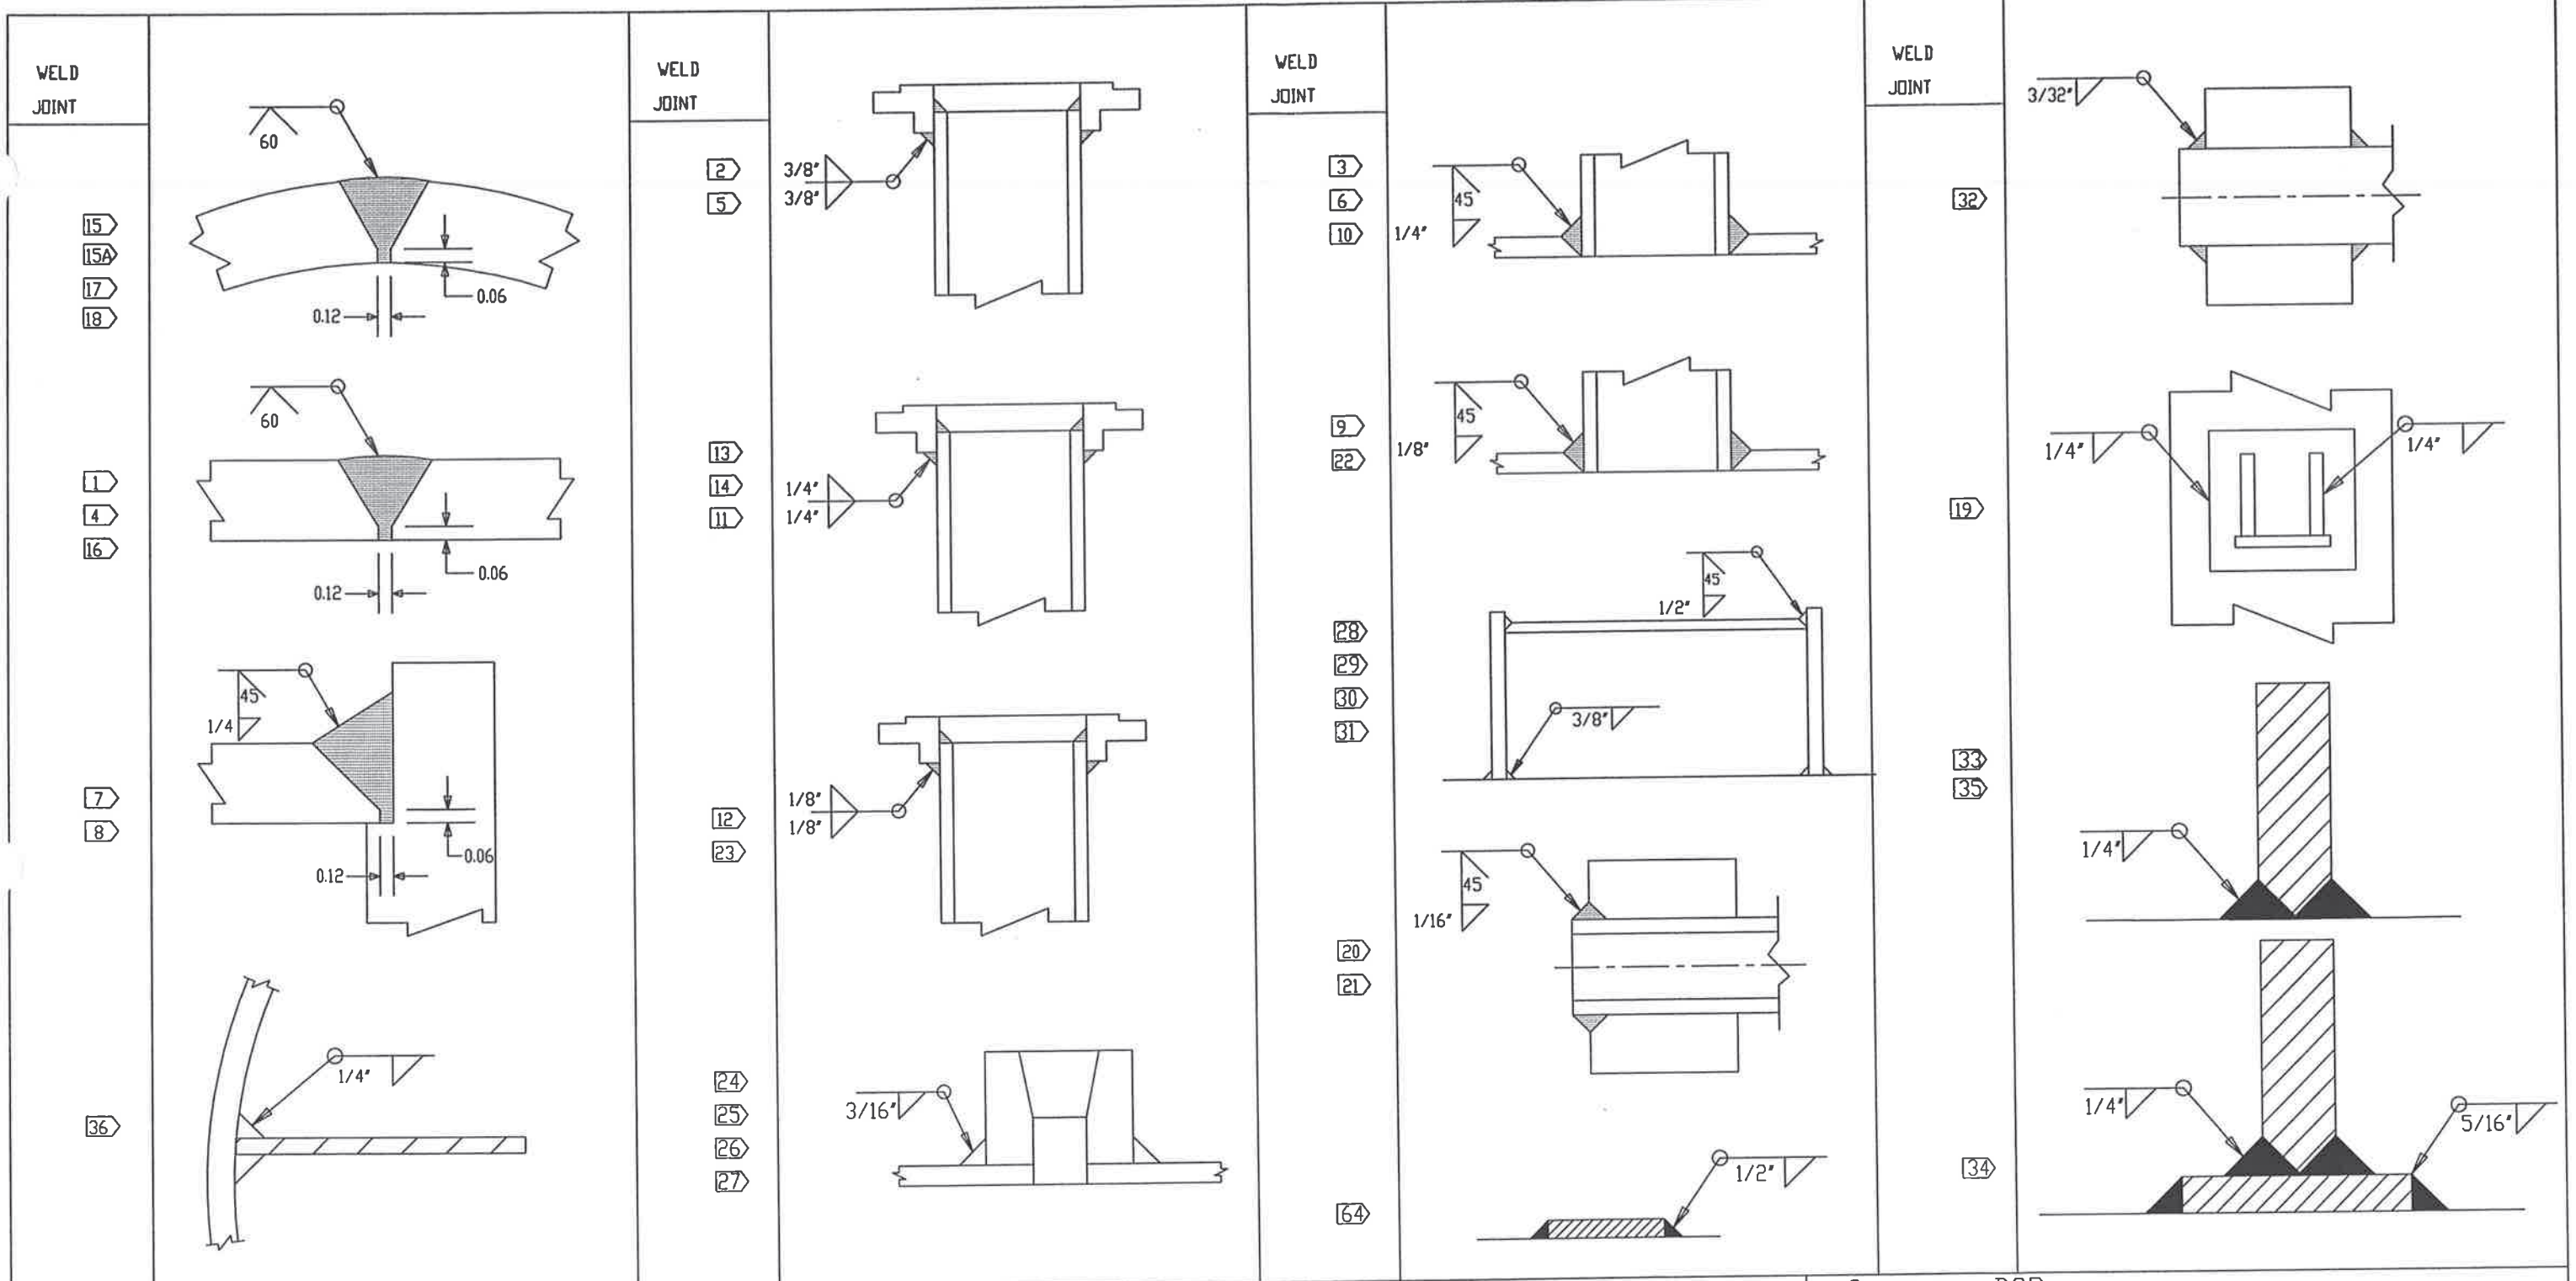


Notes:
 All Dimensions In Inches
 Welding in accordance with Code

Company: DCR
 Location: Bunge-Ergon
 Product Condenser
 Item No: E-4401
 Date: February 26, 2007 Job No: 7793

HT/DCR
 Engineering, Inc.
 2830 Parkway Street • Lakeland, FL 33811
 Phone: 863-904-2580 • Fax: 863-913-1091
 Florida Engineering Business License No. 25322

DCR Construction, Inc
 Lakeland, FL

Scale: NTS						ASME VIII-1 2004 A06		Weld Joint Detail	
Rev:	Date:	Description	Dwg	Ckd	Appd	TEMA Type:	Dwg No.:		Rev:
1	08-23-07	Issued for Construction	KFF	DGB	PW	BEM	E-4401 20		2
2	12-04-07	Certified As-Built	AGB	DGB	PW	Size: 35-192			
						TEMA Class: C			

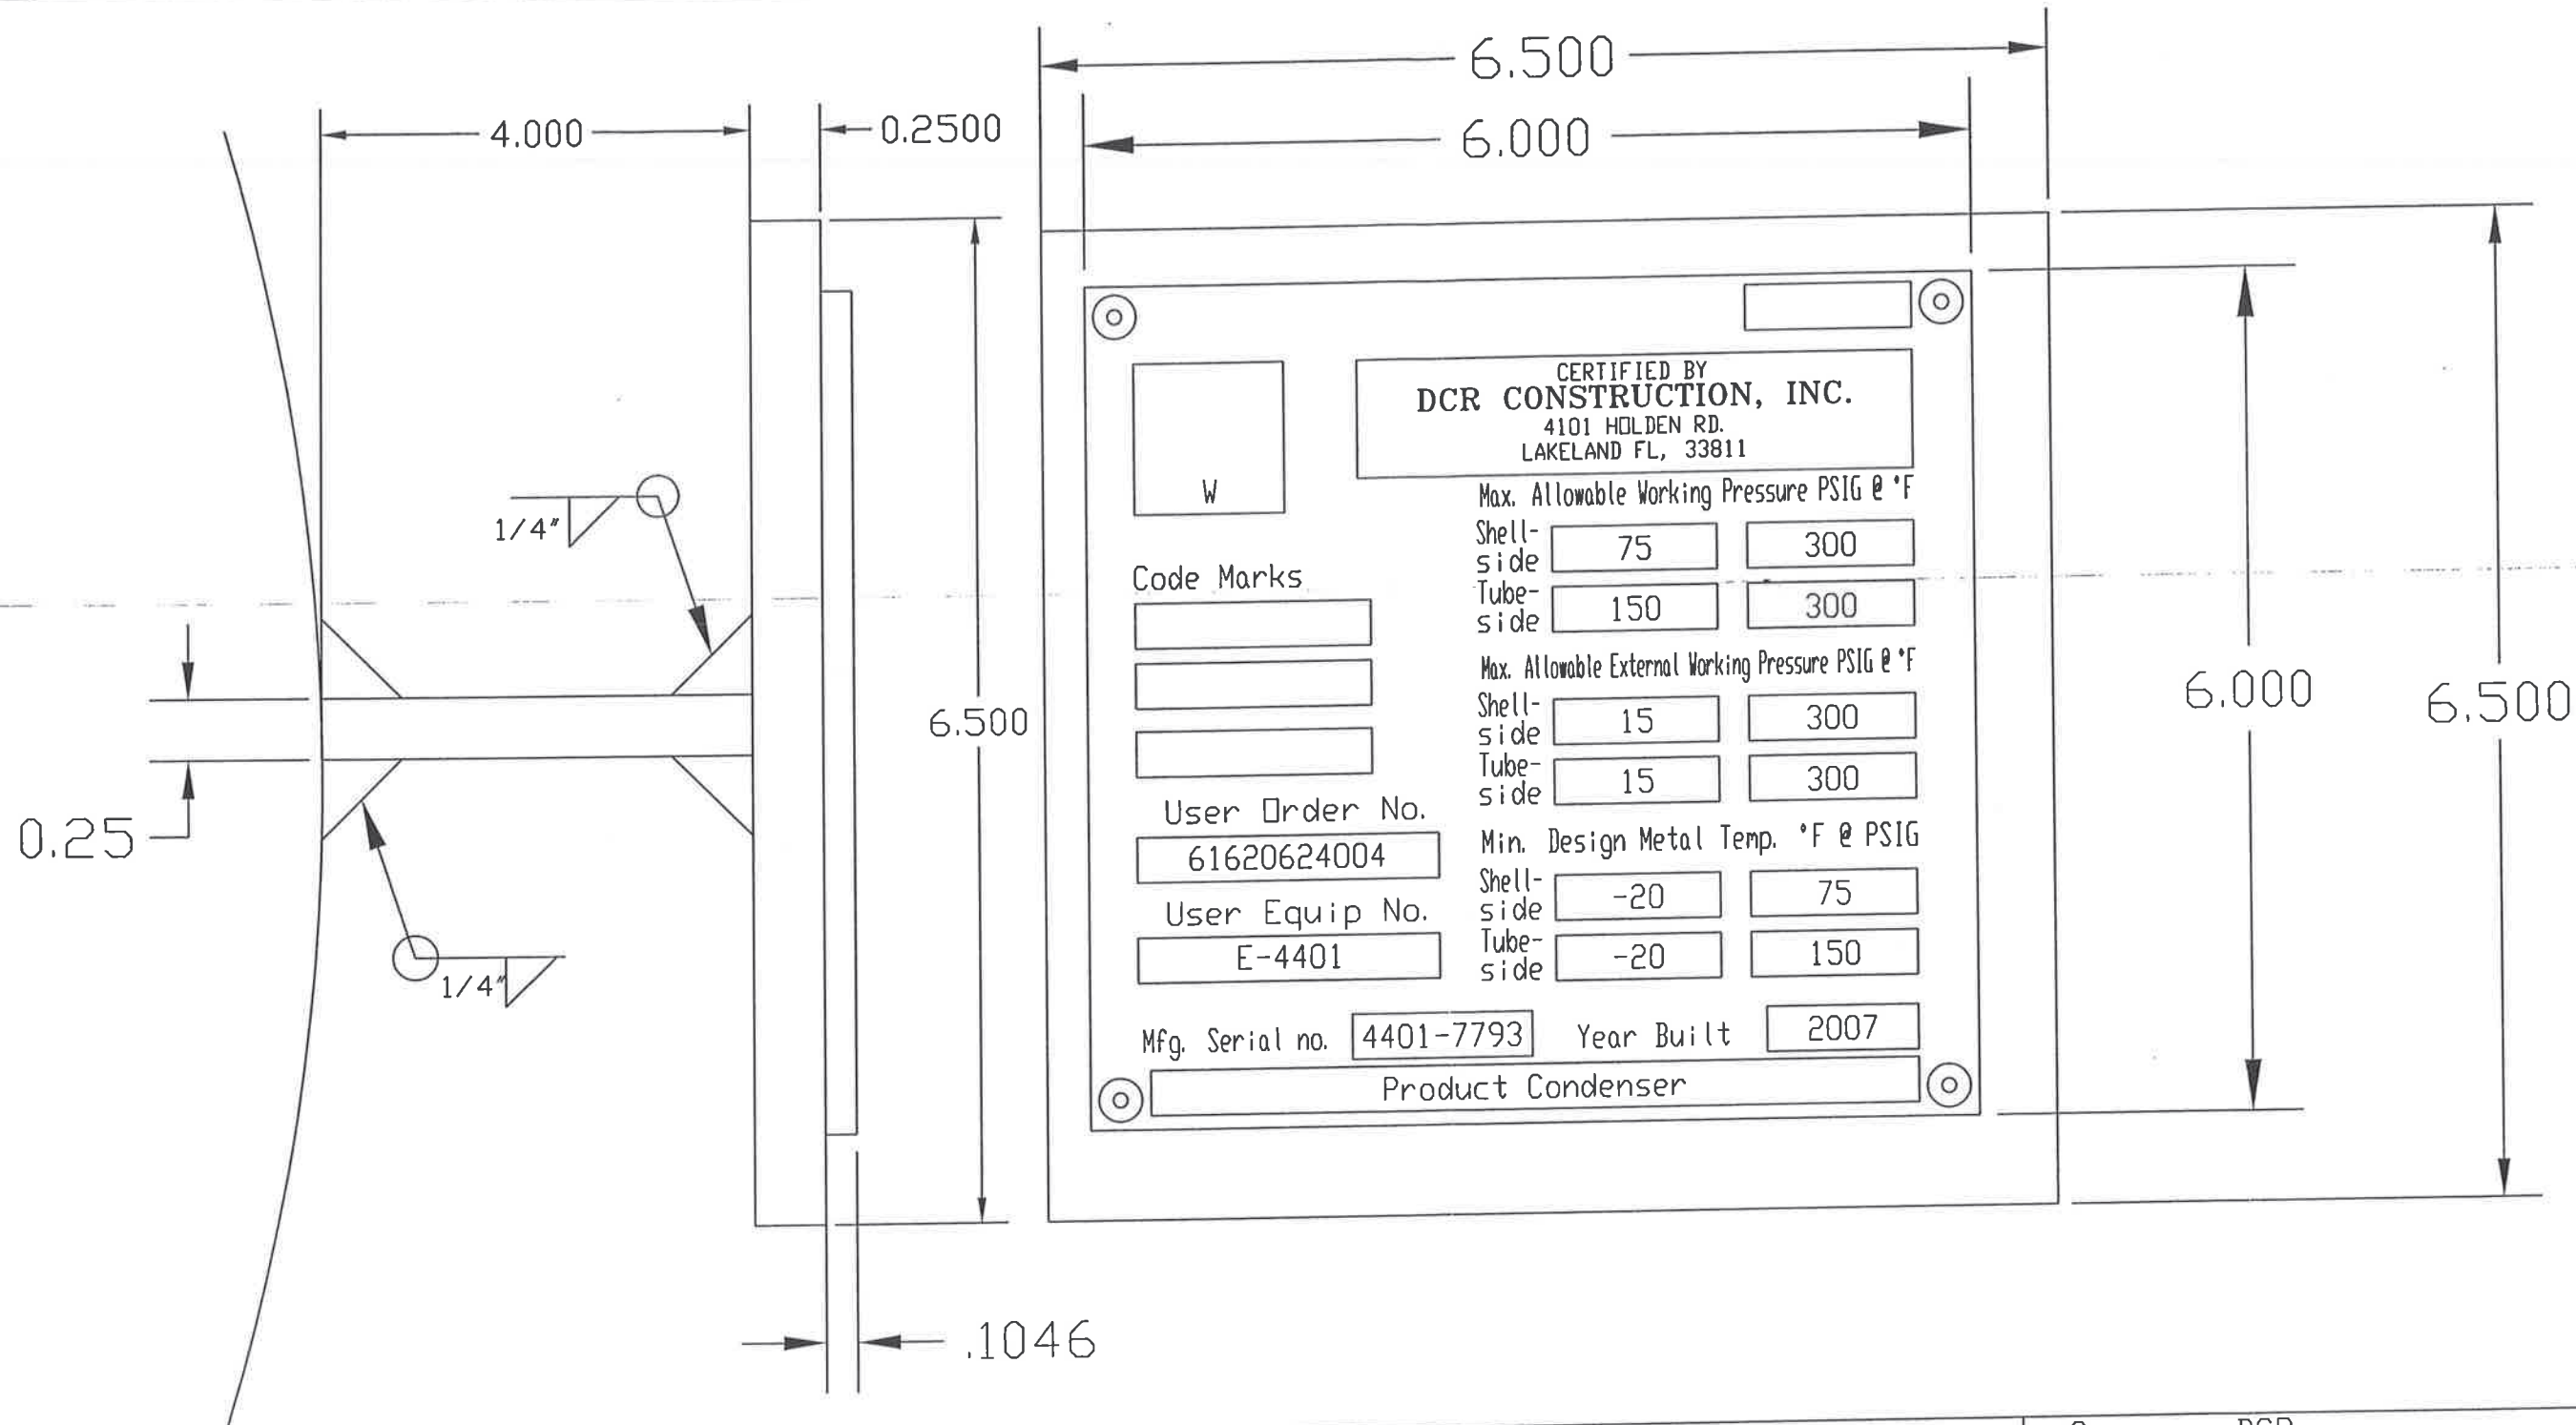

CERTIFIED BY
DCR CONSTRUCTION, INC.
 4101 HOLDEN RD.
 LAKELAND FL, 33811

Max. Allowable Working Pressure PSIG @ °F
 Shell-side 75 300
 Tube-side 150 300

Max. Allowable External Working Pressure PSIG @ °F
 Shell-side 15 300
 Tube-side 15 300

Min. Design Metal Temp. °F @ PSIG
 Shell-side -20 75
 Tube-side -20 150

User Order No. 61620624004
 User Equip No. E-4401
 Mfg. Serial no. 4401-7793 Year Built 2007
 Product Condenser

Notes:
All Dimensions In Inches

Company: DCR
 Location: Bunge-Ergon
 Product Condenser
 Item No.: E-4401
 Date: February 17, 2007 Job No.: 7793


HT/DCR
 Engineering, Inc.
2830 Parkway Street • Lakeland, FL 33811
 Phone: 863-904-2880 • Fax: 863-913-1091
 Florida Engineering Business License No. 26522

DCR Construction, Inc
 Lakeland, FL


Scale: NTS

Rev:	Date:	Description	Dwg	Ckd	Appd	ASME VIII-1 2004 A06	Code Data Plate
0	08-24-07	ISSUED FOR CONSTRUCTION	KFF	DGB	PW	TEMA Type: BEM	Dwg No.: E-4401 22
1	12-04-07	CERTIFIED AS-BUILT	AGB	DGB	PW	Size: 71-264 TEMA Class: C	

Rev: 1

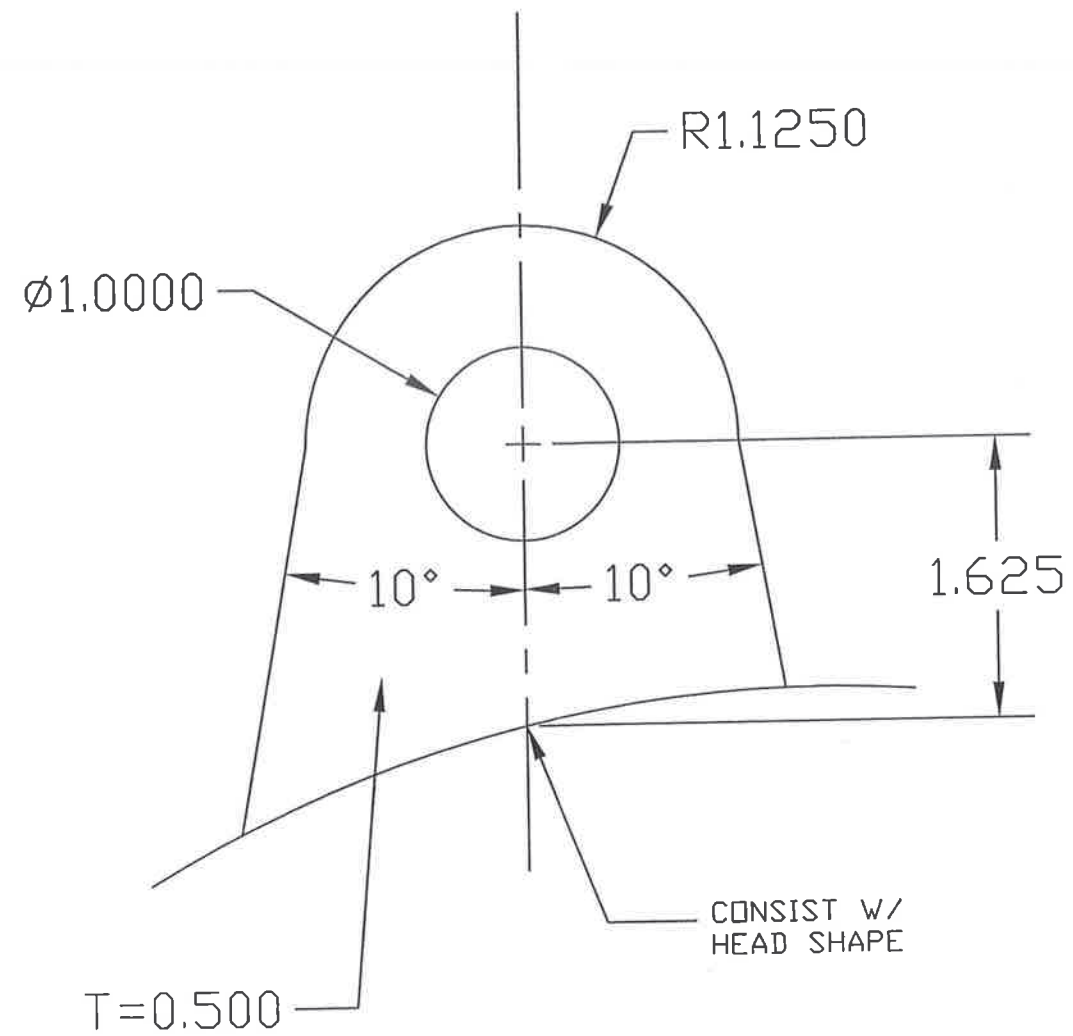

TOP LIFTING LUG
2 REQUIRED

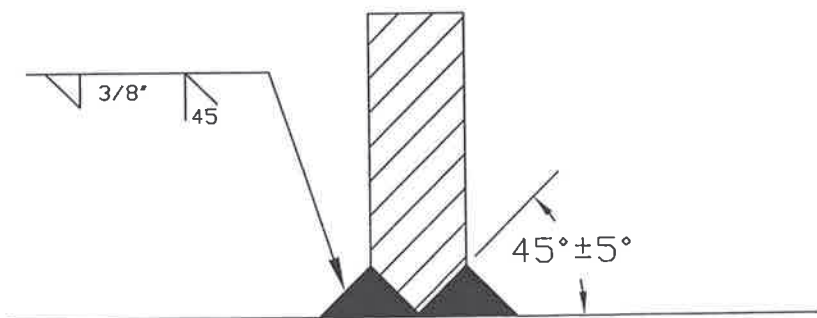

HT/DCR
Engineering, Inc.
Florida Engineering Business License No. 26522



This drawing contains intellectual property of HT/DCR Engineering, Inc. All ideas, designs, arrangements and know-how remain the property of HT/DCR Engineering, Inc. Any use of this information by entities other than the title block named entity is prohibited. Use of this drawing by the title block named entity is limited to the specific title block named project. Use on other projects is strictly prohibited.

Notes:
All Dimensions In Inches


Company: DCR
Location: Bunge-Ergon
Product Condenser
Item No.: E-4401
Date: February 26, 2007 Job No.: 7793

DCR Construction, Inc
Lakeland, FL

Scale: NTS						ASME VIII-1 2004 A06	Lifting Lug Detail	Dwg No: E-4401 23A	Rev: 2
Rev:	Date:	Description	Dwg	Ckd	Appd	TEMA Type: BEM			
1	08-23-07	Issued for Construction	KFF	DGB	PW	Size: 35-192			
2	12-04-07	Certified As-Built	AGB	DGB	PW	TEMA Class: C			

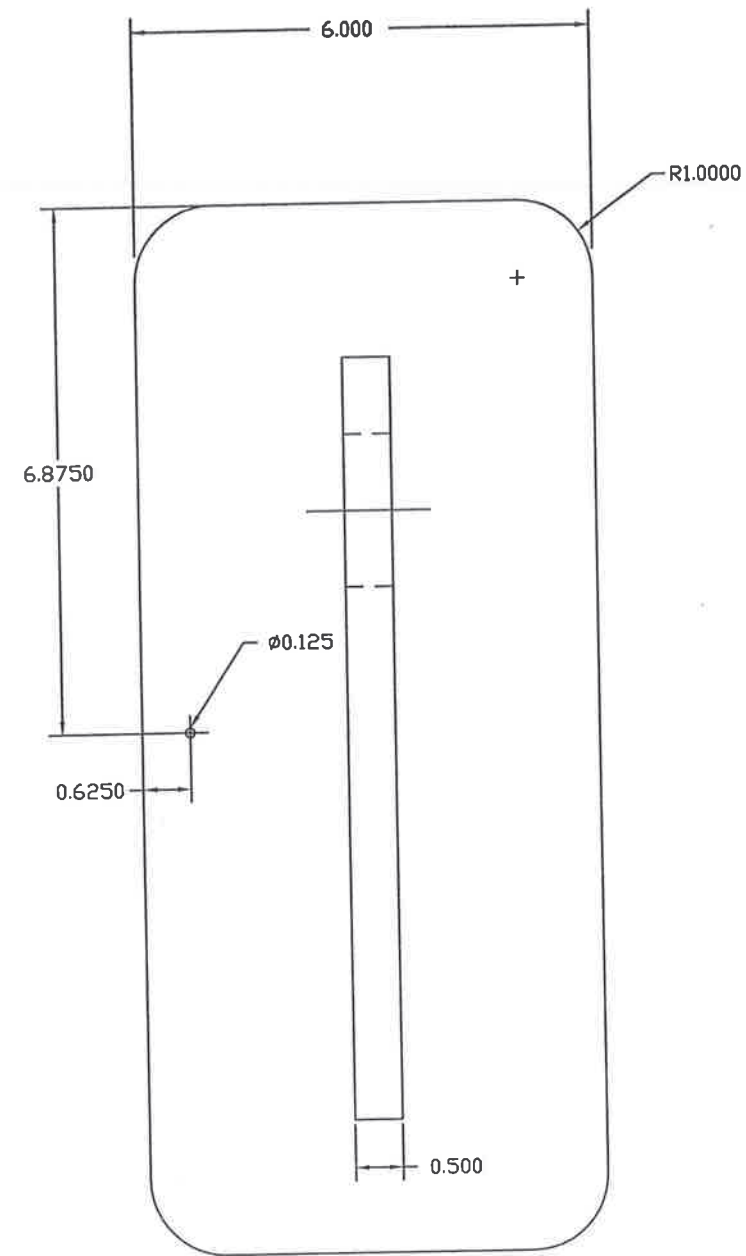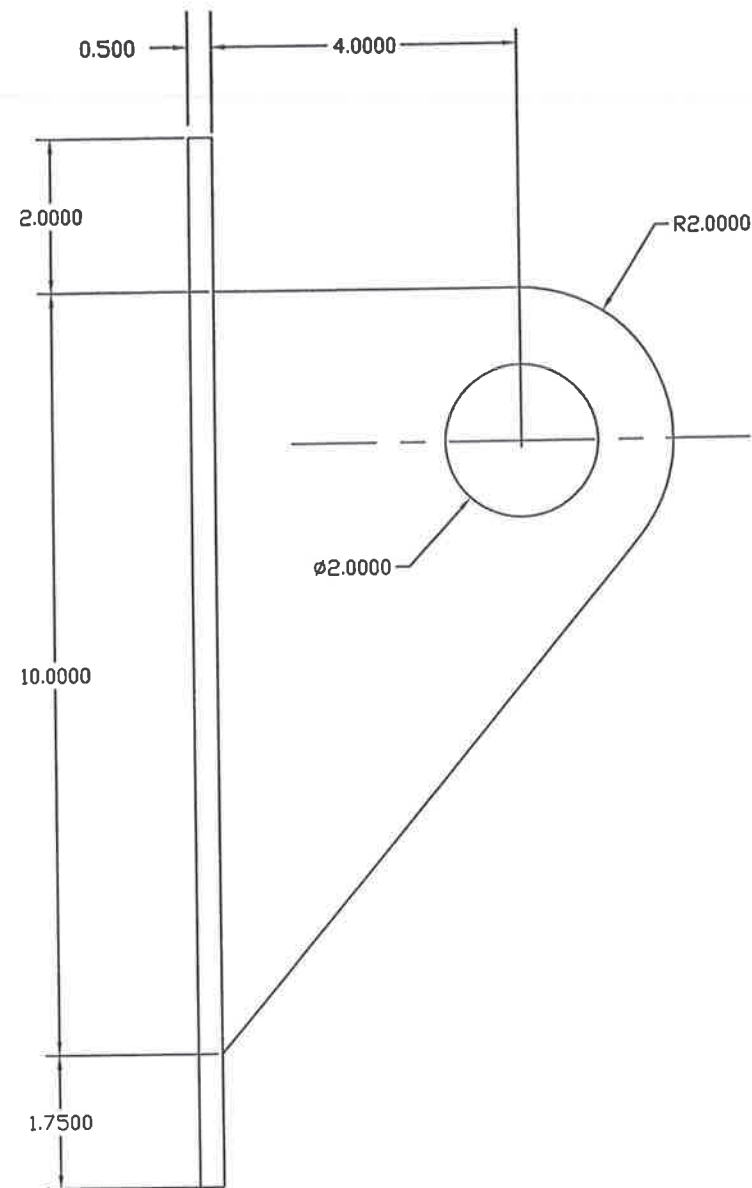

LIFTING LUG
3 REQUIRED

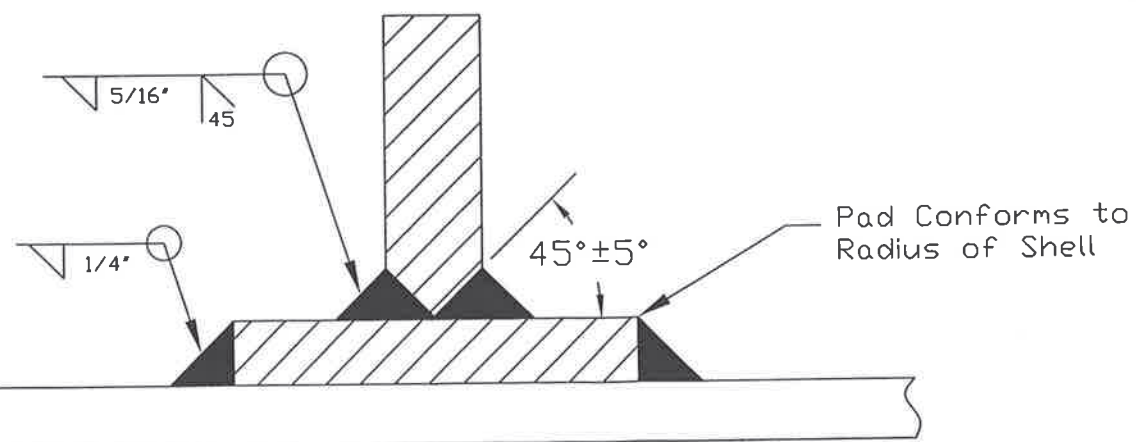

HT/DCR
Engineering, Inc.
2830 Parkway Street • Lakeland, FL 33811
Phone: 863-904-2880 • Fax: 863-913-1091
Florida Engineering Business License No. 26522

This drawing contains intellectual property of HT/DCR Engineering, Inc. All ideas, designs, arrangements and know-how remain the property of HT/DCR Engineering, Inc. Any use of this information by entities other than the title block named entity is prohibited. Use of this drawing by the title block named entity is limited to the specific 086 block named project. Use on other projects is strictly prohibited.

Notes:
All Dimensions In Inches

Company: DCR
Location: Bunge-Ergon
Product: Condenser
Item No.: E-4401
Date: March 13, 2007 Job No.: 7793

DCR Construction, Inc
Lakeland, FL

Scale: NTS						ASME VIII-1 2004 A06	Lifting Lug Detail
Rev:	Date:	Description	Dwg	Ckd	Appd		
1	08-23-07	Issued for Construction	KFF	DGB	PW	Size: 35-192	Dwg No.: E-4401 23B
2	12-04-07	Certified As-Built	AGB	DGB	PW	TEMA Class: C	
							Rev: 2

ID	Task Name	Start	Finish	% Complete	July 2007							August 2007							September 2007																
					9	12	15	18	21	24	27	30	3	6	9	12	15	18	21	24	27	30	2	5	8	11	14	17	20	23	26	29	1	4	7
1	Bunge-Ergon #4500142848 (DCR in KY)	Mon 6/25/07	Wed 9/19/07	58%	[Gantt bar spanning from Mon 6/25/07 to Wed 9/19/07]																														
2	E-4501 1st Effect Evaporator	Fri 6/29/07	Wed 9/19/07	59%	[Gantt bar spanning from Fri 6/29/07 to Wed 9/19/07]																														
3	E-4502 2nd Effect Evaporator	Wed 6/27/07	Mon 9/17/07	62%	[Gantt bar spanning from Wed 6/27/07 to Mon 9/17/07]																														
4	E-4503 3rd Effect Evaporator	Mon 6/25/07	Fri 9/14/07	66%	[Gantt bar spanning from Mon 6/25/07 to Fri 9/14/07]																														
5	E-4504 Evaporator Condenser	Tue 8/28/07	Tue 9/11/07	0%	[Gantt bar spanning from Tue 8/28/07 to Tue 9/11/07]																														
6	Bunge-Ergon #4500142848- Change Order #1	Mon 4/23/07	Mon 4/23/07	100%	[Gantt bar spanning from Mon 4/23/07 to Mon 4/23/07]																														
7	Ladders and Platforms	Mon 4/23/07	Mon 4/23/07	100%	[Gantt bar spanning from Mon 4/23/07 to Mon 4/23/07]																														
8	Bunge-Ergon #4500142970 (DCR in TX)	Thu 5/31/07	Fri 9/14/07	55%	[Gantt bar spanning from Thu 5/31/07 to Fri 9/14/07]																														
9	E-2101 Slurry Mix Tank Vent Condenser	Thu 5/31/07	Mon 8/20/07	100%	[Gantt bar spanning from Thu 5/31/07 to Mon 8/20/07]																														
10	E-4101 Beer Column Reboiler	Thu 5/31/07	Wed 8/29/07	25%	[Gantt bar spanning from Thu 5/31/07 to Wed 8/29/07]																														
11	E-4102 Beer Column Vent Condenser	Tue 7/3/07	Thu 8/23/07	10%	[Gantt bar spanning from Tue 7/3/07 to Thu 8/23/07]																														
12	E-4103 Beer Column Feed Heater	Mon 6/18/07	Mon 8/20/07	100%	[Gantt bar spanning from Mon 6/18/07 to Mon 8/20/07]																														
13	E-4201 Reflux Condenser	Tue 7/3/07	Fri 9/14/07	5%	[Gantt bar spanning from Tue 7/3/07 to Fri 9/14/07]																														
14	E-4202 Stripper Column Reboiler	Thu 5/31/07	Mon 8/20/07	100%	[Gantt bar spanning from Thu 5/31/07 to Mon 8/20/07]																														
15	E-4203 Reflux Vent Condenser	Thu 5/31/07	Mon 8/20/07	100%	[Gantt bar spanning from Thu 5/31/07 to Mon 8/20/07]																														
16	E-4301 Superheater	Thu 5/31/07	Mon 8/20/07	100%	[Gantt bar spanning from Thu 5/31/07 to Mon 8/20/07]																														
17	E-4303 Regen Vacuum Condenser	Tue 7/3/07	Sat 9/1/07	5%	[Gantt bar spanning from Tue 7/3/07 to Sat 9/1/07]																														
18	E-4304 Regen Preheater	Fri 6/8/07	Mon 8/20/07	100%	[Gantt bar spanning from Fri 6/8/07 to Mon 8/20/07]																														
19	E-4305 DD&E Condensate Preheater	Thu 5/31/07	Mon 8/20/07	100%	[Gantt bar spanning from Thu 5/31/07 to Mon 8/20/07]																														
20	E-4401 Product Condenser	Fri 6/8/07	Sat 9/1/07	5%	[Gantt bar spanning from Fri 6/8/07 to Sat 9/1/07]																														
21	E-7201 Flash Recovery Condenser	Mon 6/25/07	Thu 8/23/07	20%	[Gantt bar spanning from Mon 6/25/07 to Thu 8/23/07]																														
22	E-7601 Process Condensate Heater	Thu 5/31/07	Mon 8/20/07	100%	[Gantt bar spanning from Thu 5/31/07 to Mon 8/20/07]																														
23	E-7602 Dilute Caustic Heater	Thu 5/31/07	Mon 8/20/07	100%	[Gantt bar spanning from Thu 5/31/07 to Mon 8/20/07]																														

Heat Exchanger Specification Sheet

1	Company: DELTA-T CORPORATION	Phone: (757) 220-2955	
2	Location: WILLIAMSBURG, VIRGINIA	Fax: (757) 229-1705	L2357 REV C
3	Service of Unit: PRODUCT CONDENSER		
4	Item No.: E4401	Your Reference: 50MM GPY	Job No.: 61310 Bunge-Ergon Vicksburg, LLC
5	Date: 6 February 2007	Prepared by: RS	Checked by: AC
6	Size 35 / 192 in	Type BEM	vert Connected in 1 parallel 1 series
7	Surf/unit(eff.) 3482.9 ft2	Shells/unit 1	Surf/shell (eff.) 3482.9 ft2
8	PERFORMANCE OF ONE UNIT		
9	Fluid allocation	Shell Side	Tube Side
10	Fluid name	FINAL PRODUCT VAPOR COOLING WATER	
11	Fluid quantity, Total	5711 124185	
12	Vapor (In/Out)	5709 4	
13	Liquid	5705	124185 124185
14	Noncondensable	2	
15			
16	Temperature (In/Out)	F 250 115	85 105
17	Dew / Bubble point	F 134.78	
18	Density	lb/ft3 0.036 47.453	62.264 62.064
19	Viscosity	cp 0.011 0.754	0.81 0.648
20	Molecular wt, Vap	45.79 45.23	
21	Molecular wt, NC	44.01	
22	Specific heat	BTU/(lb*F) 0.4507 0.6568	1.0008 1.0002
23	Thermal conductivity	BTU/(ft*h*F) 0.013 0.097	0.35 0.359
24	Latent heat	BTU/lb 371.3 379	
25	Pressure	psi 6	40
26	Velocity	ft/s 14.52	0.85
27	Pressure drop, allow./calc.	psi 1 0.028	15 0.214
28	Fouling resist. (min)	ft2*h*F/BTU 0.0005 0.001	
29	Heat exchanged	2484845 BTU/h	MTD corrected 30.89 F
30	Transfer rate, Service	23.09 Dirty 97.51	Clean 116.21 BTU/(h*ft2*F)
31	CONSTRUCTION OF ONE SHELL		Sketch
32		Shell Side	Tube Side
33	Design/Test pressure	psi 75 / Code	150 / Code
34	Design temperature	F 300	300
35	Number passes per shell	1	4
36	Corrosion allowance	in	0.0625
37	Connections	In 24 / 150 ANSI	10 / 150 ANSI
38	Size/rating	Out 2 / 150 ANSI	10 / 150 ANSI
39	in	Intermediate / 150 ANSI	/ 150 ANSI
40	Tube No. 1127	OD 0.75 Tks 0.049 in	Length 16 ft Pitch 0.9375 in
41	Tube type Plain	Material SS304	Tube pattern 30
42	Shell SS304	ID OD 36 in	Shell cover
43	Channel or bonnet CS		Channel cover
44	Tubesheet-stationary SS304		Tubesheet-floating
45	Floating head cover		Impingement protection None
46	Baffle-crossing SS304	Type triple seg Cut(%d) 13 vert	Spacing: c/c 16.75 in
47	Baffle-long	Seal type	Inlet 42 in
48	Supports-tube	U-bend	Type
49	Bypass seal	Tube-tubesheet joint	strength weld
50	Expansion joint	Type	
51	RhoV2-Inlet nozzle 8	Bundle entrance 6	Bundle exit 0 lb/(ft*s2)
52	Gaskets - Shell side	Tube Side	
53	Floating head		
54	Code requirements	ASME Code Sec VIII Div 1	TEMA class C
55	Weight/Shell 12481.1	Filled with water 20525.8	Bundle 8739.7 lb
56	Remarks Design is based on 120% of nominal flow, assuming both upstream preheaters are in service.		
57			
58			



FORM U-1 MANUFACTURER'S DATA REPORT FOR PRESSURE VESSELS
As Required by the Provisions of the ASME Code Rules, Section VIII, Division 1

1. Manufactured and certified by: DCR Construction, Inc. 4101 Holden Rd. Lakeland, FL 33811
(Name and address of Manufacturer)

2. Manufactured for: Delta-T Corporation 133 Waller Mill Rd. Williamsburg, VA 23185
(Name and address of Purchaser)

3. Location of installation: Bunge Ergon Vicksburg, LLC 1833 Haining Rd. Vicksburg, MS 39183
(Name and address)

4. Type: Vertical Condenser 4401-7793
(Horiz, vert., or sphere) (Tank, separator, jkt. vessel, heat exh, etc.) (Mfr's serial No.)
N/A 4401-01 to 4401-23B (See Details) 223 2007
(CRN) (Drawing No.) (Nat'l Bd No.) (Year built)

5. ASME Code Section VIII Div 1 Edition 2004, Addenda 2006 N/A N/A
[Edition and Addenda (date)] (Code Case No.) [Special Service per UG-120(d)]

Items 6-11 incl. to be completed for single wall vessels, jackets of jacketed vessels, shell of heat exchangers, or chamber of multi-chamber vessels.

6. Shell (a) No. of course (s): 3 (b) Overall Length (ft & in.): 15' 7 1/4"

No.	Course(s)		Material Spec./Grade or Type	Thickness		Long. Joint (Cat. A)			Circum. Joint (Cat. A, B, & C)			Heat Treatment	
	Diameter	Length (ft & in.)		Nom.	Corr.	Type	Full, Spot, None	Eff.	Type	Full, Spot, None	Eff.	Temp.	Time
1	36"	5'	SA-240 GR304	0.250	0	1	None	0.70	1	None	0.70		
1	36"	5' 7 1/2"	SA-240 GR304	0.250	0	1	None	0.70	1	None	0.70		
1	36"	4' 11 1/4"	SA-240 GR304	0.250	0	1	None	0.70	1	None	0.70		

7. Heads: (a) _____ (b) _____
(Mat'l. Spec. No., Grade or Type) (H.T. - Time & Temp) (Mat'l. Spec. No., Grade or Type) (H.T. - Time & Temp)

	Location (Top, Bottom, Ends)	Thickness		Radius		Elliptical Ratio	Conical Apex Angle	Hemispherical Radius	Flat Diameter	Side to Pressure		Category A		
		Min.	Corr.	Crown	Knuckle					Convex	Concave	Type	Full, Spot, None	Eff.
(a)														
(b)														

If removable, bolts used (describe other fastenings) _____
(Mat'l Spec. No., Grade, Size, No.)

8. Type of jacket _____ Jacket closure _____
(Describe as ogee & weld, bar, etc.)
If bolted, describe or sketch _____
If not bolted, give dimensions _____

9. W.P. 75 psig 15 psig psig at max temp. 300 °F 300 °F Min. design metal temp. -20 °F at 75 psig
(Internal) (external) (Internal) (external)

10. Impact Test No Per UHA-51 at test temperature of N/A °F
[Indicate yes or no and the component(s) impact tested]

11. Hydro., Pneu., or comb. test press. 98 psig Proof Test N/A

Items 12 and 13 to be completed for tube sections.

12. Tubesheet SA-240 GR304 39.5" 2.5" 0 Welded
[Stationary (Mat'l Spec. No.)] [Dia., In. (subject to press.)] (Nom. thk., in.) (Corr. Allow., in.) [Attachment (welded or bolted)]

13. Tubes SA-249 GR304 Wld Tube 0.75" 0.049" 1127 Straight
[Floating (Mat'l Spec. No.)] (Dia., in.) (Nom. thk., in.) (Corr. Allow., in.) [Attachment]
(Mat'l Spec. No., Grade or Type) (O.D., in.) (Nom. thk., in. or gauge) (Number) [Type (Straight or U)]

Items 14-18 incl. To be completed for inner chambers of jacketed vessels or channels of heat exchangers.

14. Shell (a) No. of course (s): 2 (b) Overall Length (ft & in.): 3' 6 13/16"

No.	Courses		Material Spec./Grade or Type	Thickness		Long. Joint (Cat. A)			Circum. Joint (Cat. A, B, & C)			Heat Treatment	
	Diameter	Length (ft & in.)		Nom.	Corr.	Type	Full, Spot, None	Eff.	Type	Full, Spot, None	Eff.	Temp.	Time
1	35.25	1' 4 5/8"	SA-516 GR70	0.375	0.0625	1	None	0.70	1	None	0.70		
1	35.25	2' 2 3/16"	SA-516 GR70	0.375	0.0625	1	None	0.70	1	None	0.70		

15. Heads: (a) SA-516 GR70 (b) SA-516 GR70
(Mat'l. Spec. No., Grade or Type) (H.T. - Time & Temp) (Mat'l. Spec. No., Grade or Type) (H.T. - Time & Temp)

	Location (Top, Bottom, Ends)	Thickness		Radius		Elliptical Ratio	Conical Apex Angle	Hemispherical Radius	Flat Diameter	Side to Pressure		Category A		
		Min.	Corr.	Crown	Knuckle					Convex	Concave	Type	Full, Spot, None	Eff.
(a)	Top	0.1341	0.0625			2:1				X	X	1	None	0.70
(b)	Bottom	0.1341	0.0625			2:1				X	X	1	None	0.70

If removable, bolts used (describe other fastenings) _____
(Mat'l Spec. No. Grade, size, No.) SA-193 GRB7 0.5" (60)

FORM U-4 MANUFACTURER'S DATA REPORT SUPPLEMENTARY SHEET
As Required by the Provisions of the ASME Boiler and Pressure Vessel Code Rules, Section VIII, Division 1

1. Manufactured and certified by DCR Construction, Inc. 4101 Holden Rd. Lakeland, FL 33811
(Name and address of Manufacturer)

2. Manufactured for Delta-T Corporation 133 Waller Mill Rd. Williamsburg, VA 23185
(Name and address of Purchaser)

3. Location of installation Bunge Ergon Vicksburg, LLC 1833 Haining Rd. Vicksburg, MS 39183
(Name and address)

4. Type Vertical Condenser 4401-7793
(Horizontal vertical, or sphere) (Tank, separator, heat exch., etc.) (Manufacturer's serial number)
N/A 4401-01 to 4401-23B 223 2007
(CRN) (Drawing No.) (National Board number.) (Year built)

Data Report Item Number	Remarks
#6	Vapor Belt sections diameter 52", length 42", material SA-240 GR304 Thickness 0.500" Long. joint Cat. A Type 1, None, 0.70 circumference joint Cat. A, B & C, type 1 & 2*, none, 0.70 Includes closure ring material SA-240 GR304 Thickness 0.625" Joint UW 31.1C

Certificate of Authorization: Type: U No. 35010 Expires 3-17-08

Date 11/29/07 Name DCR Construction, Inc. Signed 
(Manufacturer) (Representative)

Date 11-29-07 Name  Commission 5789 AYB FL #412
(Authorized Inspector) (National Board (incl. Endorsement), State, Province and number.)

EXHIBIT 11

PRESSURE TEST REPORT

Utility/Plant 7793-4401 Shell Side Job No. 7793
 Material Specification SA-240, Gr. 304
 Pipe Size Range 36" Diameter (O.D.) Wall Thickness Range 0.250"
 Design Pressure 75 psig PSI Test Pressure 98 psig

Decrease the test pressure to the design pressure during examination unless the procedure requires a lower pressure.

Pressure Gauges Serial No. W506-a Max. Range 300 PSI ☆ Calibration Date 7/9/07
 (VA06054) ea
 Pressure Gauges Serial No. N/A Max. Range N/A PSI ☆ Calibration Date N/A

☆ The calibration date must be less than twelve (12) months prior to the test date.

Testing Medium Plant Water Condensate Treated Water
 Demineralized Water Other _____
 Duration at Test Pressure _____ Hours 0 Minutes 15

Remarks _____

Test Results Acceptable

Project Manager/Superintendent _____ Date _____
 Q.C. Inspector [Signature] Date 11/28/07
 Authorized Inspector [Signature] Date 11/28/07
 Customer Inspector [Signature] Date 11/28/07

EXHIBIT 11

PRESSURE TEST REPORT

Utility/Plant 7793-4401 Tube Side Job No. 7793

Material Specification SA-249, Gr. 304

Pipe Size Range 0.75" Diameter Wall Thickness Range 0.049"

Design Pressure 150 psig PSI Test Pressure 195 psig

* Tubesheets = (2)@ 39.5" x 2.5", SA-240, Gr. 304

Decrease the test pressure to the design pressure during examination unless the procedure requires a lower pressure.

Pressure Gauges Serial No. W508-08 Max. Range 300 PSI ☆ Calibration Date 7/17/07

Pressure Gauges Serial No. N/A Max. Range N/A PSI ☆ Calibration Date N/A

☆ The calibration date must be less than twelve (12) months prior to the test date.

Testing Medium Plant Water Condensate Treated Water

Demineralized Water Other _____

Duration at Test Pressure _____ Hours 0 Minutes 15

Remarks _____

Test Results Acceptable

Project Manager/Superintendent _____ Date _____

Q.C. Inspector [Signature] Date 11/28/07

Authorized Inspector [Signature] Date 11-28-07

Customer Inspector [Signature] Date 11/28/07

Code Symbol

W

225

CERTIFIED BY
DCR CONSTRUCTION, INC.

Code Marks

Shell Side 75 300
Tube Side 150 300

Max. Allowable Working Pressure
PSIG @ °F

Max. Allowable External Working Pressure
PSIG @ °F

Shell Side 15 300
Tube Side 15 300

Min. Design Metal Temp.
°F @ PSIG

User Equip No.

Shell Side -20 75
Tube Side -20 150

User Order No.

Mfg. Serial No.


4401-7793

Year Built

2007

E-4401

PRODUCT CONDENSER

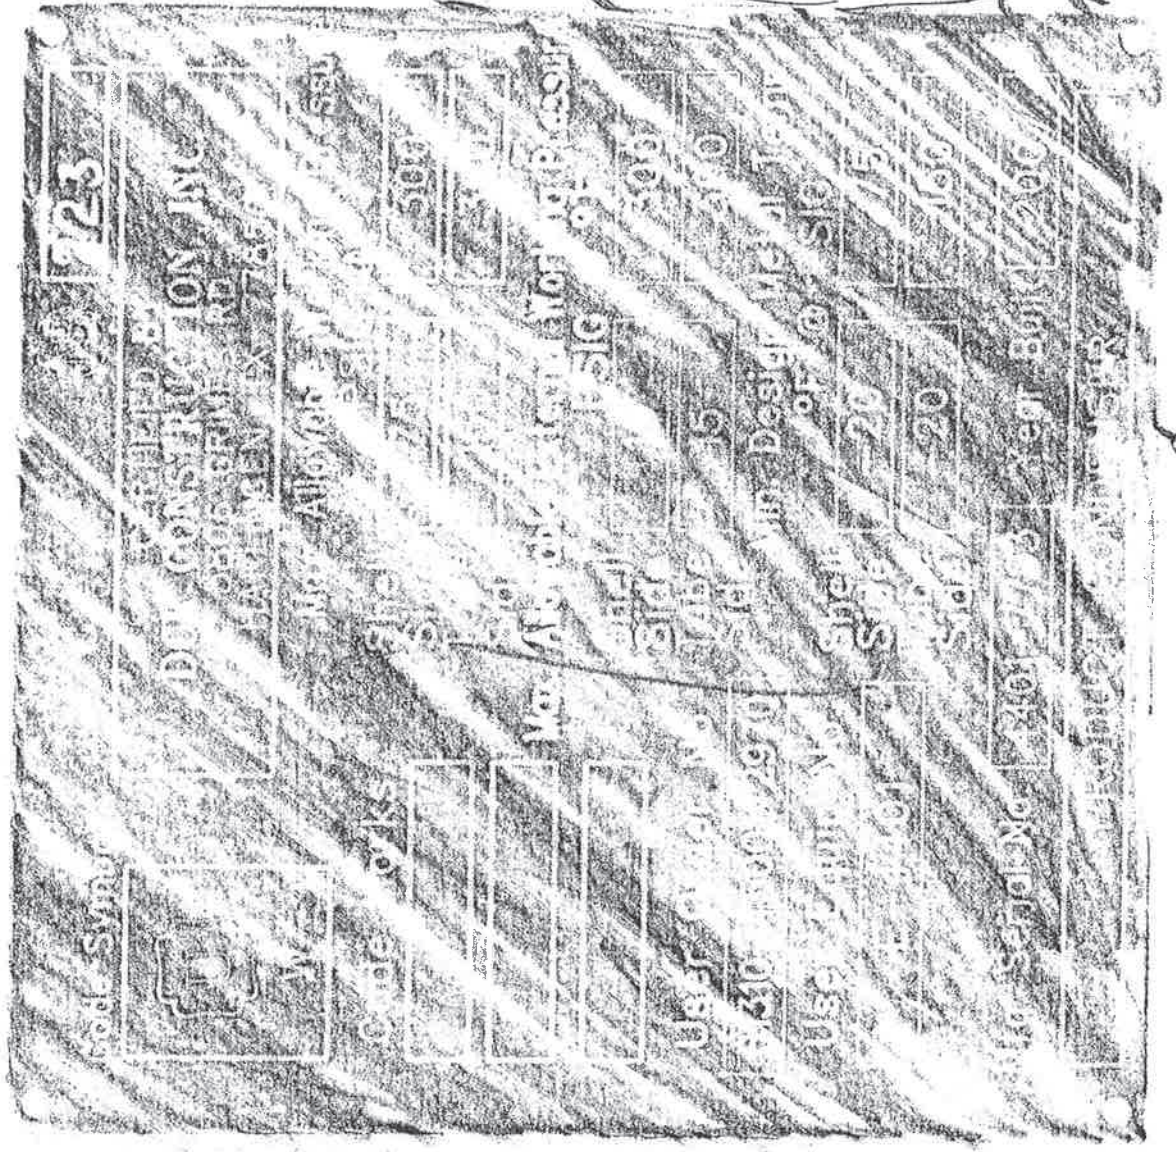

Heat Exchanger Mechanical Design

Teams 20.0

File name: E-4401-7793.BJT Date: 8/24/2007 Time: 9:11:34 AM

Design Specifications

TEMA Class	Shell Side	Tube Side	Tubesheets
Design pressure	psi 75	150	
Vacuum design pressre	psi 15	15	
Test pressure	psi 97.5	195	
Design temperature	F 300	300	300
Average metal temperature	F 128.65	114.45	128.65
Corrosion allowance	in	0.0625	
Front tubesheet corrosion allow	in		
Rear tubesheet corrosion allow	in		
Radiographing	None	None	
Number of passes	1	4	
Nozzle flange rating	150	150	
Post weld heat treatment	No	No	
Code	ASME Section VIII Div.1 2004 A06		TEMA Eighth Edition 1999
Weights	Empty:13911	Full:22005	Bundle:8881 lbf

Cylinders/Covers

	Front Head		Shell	Rear Head		Shell Cover		Tubes
	Cover	Cyl.	Cyl.	Cyl.	Cover	Cyl.	Cover	
Head type	Ellipsoidal			Ellipsoidal				0.75
Outside diameter	in 36	36	36	36	36			0.0048
Calculated thk.	in 0.2201	0.2545	0.1018	0.2545	0.2201			
TEMA minimum thk.	in 0.375	0.375	0.25	0.375	0.375			0.049
Actual thickness	in 0.375	0.375	0.25	0.375	0.375			
X-ray	None	None	None	None	None			
Joint efficiency	None	None	None	None	None			
Corrosion allowance	in 0.0625	0.0625		0.0625	0.0625			
External pressure	psi 15	15	15	15	15			90
Length Ext.Press.	in	16.625	75	26.1875				192
Maximum Ext.Press.	psi 125.159	181.789	43.953	161.509	125.159			956.011
Minimum thk. Ext.Press.	in 0.157	0.148	0.162	0.164	0.157			0.013
Max.length Ext.Press.	in	483.5	204	483.5				580

Nozzles

	A	B	C	D	G
Nozzle designator	Shell	Shell	Tube	Tube	Shell
Vessel side					
Outside diameter	in 24	2.375	10.75	10.75	6.625
Calculated thickness	in 0.1173	0.0262	0.1728	0.1728	0.0362
Code minimum thk	in 0.1499	0.113	0.2427	0.2427	0.1105
Actual thickness	in 0.375	0.154	0.365	0.365	0.134
Reinf.pad OD	in				
Reinf.pad thickness	in				
Corrosion allowance	in		0.0625	0.0625	
External pressure	psi 15	15	15	15	15
Length ext. press.	in 6	6	6	6	6
Maximum ext. press.	psi 215.029	858.476	553.348	553.348	249.047

Nozzle

Heat Exchanger Mechanical Design

Teams 20.0

File name: E-4401-7793.BJT

Date: 8/24/2007 Time: 9:11:34 AM

Flanges

	A	B	C	D	G
Nozzle designator	Slip on	Slip on	Slip on	Slip on	Slip on
Flange type	150	150	150	150	150
Flange rating	32	6	16	16	11
Flange OD	in 29.5	4.75	14.25	14.25	9.5
Bolt circle	in 1.25	0.625	0.875	0.875	0.75
Bolt diameter	in 20	4	12	12	8
Bolt number	in 27.25	3.62	12.75	12.75	8.5
Gasket OD	in 1.62	0.62	1	1	0.94
Gasket width	in 0.125	0.125	0.125	0.125	0.125
Gasket thickness	in				
Flange calc. thk.	in 1.88	0.75	1.19	1.19	1
Flange actual thk.	in				
Lap jnt ring OD	in				
Hub length	in				
Hub slope	in				
Weld height	in				

Body Flanges

	Front Head		Shell		Rear Head		Shell Cover
	Cover	at TbSh	Front	Rear	at TbSh	Cover	
Flange type		Ring			Ring		
Flange OD	in	39.5			39.5		
Bolt circle	in	38.25			38.25		
Bolt diameter	in	0.5			0.5		
Bolt number		60			60		
Gasket OD	in	37.25			37.25		
Gasket width	in	0.5625			0.5625		
Gasket thk.	in	0.125			0.125		
Flange calc. thk.	in	2.0625			2.0625		
Flange overlay	in						
Recess	in						
Flange act. thk.	in	2.0625			2.0625		
Lap jnt ring OD	in						
Hub length	in						
Hub slope	in						
Weld height	in	0.5			0.5		

Tubesheets

	Front	Rear
Tubesheet diameter	in 39.5	39.5
TEMA minimum thickness	in 0.5625	0.5625
TEMA bending thickness	in 1.6325	1.6325
TEMA shear thickness	in 0.223	0.223
TEMA flange extension thk	in 0.8079	0.8079
TEMA effective thickness	in 1.6875	1.6875
Code thickness	in 2.5	2.5
Corrosion allowance - shell	in	
Corrosion allowance - tube	in	
Recess	in	
Actual thickness	in 2.5	2.5
Clad thickness (not included above)	in	

Tube Details

Tube type		Plain
Tube OD	in	0.75
Tube wall thickness	in	0.049
Number of tubes		1127
Tube length	in	192
Tube pitch	in	0.9375
Tube pattern		30
Outer tube limit diameter	in	35

Materials of Construction

Component	Material
Shell Cylinder	SA-240 S30400 Grd 304 Plate(G5)
Front Head Cylinder	SA-516 K02700 Grd 70 Plate
Rear Head Cylinder	SA-516 K02700 Grd 70 Plate
Front Head Cover	SA-516 K02700 Grd 70 Plate
Rear Head Cover	SA-516 K02700 Grd 70 Plate
Shell Lifting Lugs	SA-36 K02600 Plate
Front Tubesheet	SA-240 S30400 Grd 304 Plate
Rear Tubesheet	SA-240 S30400 Grd 304 Plate
Front Head Flng At TS	SA-516 K02700 Grd 70 Plate
Rear Head Flng At TS	SA-516 K02700 Grd 70 Plate
Front Head Gasket At TS	Solid Teflon 1/8in Thickness
Rear Head Gasket At TS	Solid Teflon 1/8in Thickness
Tubes	SA-249 S30400 Grd TP304 Wld. tube
Baffles	SA-240 S30400 Grd 304 Plate
Tie Rods	SA-479 S30400 Grd 304 Bar
Spacers	SA-249 S30400 Grd TP304 Wld. tube(G5)
Front Head Partitions	SA-516 K02700 Grd 70 Plate
Rear Head Partitions	SA-516 K02700 Grd 70 Plate
Coupling	SA-182 S30400 Grd F304 Forgings(<= 5)(G5)
Coupling	SA-182 S30400 Grd F304 Forgings(<= 5)(G5)
Coupling	SA-182 S30400 Grd F304 Forgings(<= 5)(G5)
Coupling	SA-182 S30400 Grd F304 Forgings(<= 5)(G5)
Nozzle A	SA-312 S30400 Grd TP304 Wld. pipe
Nozzle B	SA-312 S30400 Grd TP304 Wld. pipe
Nozzle C	SA-53 K03005 Grd E/B Wld. pipe
Nozzle D	SA-53 K03005 Grd E/B Wld. pipe
Nozzle G	SA-312 S30400 Grd TP304 Wld. pipe
Nozzle Flng A	SA-182 S30400 Grd F304 Forgings(> 5)
Nozzle Flng B	SA-182 S30400 Grd F304 Forgings(> 5)
Nozzle Flng C	SA-105 K03504 Forgings
Nozzle Flng D	SA-105 K03504 Forgings
Nozzle Flng G	SA-182 S30400 Grd F304 Forgings(> 5)
Front Hd Bolting At TS	SA-193 G41400 Grd B7 Bolt(<= 2 1/2)
Rear Hd Bolting At TS	SA-193 G41400 Grd B7 Bolt(<= 2 1/2)
Distributor Belt A	SA-240 S30400 Grd 304 Plate(G5)
Nozzle Flng Bolting A	SA-193 G41400 Grd B7 Bolt(<= 2 1/2)
Nozzle Flng Bolting B	SA-193 G41400 Grd B7 Bolt(<= 2 1/2)
Nozzle Flng Bolting C	SA-193 G41400 Grd B7 Bolt(<= 2 1/2)
Nozzle Flng Bolting D	SA-193 G41400 Grd B7 Bolt(<= 2 1/2)
Nozzle Flng Bolting G	SA-193 G41400 Grd B7 Bolt(<= 2 1/2)
Nozzle Flg Gasket A	Solid Teflon 1/8in Thickness
Nozzle Flg Gasket B	Solid Teflon 1/8in Thickness

Heat Exchanger Mechanical Design

Teams 20.0

File name: E-4401-7793.BJT

Date: 8/24/2007 Time: 9:11:34 AM

Nozzle Flg Gasket C
Nozzle Flg Gasket D
Nozzle Flg Gasket G

Solid Teflon 1/8in Thickness
Solid Teflon 1/8in Thickness
Solid Teflon 1/8in Thickness


Heat Exchanger Mechanical Design

Teams 20.0


File name: E-4401-7793.BJT

Date: 8/24/2007 Time: 9:11:34 AM

Part #	Component Name	Material	Qty	Dim1	Dim2	Thks	Wght	Cost/Unit	Mat Cost
				in	In				
1	Shell Cylinder	SA-240 S30400 Grd 304 Plate(G5	1	112.5	ci 120	lg 0.25	1514	2.55	3865
1	Shell Cylinder	SA-240 S30400 Grd 304 Plate(G5	1	112.5	ci 67.5	lg 0.25	0	2.55	0
2	Fr Hd Cylinder	SA-516 K02700 Grd 70 Plate	1	112	ci 17	lg 0.375	202	0.45	91
3	Re Hd Cylinder	SA-516 K02700 Grd 70 Plate	1	112	ci 26.5	lg 0.375	315	0.45	141
5	Fr Hd Cover Ellip.	SA-516 K02700 Grd 70 Plate	1	47.625	lg 47.625	wi 0.4375	281	0.45	788
6	Re Hd Cover Ellip.	SA-516 K02700 Grd 70 Plate	1	47.625	lg 47.625	wi 0.4375	281	0.45	788
9	Shell Lift Lugs	SA-36 K02600 Plate	3	4	od 0		1.5	10	0.37
11	Front TubSh	SA-240 S30400 Grd 304 Plate	1	40.25	od 0		2.75	1005	2.55
12	Rear TubSh	SA-240 S30400 Grd 304 Plate	1	40.25	od 0		2.75	1005	2.55
17	Fr Hd Fling TubSh	SA-516 K02700 Grd 70 Plate	1	40.25	lg 40.25	wi 2.5	1147	0.45	515
18	Re Hd Fling TubSh	SA-516 K02700 Grd 70 Plate	1	40.25	lg 40.25	wi 2.5	1147	0.45	515
31	Fr Hd Gskt TubSh	Solid Teflon 1/8in Thickness	1	38	od 38	id 0.125	14	23	330
32	Re Hd Gskt TubSh	Solid Teflon 1/8in Thickness	1	38	od 38	id 0.125	14	23	330
38	Tubes (min wall)	SA-249 S30400 Grd TP304 Wld. t	1127	0.75	od 192	lg 0.049	7200	3.35	60475
39	Baffles	SA-240 S30400 Grd 304 Plate	9	36.0625	lg 36.063	wi 0.3125	1050	2.55	2681
40	Tie Rods	SA-479 S30400 Grd 304 Bar	14	0.5	od 176	lg 0	139	2.13	296
41	Spacers	SA-249 S30400 Grd TP304 Wld. t	104	0.75	od 33.5	lg 0.109	279	1.66	463
41	Spacers	SA-249 S30400 Grd TP304 Wld. t	18	0.75	od 16.75	lg 0.109	0	1.66	0
44	FH Partitions	SA-516 K02700 Grd 70 Plate	2	28.5625	lg 36	wi 0.5	291	0.45	131
45	RH Partitions	SA-516 K02700 Grd 70 Plate	1	38.125	lg 36	wi 0.5	393	0.45	176
45	RH Partitions	SA-516 K02700 Grd 70 Plate	2	38.125	od 18.375	lg 0.5	0	0.45	0
51	Coupling A	SA-182 S30400 Grd F304 Forging	1	0.5	od 0		0	20.21	7
52	Coupling B	SA-182 S30400 Grd F304 Forging	1	0.5	od 0		0	20.21	7
53	Coupling C	SA-182 S30400 Grd F304 Forging	1	0.75	od 0		0	20.21	13
54	Coupling D	SA-182 S30400 Grd F304 Forging	1	0.75	od 0		0	20.21	13
61	Nozzle A	SA-312 S30400 Grd TP304 Wld. p	1	24	od 6	lg 0.375	48	8.92	428
62	Nozzle B	SA-312 S30400 Grd TP304 Wld. p	1	2.375	od 6	lg 0.154	2	8.92	17
63	Nozzle C	SA-53 K03005 Grd E/B Wld. pipe	1	10.75	od 6	lg 0.365	20	0.7	14
64	Nozzle D	SA-53 K03005 Grd E/B Wld. pipe	1	10.75	od 6	lg 0.365	20	0.7	14
65	Nozzle G	SA-312 S30400 Grd TP304 Wld. p	1	6.625	od 6	lg 0.134	5	8.92	42
81	Nozzle Fling A Slip On	SA-182 S30400 Grd F304 Forging	1	150	AN 24	di 0	185	9.2	1700
82	Nozzle Fling B Slip On	SA-182 S30400 Grd F304 Forging	1	150	AN 2.375	di 0	5	9.2	47
83	Nozzle Fling C Slip On	SA-105 K03504 Forgings	1	150	AN 10.75	di 0	36	1.58	57
84	Nozzle Fling D Slip On	SA-105 K03504 Forgings	1	150	AN 10.75	di 0	36	1.58	57
85	Nozzle Fling G Slip On	SA-182 S30400 Grd F304 Forging	1	150	AN 6.625	di 0	17	9.2	157
101	Fr Hd Blts TubSh	SA-193 G41400 Grd B7 Bolt(<= 2	60	0.5	od 7	lg 0	23	2.48	58
102	Re Hd Blts TubSh	SA-193 G41400 Grd B7 Bolt(<= 2	60	0.5	od 7	lg 0	23	2.48	58
115	Distrib. Belt A	SA-240 S30400 Grd 304 Plate(G5	1	163.361	lg 42	wi 0.5	2092	2.55	5340
122	Dist.Belt An.Rng	SA-240 S30400 Grd 304 Plate(G5	2	52	0		0.625	0	0

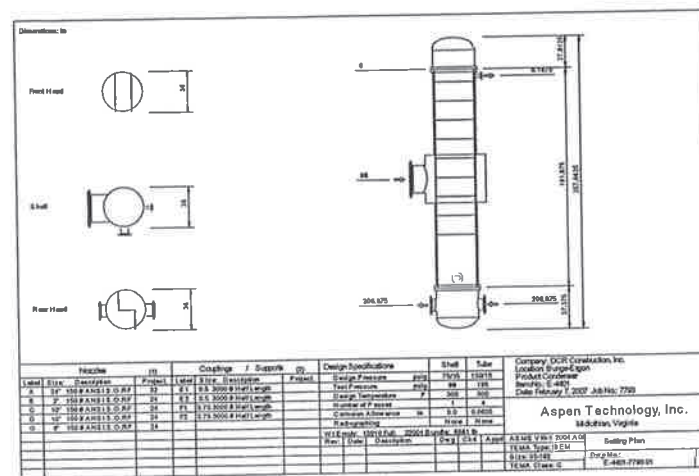

Tube Sheet Layout

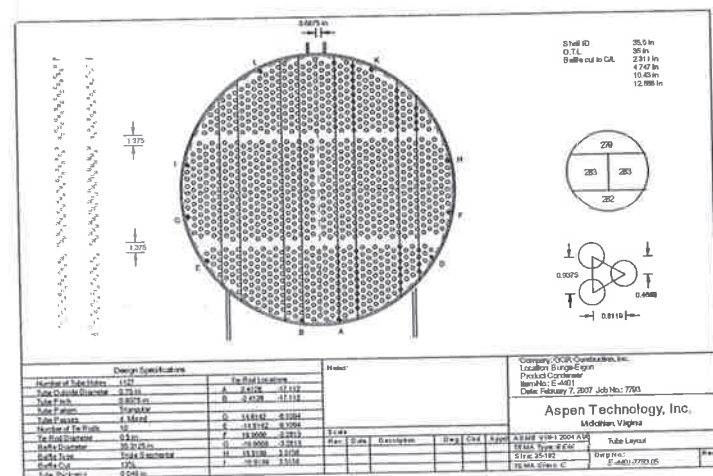

Component: Shell Cylinder

ASME Section VIII-1 2004 A06 UG-27 Thickness of Shells under Int. Pressure

--- Calculations --- Cylinder Internal Pressure

Material: SA-240 S30400 Grd 304 Plate(G5)

Design pressure P = 75 psi Design temperature T = 300 F

Radiography = None Joint eff.circ str. E = 0.7

Design stress S = 18900 psi Joint eff.long str. E = 0.7

Design stress, long S = 18900 psi (circum. butt welds)

Inside corr.allow. CAI = 0.0 in Outside corr. all. CAO = 0.0 in

Material tolerance Tol = 0.0 in TEMA min. thickness tm = 0.25 in

Outside diameter OD = 36.0 in Corroded radius OR = 18.0 in

Required wall thickness of the cylinder , greater of:

Circumferential stress

$$t = (P \cdot OR / (S \cdot E + 0.4 \cdot P)) + cai + cao + tol = 0.1018 \text{ in} \quad \text{APP.1-1(A)}$$

Longitudinal stress

$$t = (P \cdot IR / (2 \cdot S \cdot E + 0.4 \cdot P)) + cai + cao + tol = 0.0503 \text{ in} \quad \text{UG-27(c)(2)}$$

Actual wall thickness of cylinder: tnom = 0.25 in

(Required wall tks. for nozzle attachments, E=1, tri = 0.0713 in)

ASME Section VIII-1 2004 A06 UG-28 Thickness of Shells under Ext. Pressure

--- Calculations --- Cylinder External Pressure

Material: SA-240 S30400 Grd 304 Plate(G5)

Design pressure PE = 15 psi Design temperature T = 300 F

Inside corr. allow. CAI = 0 in Corrosion allow. CAO = 0 in

Radiography = None Material tol. Tol = 0 in

Cyl. outside dia. Do = 36 in Cylinder length EP L = 75 in

Nominal thickness tnom = 0.25 in (tnom-CAI-CAO-Tol) t = 0.25 in

L/Do ratio Ldo = 2.0833 Do/t Dot = 144.0

(2*S) or (0.9*yield) SE = - Mod. of elasticity ME = 27000000 psi

A factor SII-D-FigG A = 0.00036 B factor HA-1 B = 4747

Max allowed external pressure: Pa = 4*B / (3*Dot) = 43.95 psi

Actual external design pressure: PE = 15 psi

(Required cyl. tks. for nozzle attachments at PE, tre = 0.162 in)

Component: Front Head Cylinder

ASME Section VIII-1 2004 A06 UG-27 Thickness of Shells under Int. Pressure

--- Calculations --- Cylinder Internal Pressure

Material: SA-516 K02700 Grd 70 Plate

Design pressure	P = 150 psi	Design temperature	T = 300 F
Radiography	= None	Joint eff.circ str.	E = 0.7
Design stress	S = 20000 psi	Joint eff.long str.	E = 0.7
Design stress, long	S = 20000 psi	(circum. butt welds)	
Inside corr.allow.	CAI = 0.0625 in	Outside corr. all.	CAO = 0.0 in
Material tolerance	Tol = 0.0 in	TEMA min. thickness	tm = 0.375 in
Outside diameter	OD = 36.0 in	Corroded radius	OR = 18.0 in

Required wall thickness of the cylinder , greater of:

Circumferential stress

$$t = (P \cdot OR / (S \cdot E + 0.4 \cdot P)) + cai + cao + tol = 0.2545 \text{ in} \quad \text{APP.1-1(A)}$$

Longitudinal stress

$$t = (P \cdot IR / (2 \cdot S \cdot E + 0.4 \cdot P)) + cai + cao + tol = 0.1571 \text{ in} \quad \text{UG-27(c)(2)}$$

Actual wall thickness of cylinder: tnom = 0.375 in

(Required wall tks. for nozzle attachments, E=1 , tri = 0.1346 in)

ASME Section VIII-1 2004 A06 UG-28 Thickness of Shells under Ext. Pressure

--- Calculations --- Cylinder External Pressure

Material: SA-516 K02700 Grd 70 Plate

Design pressure	PE = 15 psi	Design temperature	T = 300 F
Inside corr. allow.	CAI = 0.0625 in	Corrosion allow.	CAO = 0 in
Radiography	= None	Material tol.	Tol = 0 in
Cyl. outside dia.	Do = 36 in	Cylinder length EP	L = 16.625 in
Nominal thickness	tnom = 0.375 in	(tnom-CAI-CAO-Tol)	t = 0.3125 in
L/Do ratio	Ldo = 0.4618	Do/t	Dot = 115.2
(2*S) or (0.9*yield)	SE = -	Mod. of elasticity	ME = 28100000 psi
A factor SII-D-FigG	A = 0.002549	B factor CS-2	B = 15707
Max allowed external pressure:	Pa = 4*B / (3*Dot)		= 181.79 psi
Actual external design pressure:		PE = 15 psi	
(Required cyl. tks. for nozzle attachments at PE,	tre = 0.0855 in)		

Heat Exchanger Mechanical Design

Teams 20.0

File name: E-4401-7793.BJT

Date: 8/24/2007 Time: 9:11:34 AM

Component: Rear Head Cylinder

ASME Section VIII-1 2004 A06 UG-27 Thickness of Shells under Int. Pressure

--- Calculations --- Cylinder Internal Pressure

Material: SA-516 K02700 Grd 70 Plate

Design pressure P = 150 psi Design temperature T = 300 F
Radiography = None Joint eff.circ str. E = 0.7
Design stress S = 20000 psi Joint eff.long str. E = 0.7
Design stress, long S = 20000 psi (circum. butt welds)
Inside corr.allow. CAI = 0.0625 in Outside corr. all. CAO = 0.0 in
Material tolerance Tol = 0.0 in TEMA min. thickness tm = 0.375 in
Outside diameter OD = 36.0 in Corroded radius OR = 18.0 in

Required wall thickness of the cylinder , greater of:

Circumferential stress

$$t = (P*OR / (S*E+0.4*P))+cai+cao+tol = 0.2545 \text{ in APP.1-1(A)}$$

Longitudinal stress

$$t = (P*IR / (2*S*E+0.4*P))+cai+cao+tol = 0.1571 \text{ in UG-27(c)(2)}$$

Actual wall thickness of cylinder: tnom = 0.375 in

(Required wall tks. for nozzle attachments, E=1 , tri = 0.1346 in)

ASME Section VIII-1 2004 A06 UG-28 Thickness of Shells under Ext. Pressure

--- Calculations --- Cylinder External Pressure

Material: SA-516 K02700 Grd 70 Plate

Design pressure PE = 15 psi Design temperature T = 300 F
Inside corr. allow. CAI = 0.0625 in Corrosion allow. CAO = 0 in
Radiography = None Material tol. Tol = 0 in
Cyl. outside dia. Do = 36 in Cylinder length EP L = 26.1875 in
Nominal thickness tnom = 0.375 in (tnom-CAI-CAO-Tol) t = 0.3125 in
L/Do ratio Ldo = 0.7274 Do/t Dot = 115.2
(2*S) or (0.9*yield) SE = - Mod. of elasticity ME = 28100000 psi
A factor SII-D-FigG A = 0.001554 B factor CS-2 B = 13954
Max allowed external pressure: Pa = 4*B / (3*Dot) = 161.51 psi
Actual external design pressure: PE = 15 psi

(Required cyl. tks. for nozzle attachments at PE, tre = 0.1015 in)

Component: Front Head Cover

ASME Section VIII-1 2004 A06 UG-32 Formed Heads, and Sections,
Pressure on Concave Side

--- Calculations --- Ellipsoidal Cover Internal Pressure with $t/L \geq 0.002$

Material: SA-516 K02700 Grd 70 Plate

Design pressure	P = 150 psi	Design temperature	T = 300 F
Radiography	= None	Joint efficiency	E = 0.85
Design stress	S = 20000 psi	TEMA min. thk	tm = 0.375 in
Inside corr.all.	CAI = 0.0625 in	Outside corr.all.	CAO = 0.0 in
Major/minor rat.	D/2h = 2.0	Forming tolerance	Tol = 0.0 in
Corroded min. thk	t = 0.1341 in	Equiv.dish radius	L = 31.8375 in
Ratio t/L	= 0.00982	Material tol.	Tol = 0.0 in
Outside diameter	OD = 36.0 in	Corroded diameter	OD = 36.0 in
Proportion factor	K = 0.1667*(2+(D/2h)**2) = 1.0002		

Required wall thickness of the cover:

$$t = (P*OD*K / (2*S*E+2*P*(K-0.1)))+cai+cao+tol = 0.2201 \text{ in} \quad \text{App. 1-4(c)}$$

Actual wall thickness of cover:

$$tnom = 0.375 \text{ in}$$

(Required wall tks. for nozzle attachments, $E=1$, $tri = 0.1341 \text{ in}$)

(If opening & reinf. are within 80% of head diameter, $tri = 0.1211 \text{ in}$)

ASME Section VIII-1 2004 A06 UG-33 Formed Heads, Pressure on Convex Side

--- Calculations --- Ellipsoidal Cover External Pressure

Material: SA-516 K02700 Grd 70 Plate

Design pressure	PE = 15 psi	Design temperature	T = 300 F
Inside corr. allow.	CAI = 0.0625 in	Outside corr. all.	CAO = 0 in
Radiography	= None	Forming tolerance	Tol = 0 in
		Material tolerance	Tol = 0 in
Cover outside dia.	Do = 36 in	Outside sph.radius	Ro = 32.4 in
Nominal thickness	tnom = 0.375 in	tnom-CAI-CAO-Tol	t = 0.3125 in
Ko factor (UG-33.1)	Ko = 0.9	Ro/t ratio	Rot = 103.68
UG-33(a)	352.73/1.67 = 211.22 psi	Mod. of elasticity	ME = 28100000 psi
A factor = 0.125/Rot	= 0.001206	B factor CS-2	B = 12976
Maximum allowed external pressure:	Pa = B / Rot		= 125.16 psi
Actual external design pressure:			PE = 15 psi

(Required cov. tks. for nozzle attachments at PE, $tre = 0.0945 \text{ in}$)

Heat Exchanger Mechanical Design**Teams 20.0**

File name: E-4401-7793.BJT

Date: 8/24/2007 Time: 9:11:34 AM

Component: Rear Head CoverASME Section VIII-1 2004 A06 UG-32 Formed Heads, and Sections,
Pressure on Concave Side--- Calculations --- Ellipsoidal Cover Internal Pressure with $t/L \geq 0.002$

Material: SA-516 K02700 Grd 70 Plate

Design pressure	P = 150 psi	Design temperature	T = 300 F
Radiography	= None	Joint efficiency	E = 0.85
Design stress	S = 20000 psi	TEMA min. thk	tm = 0.375 in
Inside corr.all.	CAI = 0.0625 in	Outside corr.all.	CAO = 0.0 in
Major/minor rat.	D/2h = 2.0	Forming tolerance	Tol = 0.0 in
Corroded min. thk	t = 0.1341 in	Equiv.dish radius	L = 31.8375 in
Ratio t/L	= 0.00982	Material tol.	Tol = 0.0 in
Outside diameter	OD = 36.0 in	Corroded diameter	OD = 36.0 in
Proportion factor	K = 0.1667*(2+(D/2h)**2) = 1.0002		

Required wall thickness of the cover:

$$t = (P*OD*K / (2*S*E+2*P*(K-0.1)))+cai+cao+tol = 0.2201 \text{ in} \quad \text{App. 1-4(c)}$$

Actual wall thickness of cover:

$$tnom = 0.375 \text{ in}$$

(Required wall tks. for nozzle attachments, $E=1$; $tri = 0.1341 \text{ in}$)(If opening & reinf. are within 80% of head diameter, $tri = 0.1211 \text{ in}$)

ASME Section VIII-1 2004 A06 UG-33 Formed Heads, Pressure on Convex Side

--- Calculations --- Ellipsoidal Cover External Pressure

Material: SA-516 K02700 Grd 70 Plate

Design pressure	PE = 15 psi	Design temperature	T = 300 F
Inside corr. allow.	CAI = 0.0625 in	Outside corr. all.	CAO = 0 in
Radiography	= None	Forming tolerance	Tol = 0 in
		Material tolerance	Tol = 0 in
Cover outside dia.	Do = 36 in	Outside sph.radius	Ro = 32.4 in
Nominal thickness	tnom = 0.375 in	tnom-CAI-CAO-Tol	t = 0.3125 in
Ko factor (UG-33.1)	Ko = 0.9	Ro/t ratio	Rot = 103.68
UG-33(a)	352.73/1.67 = 211.22 psi	Mod. of elasticity	ME = 28100000 psi
λ factor = 0.125/Rot	= 0.001206	B factor CS-2	B = 12976
Maximum allowed external pressure:	Pa = B / Rot		= 125.16 psi
Actual external design pressure:	PE = 15 psi		

Actual external design pressure:

(Required cov. tks. for nozzle attachments at PE, $tre = 0.0945 \text{ in}$)

Component: Distributor Belt A

ASME Section VIII Div.1 2004 A06, Appendix 9 - Jacketed Vessels

--- Calculations --- Closure Member per Type 1 Figure 9-2.

OD of dist. belt	OD = 52.0 in	ID of dist. belt	ID = 51.0 in
Corroded jacket space	j = 7.5 in	Min. fillet weld	Y = 0.38 in
Corrosion allowance	c = 0.0 in	Min. thk.outer wall trj	= 0.157 in

Required minimum thickness of closure member, trc

Figure 9-5 type: (f-1), (f-2), (f-3)

trc = 2 * trj trc = 0.334 in

Actual thickness, tc tc = 0.625 in

Heat Exchanger Mechanical Design

Teams 20.0

File name: E-4401-7793.BJT

Date: 8/24/2007 Time: 9:11:34 AM

Component: Distributor Belt A

ASME Section VIII-1 2004 A06 UG-27 Thickness of Shells under Int. Pressure

--- Calculations --- Cylinder Internal Pressure

Material: SA-240 S30400 Grd 304 Plate(G5)

Design pressure P = 75 psi Design temperature T = 300 F
 Radiography = None Joint eff.circ str. E = 0.7
 Design stress S = 18900 psi Joint eff.long str. E = 0.7
 Design stress, long S = 18900 psi (circum. butt welds)
 Inside corr.allow. CAI = 0.0 in Outside corr. all. CAO = 0.0 in
 Material tolerance Tol = 0.0 in TEMA min. thickness tm = 0.0 in
 Outside diameter OD = 52.0 in Corroded radius OR = 26.0 in

Required wall thickness of the cylinder , greater of:

Circumferential stress

$$t = (P \cdot OR / (S \cdot E + 0.4 \cdot P)) + ca_i + ca_o + tol = 0.1471 \text{ in} \quad \text{APP.1-1(A)}$$

Longitudinal stress

$$t = (P \cdot IR / (2 \cdot S \cdot E + 0.4 \cdot P)) + ca_i + ca_o + tol = 0.0722 \text{ in} \quad \text{UG-27(c)(2)}$$

Actual wall thickness of cylinder:

tnom = 0.5 in

(Required wall tks. for nozzle attachments, E=1, tri = 0.103 in)

ASME Section VIII-1 2004 A06 UG-28 Thickness of Shells under Ext. Pressure

--- Calculations --- Cylinder External Pressure

Material: SA-240 S30400 Grd 304 Plate(G5)

Design pressure PE = 15 psi Design temperature T = 300 F
 Inside corr. allow. CAI = 0 in Corrosion allow. CAO = 0 in
 Radiography = None Material tol. Tol = 0 in
 Cyl. outside dia. Do = 52 in Cylinder length EP L = 42 in
 Nominal thickness tnom = 0.5 in (tnom-CAI-CAO-Tol) t = 0.5 in
 L/Do ratio Ldo = 0.8077 Do/t Dot = 104.0
 (2*S) or (0.9*yield) SE = - Mod. of elasticity ME = 27000000 psi
 A factor SII-D-FigG A = 0.001605 B factor HA-1 B = 8716
 Max allowed external pressure: Pa = 4*B / (3*Dot) = 111.74 psi
 Actual external design pressure: PE = 15 psi
 (Required cyl. tks. for nozzle attachments at PE, tre = 0.157 in)

Component: Tubes

ASME Section VIII-1 2004 A06 UG-27 Thickness of Shells under Int. Pressure

--- Calculations --- Cylinder Internal Pressure

Material: SA-249 S30400 Grd TP304 Wld. tube

Design pressure P = 165 psi Design temperature T = 300 F
 Radiography = - Joint eff.circ str. E = 1
 Design stress S = 12700 psi Joint eff.long str. E = -
 Design stress, long S = - (circum. butt welds)
 Inside corr.allow. CAI = 0.0 in Outside corr. all. CAO = 0.0 in
 Material tolerance Tol = 0.0 in TEMA min. thickness tm = 0.0 in
 Outside diameter OD = 0.75 in Corroded radius OR = 0.375 in
 Required wall thickness of the cylinder , greater of:

Circumferential stress

$$t = (P \cdot OR / (S \cdot E + 0.4 \cdot P)) + cai + cao + tol = 0.0048 \text{ in} \quad \text{APP.1-1(A)}$$

Longitudinal stress

$$t = (P \cdot IR / (2 \cdot S \cdot E + 0.4 \cdot P)) + cai + cao + tol = - \quad \text{UG-27(c) (2)}$$

Actual wall thickness of cylinder: tnom = 0.049 in

(Required wall tks. for nozzle attachments, E=- , tri = -)

ASME Section VIII-1 2004 A06 UG-28 Thickness of Shells under Ext. Pressure

--- Calculations --- Cylinder External Pressure

Material: SA-249 S30400 Grd TP304 Wld. tube

Design pressure PE = 90 psi Design temperature T = 300 F
 Inside corr. allow. CAI = 0 in Corrosion allow. CAO = 0 in
 Radiography = Full Material tol. Tol = 0 in
 Cyl. outside dia. Do = 0.75 in Cylinder length EP L = 192 in
 Nominal thickness tnom = 0.049 in (tnom-CAI-CAO-Tol) t = 0.049 in
 L/Do ratio Ldo = 256.0 Do/t Dot = 15.3061
 (2*S) or (0.9*yield) SE = - Mod. of elasticity ME = 27000000 psi
 A factor SII-D-FigG A = 0.004768 B factor HA-1 B = 10975
 Max allowed external pressure: Pa = 4*B / (3*Dot) = 956.01 psi
 Actual external design pressure: PE = 90 psi
 (Required cyl. tks. for nozzle attachments at PE, tre = 0.013 in)

Component: Tube-to-Tubesheet Welds

ASME Section VIII Div.1 2004 A06 UW-20 Tube-To-Tubesheet Welds
 --- Calculations --- Fig UW-20.1 Sketch (c) Full Strength

Tubesheet material: SA-240 S30400 Grd 304 Plate

Tubesheet clad mtl: -

Tubes material: SA-249 S30400 Grd TP304 Wld. tube

Allowable stress TubS St = 15000 psi All. stress tubes Sa = 14941 psi
 Allowable stress weld Sw = 14941 psi Tube OD do = 0.75 in
 Tube thickness t = 0.049 in

Design temperature TubSh = 300 F Design temp. tubes = 300 F

Fille weld leg af = 0.0625 in Groove weld leg ag = 0.0625 in

Minimum length ac acmin = 0.0635 in Total length ac = af+ag = 0.125 in

Fillet weld strength = Ff = 0.55*Pi*af*(do+0.67*af)*Sw Ff = 1278 lbf

Groove weld strength = Fg = 0.85*Pi*ag*(do+0.67*ag)*Sw Fg = 1975 lbf

Tube strength Ft = Pi * t * (do - t) * Sa Ft = 1612 lbf

Design Strength Fd = 1612 lbf

Fillet weld strength, Ff = min (Ff, Ft) Ff = 1278 lbf

Groove weld strength, Fg = min (Fg, Ft) Fg = 1612 lbf

Weld strength factor fw = Sa / Sw fw = 1

Ratio fd = Fd / Ft fd = 1

Ratio ff = 1 - Fg / (fd * Ft) ff = 0

Minimum required length of the weld leg(s), ar

ar = 2*(SQRT((0.75*do)**2 + 1.07*t*(do-t)*fw*fd) - 0.75*do) ar = 0.0635 in

UW-18(d) - Allowable load on fillet/groove welds Weld Leg = 0.125 in

Allowable Load = PI * do * Weld Leg * Sw * 0.55 = 2420 lbf

Maximum Allowable Axial Loads, Lmax

Pressure only = LmaxP = Ft LmaxP = 1612 lbf

Other loads = LmaxO = 2*Ft LmaxO = 3225 lbf

Total weld throat dimension = 0.0885 in

Heat Exchanger Mechanical Design

Teams 20.0

File name: E-4401-7793.BJT

Date: 8/24/2007 Time: 9:11:34 AM

Component: Front Pass Partition

Pass Partition Plate Max. Allowed Pressure Differential (TEMA 1999 RCB-9.132)

Pass plate material: SA-516 K02700 Grd 70 Plate

Thickness t = 0.5 in Allow. pressure drop qa = 0 psi

TEMA min thk tmin = 0.5 in

Corrosion allowance c = 0.0 in Minimum thickness, tm

Design stress S = 20000 psi tm = b*SQRT((qa*B)/(1.5*S))

Max. allowable pressure drop: q = (1.5*S*((t-c)/b)**2)/B = see table below

Sides fixed	Dim a in	Dim b in	a/b	B factor	q psi	tm in	Selected
a & b	35.25	27.8125	1.267	0.431	22.5	0.0	*
a	35.25	27.8125	1.267	0.47	20.6	0.0	
b	35.25	27.8125	1.267	0.547	17.7	0.0	

Component: Rear Pass Partition

Pass Partition Plate Max. Allowed Pressure Differential (TEMA 1999 RCB-9.132)

Pass plate material: SA-516 K02700 Grd 70 Plate

Thickness t = 0.5 in Allow. pressure drop qa = 0 psi

TEMA min thk tmin = 0.5 in

Corrosion allowance c = 0.0 in Minimum thickness, tm

Design stress S = 20000 psi tm = b*SQRT((qa*B)/(1.5*S))

Max. allowable pressure drop: q = (1.5*S*((t-c)/b)**2)/B = see table below

Sides fixed	Dim a in	Dim b in	a/b	B factor	q psi	tm in	Selected
a & b	37.375	35.25	1.06	0.335	18	0.0	*
a	37.375	35.25	1.06	0.432	14	0.0	
b	37.375	35.25	1.06	0.449	13.4	0.0	

Heat Exchanger Mechanical Design**Teams 20.0**

File name: E-4401-7793.BJT

Date: 8/24/2007 Time: 9:11:34 AM

Component: Front Head Flng At TS

ASME Section VIII-1 2004 A06 App. 2 Bolted Flange With Ring Type Gaskets

Flange type: Optional type ring - code fig.2-4(8)

Flange material: SA-516 K02700 Grd 70 Plate

Int. design pressure	PI = 150 psi	Design temperature	T = 300 F
Ext. design pressure	PE = 15 psi	B1 = B+g1 or B+go	B1 = -
Inside corr. allow	CAI = 0.0625 in	Outside corr. all.	CAO = 0.0 in
Stress (operating)	SFO = 20000 psi	Stress (atmos.)	SFA = 20000 psi
Outside diameter	A = 39.5 in	Inside spherical rad.	L = -
Inside diameter	B = 35.375 in	Hub thickness	g1 = 0.8125 in
Bolt circle diameter	C = 38.25 in	Hub tks. at attach.	go = 0.3125 in
Mean gasket diameter	G = 36.7197 in	Weld leg/hub length	h = 0.5 in
Hub to bolt circle	R = 0.625 in	Bolt circle to OD	E = 0.625 in
Flange thickness	t = 2.0625 in		

Note: Optional Type Flanges use the smaller of integral or loose calculation.

Gasket material: Solid Teflon 1/8in Thickness

Gasket outside dia.	ODG = 37.25 in	Gasket width	Wth = 0.5625 in
Gasket thickness	tk = 0.125 in	Gasket factor	m = 2.0
Gasket seating stress	y = 1600 psi	Gasket eff. width	b = 0.2652 in
Gasket rib length	Rib = 72.25 in	Seating width	bo = 0.2813 in
Gasket rib eff width	Br = 0.1875 in	(Table 2-5.2 facing 1a/lb Col. II)	

Bolt material: SA-193 G41400 Grd B7 Bolt(<= 2 1/2)

Bolt diameter Dia = 0.5 in No. of bolts No. = 60

Bolt root area	Area = 0.126 in ²		
Stress (operating)	SB = 25000 psi	Stress (atmos.)	SA = 25000 psi
Joint-contact compr. load	HP = 6.2832*b*G*PI*m+2*Br*m*PI*RIB	=	26482 lbf
Hydrostatic end force	H = 0.7854*G*G*PI	=	158847 lbf
Hydrostatic end force	He = 0.7854*G*G*PE	=	15885 lbf
Operating conditions:			
Min. calc. bolt load	WM1 = HP+H	=	185329 lbf
Min. used bolt load	WM1 = max of 2 mating flanges	=	185329 lbf
Bolting up conditions:			
Minimum bolt load	WM2 = b*3.1416*G*Y+Br*Y*RIB	=	70617 lbf
Min. used bolt load	WM2 = max of 2 mating flanges	=	70617 lbf
Required bolt area	AM = WM2/SA or WM1/SB	=	7.41 in ²
Available bolt area	AB = No.Bolt*Area	=	7.56 in ²
Design bolt load	W = 0.5*(AM+AB)*SA	=	187164 lbf
Minimum gasket width	NMIN = AB*SA/(6.283*y*G)	=	0.512 in
Gasket compression stress	Gcst = AB*SA/(Pi*G*Wth)	=	2913 psi

Loads:

Operating conditions:

Hydrostatic end load

Hydrostatic end load

Gasket load

Result. hydrostatic force

Result. hydrostatic force

Bolting up conditions:

Gasket load

Operating conditions:

Hydrostatic lever arm

Gasket load lever arm

Result. hydro. lever arm

Bolting up conditions:

Gasket load lever arm

Operating conditions:

Hydrostatic moment

Gasket moment

Result. hydro. moment

Total operating moment

Total operating mom. MOPe=

Bolting up conditions:

Bolt up moment

Effective bolt moment

Total moment

Bolt spacing correction

(TEMA 1999 RCB-11.23) Cf= 1

Flange shape constants:

K = A/B	= 1.1166	ho = SQ(B*G0)	= 3.3249
TF = Fig.2-7.1	= 1.8712	h/ho = h/ho	= 0.1504
Z = Fig.2-7.1	= 9.1033	F = Fig.2-7.2	= 0.899
Y = Fig.2-7.1	= 17.5958	V = Fig.2-7.3	= 0.3721
U = Fig.2-7.1	= 19.336	f = Fig.2-7.6	= 4.9874
G1/G0 = G1/Go	= 2.6	e = F/ho	= 0.2704
t =	= 2.0625 in		
D = U*ho*g0*g0/V	= 16.872	Alpha = t*e+1.0	= 1.5577
Beta = 1.333*t*e+1.0	= 1.7434	Gamma = Alpha/TF	= 0.8324
Delta = t*t*t/D	= 0.52	Lambda = Gamma+Delta	= 1.3524

Stress calculations:

			Allowable stress:
Long. hub	SH = (f*M) / (Lambda*g1**2*B)	= 29194 psi	1.5*SFO = 30000 psi
Radial	SR = Beta*M / (Lambda*t**2*B)	= 1584 psi	SFO = 20000 psi
Tangential	ST1 = M*Y / (t**2*B) - (Z*SR)	= 7201 psi	SFO = 20000 psi
(greater)	ST2 = (SH+SR)/2 or (SH+ST1)/2	= 18197 psi	SFO = 20000 psi

Integral Flange Calculations

HD = 0.785*B*B*PI = 147426 lbf

HDe= 0.785*B*B*PE = 14743 lbf

HG = WM1-H = 26482 lbf

HT = H-HD = 11421 lbf

HTe= He-HDe = 1142 lbf

HG = W = 187164 lbf

hd = R+0.5*g1 = 1.0313 in

hg = (C-G)/2 = 0.7652 in

ht = (R+g1+hg)/2.0 = 1.1013 in

hg = (C-G)/2 = 0.7652 in

MD = HD*hd = 152033 lbf*in

MG = HG*hg = 20263 lbf*in

MT = HT*ht = 12578 lbf*in

MOP = MD+MG+MT = 184874 lbf*in

HDe(hd-hg)+HTe(ht-hg) = 4307 lbf*in

MATM = W*hg = 143212 lbf*in

MB = MATM*SFO/SFA = 143212 lbf*in

MO = MOP or MB = 184874 lbf*in

M = MO*Cf = 184874 lbf*in

Loads:

Loose Flange Calculations

Operating conditions:
 Hydrostatic end load $HD = 0.785 \cdot B \cdot B \cdot PI = 153744 \text{ lbf}$
 Hydrostatic end load $HDe = 0.785 \cdot B \cdot B \cdot PE = 15374 \text{ lbf}$
 Gasket load $HG = WM1-H = 26482 \text{ lbf}$
 Result. hydrostatic force $HT = H-HD = 5103 \text{ lbf}$
 Result. hydrostatic force $HTe = He-HDe = 510 \text{ lbf}$

Bolting up conditions:
 Gasket load $HG = W = 187164 \text{ lbf}$

Operating conditions:
 Hydrostatic lever arm $hd = (C-B)/2.0 = 1.0625 \text{ in}$
 Gasket load lever arm $hg = (C-G)/2 = 0.7652 \text{ in}$
 Result. hydro. lever arm $ht = (hd+hg)/2.0 = 0.9138 \text{ in}$

Bolting up conditions:
 Gasket load lever arm $hg = (C-G)/2 = 0.7652 \text{ in}$

Operating conditions:
 Hydrostatic moment $MD = HD \cdot hd = 163353 \text{ lbf} \cdot \text{in}$
 Gasket moment $MG = HG \cdot hg = 20263 \text{ lbf} \cdot \text{in}$
 Result. hydro. moment $MT = HT \cdot ht = 4664 \text{ lbf} \cdot \text{in}$
 Total operating moment $MOP = MD+MG+MT = 188279 \text{ lbf} \cdot \text{in}$
 Total operating mom. $MOPe = HDe(hd-hg) + HTe(ht-hg) = 4647 \text{ lbf} \cdot \text{in}$

Bolting up conditions:
 Bolt up moment $MATM = W \cdot hg = 143212 \text{ lbf} \cdot \text{in}$
 Effective bolt moment $MB = MATM \cdot SFO/SFA = 143212 \text{ lbf} \cdot \text{in}$
 Total moment $MO = MOP \text{ or } MB = 188279 \text{ lbf} \cdot \text{in}$
 Bolt spacing correction $M = MO \cdot Cf = 188279 \text{ lbf} \cdot \text{in}$
 (TEMA 1999 RCB-11.23) $Cf = 1$

Flange shape constants:
 $B = 36.125 \text{ in}$
 $K = A/B = 1.0934$
 $Y = \text{Fig. 2-7.1} = 21.6647$

Flange calculated thickness: $t = (M \cdot Y / SFO \cdot B)^{0.5} = 2.3761 \text{ in}$
 Flange nominal thickness: $tnom = 2.0625 \text{ in}$

Stress calculations:
 Tangential, $ST = MO \cdot Cf \cdot Y / (B \cdot tnom^2) = 19005 \text{ psi}$

Allowable stress:
 $SFO = 20000 \text{ psi}$

Component: Front Head Flng At TS

ASME Section VIII Div.1 2004 A06, Appendix 2, 2-14 Flange Rigidity

--- Calculations ---

Operating moment, $M_o = 184874 \text{ lbf}\cdot\text{in}$ Gasket seat. moment $M_a = 143212 \text{ lbf}\cdot\text{in}$
Factor V $V = 0.372$ Factor L $L = 1.3524$
Mod. elast.design T $E_d = 28100000 \text{ psi}$ Mod.elast.atm. temp $E_a = 29300000 \text{ psi}$
Thickness $g_0 = 0.3125 \text{ in}$ Factor $h_0 = 3.3249 \text{ in}$
Factor KI $KI = 0.3$ Factor KL $KL = 0.2$
Corrosion allowance $ca = 0.0625 \text{ in}$ Factor K $K = 1.1166$
Thickness, T $T = 2.0625 \text{ in}$
Rigidity index, J, loose flange type
Gasket seating $J = 109.4 * M_a / (E * T ** 3 * Ln(K) * KL) = -$
Operating $J = 109.4 * M_o / (E * T ** 3 * Ln(K) * KL) = -$
Rigidity index, J, integral flange type
Gasket seating $J = 52.14 * M_a * V / (L * E * G_0 ** 2 * h_0 * KI) = 0.7199$
Operating $J = 52.14 * M_o * V / (L * E * G_0 ** 2 * h_0 * KI) = 0.969$

Component: Rear Head Flng At TS

ASME Section VIII-1 2004 A06 App. 2 Bolted Flange With Ring Type Gaskets

Flange type: Optional type ring - code fig.2-4(8)

Flange material: SA-516 K02700 Grd 70 Plate

Int. design pressure	PI = 150 psi	Design temperature	T = 300 F
Ext. design pressure	PE = 15 psi	B1 = B+g1 or B+go	B1 = -
Inside corr. allow	CAI = 0.0625 in	Outside corr. all.	CAO = 0.0 in
Stress (operating)	SFO = 20000 psi	Stress (atmos.)	SFA = 20000 psi
Outside diameter	A = 39.5 in	Inside spherical rad.	L = -
Inside diameter	B = 35.375 in	Hub thickness	g1 = 0.8125 in
Bolt circle diameter	C = 38.25 in	Hub tks. at attach.	go = 0.3125 in
Mean gasket diameter	G = 36.7197 in	Weld leg/hub length	h = 0.5 in
Hub to bolt circle	R = 0.625 in	Bolt circle to OD	E = 0.625 in
Flange thickness	t = 2.0625 in		

Note: Optional Type Flanges use the smaller of integral or loose calculation.

Gasket material: Solid Teflon 1/8in Thickness

Gasket outside dia.	ODG = 37.25 in	Gasket width	Wth = 0.5625 in
Gasket thickness	tk = 0.125 in	Gasket factor	m = 2.0
Gasket seating stress	y = 1600 psi	Gasket eff. width	b = 0.2652 in
Gasket rib length	Rib = 72.25 in	Seating width	bo = 0.2813 in
Gasket rib eff width	Br = 0.1875 in	(Table 2-5.2 facing 1a/lb Col. II)	

Bolt material: SA-193 G41400 Grd B7 Bolt(<= 2 1/2)

Bolt diameter Dia = 0.5 in No. of bolts No. = 60

Bolt root area	Area = 0.126 in ²		
Stress (operating)	SB = 25000 psi	Stress (atmos.)	SA = 25000 psi
Joint-contact compr. load	HP = 6.2832*b*G*PI*m+2*Br*m*PI*RIB	=	26482 lbf
Hydrostatic end force	H = 0.7854*G*G*PI	=	158847 lbf
Hydrostatic end force	He = 0.7854*G*G*PE	=	15885 lbf
Operating conditions:			
Min. calc. bolt load	WM1 = HP+H	=	185329 lbf
Min. used bolt load	WM1 = max of 2 mating flanges	=	185329 lbf
Bolting up conditions:			
Minimum bolt load	WM2 = b*3.1416*G*Y+Br*Y*RIB	=	70617 lbf
Min. used bolt load	WM2 = max of 2 mating flanges	=	70617 lbf
Required bolt area	AM = WM2/SA or WM1/SB	=	7.41 in ²
Available bolt area	AB = No.Bolt*Area	=	7.56 in ²
Design bolt load	W = 0.5*(AM+AB)*SA	=	187164 lbf
Minimum gasket width	NMIN = AB*SA/(6.283*y*G)	=	0.512 in
Gasket compression stress	Gcst = AB*SA/(Pi*G*Wth)	=	2913 psi

Loads:

Operating conditions:

Hydrostatic end load

Hydrostatic end load

Gasket load

Result. hydrostatic force

Result. hydrostatic force

Bolting up conditions:

Gasket load

Operating conditions:

Hydrostatic lever arm

Gasket load lever arm

Result. hydro. lever arm

Bolting up conditions:

Gasket load lever arm

Operating conditions:

Hydrostatic moment

Gasket moment

Result. hydro. moment

Total operating moment

Total operating mom. MOPe=

Bolting up conditions:

Bolt up moment

Effective bolt moment

Total moment

Bolt spacing correction

(TEMA 1999 RCB-11.23) Cf= 1

Flange shape constants:

K = A/B	= 1.1166	ho = SQ(B*G0)	= 3.3249
TF = Fig.2-7.1	= 1.8712	h/ho = h/ho	= 0.1504
Z = Fig.2-7.1	= 9.1033	F = Fig.2-7.2	= 0.899
Y = Fig.2-7.1	= 17.5958	V = Fig.2-7.3	= 0.3721
U = Fig.2-7.1	= 19.336	f = Fig.2-7.6	= 4.9874
G1/G0 = G1/Go	= 2.6	e = F/ho	= 0.2704
t =	= 2.0625 in		
D = U*ho*g0*g0/V	= 16.872	Alpha = t*e+1.0	= 1.5577
Beta = 1.333*t*e+1.0	= 1.7434	Gamma = Alpha/TF	= 0.8324
Delta = t*t*t/D	= 0.52	Lambda = Gamma+Delta	= 1.3524

Stress calculations:

Long. hub	SH = (f*M)/(Lambda*g1**2*B)	= 29194 psi	Allowable stress:	1.5*SFO = 30000 psi
Radial	SR = Beta*M/(Lambda*t**2*B)	= 1584 psi	SFO =	20000 psi
Tangential	ST1 = M*Y/(t**2*B)-(Z*SR)	= 7201 psi	SFO =	20000 psi
(greater)	ST2 = (SH+SR)/2 or (SH+ST1)/2	= 18197 psi	SFO =	20000 psi

Integral Flange Calculations

HD = 0.785*B*B*PI = 147426 lbf

HDe= 0.785*B*B*PE = 14743 lbf

HG = WM1-H = 26482 lbf

HT = H-HD = 11421 lbf

HTE= He-HDe = 1142 lbf

HG = W = 187164 lbf

hd = R+0.5*g1 = 1.0313 in

hg = (C-G)/2 = 0.7652 in

ht = (R+g1+hg)/2.0 = 1.1013 in

hg = (C-G)/2 = 0.7652 in

MD = HD*hd = 152033 lbf*in

MG = HG*hg = 20263 lbf*in

MT = HT*ht = 12578 lbf*in

MOP = MD+MG+MT = 184874 lbf*in

MOPe= HDe(hd-hg)+HTE(ht-hg) = 4307 lbf*in

MATM = W*hg = 143212 lbf*in

MB = MATM*SFO/SFA = 143212 lbf*in

MO = MOP or MB = 184874 lbf*in

M = MO*Cf = 184874 lbf*in

Loads:

Operating conditions:

Hydrostatic end load

Hydrostatic end load

Gasket load

Result. hydrostatic force

Result. hydrostatic force

Bolting up conditions:

Gasket load

Operating conditions:

Hydrostatic lever arm

Gasket load lever arm

Result. hydro. lever arm

Bolting up conditions:

Gasket load lever arm

Operating conditions:

Hydrostatic moment

Gasket moment

Result. hydro. moment

Total operating moment

Total operating mom. MOPE=

Bolting up conditions:

Bolt up moment

Effective bolt moment

Total moment

Bolt spacing correction

(TEMA 1999 RCB-11.23) Cf= 1

Flange shape constants:

B =

K = A/B

Y = Fig.2-7.1

Flange calculated thickness: $t = (M*Y/SFO*B)**0.5 = 2.3761$ inFlange nominal thickness: $t_{nom} = 2.0625$ in

Stress calculations: Allowable stress:

Tangential, $ST = MO*Cf*Y/(B*t_{nom}**2) = 19005$ psi SFO = 20000 psi**Loose Flange Calculations**HD = $0.785*B*B*PI = 153744$ lbfHDe= $0.785*B*B*PE = 15374$ lbf

HG = WM1-H = 26482 lbf

HT = H-HD = 5103 lbf

HTE= He-HDe = 510 lbf

HG = W = 187164 lbf

hd = $(C-B)/2.0 = 1.0625$ inhg = $(C-G)/2 = 0.7652$ inht = $(hd+hg)/2.0 = 0.9138$ inhg = $(C-G)/2 = 0.7652$ in

MD = HD*hd = 163353 lbf*in

MG = HG*hg = 20263 lbf*in

MT = HT*ht = 4664 lbf*in

MOP = MD+MG+MT = 188279 lbf*in

HDe(hd-hg)+HTE(ht-hg) = 4647 lbf*in

MATM = W*hg = 143212 lbf*in

MB = MATM*SFO/SFA = 143212 lbf*in

MO = MOP or MB = 188279 lbf*in

M = MO*Cf = 188279 lbf*in

Component: Rear Head Flng At TS

ASME Section VIII Div.1 2004 A06, Appendix 2, 2-14 Flange Rigidity

--- Calculations ---

Operating moment, Mo = 184874 lbf*in Gasket seat. moment Ma = 143212 lbf*in
Factor V V = 0.372 Factor L L = 1.3524
Mod. elast.design T Ed = 28100000 psi Mod.elast.atm. temp Ea = 29300000 psi
Thickness g0 g0 = 0.3125 in Factor h0 h0 = 3.3249 in
Factor KI KI = 0.3 Factor KL KL = 0.2
Corrosion allowance ca = 0.0625 in Factor K K = 1.1166
Thickness, T T = 2.0625 in
Rigidity index, J, loose flange type
Gasket seating $J = 109.4 * Ma / (E * T ** 3 * Ln(K) * KL) = -$
Operating $J = 109.4 * Mo / (E * T ** 3 * Ln(K) * KL) = -$
Rigidity index, J, integral flange type
Gasket seating $J = 52.14 * Ma * V / (L * E * G0 ** 2 * ho * KI) = 0.7199$
Operating $J = 52.14 * Mo * V / (L * E * G0 ** 2 * ho * KI) = 0.969$

Heat Exchanger Mechanical Design

Teams 20.0

File name: E-4401-7793.BJT

Date: 8/24/2007 Time: 9:11:34 AM

Component: Tubesheets

Tubesheet Details - TEMA 1999 Design

Materials of construction

Shell: SA-240 S30400 Grd 304 Plate(G5)
 Channel: SA-516 K02700 Grd 70 Plate
 Tubesheet: SA-240 S30400 Grd 304 Plate
 Tubes: SA-249 S30400 Grd TP304 Wld. tube

Design conditions	Shell	Channel	Tubesheet	Tubes
Design pressure	psi 90	165		
Design temperature	F 300	300	300	300
Allowable stress	psi 18900		15000	14941
Mean metal temp.	F 128.6		128.6	114.4
Mod.of elas/M.M.T.	psi 27984192		27984192	28060654
Coef.th.exp/M.M.T. in/in/F	0.0000087			0.0000086
Corrosion allowance	in 0.0	0.0625		
Yield stress, Sy	psi			22400

RCB-7.134 Tubesheet Formula - Tubesheet Flange Extension

RCB-7.1341 Fixed Tubesheet or Floating Tubesheet Exchangers

Design temperature TS = 300 F TS allowable stress S = 15000 psi

Tubesheet OD A = 39.5 in Reaction diameter G = 35.5 in

Ratio A/G r = 1.1127

Equivalent diameter DL = 22.9244 in Flange moment M = 184874 lbf*in

$$Tr = 0.98 * \left(\frac{M * (r^{**2} - 1 + 3.71 * r^{**2} * Ln(r))^{**1/2}}{S * (A - G) * (1 + 1.86 * r^{**2})} \right) = 0.8079 \text{ in}$$

Relative expansion between shell and tubes (TEMA T-4.5)

Shell metal temp. Thetas = 58.6 F Tube metal temp. Thetat = 44.4 F

Tube length L = 192.0 in

DeltaL = (Alphas*Thetas-Alphat*Thetat)*L = 0.0242 in

Component: Tubesheets

Tubesheet Details - TEMA 1999 Design

RCB-7.13 Required Effective Tubesheet Thickness

Tubesheet details with effective thicknesses (no corrosion added), in

Effective thickness definition as per TEMA 1999 RCB-7.12

Corroded conditions refer to head and shell dimensions only

Bending : $T = (F*G/3)*\text{Sqrt}(P/\text{Eta}*S)$ Factor Eta = 0.4195

Shear : $T = 0.31*DL*(P/S)/(1-\text{do}/\text{Pitch})$

	-Without exp.joint-		-- With exp.joint --	
	Uncorroded	Corroded	Uncorroded	Corroded
User specified thickness	2.5	2.5	2.5	2.5
Effective thickness, T :	1.6875	1.6875	0.0	0.0
Req. tks. shell side (bending):	0.8679	0.8679	0.0	0.0
Req. tks. tube side (bending) :	1.6325	1.6325	0.0	0.0
Req. tks. shell side (shear) :	0.0798	0.0798	0.0	0.0
Req. tks. tube side (shear) :	0.223	0.223	0.0	0.0

Shell and tube stresses, tube-to-TS loads and effective pressures

Stresses, psi (* means stress exceeds allowable)

	-Without exp.joint-		-- With exp.joint --	
	Uncorroded	Corroded	Uncorroded	Corroded
Shell longitudinal stress =	3737	3737	0	0
Shell compressive stress =	-1711	-1711	0	0
Tube longitudinal stress =	2811	2811	0	0
Tube compressive stress =	-939	-939	0	0
Tube-to-tubesheet load, lbf				
Tube-to-tubesheet load Wj =	303	303	0	0
Effective pressures P, psi				
Eff.pres.shell side (bend.)=	33.9	33.9	0	0
Eff.pres.tube side (bend.) =	119.8	119.8	0	0
Eff.pres.shell side (shear)=	33.7	33.7	0	0
Eff.pres.tube side (shear) =	94.2	94.2	0	0

Heat Exchanger Mechanical Design

Teams 20.0

File name: E-4401-7793.BJT

Date: 8/24/2007 Time: 9:11:34 AM

Component: Tubesheets

Tubesheet Details - TEMA 1999 Design

RCB-7.161 Equivalent Differential Expansion Pressure, Pd, psi

Tube OD do = 0.75 in Tube thickness tt = 0.049 in
 Tube Number N = 1127 Tube pitch pitch = 0.9375 in
 Tube Length Lt = 192.0 in Mod.of Elasticity E = 27984192 psi
 Mod.of Elasticity Es = 27984192 psi Mod.of Elasticity Et = 28060654 psi

$Pd = 4 * J * Es * ts * (\Delta L / Lt) / (Do - 3 * ts) * (1 + J * K * Fq)$

$J = S_j * L / S_j * L + \pi * (Do - ts) * ts * Es$ $K = Es * ts * (Do - ts) / Et * tt * N * (do - tt)$

$Fq = 0.25 + (F - 0.6) * ((300 * ts * Es / K * L * E) * (G / T) ** 3) ** 0.25$

	-Without exp.joint-		-- With exp.joint --
	Uncorroded	Corroded	Uncorroded Corroded

Units: in				
Factor F shell side F = Fs =	1.0	1.0	1.0	1.0
Factor F tube side F = Ft =	1.0	1.0	1.0	1.0
Dia. G shell side G = Gs =	35.5	35.5	35.5	35.5
Dia. G tube side G = Gt =	35.5	35.5	35.5	35.5
Shell OD Do =	36.0	36.0	36.0	36.0
Shell thickness ts =	0.25	0.25	0.25	0.25
Spring rate, lbf/in Sj =	-	-	0	0
Stiffness multiplier K =	-	-	0	0
Effective tube length L =	188.6	188.6	0	0
J=1;w/o Exp.Joint J =	1.0	1.0	0.0	0.0
J=0;Sj < (Do-ts)*ts*Es/10*L =	0	0	0	0
Rigidity factor K =	0.2302	0.2302	0.2302	0.2302
Fq =	4.7542	4.7542	0.0	0.0
Pd =	47.9	47.9	0	0

Heat Exchanger Mechanical Design

Teams 20.0

File name: E-4401-7793.BJT

Date: 8/24/2007 Time: 9:11:34 AM

Component: Tubesheets

Tubesheet Details - TEMA 1999 Design

RCB-7.162 Equivalent Bolting Pressure, P_b, psi

	-Without exp.joint-		-- With exp.joint --	
	Uncorroded	Corroded	Uncorroded	Corroded
Equiv. bolting pressure P _{bt} =	25.6	25.6	25.6	25.6
Equiv. bolting pressure P _{bs} =	19.8	19.8	19.8	19.8
Operating moment M1 = 184874 lbf*in	Bolting-up moment M2 = 143212 lbf*in			
	6.2 * M1		6.2 * M2	
Operating - P _{bt} = -----	Bolting up - P _{bs} = -----			
	F**2 * Gs**3		F**2 * Gs**3	

RCB-7.163 Effective Shell Side Design Pressure, P, psi

	-Without exp.joint-		-- With exp.joint --	
	Uncorroded	Corroded	Uncorroded	Corroded
P = (P _{s'} -P _d)/2	-7.1	-7.1	0	0
P = P _{s'}	33.7	33.7	0	0
P = P _{Bs}	19.8	19.8	0	0
P = (P _{s'} -P _d -P _{Bs})/2	-17	-17	0	0
P = (P _{Bs} +P _d)/2	33.9	33.9	0	0
P = P _{s'} -P _{Bs}	13.8	13.8	0	0
G = G _s = Shell I.D., in	35.5	35.5	35.5	35.5
f _s = 1-N*(d _o /G)**2	0.497	0.497	0.497	0.497
D _j = expansion joint ID, in	35.5	35.5	0.0	0.0
P _{s'} =	33.7	33.7	0	0

$$P_{s'} = P_s * \frac{0.4 * J * (1.5 + K * (1.5 + f_s)) - ((1 - J) / 2) * (D_j^{**2} / G^{**2} - 1)}{1 + J * K * F_q}$$

Heat Exchanger Mechanical Design

Teams 20.0

File name: E-4401-7793.BJT

Date: 8/24/2007 Time: 9:11:34 AM

Component: Tubesheets

Tube sheet Details - TEMA 1999 Design

RCB-7.164 Effective Tube Side Design Pressure, P, psi

	-Without exp.joint-		-- With exp.joint --	
	Uncorroded	Corroded	Uncorroded	Corroded
If Ps' is positive:				
P = (Pt'+PBt+Pd)/2	83.8	83.8	0	0
P = Pt'+PBt	119.8	119.8	0	0
If Ps' is negative:				
P = (Pt'-Ps'+PBt+Pd)/2	67	67	0	0
P = Pt'-Ps'+PBt	86.1	86.1	0	0
When J=0 and Ps and Pt are both positive:				
P = Pt+(Ps/2)*((Dj/G)**2-1)+PBt	0	0	0	0
G = Gs = shell I.D., in	35.5	35.5	35.5	35.5
ft = 1-N*((do-2*tt)/G)**2	0.6198	0.6198	0.6198	0.6198
Pt' =	94.2	94.2	0	0
	1 + 0.4 * J * K * (1.5 + ft)			
Pt' = Pt *	----- 1 + J * K * Fq			

RCB-7.22 Shell Longitudinal Stress, Ss, psi

	-Without exp.joint-		-- With exp.joint --	
	Uncorroded	Corroded	Uncorroded	Corroded
Ss = (Cs * (Do - ts) * (Ps*)) / 4 * ts				
Tensile stress (shell), psi				
Allowable stress	18900	18900	18900	18900
Tensile stress Ss =	3737	3737	0	0
Compressive stress (shell), psi				
Allowable stress	8920	8920	8920	8920
Compressive stress Ss =	-1711	-1711	0	0
Effective pressure, Ps*, psi				
Ps* = Pt-Pt'	70.8	70.8	0	0
Ps* = Ps'	33.7	33.7	0	0
Ps* = -Pd	-47.9	-47.9	0	0
Ps* = Pt-Pt'+Ps'	104.5	104.5	0	0
Ps* = Pt-Pt'-Pd	23	23	0	0
Ps* = Ps'-Pd	-14.2	-14.2	0	0
Ps* = Pt-Pt'+Ps'-Pd	56.7	56.7	0	0

Component: Tubesheets

Tubesheet Details - TEMA 1999 Design

RCB-7.23 Tube Longitudinal Stress-Periphery of Bundle, St, psi

$$St = (Ct * Fq * (Pt*) * G**2) / 4 * N * tt * (do-tt)$$

	-Without exp.joint-		-- With exp.joint --	
	Uncorroded	Corroded	Uncorroded	Corroded
G = Gs = Shell I.D., in	35.5	35.5	35.5	35.5
Fs = 3.25-0.5*Fq	1.25	1.25	0	0
Tensile stress (tubes), psi				
Allowable stress	14941	14941	14941	14941
Tensile stress St =	2810.6	2810.6	0	0
Compressive stress (tubes), psi				
Allowable stress Sc =	6191	6191	0	0
Compressive stress St =	-939.3	-939.3	0	0
Intermediate pressures, P2 and P3, psi				
P2 = Pt'-(ft*Pt/Fq)	72.6	72.6	0	0
P3 = Ps'-(fs*Ps/Fq)	24.3	24.3	0	0

RCB-7.23 Tube Longitudinal Stress-Periphery of Bundle (Continued), St, psi

	-Without exp.joint-		-- With exp.joint --	
	Uncorroded	Corroded	Uncorroded	Corroded
Effective pressure, Pt*, psi				
Pt* = P2	72.6	72.6	0	0
Pt* = -P3	-24.3	-24.3	0	0
Pt* = Pd	47.9	47.9	0	0
Pt* = P2-P3	48.4	48.4	0	0
Pt* = P2+Pd	120.5	120.5	0	0
Pt* = -P3+Pd	23.6	23.6	0	0
Pt* = P2-P3+Pd	96.2	96.2	0	0

RCB-7.24 Allowable Tube Compressive Stress-Periphery of Bundle, Sc, psi

$$Sc = \frac{\pi^2 * Et}{(Fs * (kl/r))^2} \text{ when } Cc \leq kl/r \quad k = 0.80$$

$$Sc = \frac{Sy}{Fs} * (1 - (kl/r) / (2 * Cc)) \text{ when } Cc > kl/r \quad l = 58.75 \text{ in}$$

$$Cc = \sqrt{2 * \pi^2 * Et / Sy} \quad Cc = 157.3 \quad kl/r = 189.18$$

$$r = 0.25 * \sqrt{do^2 + (do - 2 * tt)^2} = 0.2484 \text{ in}$$

Heat Exchanger Mechanical Design

Teams 20.0

File name: E-4401-7793.BJT

Date: 8/24/2007 Time: 9:11:34 AM

Component: Tubesheets

Tubesheet Details - TEMA 1999 Design

RCB-7.25 Tube-to-Tubesheet Joint Loads-Periphery of Bundle, Wj, lbf

	-Without exp.joint-		-- With exp.joint --	
	Uncorroded	Corroded	Uncorroded	Corroded
G = Gs = Shell I.D., in	35.5	35.5	35.5	35.5
Tube-to-tubesheet load, Wj	303.3	303.3	0	0
Effective pressure, Pt*, psi				
Pt* = P2	72.6	72.6	0	0
Pt* = -P3	-24.3	-24.3	0	0
Pt* = P2-P3	48.4	48.4	0	0

RCB-7.25 Tube-to-Tubesheet Joint Loads-Periphery of Bundle (cont.), Wj, lbf
 Allowable Loads per ASME Section VIII Div. 1 2004 A06 Appendix A

Type	Joint description	No Test		Test	
		fr	Lmax	fr	Lmax
a	Strength welded only	0.8	1290	1	1612
b	Seal welded only	0.55	887	0.7	1129
e	Strength welded and expanded	0.8	1290	1	1612
f	Seal welded and exp.with 2 grooves	0.75	1209	0.95	1532
g	Seal welded and exp.with 1 groove	0.65	1048	0.85	1370
h	Seal welded and exp.with no grooves	0.5	806	0.7	1129
i	Expanded with 2 grooves	0.7	1129	0.9	1451
j	Expanded with 1 groove	0.65	1048	0.8	1290
k	Expanded with no grooves	0.5	806	0.6	967

* = Wj calculated exceeds code allowable for this joint type.
 For joints types a,b,b-1,c,d,e : Lmax = At*Sa*fr
 For joints types f,g,h, : Lmax = At*Sa*fe*fr*fy
 For joints types i,j,k : Lmax = At*Sa*fe*fr*fy,ft
 Cross-sectional area At = 0.1079 in² Tube allowable stress Sa = 14941 psi
 Factor fe (1/do or 1) fe = 1 Ratio fy fy = 1
 ft = (Po+Pt)/Po ft = 1 Min Yield Str SigmaM = 30000 psi
 (ft = 1 if max exceeded)
 Tube OD do = 0.75 in Tube thickness tt = 0.049 in
 Tubes yield str(min) st = 30000 psi TubSh mean metal tmp T = 128.6 F
 Tubes Mod.Elasticity EtT = 27984192 psi TubSh Mod.Elast. EsT = 27984192 psi
 Tubes Coef.Th.Exp. at = 0.0000087 TubSh Coef.Th.Exp. as = 0.0000087
 Po = (4*(do*t-t**2)*st)/do**2 Po = 7328 psi
 Pt = ((T-Tamb)*(at-as)*(EtT*EsT)/(EtT+EsT) Pt = -
 For joint types i, j, k: Po + Pt <= 0.58*SigmaM
 7328 psi <= 17400 psi

Component: Tubesheets Rules for the Design of Fixed Tubesheets

ASME VIII-1 2004 A06 UHX-13 Fig.UHX-13.1(b) Controlling Case: UHX-13.4(a)(1)

*** Tubesheet material: SA-240 S30400 Grd 304 Plate
Design temp. tubesheet T = 300 F TubSh metal tmp at rim T'= 128.6 F
TubSh allowable stress S = 15000 psi *TubSh th.ex.coe. alpha = 9.2
TubSh mod.elasticity E = 27000000 psi *TubSh th.ex.coe. alpha' = 8.7146
Poisson's rat. tubSh v = 0.3 *(th.exp.coef * 10**6)

*** Shell material: SA-240 S30400 Grd 304 Plate(G5)
Design temp. shell Ts = 300 F Shell metal tmp/TubS T's = 128.6 F
Shell allowable str. Ss = 18900 psi *Shell th.ex.coe.alpha's = 8.7146
Shell mod.elasticity Es = 27000000 psi Shell mean metal tmp Tsm = 128.6 F
Poisson's ratio shell vs = 0.3 *Shell th.ex.coe.alphasm = 8.7146

*** Tube material: SA-249 S30400 Grd TP304 Wld. tube
Design temp. tubes Tt = 300 F Tubes mean metal tmp Ttm = 114.4 F
Tube allow.Str. at Tt St = 14941.2 psi Tube allow.Str. at T Stt = 14941.2 psi
Tube mod.elas. at Tt Et = 27000000 psi Tube mod.elas. at T Ett = 27000000 psi
Poisson's rat. tubes vt = 0.3 *Tube th.ex.coe.alphatm = 8.6578
Tube yield stress Syt = 22400 psi *(th.exp.coef * 10**6)

*** Channel material: SA-516 K02700 Grd 70 Plate
Design temp. channel Tc = 300 F Channel metal tmp TS T'c = 114.4 F
Channel all. stress Sc = 20000 psi *Chan.th.ex.coe.alpha'c = 6.5289
Channel mod.elast. Ec = 28100000 psi *(th.exp.coef * 10**6)
Poisson's rat.channel vc = 0.3

*** Adjacent shell matl: -
Adj Shell all. str. Ss,1 = - *Shell th.ex.coe.alpha's1= 0.0
*Shell th.ex.coe.alpha'sml=0.0

Tubesheet thickness h = 2.5 in Actual tubesheet thk ha = 2.5 in
Shell side corr allow c = 0.0 in Tube side cor.allow. c = 0.0625 in
SS TubSh corr allow cs = 0.0 in TS TubSh corr allow ct = 0.0 in

Table with 3 columns: Parameter, Corroded case, Uncorroded case. Rows include Shell diameter (Ds), Channel diameter (Dc), Shell thickness (ts), Adjacent shell thk (ts,1), Channel thickness (tc), Minimum TubSh thk (hmin), Thickness h used, and Tubesheet OD (A = 39.5 in, Bolt circle diam. C = 38.25 in).

Heat Exchanger Mechanical Design

Teams 20.0

File name: E-4401-7793.BJT

Date: 8/24/2007 Time: 9:11:34 AM

Shell gasket diam.	Gs = -	Channel gasket diam.	Gc = 36.7197 in
Gasket reaction diam.	G = 36.7197 in	Gasket reaction diam.	G1 = 36.7197 in
Number of tubes	Nt = 1127	Flange load	W = 187164 lbf
Pass partition groove	hg = 0.0 in	Eff.tube side groove h'g	= 0.0 in
Tube outside diam.	dt = 0.75 in	Tube thickness	tt = 0.049 in
Tube pitch	p = 0.9375 in	Center-to-center dis	UL = 1.375 in
Tube projection	tpr = 0.0625 in	Tube corrosion allow.	c = -
Tube length L	L = 186.875 in	Tube length Lt	Lt = 191.875 in
Tube expanded depth	ltx = 2.375 in	Tube exp.depth ratio rho	= 0.95
Tube buckling factor	k = 0.8	Unsupported tube span l	l = 58.75 in
Outermost tube rad.	ro = 17.125 in	Unsupp.length lt=k*l	lt = 47.0 in
Shell radius	as = 17.75 in	Channel radius	ac = 18.3598 in
Shell design pressure	Ps = 0 psi	Tube design pressure Pt	= 165 psi
Exp.joint spring rate	kj = -	EJ diameter	Dj = -
Component: Tubesheets			

Fig.UHX-13.1(b) Controlling Case: UHX-13.4(a)(1)

UHX-13.5.1 Step 1. Determine Do, Mu, Mu* and h'g from UHX-11.5.1.

Do = 2 * ro + dt	Do = 35.0 in
mu = (p - dt) / p	mu = 0.2
d* = MAX(dt-2*tt*(Ett/E)*(Stt/S)*Rho), (dt-2*tt)	d* = 0.6573 in
Pass lane area limit	4*Do*p = 131.25 in2
Actual pass lane area, AL	AL = 112.24 in2
Effective pitch = p/SQRT(1-(4*MIN[AL, 4*Do*p]/Pi*Do**2))	p* = 0.9975 in
mu* = (p* - d*) / p*	mu* = 0.3411
h'g = MAX[(hg-ct), (0)]	h'g = 0.0 in
Calculate ao, rhos, rhoc, xs and xt	
ao = radius of the perforated region = Do / 2	ao = 17.5 in
rhos = as/ao	rhos = 1.0143
rhoc = ac/ao	rhoc = 1.0491
xs = 1 - Nt(dt/(2*ao))**2	xs = 0.4825
xt = 1 - Nt((dt-2*tt)/(2*ao))**2	xt = 0.6089

UHX-13.5.2 Step 2. Calculate the shell axial stiffness K_s , tube axial

stiffness K_t , and stiffness factors $K_{s,t}$ and J
 Shell axial stiffness, $K_s = \frac{\pi t_s (D_s + t_s) E_s}{L}$ $K_s = 4056752 \text{ lbf/in}$
 $K_s^* = \frac{\pi (D_s + t_s)}{(L - 2t_s) / (E_s t_s) + (2t_s / (E_s t_s))}$ $K_s^* = -$
 Tube axial stiffness, $K_t = \frac{\pi t_t (d_t - t_t) E_t}{L}$ $K_t = 15591 \text{ lbf/in}$
 Factor $K_{s,t} = K_s / (N_t K_t)$ or $K_{s,t} = K_s^* / (N_t K_t^*)$ $K_{s,t} = 0.2309$
 $J = 1 / (1 + (K_s / K_t))$ $J = 1.0$

Calculate shell coefficients β_s , k_s , λ_{ds} and δ_{ts}

$\beta_s = (12(1 - \nu_s^2))^{0.25} / ((D_s + t_s) t_s)^{0.5}$ $\beta_s = 0.6081$
 $k_s = \beta_s (E_s t_s^3) / (6(1 - \nu_s^2))$ $k_s = 46983$
 $\lambda_{ds} = (6D_s / h^3) k_s (1 + h\beta_s + (h^2 \beta_s^2) / 2)$ $\lambda_{ds} = 2354102$
 $\delta_{ts} = (D_s^2 / (4E_s t_s)) (1 - \nu_s / 2)$ $\delta_{ts} = 0.0000396$

Calculate channel coefficients β_{tc} , k_c , λ_{dc} and δ_{tc}

$\beta_{tc} = (12(1 - \nu_c^2))^{0.25} / ((D_c + t_c) t_c)^{0.5}$ $\beta_{tc} = 0$
 $k_c = \beta_{tc} (E_c t_c^3) / (6(1 - \nu_c^2))$ $k_c = 0$
 $\lambda_{dc} = (6D_c / h^3) k_c (1 + h\beta_{tc} + (h^2 \beta_{tc}^2) / 2)$ $\lambda_{dc} = 0$
 $\delta_{tc} = (D_c^2 / (4E_c t_c)) (1 - \nu_c / 2)$ $\delta_{tc} = 0$

NOTE: If the effect of plasticity used, E_s or E_c will be E_s^* or E_c^*

Component: Tubesheets

Fig.UHX-13.1(b) Controlling Case: UHX-13.4(a) (1)

UHX-13.5.3 Step 3. Calculate h/p . If ρ changes, recalculate d^* and μ^*

from UHX-11.5.1. Determine E^*/E and ν^* relative to h/p from UHX-11.5.2

Layout: Triangular Tubesheet thickness $h = 2.5 \text{ in}$
 From fig. UHX-11.2 or UHX-11.3 - $E^*/E = 0.3353$ $\nu^* = 0.3304$
 $h/p = 2.6667$ $\mu^* = 0.3411$

Effective Tubesheet Mod.Elasticity $E^* = 9054420 \text{ psi}$

Parameter $X_a = \frac{24(1 - \nu^{*2}) N_t (E_t t_t (d_t - t_t) a^2)}{(E^* L^3 h^3)^{0.25}}$ $X_a = 4.011$

UHX-13.5.4 Step 4. Calculate diameter ratio K and coefficient F .

$K = A / D_o$ $K = 1.129$
 $F = ((1 - \nu^*) / E^*) (\lambda_{ds} + \lambda_{dc} + E^* \ln(K))$ $F = 0.416$

Parameters Zd, Zv and Zm from Table UHX-13.1

$\text{Psi1}(Xa) = \text{bei}(Xa) + (1-v^*)/Xa * \text{ber}'(Xa)$	$\text{Psi1}(Xa) = 1.7611$
$\text{Psi2}(Xa) = \text{ber}(Xa) - (1-v^*)/Xa * \text{bei}'(Xa)$	$\text{Psi2}(Xa) = -2.5117$
$Za = \text{bei}'(Xa) * \text{Psi2}(Xa) - \text{ber}'(Xa) * \text{Psi1}(Xa)$	$Za = 6.8515$
$Zd = (\text{ber}(Xa) * \text{Psi2}(Xa) + \text{bei}(Xa) * \text{Psi1}(Xa)) / (Xa^{**3} * Za)$	$Zd = 0.0239$
$Zv = (\text{ber}'(Xa) * \text{Psi2}(Xa) + \text{bei}'(Xa) * \text{Psi1}(Xa)) / (Xa^{**2} * Za)$	$Zv = 0.0635$
$Zm = (\text{ber}'(Xa) ** 2 + \text{bei}'(Xa) ** 2) / (Xa * Za)$	$Zm = 0.3711$
Calculate Q1, Qz1, Qz2 and U	
$\text{Phi} = (1+v^*) * F$	$\text{Phi} = 0.5529$
$Q1 = (\text{rhos} - 1 - \text{Phi} * Zv) / (1 + \text{Phi} * Zm)$	$Q1 = -0.0173$
$Qz1 = ((Zd + Q1 * Zv) * Xa^{**4}) / 2$	$Qz1 = 2.9471$
$Qz2 = ((Zv + Q1 * Zm) * Xa^{**4}) / 2$	$Qz2 = 7.391$
$U = ((Zv + (\text{rhos} - 1) * Zm) * Xa^{**4}) / (1 + \text{Phi} * Zm)$	$U = 14.7819$

UHX-13.5.5 Step 5.

UHX-13.5.5(a) Calculate gamma

$$\text{gamma} = (\text{alpmatm} * (\text{Ttm} - \text{Tamb}) - \text{alphasm} * (\text{Tsm} - \text{Tamb})) * L$$

(=0 for load cases 1, 2, 3)

gamma = 0.0 in

UHX-13.5.5(b) Calculate omegas, omegas*, omegac*

$\text{omegas} = \text{rhos} * \text{ks} * \text{betas} * \text{deltas} * (1 + \text{h} * \text{betas})$	$\text{omegas} = 2.8972$
$\text{omegas}^* = \text{ao}^{**2} * ((\text{rhos}^{**2} - 1) * (\text{rhos} - 1)) / 4 - \text{omegas}$	$\text{omegas}^* = -2.8658$
$\text{omegac} = \text{rhoc} * \text{kc} * \text{betac} * \text{deltac} * (1 + \text{h} * \text{betac})$	$\text{omegac} = 0.0$
$\text{omegac}^* = \text{ao}^{**2} * ((\text{rhoc}^{**2} + 1) * (\text{rhoc} - 1)) / 4 - (\text{rhos} - 1) / 2 - \text{omegac}$	$\text{omegac}^* = 5.7148$

UHX-13.5.5(c) Calculate gammab

gammab = (Gc - C) / Do

gammab = -0.0437

UHX-13.8.4 Calculate Ps* and Pc*.

UHX-13.8.4(a) Determine the average temperature of the unperforated rim Tr
 $Tr = (T's+T's)/2$ $Tr = 128.6$ F

UHX-13.8.4(b) Determine the average temperature of the shell Ts* and channel Tc* at their junction to the tubesheet as follows:

$$Ts^* = (T's+Tr)/2 \quad Ts^* = 128.6 \text{ F}$$

$$Tc^* = (T'c+Tr)/2 \quad Tc^* = 121.5 \text{ F}$$

UHX-13.8.4(c) Calculate Ps* and Pc*

$$Ps^* = (Es^*ts/as) * (\alpha^*s * (Ts^*-70) - \alpha^* * (Tr-70)) \quad Ps^* = 0 \text{ psi}$$

$$Pc^* = (Ec^*tc/ac) * (\alpha^*c * (Tc^*-70) - \alpha^* * (Tr-70)) \quad Pc^* = 0 \text{ psi}$$

UHX-13.8.4(d) Calculate Pomega

$$Pomega = (U/ao^{**2}) (ws * (P*s) - wc * (P*c)) \quad Pomega = 0 \text{ psi}$$

Component: Tubesheets

Fig.UHX-13.1(b) Controlling Case: UHX-13.4(a)(1)

UHX-13.5.6 Step 6. For each loading case calculate Ps', Pt', Pgamma, Pw, Prim, and effective pressure Pe.

$$Ps' = (xs+2*(1-xs)*vt+(2/Kst)*(Ds/Do)^{**2}*vs - (Rhos^{**2}-1)/(J*Kst) - ((1-J)/(2*J*Kst)) * (DJ^{**2} - (2*as)^{**2})/Do^{**2}) * Ps \quad Ps' = 0 \text{ psi}$$

$$Pt' = (xt+2*(1-xt)*vt+1/(J*Kst)) * Pt \quad Pt' = 853.86 \text{ psi}$$

$$Pgamma = (Nt*Kt/(Pi*ao^{**2})) * gamma \quad Pgamma = 0 \text{ psi}$$

$$PW = -(U/ao^{**2}) (gammab/(2*Pi)) * W \quad PW = 62.87 \text{ psi}$$

$$Prim = -(U/ao^{**2}) * ((omegas^*) (Ps) - (omegac^*) (Pt)) \quad Prim = 45.51 \text{ psi}$$

Effective pressure, Pe

$$Pe = (J*Kst/(1+J*Kst(Qz1+(rhos-1)Qz2))) * (Ps' - Pt' + Pgamma + Pomega + PW + Prim) \quad Pe = -100.96 \text{ psi}$$

UHX-13.5.7 Step 7. For each loading case calculate Q2 and Q3.

$$Q2 = ((\omega_{gas}) * P_s - (\omega_{ac}) * P_t) - ((\omega_{gas} * (P_s) - \omega_{ac} * (P_c)) + (\gamma_{ab} / (2 * \pi)) * W) / (1 + \Phi_i * Z_m)$$

$$Q3 = Q1 + 2 * Q2 / Pe * a_o^{**2}$$

$$Q2 = -1863.0881$$

$$Q3 = 0.1032$$

Using Xa and Q3, determine coefficient Fm for each loading case from either Table UHX-13.1 or Figs. UHX-13.3.-1 and UHX-13.3.-2.

$$\text{Controlling } x = 3.1286 \text{ in}$$

Calculate functions Psi1 and Psi2 relative to x

$$\Psi_{i1}(x) = \text{bei}(x) + (1 - \nu^*) / x * \text{ber}'(x) \quad \Psi_{i1}(x) = 1.6702$$

$$\Psi_{i2}(x) = \text{ber}(x) - (1 - \nu^*) / x * \text{bei}'(x) \quad \Psi_{i2}(x) = -0.6071$$

Calculate functions Qm, Qv and Fm relative to x

$$Q_m(x) = (\text{bei}'(X_a) * \Psi_{i2}(x) - \text{ber}'(X_a) * \Psi_{i1}(x)) / Z_a \quad Q_m(x) = 0.8141$$

$$Q_v(x) = (\Psi_{i1}(X_a) * \Psi_{i2}(x) - \Psi_{i2}(X_a) * \Psi_{i1}(x)) / (X_a * Z_a) \quad Q_v(x) = 0.1137$$

Controlling Fm relative to x

$$F_m(x) = (Q_v(x) + Q_3 * Q_m(x)) / 2 \quad F_m(x) = 0.0989$$

$$F_m = \text{MAX}|F_m(x)| \quad F_m = 0.0989$$

For each loading case, calculate the bending stress in the tubesheet

$$\sigma = (1.5 * F_m / \mu^*) * (2 * a_o / (h - h'g))^{**2} * Pe \quad \sigma = -8606 \text{ psi}$$

$$|\sigma| \leq 1.5 * S \quad 8606 \text{ psi} \leq 22500 \text{ psi}$$

UHX-13.5.8 Step 8. For each loading case, calculate the average shear

stress in the tubesheet at the outer edge of the perforated region

$$\text{Area enclosed by perimeter} \quad A_L = 859.02 \text{ in}^2$$

$$\text{Perimeter of the tube layout} \quad C_L = 149.8884 \text{ in}$$

$$\text{Shear diameter } DL = 4 * A_L / C_L \text{ or } D_o \quad D_o = 35.0 \text{ in}$$

$$\text{Ligament efficiency, } \mu \quad \mu = (p - dt) / p = 0.2$$

$$\text{Shear stress, } \tau = (1 / (4 * \mu)) * (D_o / h) * Pe \quad \tau = -1767 \text{ psi}$$

$$|\tau| \leq 0.8 * S \quad 1767 \text{ psi} \leq 12000 \text{ psi}$$

UHX-13.5.9 Step 9. Perform this step for each loading case.

UHX-13.5.9(a) Calculate coefficient F_q and the axial tube stress $\sigma_{mat,o}$ in the outermost tube row

$$\begin{aligned} \text{Factor } F_q &= (Z_d + Q_3 \cdot Z_v) \cdot X_a^{**4/2} = 3.9379 \\ \sigma_{mat,o} &= ((P_s \cdot x_s - P_{txt}) - P_e \cdot F_q) / (x_t - x_s) = 2350 \text{ psi} \\ \sigma_{mat,o} &\leq S_t \\ 2350 \text{ psi} &\leq 14941 \text{ psi} \end{aligned}$$

UHX-13.5.9(b) Check the tubes for buckling.

$$\begin{aligned} C_t &= \text{SQRT}(2 \cdot \text{PI}^{**2} \cdot (E_t / S_y t)) & C_t &= 154.2491 \\ r_t &= \text{SQRT}(d_t^{**2} + (d_t - 2 \cdot t_t)^{**2}) / 4 & r_t &= 0.2484 \text{ in} \\ F_t &= l_t / r_t & F_t &= 189.1762 \\ F_s &= \text{MAX}(1.25, (3.25 - 0.5 \cdot F_q), 2) & F_s &= 1.2811 \\ \text{For } C_t \leq F_t & \quad S_{tb} = \text{MIN}[(1 / F_s) \cdot (\text{PI}^{**2} \cdot E_t / (F_t^{**2}), S_t] & S_{tb} &= -5812 \text{ psi} \\ \text{For } C_t > F_t & \quad S_{tb} = \text{MIN}[(S_y t / F_s) \cdot (1 - (F_t / 2 \cdot C_t)), S_t] & S_{tb} &= - \\ \sigma_{mat,o} &\leq S_{tb} \\ - &\leq -5812 \text{ psi} \end{aligned}$$

UHX-Tube stresses at the interior of the bundle.

Maximum tube compressive stress at the interior of the bundle

$$\begin{aligned} F_t(x) &= Z_{dx} + Q_3 \cdot Z_{wx} \cdot (X_a^{**4/2}) & F_i &= -1.1164 \\ F_i &= f_t(x) & \sigma_{mat,i} &= -1686 \text{ psi} \\ \sigma_{mat,i} &= ((P_s \cdot x_s - P_{txt}) - P_e \cdot F_i) / (x_t - x_s) & \sigma_{mat,i} &\leq S_{tb} \\ -1686 \text{ psi} &\leq -5812 \text{ psi} \end{aligned}$$

UHX-13.5.10 Step 10. For each loading case, calculate the stresses in the shell and /or channel integral with the tubesheet.

Calculate the axial membrane stress σ_{asm} , axial bending stress σ_{asb} and total axial stress σ_{as} in the shell at its junction to the tubesheet

$$\sigma_{asm} = a_o^{**2}/t_s^{**2} * (2 * a_s + t_s) * [P_e + (\rho_{hos}^{**2} - 1) * (P_s - P_t)] + a_s^{**2}/t_s^{**2} * (2 * a_s + t_s) * P_t \quad \sigma_{asm} = 2194 \text{ psi}$$

$$s_{b1} = (6/t_s^{**2}) * k_s$$

$$s_{b2} = \beta_{tas} * (\Delta t_{as} * P_s - v_s * (a_s/E_s) * \sigma_{asm})$$

$$s_{b3} = 6 * (1 - \nu_s^{**2}) / (E_s) * (a_o^{**3}/h^{**3}) * (1 + (h * \beta_{tas} / 2))$$

$$s_{b4} = P_e * (Z_v + Z_m * Q_1) + (2/a_o^{**2}) * Z_m * Q_2$$

$$\sigma_{asb} = s_{b1} * (s_{b2} + s_{b3} * s_{b4}) \quad \sigma_{asb} = -17712 \text{ psi}$$

$$\sigma_{as} = |\sigma_{asm}| + |\sigma_{asb}| \quad \sigma_{as} = 19907 \text{ psi}$$

$$\sigma_{as} \leq 1.5 * S$$

$$19907 \text{ psi} \leq 28350 \text{ psi}$$

ASME VIII-1 2004 A06 UHX-13 - Rules for the Design of Fixed Tubesheets

ASME Fig.UHX-13.1(b) All Load Cases

Controlling case:

Load case:	1	2	3	4	5	6	7
Tube-side press, P_t	165	0	165	0	165	0	165
Shell-side press, P_s	0	90	90	0	0	90	90
Axial diff.Th.Exp	0.0	0.0	0.0	-0.0236	-0.0236	-0.0236	-0.0236
TubSh Bending stress	-8606	4024	-7372	-4915	-11760	-3978	-10303
Max TubSh Bending st	22500	22500	22500	57164	57164	57164	57164
Min TubSh thk	1.5462	1.0572	1.431	0.7331	1.1339	0.6595	1.0613
TubSh Shear stress	-1767	891	-1024	-900	-2801	-162	-2063
Max TubSh Shear str	12000	12000	12000	15244	15244	15244	15244
Min TubSh thk	0.3681	0.1857	0.2134	0.1476	0.4594	0.0265	0.3383
Tubesheet thickness	2.5	2.5	2.5	2.5	2.5	2.5	2.5

Component: Tubesheets

ASME Fig.UHX-13.1(b)

All Load Cases

Controlling case:

Load case:	1	2	3	4	5	6	7
Tubes stress	2350	-294	1796	1691	3812	1129	3249
Max Tubes stress	14941	14941	14941	39048	39048	39048	39048
Max buckling stress	-	-3723	-	-	-	-	-
Total shell stress	19907	10266	9430	10073	22969	3992	12430
Max shell stress	28350	28350	28350	60000	60000	60000	60000
Max shell stress EP	56700	56700	56700				
Total channel stress	4806	0	4806	0	4806	0	4806
Max channel stress	30000	30000	30000	67200	67200	67200	67200
Max channel str. EP	67200	67200	67200				
EP factor - Facts(*)	1.0	1.0	1.0				
EP factor - Factc(*)	1.0	1.0	1.0				
(*) <= 1 used in calculations							
Tube compressive stresses at the interior of the bundle							
Load case:	1	2	3	4	5	6	7
Tubes stress	-1686	-297	-1159	-473	-1991	-	-1462
Max buckling stress	-5812	-3723	-5957	-6191	-5407	-	-6114

Heat Exchanger Mechanical Design

Teams 20.0

File name: E-4401-7793.BJT

Date: 8/24/2007 Time: 9:11:34 AM

ASME VIII-1 2004 A06 UHX-13 - Fixed Tubesheets - All Cases

Load case	Ps psi	Pt psi	Gamma in	Ps* psi	Pc* psi		
- 1 -	0	165	0	0	0		
- 2 -	90	0	0	0	0		
- 3 -	90	165	0	0	0		
- 4 -	0	0	-0.0236	0	0		
- 5 -	0	165	-0.0236	0	0		
- 6 -	90	0	-0.0236	0	0		
- 7 -	90	165	-0.0236	0	0		
Load case	P's psi	P't psi	Pgamma psi	Pomega psi	Pw psi	Prim psi	Pe psi
- 1 -	0	853.9	0	0	62.9	45.5	-101
- 2 -	300.8	0	0	0	62.9	12.4	50.9
- 3 -	300.8	853.9	0	0	62.9	58	-58.5
- 4 -	0	0	-447.9	0	64.8	0	-51.4
- 5 -	0	855.8	-447.9	0	64.8	46.9	-160.1
- 6 -	301.4	0	-447.9	0	64.8	12.8	-9.2
- 7 -	301.4	855.8	-447.9	0	64.8	59.8	-117.9
Load case	Q2	Q3	Fm	Sigma psi	Sigma All psi	Tau psi	Tau All psi
- 1 -	-1863.1	0.1032	0.0989	-8606	22500	-1767	12000
- 2 -	-1294.7	-0.1833	0.0916	4024	22500	891	12000
- 3 -	-2077.1	0.2144	0.1461	-7372	22500	-1024	12000
- 4 -	-1070.3	0.1177	0.1036	-4915	57164	-900	15244
- 5 -	-1845.2	0.0571	0.0796	-11760	57164	-2801	15244
- 6 -	-1282.3	0.8879	0.4666	-3978	57164	-162	15244
- 7 -	-2057.1	0.0958	0.0948	-10303	57164	-2063	15244

Heat Exchanger Mechanical Design

Teams 20.0

File name: E-4401-7793.BJT

Date: 8/24/2007 Time: 9:11:34 AM

ASME VIII-1 2004 A06 UHX-13 - Fixed Tubesheets - All Cases

Load case	Fq	Fs	Sigto psi	Sigto All psi	Stb psi
- 1 -	3.9379	1.2811	2350	14941	-5812
- 2 -	1.5823	2	-294	14941	-3723
- 3 -	4.8521	1.25	1796	14941	-5957
- 4 -	4.1556	1.25	1691	39048	-6191
- 5 -	3.6377	1.4312	3812	39048	-5407
- 6 -	10.7387	-	1129	39048	-
- 7 -	3.9684	1.2658	3249	39048	-6114

Load case	Sigsm psi	Sigsb psi	Sigs psi	Sigsall psi	Sigcm psi	Sigcb psi	Sigc psi	Sigcall psi
- 1 -	2194	-17712	19907	28350	4806	0	4806	30000
- 2 -	1834	8432	10266	28350	0	0	0	30000
- 3 -	3737	-5694	9430	28350	4806	0	4806	30000
- 4 -	-1763	-8310	10073	60000	0	0	0	67200
- 5 -	169	-22800	22969	60000	4806	0	4806	67200
- 6 -	-228	3764	3992	60000	0	0	0	67200
- 7 -	1704	-10726	12430	60000	4806	0	4806	67200

Type of tube-to-TS joint: expanded & strength welded

Load case:	1	2	3	4	5	6	7
Tube-to-TS Load, lbf	254	32	194	182	411	122	351
Allowable no-test	1290	1290	1290	2580	2580	2580	2580
Allowable test	1612	1612	1612	3225	3225	3225	3225

Allowable Loads per ASME Section VIII Div. 1 2004 A06 Appendix A

Type	Joint description	No Test		Test	
		fr	Lmax	fr	Lmax
a	Strength welded only	0.8	1290	1	1612
b	Seal welded only	0.55	887	0.7	1129
e	Strength welded and expanded	0.8	1290	1	1612
f	Seal welded and exp.with 2 grooves	0.75	1209	0.95	1532
g	Seal welded and exp.with 1 groove	0.65	1048	0.85	1370
h	Seal welded and exp.with no grooves	0.5	806	0.7	1129
i	Expanded with 2 grooves	0.7	1129	0.9	1451
j	Expanded with 1 groove	0.65	1048	0.8	1290
k	Expanded with no grooves	0.5	806	0.6	967

* = Load calculated exceeds code allowable for this joint type.

For joints types a,b,b-1,c,d,e : $L_{max} = A_t * S_a * f_r$
 For joints types f,g,h, : $L_{max} = A_t * S_a * f_e * f_r * f_y$
 For joints types i,j,k : $L_{max} = A_t * S_a * f_e * f_r * f_y, f_t$
 Cross-sectional area $A_t = 0.1079 \text{ in}^2$ Tube allowable stress $S_a = 14941 \text{ psi}$
 Factor f_e (1/do or 1) $f_e = 1$ Ratio f_y $f_y = 1$
 $f_t = (P_o + P_t) / P_o$ $f_t = 1$ Min Yield Str $\Sigma_{sigmaM} = 30000 \text{ psi}$
 (ft = 1 if max exceeded)
 Tube OD $d_o = 0.75 \text{ in}$ Tube thickness $t_t = 0.049 \text{ in}$
 Tubes yield str(min) $s_t = 30000 \text{ psi}$ TubSh mean metal tmp $T = 128.6 \text{ F}$
 Tubes Mod.Elasticity $E_tT = 27984192 \text{ psi}$ TubSh Mod.Elast. $E_sT = 27984192 \text{ psi}$
 Tubes Coef.Th.Exp. $a_t = 0.0000087$ TubSh Coef.Th.Exp. $a_s = 0.0000087$
 $P_o = (4 * (d_o * t - t^2) * s_t) / d_o^2$ $P_o = 7328 \text{ psi}$
 $P_t = ((T - T_{amb}) * (a_t - a_s) * (E_tT * E_sT)) / (E_tT + E_sT)$ $P_t = -$
 For joint types i, j, k: $P_o + P_t \leq 0.58 * \Sigma_{sigmaM}$
 $7328 \text{ psi} \leq 17400 \text{ psi}$

UHX-9 Tubesheet Flanged Extension
 $G = \text{diameter of gasket load reaction}$ $G = 36.7197 \text{ in}$
 $hG = \text{gasket moment arm}$ $hG = 0.7652 \text{ in}$
 $S_a = \text{allowable stress for tubesheet extension at ambient temperature}$ $S_a = 20000 \text{ psi}$
 $S_d = \text{allowable stress for tubesheet extension at design temperature}$ $S_d = 15000 \text{ psi}$
 $T_a = \text{ambient temperature}$ $T_a = 70 \text{ F}$
 $T_d = \text{design temperature}$ $T_d = 300 \text{ F}$
 $W_o = \text{flange design bolt load, operating conditions}$ $W_o = 185329 \text{ lbf}$
 $W_g = \text{flange design bolt load, gasket seating}$ $W_g = 187164 \text{ lbf}$
 Minimum required thickness of the tubesheet flanged extension
 $h_{ro} = \text{SQRT}(1.9 * W_o * hG) / (S_d * G)$ $h_{ro} = 0.6994 \text{ in}$
 $h_{rg} = \text{SQRT}(1.9 * W_g * hG) / (S_a * G)$ $h_{rg} = 0.6087 \text{ in}$
 $h_r = \text{MAX}[h_{ro}, h_{rg}]$ $h_r = 0.6994 \text{ in}$

Heat Exchanger Mechanical Design**Teams 20.0**

File name: E-4401-7793.BJT

Date: 8/24/2007 Time: 9:11:34 AM

Component: Nozzle A

ASME VIII-1 2004 A06 UG-27 Thickness of Cylinders under Internal Pressure

--- Calculations --- Cylinder Internal Pressure

Material: SA-312 S30400 Grd TP304 Wld. pipe

Design pressure P = 75 psi Design temperature T = 300 F

Radiography = None Joint efficiency E = 0.85

Design stress S = 15000 psi

Inside corr.allow. cai = 0.0 in Outside corr. all. cao = 0.0 in

Material tolerance tol = 0.0469 in Minimum thickness tmin = 0.1499 in

Outside diameter OD = 24.0 in Corroded radius OR = 12.0 in

- Min. thk. not less than UG-45(a), UG-16(b), UG-45(b):

- UG-45(a) Internal pressure:

$$t = (P \cdot OR / (S \cdot E + 0.4 \cdot P)) + cai + cao + tol = 0.1173 \text{ in} \quad \text{APP.1-1(A)}$$

- UG-45(a) external pressure+cai+cao+tol t = 0.094 in

- UG-16(b) minimum thickness+cai+cao+tol t = 0.1406 in

UG-45(b) Smaller of: t = 0.1499 in

UG-45(b) (4) std pipe*0.875+cai+cao+tol = 0.375 in

- UG-45(b) Greater of: t = 0.1499 in

- UG-45(b) (1)+cai+cao+tol = 0.1499 in

- UG-45(b) (2)+cai+cao+tol = 0 in

Minimum thickness: tmin = 0.1499 in

Nominal thickness: tnom = 0.375 in

ASME Section VIII-1 2004 A06 UG-28 Thickness of Shells under Ext. Pressure

--- Calculations --- Cylinder External Pressure

Material: SA-312 S30400 Grd TP304 Wld. pipe

Design pressure PE = 15 psi Design temperature T = 300 F

Inside corr. allow. CAI = 0 in Corrosion allow. CAO = 0 in

Radiography = None Material tol. Tol = 0 in

Cyl. outside dia. Do = 24 in Cylinder length EP L = 6 in

Nominal thickness tnom = 0.375 in (tnom-CAI-CAO-Tol) t = 0.3281 in

L/Do ratio Ldo = 0.25 Do/t Dot = 73.1429

(2*S) or (0.9*yield) SE = - Mod. of elasticity ME = 27000000 psi

A factor SII-D-FigG A = 0.010953 B factor HA-1 B = 11796

Max allowed external pressure: Pa = 4*B / (3*Dot) = 215.03 psi

Actual external design pressure: PE = 15 psi

(Required cyl. tks. for nozzle attachments at PE, tre = 0.0471 in)

Heat Exchanger Mechanical Design**Teams 20.0**

File name: E-4401-7793.BJT

Date: 8/24/2007 Time: 9:11:34 AM

Component: Reinforcement Nozzle A

ASME Section VIII-1 2004 A06 UG-37 Reinforcement Required for Openings in Shells and Formed Heads

--- Design Conditions:

Int. design pressure PI = 75 psi	Ext. design press. PE = 15 psi
Design temperature T = 300 F	Fig.UW-16.1 Sketch (c)
Vessel material: SA-240 S30400 Grd 304 Plate(G5)	
Inside corr. allow. CAI = 0.0 in	Outside corr.allow.CAO = 0.0 in
Vessel design stress Sv = 18900 psi	Joint efficiency E = 1
Vessel outside dia Do = 52.0 in	Corroded radius OR = 26.0 in
Nominal thickness tnom = 0.5 in	Reinforcement limit lp = 23.25 in
Req. tks. int.pres. tr = 0.103 in	Req. tks.ext.pres. tre = 0.157 in
Corroded thickness t = 0.5 in	Reinf. efficiency E1 = 1.0
Attachment Material: SA-312 S30400 Grd TP304 Wld. pipe	
Inside corr. allow. CAI = 0.0 in	Outside corr.allow.CAO = 0.0 in
Nozzle design stress Sn = 15000 psi	Joint efficiency E = 0.85
Nozzle outside dia. Don = 24.0 in	Corroded radius OR = 12.0 in
Nominal thickness tnom = 0.375 in	Reinforcement limit ln = 0.9375 in
Req.tks. int.pres. trn = 0.0704 in	Req.tks.ext.pres. trne = 0.0471 in
Corroded thickness tn = 0.375 in	Nozzle Projection h = 0.0 in
Reinforcement element material:	
Limit of reinf. Dp = 0.0 in	Nominal thickness te = 0.0 in
Outside diameter = 0.0 in	Design stress Se = 0 psi
Minimum weld size tmin = 0.375 in	Leg size(1/2*tmin)(Act) = 0.0 in
1/2 * tmin (minimum) = 0.0 in	1/2 * tmin (actual) = 0.0 in
Weld tw (minimum) = 0.2625 in	Weld tw (actual) = 0.0 in
Weld tc (minimum) = 0.25 in	Weld tc (actual) = 0.25 in
smaller 0.25 in	Leg size tw (actual) = 0.0 in
tc of 0.7 * tmin	Leg size tc (actual) = 0.3571 in
Outward nozzle weld L1 = 0.3571 in	fr1 = Sn/Sv = 0.7937
Outer element weld L2 = 0.0 in	fr2 = Sn/Sv = 0.7937
Inward nozzle weld L3 = 0.0 in	fr3 = Sn/Sv or Se/Sv = 0.7937
Inward nozzle weld new = 0.0 in	fr4 = Se/Sv = 1.0
Corroded int.proj.thk ti = 0.0 in	

Heat Exchanger Mechanical Design

Teams 20.0

File name: E-4401-7793.BJT

Date: 8/24/2007 Time: 9:11:34 AM

Corroded inside diameter

d = 23.25 in

Vessel wall length available for reinforcement 2*Lp-d = 23.25 in

Plane correction factor (Fig.UG-37) F = 1.0

Offset distance from centerline doff = 0.0 in

Reinforcement areas (internal pressure condition) ASME 2004 UG-37

A1 = Vessel wall. Larger of:

| (2*Lp-d)*(E1*t-F*tr)-2*tn*(E1*t-F*tr)*(1-fr1) | = 9.1686 in2

| 2*(t+tn)*(E1*t-F*tr)-2*tn*(E1*t-F*tr)*(1-fr1) | = 0.6333 in2

A1 = 9.1686 in2

A2 = Nozzle wall outward | 5*(tn-trn)*fr2*t | = 0.6043 in2

Smaller of: | 5*(tn-trn)*fr2*tn | = 0.4532 in2

A2 = 0.4532 in2

A3 = Nozzle wall inward | 5*t*ti*fr2 | = 0.0 in2

Smallest of: | 5*ti*ti*fr2 | = 0.0 in2

| 2*h*ti*fr2 | = 0.0 in2

A3 = 0.0 in2

A41 = Outward nozzle weld = (L1**2)*fr3 = 0.1012 in2

A42 = Outer element weld = (L2**2)*fr4 = 0.0 in2

A43 = Inward nozzle weld = (L3**2)*fr2 = 0.0 in2

A4 = 0.1012 in2

A5 = Reinforcement pad Area = (Dp-d-2*tn)*te*fr4

A5 = 0.0 in2

Aa = Area Available = A1+A2+A3+A4+A5

Aa = 9.723 in2

A = Area required = (d*tr*F)+2*tn*tr*F*(1-f1)

A = 2.411 in2

For large nozzles per 1-7:

Reinforcement limit Dp2 = MIN(Dp, 1-7(a)(1))

Dp2 = 34.875 in

A52 = Reinforcement pad Area = (Dp2-d-2*tn)*te*fr4

A52 = 0.0 in2

A12 = Vessel wall. Larger of:

| (1.5Lp-d)*(E1*t-F*tr)-2*tn*(E1*t-F*tr)*(1-fr1) | = 4.5536 in

| 2*(t+tn)*(E1*t-F*tr)-2*tn*(E1*t-F*tr)*(1-fr1) | = 0.6333 in

Aa2 = Area Available = A12+A2+A3+A4+A52

Aa2 = 5.108 in2

A = (2/3)Area required = (2/3)*((d*tr*F)+2*tn*tr*F*(1-f1))

A = 1.6073 in2

Note: Parallel and normal limits per 1-7(a)(1) and 1-7(a)(2). Calculations per 1-7(b) only shown if required (see 1-7(b)(1)(a),(b),(c)).

ASME VIII-1 2004 A06 Reinforcement areas (external pressure) UG-37(d)

A1 = Vessel wall. Larger of:

| (2*Lp-d)*(E1*t-F*tre)-2*tn*(E1*t-F*tre)*(1-fr1) | = 7.9217 in2

| 2*(t+tn)*(E1*t-F*tre)-2*tn*(E1*t-F*tre)*(1-fr1) | = 0.5472 in2

A1 = 7.9217 in2

A2 = Nozzle wall outward | 5*(tn-trne)*fr2*t | = 0.6505 in2

Smaller of: | 5*(tn-trne)*fr2*tn | = 0.4879 in2

A2 = 0.4879 in2

A3 = Nozzle wall inward | 5*t*ti*fr2 | = 0.0 in2

Smallest of: | 5*ti*ti*fr2 | = 0.0 in2

| 2*h*ti*fr2 | = 0.0 in2

A3 = 0.0 in2

A41 = Outward nozzle weld = (L1**2)*fr3 = 0.1012 in2

A42 = Outer element weld = (L2**2)*fr4 = 0.0 in2

A43 = Inward nozzle weld = (L3**2)*fr2 = 0.0 in2

A4 = 0.1012 in2

A5 = Reinforcement pad Area = (Dp-d-2*tn)*te*fr4

A5 = 0.0 in2

Aa = Area Available = A1+A2+A3+A4+A5

Aa = 8.5108 in2

A = Area required = 0.5*(d*tre*F+2*tn*tre*F*(1-fr1))

A = 1.8373 in2

Nozzle attachment weld loads - UG-41 - Strength of reinforcement

ASME - Weld strength calculations not required per UW-15(b).
 Total weld load (UG-41(b)(2))
 $W = (A-A1+2*tn*fr1(E1*t-F*tr))*Sv$ W = -
 Weld load for strength path 1-1 (UG-41(b)(1))
 $W(1-1) = (A2+A5+A41+A42)*Sv$ W(1-1) = 10480 lbf
 Weld load for strength path 2-2 (UG-41(b)(1))
 $W(2-2) = (A2+A3+A41+A43+2*tn*t*fr1)*Sv$ W(2-2) = 16105 lbf
 Weld load for strength path 3-3 (UG-41(b)(1))
 $W(3-3) = (A2+A3+A5+A41+A42+A43+2*tn*t*fr1)*Sv$ W(3-3) = -
 Reinforcing element strength = $A5 * Se$ = -

Nozzle attachment weld loads - ASME 2004 UG-41 - Strength of reinforcement

Unit stresses - UW15(c) and UG-45(c)
 Inner fillet weld shear = 7350 psi
 Outer fillet weld shear = -
 Groove weld tension = 11100 psi
 Groove weld shear = -
 Nozzle wall shear = 10500 psi
 Strength of connection elements
 Inner fillet weld shear = 98911 lbf
 Nozzle wall shear = 146047 lbf
 Groove weld tension = 149375 lbf
 Outer fillet weld shear = -
 Possible paths of failure
 1-1 146047 + 98911 = 244958 lbf
 2-2 98911 + 149375 = 248286 lbf
 3-3 - + - = -
 Welds strong enough if path greater than the smaller of W or W(path)
 Path 1-1 > W or W11
 244958 lbf > 10480 lbf OK
 Path 2-2 > W or W22
 248286 lbf > 16105 lbf OK
 Path 3-3 > W or W33
 - > -

Heat Exchanger Mechanical Design**Teams 20.0**

File name: E-4401-7793.BJT

Date: 8/24/2007 Time: 9:11:34 AM

Component: Nozzle B

ASME VIII-1 2004 A06 UG-27 Thickness of Cylinders under Internal Pressure

--- Calculations --- Cylinder Internal Pressure

Material: SA-312 S30400 Grd TP304 Wld. pipe

Design pressure P = 75 psi Design temperature T = 300 F

Radiography = None Joint efficiency E = 0.85

Design stress S = 15000 psi

Inside corr.allow. cai = 0.0 in Outside corr. all. cao = 0.0 in

Material tolerance tol = 0.0192 in Minimum thickness tmin = 0.113 in

Outside diameter OD = 2.375 in Corroded radius OR = 1.1875 in

- Min. thk. not less than UG-45(a), UG-16(b), UG-45(b):

- UG-45(a) Internal pressure:

$$t = (P \cdot OR / (S \cdot E + 0.4 \cdot P)) + cai + cao + tol = 0.0262 \text{ in} \quad \text{APP.1-1(A)}$$

- UG-45(a) external pressure+cai+cao+tol t = 0.031 in

- UG-16(b) minimum thickness+cai+cao+tol t = 0.113 in

UG-45(b) Smaller of: t = 0.0906 in

UG-45(b) (4) std pipe*0.875+cai+cao+tol = 0.154 in

- UG-45(b) Greater of: t = 0.0906 in

- UG-45(b) (1)+cai+cao+tol = 0.0906 in

- UG-45(b) (2)+cai+cao+tol = 0.0335 in

Minimum thickness: tmin = 0.113 in

Nominal thickness: tnom = 0.154 in

ASME Section VIII-1 2004 A06 UG-28 Thickness of Shells under Ext. Pressure

--- Calculations --- Cylinder External Pressure

Material: SA-312 S30400 Grd TP304 Wld. pipe

Design pressure PE = 15 psi Design temperature T = 300 F

Inside corr. allow. CAI = 0 in Corrosion allow. CAO = 0 in

Radiography = None Material tol. Tol = 0 in

Cyl. outside dia. Do = 2.375 in Cylinder length EP L = 6 in

Nominal thickness tnom = 0.154 in (tnom-CAI-CAO-Tol) t = 0.1347 in

L/Do ratio Ldo = 2.5263 Do/t Dot = 17.6252

(2*S) or (0.9*yield) SE = - Mod. of elasticity ME = 27000000 psi

A factor SII-D-FigG A = 0.006845 B factor HA-1 B = 11348

Max allowed external pressure: Pa = 4*B / (3*Dot) = 858.48 psi

Actual external design pressure: PE = 15 psi

(Required cyl. tks. for nozzle attachments at PE, tre = 0.0118 in)

Component: Reinforcement Nozzle B

ASME Section VIII-1 2004 A06 UG-37 Reinforcement Required for Openings in Shells and Formed Heads

--- Design Conditions:

Int. design pressure PI = 75 psi	Ext. design press. PE = 15 psi
Design temperature T = 300 F	Fig.UW-16.1 Sketch (c)
Vessel material: SA-240 S30400 Grd 304 Plate(G5)	
Inside corr. allow. CAI = 0.0 in	Outside corr.allow.CAO = 0.0 in
Vessel design stress Sv = 18900 psi	Joint efficiency E = 1
Vessel outside dia Do = 36.0 in	Corroded radius OR = 18.0 in
Nominal thickness tnom = 0.25 in	Reinforcement limit lp = 2.067 in
Req. tks. int.pres. tr = 0.0713 in	Req. tks.ext.pres. tre = 0.162 in
Corroded thickness t = 0.25 in	Reinf. efficiency E1 = 1.0
Attachment Material: SA-312 S30400 Grd TP304 Wld. pipe	
Inside corr. allow. CAI = 0.0 in	Outside corr.allow.CAO = 0.0 in
Nozzle design stress Sn = 15000 psi	Joint efficiency E = 0.85
Nozzle outside dia. Don = 2.375 in	Corroded radius OR = 1.1875 in
Nominal thickness tnom = 0.154 in	Reinforcement limit ln = 0.385 in
Req.tks. int.pres. trn = 0.007 in	Req.tks.ext.pres. trne = 0.0118 in
Corroded thickness tn = 0.154 in	Nozzle Projection h = 0.0 in
Reinforcement element material:	
Limit of reinf. Dp = 0.0 in	Nominal thickness te = 0.0 in
Outside diameter = 0.0 in	Design stress Se = 0 psi
Minimum weld size tmin = 0.154 in	Leg size(1/2*tmin)(Act) = 0.0 in
1/2 * tmin (minimum) = 0.0 in	1/2 * tmin (actual) = 0.0 in
Weld tw (minimum) = 0.1078 in	Weld tw (actual) = 0.0 in
Weld tc (minimum) = 0.1078 in	Weld tc (actual) = 0.1078 in
smaller {0.25 in	Leg size tw (actual) = 0.0 in
tc of {0.7 * tmin	Leg size tc (actual) = 0.154 in
Outward nozzle weld L1 = 0.154 in	fr1 = Sn/Sv = 0.7937
Outer element weld L2 = 0.0 in	fr2 = Sn/Sv = 0.7937
Inward nozzle weld L3 = 0.0 in	fr3 = Sn/Sv or Se/Sv = 0.7937
Inward nozzle weld new = 0.0 in	fr4 = Se/Sv = 1.0
Corroded int.proj.thk ti = 0.0 in	

Heat Exchanger Mechanical Design

Teams 20.0

File name: E-4401-7793.BJT

Date: 8/24/2007 Time: 9:11:34 AM

Corroded inside diameter

d = 2.067 in

Vessel wall length available for reinforcement $2 * Lp - d = 2.067$ in

Plane correction factor (Fig.UG-37) $F = 1.0$

Offset distance from centerline $doff = 0.0$ in

Reinforcement areas (internal pressure condition) ASME 2004 UG-37

A1 = Vessel wall. Larger of:

$$|(2 * Lp - d) * (E1 * t - F * tr) - 2 * tn * (E1 * t - F * tr) * (1 - fr1)| = 0.358 \text{ in}^2$$

$$|2 * (t + tn) * (E1 * t - F * tr) - 2 * tn * (E1 * t - F * tr) * (1 - fr1)| = 0.133 \text{ in}^2$$

A1 = 0.358 in2

A2 = Nozzle wall outward $| 5 * (tn - trn) * fr2 * t | = 0.1459$ in2

Smaller of: $| 5 * (tn - trn) * fr2 * tn | = 0.0899$ in2

A2 = 0.0899 in2

A3 = Nozzle wall inward $| 5 * t * ti * fr2 | = 0.0$ in2

Smallest of: $| 5 * ti * ti * fr2 | = 0.0$ in2

$| 2 * h * ti * fr2 | = 0.0$ in2

A3 = 0.0 in2

A41 = Outward nozzle weld = $(L1 ** 2) * fr3 = 0.0188$ in2

A42 = Outer element weld = $(L2 ** 2) * fr4 = 0.0$ in2

A43 = Inward nozzle weld = $(L3 ** 2) * fr2 = 0.0$ in2

A4 = 0.0188 in2

A5 = Reinforcement pad Area = $(Dp - d - 2 * tn) * te * fr4$

A5 = 0.0 in2

Aa = Area Available = $A1 + A2 + A3 + A4 + A5$

Aa = 0.4667 in2

A = Area required = $(d * tr * F) + 2 * tn * tr * F * (1 - f1)$

A = 0.1519 in2

Per UG-36(c)(3)(a), this opening does NOT require additional reinforcement other than the inherent in the construction.

ASME VIII-1 2004 A06 Reinforcement areas (external pressure) UG-37(d)

A1 = Vessel wall. Larger of:

$$|(2 * Lp - d) * (E1 * t - F * tre) - 2 * tn * (E1 * t - F * tre) * (1 - fr1)| = 0.1763 \text{ in}^2$$

$$|2 * (t + tn) * (E1 * t - F * tre) - 2 * tn * (E1 * t - F * tre) * (1 - fr1)| = 0.0655 \text{ in}^2$$

A1 = 0.1763 in2

A2 = Nozzle wall outward $| 5 * (tn - trne) * fr2 * t | = 0.1411$ in2

Smaller of: $| 5 * (tn - trne) * fr2 * tn | = 0.0869$ in2

A2 = 0.0869 in2

A3 = Nozzle wall inward $| 5 * t * ti * fr2 | = 0.0$ in2

Smallest of: $| 5 * ti * ti * fr2 | = 0.0$ in2

$| 2 * h * ti * fr2 | = 0.0$ in2

A3 = 0.0 in2

A41 = Outward nozzle weld = $(L1 ** 2) * fr3 = 0.0188$ in2

A42 = Outer element weld = $(L2 ** 2) * fr4 = 0.0$ in2

A43 = Inward nozzle weld = $(L3 ** 2) * fr2 = 0.0$ in2

A4 = 0.0188 in2

A5 = Reinforcement pad Area = $(Dp - d - 2 * tn) * te * fr4$

A5 = 0.0 in2

Aa = Area Available = $A1 + A2 + A3 + A4 + A5$

Aa = 0.2821 in2

A = Area required = $0.5 * (d * tre * F + 2 * tn * tre * F * (1 - fr1))$

A = 0.1726 in2

Nozzle attachment weld loads - UG-41 - Strength of reinforcement

ASME - Weld strength calculations not required per UW-15(b).

Total weld load (UG-41(b)(2))

$$W = (A-A1+2*tn*fr1(E1*t-F*tr))*Sv$$

W = -

Weld load for strength path 1-1 (UG-41(b)(1))

$$W(1-1) = (A2+A5+A41+A42)*Sv$$

W(1-1) = 2054 lbf

Weld load for strength path 2-2 (UG-41(b)(1))

$$W(2-2) = (A2+A3+A41+A43+2*tn*t*fr1)*Sv$$

W(2-2) = 3209 lbf

Weld load for strength path 3-3 (UG-41(b)(1))

$$W(3-3) = (A2+A3+A5+A41+A42+A43+2*tn*t*fr1)*Sv$$

W(3-3) = -

Reinforcing element strength = A5 * Se

= -

Nozzle attachment weld loads - ASME 2004 UG-41 - Strength of reinforcement

Unit stresses - UW15(c) and UG-45(c)

Inner fillet weld shear = 7350 psi

Outer fillet weld shear = -

Groove weld tension = 11100 psi

Groove weld shear = -

Nozzle wall shear = 10500 psi

Strength of connection elements

Inner fillet weld shear = 4221 lbf

Nozzle wall shear = 5639 lbf

Groove weld tension = 6374 lbf

Outer fillet weld shear = -

Possible paths of failure

1-1 5639 + 4221 = 9860 lbf

2-2 4221 + 6374 = 10595 lbf

3-3 - + - = -

Welds strong enough if path greater than the smaller of W or W(path)

Path 1-1 > W or W11

9860 lbf > 2054 lbf OK

Path 2-2 > W or W22

10595 lbf > 3209 lbf OK

Path 3-3 > W or W33

- > -

Heat Exchanger Mechanical Design**Teams 20.0**

File name: E-4401-7793.BJT

Date: 8/24/2007 Time: 9:11:34 AM

Component: Nozzle C

ASME VIII-1 2004 A06 UG-27 Thickness of Cylinders under Internal Pressure

--- Calculations --- Cylinder Internal Pressure

Material: SA-53 K03005 Grd E/B Wld. pipe

Design pressure P = 150 psi Design temperature T = 300 F

Radiography = None Joint efficiency E = 0.85

Design stress S = 14600 psi

Inside corr.allow. cai = 0.0625 in Outside corr. all. cao = 0.0 in

Material tolerance tol = 0.0456 in Minimum thickness tmin = 0.2427 in

Outside diameter OD = 10.75 in Corroded radius OR = 5.375 in

- Min. thk. not less than UG-45(a), UG-16(b), UG-45(b):

- UG-45(a) Internal pressure:

$$t = (P \cdot OR / (S \cdot E + 0.4 \cdot P)) + cai + cao + tol = 0.1728 \text{ in} \quad \text{APP.1-1(A)}$$

- UG-45(a) external pressure+cai+cao+tol t = 0.136 in

- UG-16(b) minimum thickness+cai+cao+tol t = 0.2019 in

UG-45(b) Smaller of: t = 0.2427 in

UG-45(b) (4) std pipe*0.875+cai+cao+tol = 0.4275 in

- UG-45(b) Greater of: t = 0.2427 in

- UG-45(b) (1)+cai+cao+tol = 0.2427 in

- UG-45(b) (2)+cai+cao+tol = 0.1216 in

Minimum thickness: tmin = 0.2427 in

Nominal thickness: tnom = 0.365 in

ASME Section VIII-1 2004 A06 UG-28 Thickness of Shells under Ext. Pressure

--- Calculations --- Cylinder External Pressure

Material: SA-53 K03005 Grd E/B Wld. pipe

Design pressure PE = 15 psi Design temperature T = 300 F

Inside corr. allow. CAI = 0.0625 in Corrosion allow. CAO = 0 in

Radiography = None Material tol. Tol = 0 in

Cyl. outside dia. Do = 10.75 in Cylinder length EP L = 6 in

Nominal thickness tnom = 0.365 in (tnom-CAI-CAO-Tol) t = 0.2569 in

L/Do ratio Ldo = 0.5581 Do/t Dot = 41.8491

(2*S) or (0.9*yield) SE = - Mod. of elasticity ME = 28100000 psi

A factor SII-D-FigG A = 0.009869 B factor CS-2 B = 17368

Max allowed external pressure: Pa = 4*B / (3*Dot) = 553.35 psi

Actual external design pressure: PE = 15 psi

(Required cyl. tks. for nozzle attachments at PE, tre = 0.0279 in)

Heat Exchanger Mechanical Design

Teams 20.0

File name: E-4401-7793.BJT

Date: 8/24/2007 Time: 9:11:34 AM

Component: Reinforcement Nozzle C

ASME Section VIII-1 2004 A06 UG-37 Reinforcement Required for Openings in Shells and Formed Heads

--- Design Conditions:

Int. design pressure PI = 150 psi	Ext. design press. PE = 15 psi
Design temperature T = 300 F	Fig.UW-16.1 Sketch (c)
Vessel material: SA-516 K02700 Grd 70 Plate	
Inside corr. allow. CAI = 0.0625 in	Outside corr.allow.CAO = 0.0 in
Vessel design stress Sv = 20000 psi	Joint efficiency E = 1
Vessel outside dia Do = 36.0 in	Corroded radius OR = 18.0 in
Nominal thickness tnom = 0.375 in	Reinforcement limit lp = 10.145 in
Req. tks. int.pres. tr = 0.1346 in	Req. tks.ext.pres. tre = 0.1015 in
Corroded thickness t = 0.3125 in	Reinf. efficiency E1 = 1.0
Attachment Material: SA-53 K03005 Grd E/B Wld. pipe	
Inside corr. allow. CAI = 0.0625 in	Outside corr.allow.CAO = 0.0 in
Nozzle design stress Sn = 14600 psi	Joint efficiency E = 0.85
Nozzle outside dia. Don = 10.75 in	Corroded radius OR = 5.375 in
Nominal thickness tnom = 0.365 in	Reinforcement limit ln = 0.7563 in
Req.tks. int.pres. trn = 0.0647 in	Req.tks.ext.pres. trne = 0.0279 in
Corroded thickness tn = 0.3025 in	Nozzle Projection h = 0.0 in
Reinforcement element material:	
Limit of reinf. Dp = 0.0 in	Nominal thickness te = 0.0 in
Outside diameter = 0.0 in	Design stress Se = 0 psi
Minimum weld size tmin = 0.3025 in	Leg size(1/2*tmin)(Act)= 0.0 in
1/2 * tmin (minimum) = 0.0 in	1/2 * tmin (actual) = 0.0 in
Weld tw (minimum) = 0.2118 in	Weld tw (actual) = 0.0 in
Weld tc (minimum) = 0.2118 in	Weld tc (actual) = 0.2118 in
smaller 0.25 in	Leg size tw (actual) = 0.0 in
tc of 0.7 * tmin	Leg size tc (actual) = 0.3025 in
Outward nozzle weld L1 = 0.3025 in	fr1 = Sn/Sv = 0.73
Outer element weld L2 = 0.0 in	fr2 = Sn/Sv = 0.73
Inward nozzle weld L3 = 0.0 in	fr3 = Sn/Sv or Se/Sv = 0.73
Inward nozzle weld new = 0.0 in	fr4 = Se/Sv = 1.0
Corroded int.proj.thk ti = 0.0 in	

Corroded inside diameter

$d = 10.145 \text{ in}$

Vessel wall length available for reinforcement $2*Lp-d = 10.145 \text{ in}$ Plane correction factor (Fig.UG-37) $F = 1.0$ Offset distance from centerline $doff = 0.0 \text{ in}$

Reinforcement areas (internal pressure condition) ASME 2004 UG-37

A1 = Vessel wall. Larger of:

$| (2*Lp-d)*(E1*t-F*tr)-2*tn*(E1*t-F*tr)*(1-fr1) | = 1.7758 \text{ in}^2$

$| 2*(t+tn)*(E1*t-F*tr)-2*tn*(E1*t-F*tr)*(1-fr1) | = 0.1898 \text{ in}^2$

$A1 = 1.7758 \text{ in}^2$

A2 = Nozzle wall outward $| 5*(tn-trn)*fr2*t | = 0.2713 \text{ in}^2$ Smaller of: $| 5*(tn-trn)*fr2*tn | = 0.2626 \text{ in}^2$

$A2 = 0.2626 \text{ in}^2$

A3 = Nozzle wall inward $| 5*t*ti*fr2 | = 0.0 \text{ in}^2$ Smallest of: $| 5*ti*ti*fr2 | = 0.0 \text{ in}^2$

$| 2*h*ti*fr2 | = 0.0 \text{ in}^2$

$A3 = 0.0 \text{ in}^2$

A41 = Outward nozzle weld = $(L1**2)*fr3 = 0.0668 \text{ in}^2$ A42 = Outer element weld = $(L2**2)*fr4 = 0.0 \text{ in}^2$ A43 = Inward nozzle weld = $(L3**2)*fr2 = 0.0 \text{ in}^2$

$A4 = 0.0668 \text{ in}^2$

A5 = Reinforcement pad Area = $(Dp-d-2*tn)*te*fr4$

$A5 = 0.0 \text{ in}^2$

Aa = Area Available = $A1+A2+A3+A4+A5$

$Aa = 2.1052 \text{ in}^2$

A = Area required = $(d*tr*F)+2*tn*tr*F*(1-f1)$

$A = 1.3875 \text{ in}^2$

ASME VIII-1 2004 A06 Reinforcement areas (external pressure) UG-37(d)

A1 = Vessel wall. Larger of:

$| (2*Lp-d)*(E1*t-F*tre)-2*tn*(E1*t-F*tre)*(1-fr1) | = 2.1061 \text{ in}^2$

$| 2*(t+tn)*(E1*t-F*tre)-2*tn*(E1*t-F*tre)*(1-fr1) | = 0.2251 \text{ in}^2$

$A1 = 2.1061 \text{ in}^2$

A2 = Nozzle wall outward $| 5*(tn-trne)*fr2*t | = 0.3132 \text{ in}^2$ Smaller of: $| 5*(tn-trne)*fr2*tn | = 0.3032 \text{ in}^2$

$A2 = 0.3032 \text{ in}^2$

A3 = Nozzle wall inward $| 5*t*ti*fr2 | = 0.0 \text{ in}^2$ Smallest of: $| 5*ti*ti*fr2 | = 0.0 \text{ in}^2$

$| 2*h*ti*fr2 | = 0.0 \text{ in}^2$

$A3 = 0.0 \text{ in}^2$

A41 = Outward nozzle weld = $(L1**2)*fr3 = 0.0668 \text{ in}^2$ A42 = Outer element weld = $(L2**2)*fr4 = 0.0 \text{ in}^2$ A43 = Inward nozzle weld = $(L3**2)*fr2 = 0.0 \text{ in}^2$

$A4 = 0.0668 \text{ in}^2$

A5 = Reinforcement pad Area = $(Dp-d-2*tn)*te*fr4$

$A5 = 0.0 \text{ in}^2$

Aa = Area Available = $A1+A2+A3+A4+A5$

$Aa = 2.4761 \text{ in}^2$

A = Area required = $0.5*(d*tre*F+2*tn*tre*F*(1-fr1))$

$A = 0.5231 \text{ in}^2$

Heat Exchanger Mechanical Design

Teams 20.0

File name: E-4401-7793.BJT

Date: 8/24/2007 Time: 9:11:34 AM

Nozzle attachment weld loads - UG-41 - Strength of reinforcement

ASME - Weld strength calculations not required per UW-15(b).

Total weld load (UG-41(b)(2))

$W = (A-A1+2*tn*fr1(E1*t-F*tr))*Sv$

$W = -$

Weld load for strength path 1-1 (UG-41(b)(1))

$W(1-1) = (A2+A5+A41+A42)*Sv$

$W(1-1) = 6588 \text{ lbf}$

Weld load for strength path 2-2 (UG-41(b)(1))

$W(2-2) = (A2+A3+A41+A43+2*tn*t*fr1)*Sv$

$W(2-2) = 9349 \text{ lbf}$

Weld load for strength path 3-3 (UG-41(b)(1))

$W(3-3) = (A2+A3+A5+A41+A42+A43+2*tn*t*fr1)*Sv$

$W(3-3) = -$

Reinforcing element strength = $A5 * Se$

$= -$

Nozzle attachment weld loads - ASME 2004 UG-41 - Strength of reinforcement

Unit stresses - UW15(c) and UG-45(c)

Inner fillet weld shear = 7154 psi

Outer fillet weld shear = -

Groove weld tension = 10804 psi

Groove weld shear = -

Nozzle wall shear = 10220 psi

Strength of connection elements

Inner fillet weld shear = 36525 lbf

Nozzle wall shear = 50710 lbf

Groove weld tension = 55160 lbf

Outer fillet weld shear = -

Possible paths of failure

1-1 50710 + 36525 = 87235 lbf

2-2 36525 + 55160 = 91685 lbf

3-3 - + - = -

Welds strong enough if path greater than the smaller of W or W(path)

Path 1-1 > W or W11

87235 lbf > 6588 lbf OK

Path 2-2 > W or W22

91685 lbf > 9349 lbf OK

Path 3-3 > W or W33

= > -

Heat Exchanger Mechanical Design

Teams 20.0

File name: E-4401-7793.BJT Date: 8/24/2007 Time: 9:11:34 AM

Component: Nozzle D

ASME VIII-1 2004 A06 UG-27 Thickness of Cylinders under Internal Pressure

--- Calculations --- Cylinder Internal Pressure

Material: SA-53 K03005 Grd E/B Wld. pipe

Design pressure P = 150 psi Design temperature T = 300 F

Radiography = None Joint efficiency E = 0.85

Design stress S = 14600 psi

Inside corr.allow. cai = 0.0625 in Outside corr. all. cao = 0.0 in

Material tolerance tol = 0.0456 in Minimum thickness tmin = 0.2427 in

Outside diameter OD = 10.75 in Corroded radius OR = 5.375 in

- Min. thk. not less than UG-45(a), UG-16(b), UG-45(b):

- UG-45(a) Internal pressure:
t = (P*OR / (S*E+0.4*P))+cai+cao+tol = 0.1728 in APP.1-1(A)

- UG-45(a) external pressure+cai+cao+tol t = 0.136 in

- UG-16(b) minimum thickness+cai+cao+tol t = 0.2019 in

UG-45(b) Smaller of: t = 0.2427 in

UG-45(b) (4) std pipe*0.875+cai+cao+tol = 0.4275 in

- UG-45(b) Greater of: t = 0.2427 in

- UG-45(b) (1)+cai+cao+tol = 0.2427 in

- UG-45(b) (2)+cai+cao+tol = 0.1216 in

Minimum thickness: tmin = 0.2427 in

Nominal thickness: tnom = 0.365 in

ASME Section VIII-1 2004 A06 UG-28 Thickness of Shells under Ext. Pressure

--- Calculations --- Cylinder External Pressure

Material: SA-53 K03005 Grd E/B Wld. pipe

Design pressure PE = 15 psi Design temperature T = 300 F

Inside corr. allow. CAI = 0.0625 in Corrosion allow. CAO = 0 in

Radiography = None Material tol. Tol = 0 in

Cyl. outside dia. Do = 10.75 in Cylinder length EP L = 6 in

Nominal thickness tnom = 0.365 in (tnom-CAI-CAO-Tol) t = 0.2569 in

L/Do ratio Ldo = 0.5581 Do/t Dot = 41.8491

(2*S) or (0.9*yield) SE = - Mod. of elasticity ME = 28100000 psi

A factor SII-D-FigG A = 0.009869 B factor CS-2 B = 17368

Max allowed external pressure: Pa = 4*B / (3*Dot) = 553.35 psi

Actual external design pressure: PE = 15 psi

(Required cyl. tks. for nozzle attachments at PE, tre = 0.0279 in)

Heat Exchanger Mechanical Design

Teams 20.0

File name: E-4401-7793.BJT

Date: 8/24/2007 Time: 9:11:34 AM

Component: Reinforcement Nozzle D

ASME Section VIII-1 2004 A06 UG-37 Reinforcement Required for Openings in Shells and Formed Heads

--- Design Conditions:

Int. design pressure PI = 150 psi	Ext. design press. PE = 15 psi
Design temperature T = 300 F	Fig.UW-16.1 Sketch (c)
Vessel material: SA-516 K02700 Grd 70 Plate	
Inside corr. allow. CAI = 0.0625 in	Outside corr.allow.CAO = 0.0 in
Vessel design stress Sv = 20000 psi	Joint efficiency E = 1
Vessel outside dia Do = 36.0 in	Corroded radius OR = 18.0 in
Nominal thickness tnom = 0.375 in	Reinforcement limit lp = 10.145 in
Req. tks. int.pres. tr = 0.1346 in	Req. tks.ext.pres. tre = 0.1015 in
Corroded thickness t = 0.3125 in	Reinf. efficiency E1 = 1.0
Attachment Material: SA-53 K03005 Grd E/B Wld. pipe	
Inside corr. allow. CAI = 0.0625 in	Outside corr.allow.CAO = 0.0 in
Nozzle design stress Sn = 14600 psi	Joint efficiency E = 0.85
Nozzle outside dia. Don = 10.75 in	Corroded radius OR = 5.375 in
Nominal thickness tnom = 0.365 in	Reinforcement limit ln = 0.7563 in
Req.tks. int.pres. trn = 0.0647 in	Req.tks.ext.pres. trne = 0.0279 in
Corroded thickness tn = 0.3025 in	Nozzle Projection h = 0.0 in
Reinforcement element material:	
Limit of reinf. Dp = 0.0 in	Nominal thickness te = 0.0 in
Outside diameter = 0.0 in	Design stress Se = 0 psi
Minimum weld size tmin = 0.3025 in	Leg size(1/2*tmin) (Act) = 0.0 in
1/2 * tmin (minimum) = 0.0 in	1/2 * tmin (actual) = 0.0 in
Weld tw (minimum) = 0.2118 in	Weld tw (actual) = 0.0 in
Weld tc (minimum) = 0.2118 in	Weld tc (actual) = 0.2118 in
smaller 0.25 in	Leg size tw (actual) = 0.0 in
tc of 0.7 * tmin	Leg size tc (actual) = 0.3025 in
Outward nozzle weld L1 = 0.3025 in	fr1 = Sn/Sv = 0.73
Outer element weld L2 = 0.0 in	fr2 = Sn/Sv = 0.73
Inward nozzle weld L3 = 0.0 in	fr3 = Sn/Sv or Se/Sv = 0.73
Inward nozzle weld new = 0.0 in	fr4 = Se/Sv = 1.0
Corroded int.proj.thk ti = 0.0 in	

Corroded inside diameter $d = 10.145$ in
Vessel wall length available for reinforcement $2*Lp-d = 10.145$ in
Plane correction factor (Fig.UG-37) $F = 1.0$
Offset distance from centerline $doff = 0.0$ in
Reinforcement areas (internal pressure condition) ASME 2004 UG-37
A1 = Vessel wall. Larger of:
 $| (2*Lp-d)*(E1*t-F*tr)-2*tn*(E1*t-F*tr)*(1-fr1) | = 1.7758$ in2
 $| 2*(t+tn)*(E1*t-F*tr)-2*tn*(E1*t-F*tr)*(1-fr1) | = 0.1898$ in2
A1 = 1.7758 in2
A2 = Nozzle wall outward $| 5*(tn-trn)*fr2*t | = 0.2713$ in2
Smaller of: $| 5*(tn-trn)*fr2*tn | = 0.2626$ in2
A2 = 0.2626 in2
A3 = Nozzle wall inward $| 5*t*ti*fr2 | = 0.0$ in2
Smallest of: $| 5*ti*ti*fr2 | = 0.0$ in2
 $| 2*h*ti*fr2 | = 0.0$ in2
A3 = 0.0 in2
A41 = Outward nozzle weld = $(L1**2)*fr3 = 0.0668$ in2
A42 = Outer element weld = $(L2**2)*fr4 = 0.0$ in2
A43 = Inward nozzle weld = $(L3**2)*fr2 = 0.0$ in2
A4 = 0.0668 in2
A5 = Reinforcement pad Area = $(Dp-d-2*tn)*te*fr4$ A5 = 0.0 in2
Aa = Area Available = $A1+A2+A3+A4+A5$ Aa = 2.1052 in2
A = Area required = $(d*tr*F)+2*tn*tr*F*(1-f1)$ A = 1.3875 in2
ASME VIII-1 2004 A06 Reinforcement areas (external pressure) UG-37(d)
A1 = Vessel wall. Larger of:
 $| (2*Lp-d)*(E1*t-F*tre)-2*tn*(E1*t-F*tre)*(1-fr1) | = 2.1061$ in2
 $| 2*(t+tn)*(E1*t-F*tre)-2*tn*(E1*t-F*tre)*(1-fr1) | = 0.2251$ in2
A1 = 2.1061 in2
A2 = Nozzle wall outward $| 5*(tn-trne)*fr2*t | = 0.3132$ in2
Smaller of: $| 5*(tn-trne)*fr2*tn | = 0.3032$ in2
A2 = 0.3032 in2
A3 = Nozzle wall inward $| 5*t*ti*fr2 | = 0.0$ in2
Smallest of: $| 5*ti*ti*fr2 | = 0.0$ in2
 $| 2*h*ti*fr2 | = 0.0$ in2
A3 = 0.0 in2
A41 = Outward nozzle weld = $(L1**2)*fr3 = 0.0668$ in2
A42 = Outer element weld = $(L2**2)*fr4 = 0.0$ in2
A43 = Inward nozzle weld = $(L3**2)*fr2 = 0.0$ in2
A4 = 0.0668 in2
A5 = Reinforcement pad Area = $(Dp-d-2*tn)*te*fr4$ A5 = 0.0 in2
Aa = Area Available = $A1+A2+A3+A4+A5$ Aa = 2.4761 in2
A = Area required = $0.5*(d*tre*F+2*tn*tre*F*(1-fr1))$ A = 0.5231 in2

Heat Exchanger Mechanical Design

Teams 20.0

File name: E-4401-7793.BJT

Date: 8/24/2007 Time: 9:11:34 AM

Nozzle attachment weld loads - UG-41 - Strength of reinforcement

ASME - Weld strength calculations not required per UW-15(b).

Total weld load (UG-41(b)(2))

W = (A-A1+2*tn*frl(E1*t-F*tr))*Sv

W = -

Weld load for strength path 1-1 (UG-41(b)(1))

W(1-1) = (A2+A5+A41+A42)*Sv

W(1-1) = 6588 lbf

Weld load for strength path 2-2 (UG-41(b)(1))

W(2-2) = (A2+A3+A41+A43+2*tn*t*frl)*Sv

W(2-2) = 9349 lbf

Weld load for strength path 3-3 (UG-41(b)(1))

W(3-3) = (A2+A3+A5+A41+A42+A43+2*tn*t*frl)*Sv

W(3-3) = -

Reinforcing element strength = A5 * Se

= -

Nozzle attachment weld loads - ASME 2004 UG-41 - Strength of reinforcement

Unit stresses - UW15(c) and UG-45(c)

Inner fillet weld shear = 7154 psi

Outer fillet weld shear = -

Groove weld tension = 10804 psi

Groove weld shear = -

Nozzle wall shear = 10220 psi

Strength of connection elements

Inner fillet weld shear = 36525 lbf

Nozzle wall shear = 50710 lbf

Groove weld tension = 55160 lbf

Outer fillet weld shear = -

Possible paths of failure

1-1 50710 + 36525 = 87235 lbf

2-2 36525 + 55160 = 91685 lbf

3-3 - + - = -

Welds strong enough if path greater than the smaller of W or W(path)

Path 1-1 > W or W11

87235 lbf > 6588 lbf OK

Path 2-2 > W or W22

91685 lbf > 9349 lbf OK

Path 3-3 > W or W33

- > -

Heat Exchanger Mechanical Design**Teams 20.0**

File name: E-4401-7793.BJT

Date: 8/24/2007 Time: 9:11:34 AM

Component: Nozzle G

ASME VIII-1 2004 A06 UG-27 Thickness of Cylinders under Internal Pressure

--- Calculations --- Cylinder Internal Pressure

Material: SA-312 S30400 Grd TP304 Wld. pipe

Design pressure P = 75 psi Design temperature T = 300 F

Radiography = None Joint efficiency E = 0.85

Design stress S = 15000 psi

Inside corr.allow. cai = 0.0 in Outside corr. all. cao = 0.0 in

Material tolerance tol = 0.0168 in Minimum thickness tmin = 0.1105 in

Outside diameter OD = 6.625 in Corroded radius OR = 3.3125 in

- Min. thk. not less than UG-45(a), UG-16(b), UG-45(b):

- UG-45(a) Internal pressure:

$$t = (P \cdot OR / (S \cdot E + 0.4 \cdot P)) + cai + cao + tol = 0.0362 \text{ in} \quad \text{APP.1-1(A)}$$

- UG-45(a) external pressure+cai+cao+tol t = 0.038 in

- UG-16(b) minimum thickness+cai+cao+tol t = 0.1105 in

UG-45(b) Smaller of: t = 0.0881 in

UG-45(b) (4) std pipe*0.875+cai+cao+tol = 0.2618 in

- UG-45(b) Greater of: t = 0.0881 in

- UG-45(b) (1)+cai+cao+tol = 0.0881 in

- UG-45(b) (2)+cai+cao+tol = 0.031 in

Minimum thickness: tmin = 0.1105 in

Nominal thickness: tnom = 0.134 in

ASME Section VIII-1 2004 A06 UG-28 Thickness of Shells under Ext. Pressure

--- Calculations --- Cylinder External Pressure

Material: SA-312 S30400 Grd TP304 Wld. pipe

Design pressure PE = 15 psi Design temperature T = 300 F

Inside corr. allow. CAI = 0 in Corrosion allow. CAO = 0 in

Radiography = None Material tol. Tol = 0 in

Cyl. outside dia. Do = 6.625 in Cylinder length EP L = 6 in

Nominal thickness tnom = 0.134 in (tnom-CAI-CAO-Tol) t = 0.1173 in

L/Do ratio Ldo = 0.9057 Do/t Dot = 56.5032

(2*S) or (0.9*yield) SE = - Mod. of elasticity ME = 27000000 psi

A factor SII-D-FigG A = 0.003604 B factor HA-1 B = 10554

Max allowed external pressure: Pa = 4*B / (3*Dot) = 249.05 psi

Actual external design pressure: PE = 15 psi

(Required cyl. tks. for nozzle attachments at PE, tre = 0.0213 in)

Heat Exchanger Mechanical Design

Teams 20.0

File name: E-4401-7793.BJT

Date: 8/24/2007 Time: 9:11:34 AM

Component: Reinforcement Nozzle G

ASME Section VIII-1 2004 A06 UG-37 Reinforcement Required for Openings in Shells and Formed Heads

--- Design Conditions:

Int. design pressure PI = 75 psi	Ext. design press. PE = 15 psi
Design temperature T = 300 F	Fig.UW-16.1 Sketch (c)
Vessel material: SA-240 S30400 Grd 304 Plate(G5)	
Inside corr. allow. CAI = 0.0 in	Outside corr.allow.CAO = 0.0 in
Vessel design stress Sv = 18900 psi	Joint efficiency E = 1
Vessel outside dia Do = 36.0 in	Corroded radius OR = 18.0 in
Nominal thickness tnom = 0.25 in	Reinforcement limit lp = 6.357 in
Req. tks. int.pres. tr = 0.0713 in	Req. tks.ext.pres. tre = 0.162 in
Corroded thickness t = 0.25 in	Reinf. efficiency E1 = 1.0
Attachment Material: SA-312 S30400 Grd TP304 Wld. pipe	
Inside corr. allow. CAI = 0.0 in	Outside corr.allow.CAO = 0.0 in
Nozzle design stress Sn = 15000 psi	Joint efficiency E = 0.85
Nozzle outside dia. Don = 6.625 in	Corroded radius OR = 3.3125 in
Nominal thickness tnom = 0.134 in	Reinforcement limit ln = 0.335 in
Req.tks.int.pres. trn = 0.0194 in	Req.tks.ext.pres. trne = 0.0213 in
Corroded thickness tn = 0.134 in	Nozzle Projection h = 0.0 in
Reinforcement element material:	
Limit of reinf. Dp = 0.0 in	Nominal thickness te = 0.0 in
Outside diameter = 0.0 in	Design stress Se = 0 psi
Minimum weld size tmin = 0.134 in	Leg size(1/2*tmin)(Act) = 0.0 in
1/2 * tmin (minimum) = 0.0 in	1/2 * tmin (actual) = 0.0 in
Weld tw (minimum) = 0.0938 in	Weld tw (actual) = 0.0 in
Weld tc (minimum) = 0.0938 in	Weld tc (actual) = 0.0938 in
smaller 0.25 in	Leg size tw (actual) = 0.0 in
tc of 0.7 * tmin	Leg size tc (actual) = 0.134 in
Outward nozzle weld L1 = 0.134 in	fr1 = Sn/Sv = 0.7937
Outer element weld L2 = 0.0 in	fr2 = Sn/Sv = 0.7937
Inward nozzle weld L3 = 0.0 in	fr3 = Sn/Sv or Se/Sv = 0.7937
Inward nozzle weld new = 0.0 in	fr4 = Se/Sv = 1.0
Corroded int.proj.thk ti = 0.0 in	

Heat Exchanger Mechanical Design

Teams 20.0

File name: E-4401-7793.BJT

Date: 8/24/2007 Time: 9:11:34 AM

Corroded inside diameter

d = 6.357 in

Vessel wall length available for reinforcement $2*Ln-d = 6.357$ in

Plane correction factor (Fig.UG-37) $F = 1.0$

Offset distance from centerline $doff = 0.0$ in

Reinforcement areas (internal pressure condition) ASME 2004 UG-37

A1 = Vessel wall. Larger of:

$| (2*Ln-d)*(E1*t-F*tr)-2*tn*(E1*t-F*tr)*(1-fr1) | = 1.126$ in2

$| 2*(t+tn)*(E1*t-F*tr)-2*tn*(E1*t-F*tr)*(1-fr1) | = 0.1273$ in2

A1 = 1.126 in2

A2 = Nozzle wall outward $| 5*(tn-trn)*fr2*t | = 0.1137$ in2

Smaller of: $| 5*(tn-trn)*fr2*tn | = 0.0609$ in2

A2 = 0.0609 in2

A3 = Nozzle wall inward $| 5*t*ti*fr2 | = 0.0$ in2

Smallest of: $| 5*ti*ti*fr2 | = 0.0$ in2

$| 2*h*ti*fr2 | = 0.0$ in2

A3 = 0.0 in2

A41 = Outward nozzle weld = $(L1**2)*fr3 = 0.0143$ in2

A42 = Outer element weld = $(L2**2)*fr4 = 0.0$ in2

A43 = Inward nozzle weld = $(L3**2)*fr2 = 0.0$ in2

A4 = 0.0143 in2

A5 = Reinforcement pad Area = $(Dp-d-2*tn)*te*fr4$

A5 = 0.0 in2

Aa = Area Available = $A1+A2+A3+A4+A5$

Aa = 1.2012 in2

A = Area required = $(d*tr*F)+2*tn*tr*F*(1-f1)$

A = 0.4573 in2

ASME VIII-1 2004 A06 Reinforcement areas (external pressure) UG-37(d)

A1 = Vessel wall. Larger of:

$| (2*Ln-d)*(E1*t-F*tre)-2*tn*(E1*t-F*tre)*(1-fr1) | = 0.5545$ in2

$| 2*(t+tn)*(E1*t-F*tre)-2*tn*(E1*t-F*tre)*(1-fr1) | = 0.0627$ in2

A1 = 0.5545 in2

A2 = Nozzle wall outward $| 5*(tn-trne)*fr2*t | = 0.1119$ in2

Smaller of: $| 5*(tn-trne)*fr2*tn | = 0.06$ in2

A2 = 0.06 in2

A3 = Nozzle wall inward $| 5*t*ti*fr2 | = 0.0$ in2

Smallest of: $| 5*ti*ti*fr2 | = 0.0$ in2

$| 2*h*ti*fr2 | = 0.0$ in2

A3 = 0.0 in2

A41 = Outward nozzle weld = $(L1**2)*fr3 = 0.0143$ in2

A42 = Outer element weld = $(L2**2)*fr4 = 0.0$ in2

A43 = Inward nozzle weld = $(L3**2)*fr2 = 0.0$ in2

A4 = 0.0143 in2

A5 = Reinforcement pad Area = $(Dp-d-2*tn)*te*fr4$

A5 = 0.0 in2

Aa = Area Available = $A1+A2+A3+A4+A5$

Aa = 0.6288 in2

A = Area required = $0.5*(d*tre*F+2*tn*tre*F*(1-fr1))$

A = 0.5194 in2

Nozzle attachment weld loads - UG-41 - Strength of reinforcement

ASME - Weld strength calculations not required per UW-15(b).

Total weld load (UG-41(b) (2))

W = (A-A1+2*tn*fr1(E1*t-F*tr))*Sv W = -

Weld load for strength path 1-1 (UG-41(b) (1))

W(1-1) = (A2+A5+A41+A42)*Sv W(1-1) = 1421 lbf

Weld load for strength path 2-2 (UG-41(b) (1))

W(2-2) = (A2+A3+A41+A43+2*tn*t*fr1)*Sv W(2-2) = 2426 lbf

Weld load for strength path 3-3 (UG-41(b) (1))

W(3-3) = (A2+A3+A5+A41+A42+A43+2*tn*t*fr1)*Sv W(3-3) = -

Reinforcing element strength = A5 * Se = -

Nozzle attachment weld loads - ASME 2004 UG-41 - Strength of reinforcement

Unit stresses - UW15(c) and UG-45(c)

Inner fillet weld shear = 7350 psi

Outer fillet weld shear = -

Groove weld tension = 11100 psi

Groove weld shear = -

Nozzle wall shear = 10500 psi

Strength of connection elements

Inner fillet weld shear = 10245 lbf

Nozzle wall shear = 14339 lbf

Groove weld tension = 15471 lbf

Outer fillet weld shear = -

Possible paths of failure

1-1 14339 + 10245 = 24584 lbf

2-2 10245 + 15471 = 25716 lbf

3-3 - + - = -

Welds strong enough if path greater than the smaller of W or W(path)

Path 1-1 > W or W11 24584 lbf > 1421 lbf OK

Path 2-2 > W or W22 25716 lbf > 2426 lbf OK

Path 3-3 > W or W33 - > -

Component: Nozzle B


Method: Local Stresses in Cylindrical Shell Due to External Loadings per Heat Exchange Institute (HEI 'Std For Power Plant Hx', First Edition)

Vessel: Shell Cylinder SA-240 S30400 Grd 304 Plate(G5)
 Design pressure Pr = 75 psi Design temperature T = 300 F
 Joint efficiency E = 1.00
 Vessel design stress S = 18900 psi Vessel yield stress Sy = 22400 psi
 Inside corr. allow. CAI = 0.0 in Outside corr. all. CAO = 0.0 in
 Vessel outside dia. OD = 36.0 in Vessel mean radius Rm = 17.875 in
 Vessel thickness tnom = 0.25 in

Nozzle:
 Nozzle outside dia. ODN = 2.375 in Nozzle outside rad. ro = 1.1875 in
 Reinf. pad:
 Pad thickness Prtk = 0.0 in Vessel + pad tks. T = 0.25 in

Shape factors and Coefficients:
 Gamma = Rm/T = 71.5 Beta = 0.875*ro/Rm = 0.0581
 Alpha = 4876.22 Sigma = 3202.91 Delta = 2029.70
 Conversion factor Cf = 1

Maximum load & moment
 S = 2*pr*(Rm-T/2)/t = 10650 psi
 Sa = shell allowable stress = 18900 psi
 Sig = minimum of S & Sa = 10650 psi
 Frrf = Rm*Rm*(sy-sig)/alpha = 770 lbf
 Mrcm = Rm*Rm*ro*sy*cf/sigma = 2654 lbf*in
 Mrlm = Rm*Rm*ro*(sy-sig)*cf/delta = 2197 lbf*in
 Frf = maximum resultant force = 770 lbf
 Mrm = maximum resultant moment = 2197 lbf*in

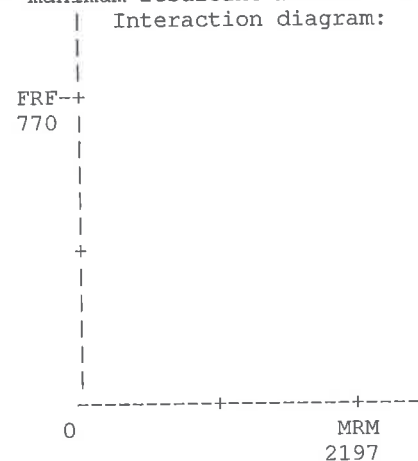

Interaction diagram:
 Applied loads:
 Radial load P = 0 lbf
 Circ. moment Mc = 0 lbf*in
 Long. moment Ml = 0 lbf*in
 Maximum allowable loads:
 Radial Load P, Mc = 770 lbf
 Radial Load P, Ml = 770 lbf
 Mc or Ml (from P) = 2197 lbf*in

Note: Couples (P,Mc) & (P,Ml) must be located within the triangle limited by 0, FRF, MRM.

Heat Exchanger Mechanical Design

Teams 20.0

File name: E-4401-7793.BJT

Date: 8/24/2007 Time: 9:11:34 AM

Component: Nozzle C


Method: Local Stresses in Cylindrical Shell Due to External Loadings per Heat Exchange Institute (HEI 'Std For Power Plant Hx', First Edition)

Vessel: Rear Head Cylinder SA-516 K02700 Grd 70 Plate
Design pressure Pr = 150 psi Design temperature T = 300 F
Joint efficiency E = 1.00
Vessel design stress S = 20000 psi Vessel yield stress Sy = 33600 psi
Inside corr. allow. CAI = 0.0625 in Outside corr. all. CAO = 0.0 in
Vessel outside dia. OD = 36.0 in Vessel mean radius Rm = 17.8438 in
Vessel thickness tnom = 0.375 in

Nozzle:
Nozzle outside dia. ODn = 10.75 in Nozzle outside rad. ro = 5.375 in
Reinf. pad:
Pad thickness Prtk = 0.0 in Vessel + pad tks. T = 0.3125 in

Shape factors and Coefficients:
Gamma = Rm/T = 57.1 Beta = 0.875*ro/Rm = 0.2636
Alpha = 854.67 Sigma = 1405.13 Delta = 559.85
Conversion factor Cf = 1

Maximum load & moment
S = 2*pr*(Rm-T/2)/t = 16980 psi
Sa = shell allowable stress = 20000 psi
Sig = minimum of S & Sa = 16980 psi
Frrf = Rm*Rm*(sy-sig)/alpha = 6192 lbf
Mrcm = Rm*Rm*ro*sy*cf/sigma = 40923 lbf*in
Mrlm = Rm*Rm*ro*(sy-sig)*cf/delta = 50806 lbf*in
Frf = maximum resultant force = 6192 lbf
Mrm = maximum resultant moment = 40923 lbf*in

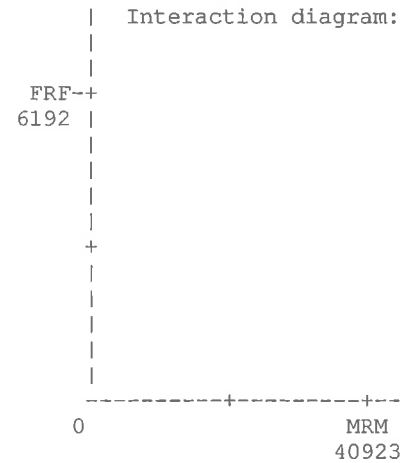

Interaction diagram:
Applied loads:
Radial load P = 0 lbf
Circ. moment Mc = 0 lbf*in
Long. moment Ml = 0 lbf*in
Maximum allowable loads:
Radial Load P,Mc = 6192 lbf
Radial Load P,Ml = 6192 lbf
Mc or Ml (from P) = 40923 lbf*in

Note: Couples (P,Mc) & (P,Ml) must be located within the triangle limited by 0, FRF, MRM.

Component: Nozzle D


Method: Local Stresses in Cylindrical Shell Due to External Loadings per Heat Exchange Institute (HEI 'Std For Power Plant Hx', First Edition)

Vessel: Rear Head Cylinder SA-516 K02700 Grd 70 Plate
 Design pressure Pr = 150 psi Design temperature T = 300 F
 Joint efficiency E = 1.00
 Vessel design stress S = 20000 psi Vessel yield stress Sy = 33600 psi
 Inside corr. allow. CAI = 0.0625 in Outside corr. all. CAO = 0.0 in
 Vessel outside dia. OD = 36.0 in Vessel mean radius Rm = 17.8438 in
 Vessel thickness tnom = 0.375 in

Nozzle:
 Nozzle outside dia. ODN = 10.75 in Nozzle outside rad. ro = 5.375 in
 Reinf. pad:
 Pad thickness Prtk = 0.0 in Vessel + pad tks. T = 0.3125 in

Shape factors and Coefficients:
 Gamma = Rm/T = 57.1 Beta = 0.875*ro/Rm = 0.2636
 Alpha = 854.67 Sigma = 1405.13 Delta = 559.85
 Conversion factor Cf = 1

Maximum load & moment
 S = 2*pr*(Rm-T/2)/t = 16980 psi
 Sa = shell allowable stress = 20000 psi
 Sig = minimum of S & Sa = 16980 psi
 Frrf = Rm*Rm*(sy-sig)/alpha = 6192 lbf
 Mrcm = Rm*Rm*ro*sy*cf/sigma = 40923 lbf*in
 Mrlm = Rm*Rm*ro*(sy-sig)*cf/delta = 50806 lbf*in
 Frf = maximum resultant force = 6192 lbf
 Mrm = maximum resultant moment = 40923 lbf*in

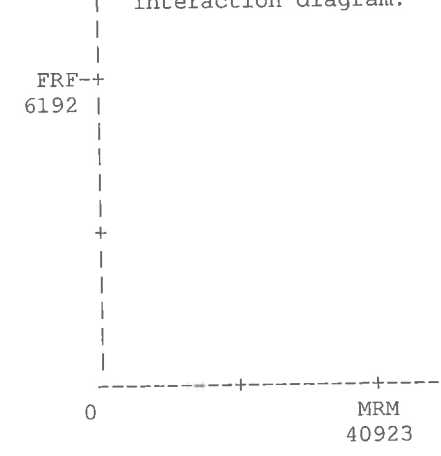

Interaction diagram:
 Applied loads:
 Radial load P = 0 lbf
 Circ. moment Mc = 0 lbf*in
 Long. moment Ml = 0 lbf*in
 Maximum allowable loads:
 Radial Load P, Mc = 6192 lbf
 Radial Load P, Ml = 6192 lbf
 Mc or Ml (from P) = 40923 lbf*in

Note: Couples (P,Mc) & (P,Ml) must be located within the triangle limited by 0, FRF, MRM.

Heat Exchanger Mechanical Design

Teams 20.0

File name: E-4401-7793.BJT

Date: 8/24/2007 Time: 9:11:34 AM

Component: Nozzle G


Method: Local Stresses in Cylindrical Shell Due to External Loadings per Heat Exchange Institute (HEI 'Std For Power Plant Hx', First Edition)

Vessel: Shell Cylinder SA-240 S30400 Grd 304 Plate(G5)
Design pressure Pr = 75 psi Design temperature T = 300 F
Joint efficiency E = 1.00
Vessel design stress S = 18900 psi Vessel yield stress Sy = 22400 psi
Inside corr. allow. CAI = 0.0 in Outside corr. all. CAO = 0.0 in
Vessel outside dia. OD = 36.0 in Vessel mean radius Rm = 17.875 in
Vessel thickness tnom = 0.25 in

Nozzle:
Nozzle outside dia. ODN = 6.625 in Nozzle outside rad. ro = 3.3125 in
Reinf. pad:
Pad thickness Prtk = 0.0 in Vessel + pad tks. T = 0.25 in

Shape factors and Coefficients:
Gamma = Rm/T = 71.5 Beta = 0.875*ro/Rm = 0.1622
Alpha = 2130.17 Sigma = 2477.62 Delta = 1262.12
Conversion factor Cf = 1

Maximum load & moment
S = 2*pr*(Rm-T/2)/t = 10650 psi
Sa = shell allowable stress = 18900 psi
Sig = minimum of S & Sa = 10650 psi
Frrf = Rm*Rm*(sy-sig)/alpha = 1762 lbf
Mrcm = Rm*Rm*ro*sy*cf/sigma = 9569 lbf*in
Mrlm = Rm*Rm*ro*(sy-sig)*cf/delta = 9853 lbf*in
Frf = maximum resultant force = 1762 lbf
Mrm = maximum resultant moment = 9569 lbf*in

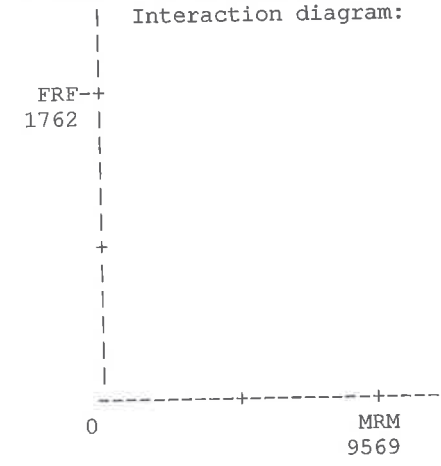

Interaction diagram:
Applied loads:
Radial load P = 0 lbf
Circ. moment Mc = 0 lbf*in
Long. moment Ml = 0 lbf*in
Maximum allowable loads:
Radial Load P, Mc = 1762 lbf
Radial Load P, Ml = 1762 lbf
Mc or Ml (from P) = 9569 lbf*in

Note: Couples (P,Mc) & (P,Ml) must be located within the triangle limited by 0, FRF, MRM.

Component: Nozzle Flange Details

Flange, Gasket and Bolting Details

Dimensional data in

Nozzle	Flg Type	Flg Dia.(*)	Flg Rating	Neck		Bolt Cir.	Gaskets		Bolts	
				Flg tks	Flg tks		O.D.	Width	No	Dia.
A	ANSI SO	24.0	150	0.375	1.88	29.5	27.25	1.62	20	1.25
B	ANSI SO	2.375	150	0.154	0.75	4.75	3.62	0.62	4	0.625
C	ANSI SO	10.75	150	0.365	1.19	14.25	12.75	1.0	12	0.875
D	ANSI SO	10.75	150	0.365	1.19	14.25	12.75	1.0	12	0.875
G	ANSI SO	6.625	150	0.134	1.0	9.5	8.5	0.94	8	0.75

* Dia. = Nozzle O.D. if standard flange
= Flange O.D. if non-standard flange

Heat Exchanger Mechanical Design**Teams 20.0**

File name: E-4401-7793.BJT

Date: 8/24/2007 Time: 9:11:34 AM

Wind loads - ANSI/SEI/ASCE 7-02

Vessel outside diameter OD = 36 in
 Vessel effective length EL = 257.0625 in
 Vessel effective diameter EOD = 54 in
 Effective wind area Af = EOD*EL = 96.4 ft²
 Velocity pressure exposure Kz = 0.85
 Topographic factor Kzt = 1
 Directionality factor Kd = 1
 Importance factor I = 1
 Wind speed, m/h V = 100
 Velocity pressure, qz, lbf/ft² = 0.00256*Kz*Kzt*I*V**2 = 21.8
 Gust response factor G = 0.85
 Force coefficient Cf = 1
 Wind force F = qz*G*Cf*Af = 1783 lbf
 Moment arm L = 10.71 ft
 Overturning moment, OM, ft-lbf OM = F*L = 19097

Earthquake Loads - ANSI/SEI/ASCE 7-02

Equipment occupancy category - wind/seismic design = II
 Equipment seismic site class = B
 Equipment seismic use group = I
 Response modification factor R = 3
 Seismic importance factor I = 1
 Mapped maximum spectral response acceleration at short periods Ss = 0.75
 Mapped maximum spectral response acceleration at 1-sec period S1 = 0.2
 Site coefficient Fa - Table 9.4.1.2.4a Fa = 1
 Site coefficient Fv - Table 9.4.1.2.4b Fv = 1
 Maximum spectral response acceleration short periods Sms = Fa*Ss = 0.75
 Maximum spectral response acceleration at 1-sec per. Sml = Fv*S1 = 0.2
 Spectral response acceleration at short periods Sds = (2/3)*Sms = 0.5
 Spectral response acceleration at 1-sec period Sd1 = (2/3)*Sml = 0.13
 Seismic response coefficient, Cs = Sds/(R/I) Cs = 0.17
 CsMin = 0.5*S1/(R/I) CsMin = 0.03
 Seismic zone coefficient, Cv = 0.24
 Weight of vessel, full W = 22005 lbf
 Total shear at the base, V = Cs * W V = 3667.5 lbf
 Maximum lateral force, F = V F = 3667.5 lbf
 Overturning moment, OM, ft-lbf OM = 0.5*F*L = 19641

Wind and Seismic Loads - Effect on Lugs

Distance center of vessel to supports		$l = 0 \text{ ft}$
Distance center of gravity to supports		$L = 0 \text{ ft}$
Distance between bolt holes (diametrical)		$B = 0 \text{ ft}$
Projected area of vessel	$A_f = EOD * EL$	$A_f = 0.02 \text{ ft}^2$
Wind force	$F = A_f * C_f * G * q_z$	$F = 20000 \text{ lbf}$
Wind load	$Q_w = F * l / B$	$Q_w = 6 \text{ lbf}$
Horizontal seismic force	$F_h = C_s * W$	$F_h = 15 \text{ lbf}$
Vertical seismic force	$F_v = C_v * W$	$F_v = 300 \text{ lbf}$
Seismic load	$Q_s = F_v + F_h * L / B$	$Q_s = 4627 \text{ lbf}$
Controlling load, $Q = Q_{\max}(Q_w, Q_s)$		$Q = 0 \text{ lbf}$

Heat Exchanger Mechanical Design

Teams 20.0

File name: E-4401-7793.BJT

Date: 8/24/2007 Time: 9:11:34 AM

Weights, surface area, Insulation

	Shell side	Tube side
Volume	54.58	75.16
Avg. fluid density	0	0
Fluid weight	0	0
Surface area	150.7	51.2
Surface Area	201.9 ft2	
Insulation thickness	-	-
Insulation type	-	-
Insulation density	-	-
Insulation weight	-	-
Insulation seals and jackets	-	-
Weight of Accessories	-	-
Weight of piping attached SS nozzles	-	-
Weight of piping attached TS nozzles	-	-
Empty weight	13911 lb	
Operating weight	22005 lb	
Full weight	22005 lb	

Heat Exchanger Mechanical Design

Teams 20.0

File name: E-4401-7793.BJT

Date: 8/24/2007 Time: 9:11:34 AM

Component: Shell Lifting Lugs

Calculation of Plate-type Lifting Lugs

Lug material: SA-36 K02600 Plate

Pad material: SA-240 S30400 Grd 304 Plate

Basic data:

Thickness	tb = 1.5 in	Length	L = 10.0 in
Outside radius	Rl = 2.0 in	Radius of hole	Rh = 1.0 in
Weld size	n = 0.25 in	Vessel outside radius	R = 18.0 in
Allowable stress	Sa = 16600 psi	Vessel thickness	ta = 0.25 in
Yield stress vessel	Sy = 22400 psi	Empty weight per lug	W = 9274 lbf
Distance vessel surface to lug hole		d	d = 4.5 in
Factor f	f = 0.5 in	Number of lugs	nl = 3

Calculation of allowable lug load, P (minimum of P1 or P2):

$P1 = Sa \cdot tb / (0.33 / (Rl - Rh) + 0.76 \cdot (Rl + rh) / (Rl - Rh) ** 2) = 9540 \text{ lbf}$

$P2 = 1.5 \cdot Sa \cdot tb \cdot L / ((10.4 \cdot (d + f) / L) + 1) = 60242 \text{ lbf}$

$(P > W) \quad P = 9540 \text{ lbf}$

Component: Shell Lifting Lugs

Calculation of the minimum required weld size, n

$n = 6.8 \cdot W \cdot d / l ** 2 \cdot Sa = 0.171 \text{ in}$

Calculation of the required vessel thickness to resist lug loads, ts

Equivalent radius of lug, RE = $0.644 \cdot (tb \cdot l ** 2) ** (1/3) = 3.4218 \text{ in}$

$ts = (0.415 \cdot \text{SQRT}(R) / Sy \cdot (1.734 \cdot W \cdot (d + f) / (RE ** 2)) + 0.75 \cdot W / RE) ** 2 / 3$

$ts = 0.788 \text{ in}$

Minimum reinforcing pad thickness, tp

$tp = ts - ta = 0.538 \text{ in}$

	Actual	Entered
Reinforcement pad thickness	0.5625 in	0.625 in
Pad dimension parallel to the lug:	15.0 in	0.0 in
Pad dimension perpendicular to the lug:	7.5 in	0.0 in

Heat Exchanger Mechanical Design

Teams 20.0

File name: E-4401-7793.BJT

Date: 8/24/2007 Time: 9:11:34 AM

Maximum Allowable Working Pressures

* = Shell Side MAWP + = Tube Side MAWP

Component	Side	--Design conditions--			---- New and cold ----		
		Temp F	Stress psi	MAWP psi	Temp F	Stress psi	MAWP psi
Shell Cylinder	S	300	18900	184.8	70	20000	195.5
Front Head Cylinder	T	300	20000	244.8	70	20000	294.1
Rear Head Cylinder	T	300	20000	244.8	70	20000	294.1
Front Head Cover	T	300	20000	299.8	70	20000	360.9
Rear Head Cover	T	300	20000	299.8	70	20000	360.9
Front Tubesheet	S	300	15000	133.3	70	20000	133.3
Front Tubesheet	T	300	15000	244.4	70	20000	244.4
Rear Tubesheet	S	300	15000	133.3	70	20000	133.3
Rear Tubesheet	T	300	15000	244.4	70	20000	244.4
Front Head Flng At TS	T	300	20000	154.6	70	20000	154.6
Rear Head Flng At TS	T	300	20000	154.6	70	20000	154.6
Tubes	T	300	12700	1751	70	17000	2343.8
Nozzle A	S	300	15000	239.7	70	20000	253.7
Nozzle B	S	300	15000	141.9	70	20000	150.2
Nozzle C	T	300	14600	287.1	70	14600	357.4
Nozzle D	T	300	14600	287.1	70	14600	357.4
Nozzle G	S	300	15000	123.4	70	20000	130.6
Nozzle Flng A	S	300	15000	205	70	20000	275
Nozzle Flng B	S	300	15000	205	70	20000	275
Nozzle Flng C	T	300	20000	230	70	20000	285
Nozzle Flng D	T	300	20000	230	70	20000	285
Nozzle Flng G	S	300	15000	205	70	20000	275
Nozzle Reinforcement A	S	300	-	190	70	-	202
Nozzle Reinforcement B	S	-	-	N/C	-	-	N/C
Nozzle Reinforcement C	T	300	-	186	70	-	221
Nozzle Reinforcement D	T	300	-	186	70	-	221
Nozzle Reinforcement G	S	300	-	122*	70	-	130*
Front Hd Bolting At TS	T	300	25000	153+	70	25000	153+
Rear Hd Bolting At TS	T	300	25000	153+	70	25000	153+
Dist. Belt An.ring	S	-	-	N/C	-	-	N/C
Nozzle Flng Bolting A	S	300	25000	205	70	25000	275
Nozzle Flng Bolting B	S	300	25000	205	70	25000	275
Nozzle Flng Bolting C	T	300	25000	230	70	25000	285
Nozzle Flng Bolting D	T	300	25000	230	70	25000	285
Nozzle Flng Bolting G	S	300	25000	205	70	25000	275

Minimum Design Metal Temperature for Impact Test Exemption (UCS-66)

* Indicates the controlling components + Indicates compliance with UG-20(f)

Component	Curve	Temp	Ratio	Reduction	Temperature	
		F	UCS-66.1			
Front Head Cylinder	B	-20	0.49	58	-78	
Rear Head Cylinder	B	-20	0.49	58	-78	
Front Head Cover	B	-20	0.43	81	-101	
Rear Head Cover	B	-20	0.43	81	-101	
Front Head Flng At TS	D	-55	0.49	58	-113	
Rear Head Flng At TS	D	-55	0.49	58	-113	
Front Head Partitions	B	-7 +	-	-	-	*
Rear Head Partitions	B	-7 +	-	-	-	*
Nozzle C	B	-20	0.21	140	-160	
Nozzle D	B	-20	0.21	140	-160	
Nozzle Flng C	-	-20	-	-	-	
Nozzle Flng D	-	-20	-	-	-	
Front Hd Bolting At TS	A	-55	-	-	-	
Rear Hd Bolting At TS	A	-55	-	-	-	
Nozzle Flng Bolting A	A	-55	-	-	-	
Nozzle Flng Bolting B	A	-55	-	-	-	
Nozzle Flng Bolting C	A	-55	-	-	-	
Nozzle Flng Bolting D	A	-55	-	-	-	
Nozzle Flng Bolting G	A	-55	-	-	-	

Heat Exchanger Mechanical Design

Teams 20.0

File name: E-4401-7793.BJT

Date: 8/24/2007 Time: 9:11:34 AM

Hydrostatic Test Pressure - ASME VIII-1 2004 A06 UG-99(b) Factor: 1.3
 Shell Side: 97.5 psi Tube Side: 195 psi

Component	Material	Side	Temp F	Design	Test	Stress	Ratio
				Stress psi	Stress psi	psi	
Shell Cylinder	SA-240 S30400 Grd 304 Plat S		300	18900	20000	1.0582	
Front Head Cylinder	SA-516 K02700 Grd 70 Plate T		300	20000	20000	1	
Rear Head Cylinder	SA-516 K02700 Grd 70 Plate T		300	20000	20000	1	
Front Head Cover	SA-516 K02700 Grd 70 Plate T		300	20000	20000	1	
Rear Head Cover	SA-516 K02700 Grd 70 Plate T		300	20000	20000	1	
Front Tubesheet	SA-240 S30400 Grd 304 Plat S		300	15000	20000	1.3333	
Rear Tubesheet	SA-240 S30400 Grd 304 Plat S		300	15000	20000	1.3333	
Front Head Flng At TS	SA-516 K02700 Grd 70 Plate T		300	20000	20000	1	
Rear Head Flng At TS	SA-516 K02700 Grd 70 Plate T		300	20000	20000	1	
Tubes	SA-249 S30400 Grd TP304 Wl T		300	12700	17000	1.3386	
Nozzle A	SA-312 S30400 Grd TP304 Wl S		300	15000	20000	1.3333	
Nozzle B	SA-312 S30400 Grd TP304 Wl S		300	15000	20000	1.3333	
Nozzle C	SA-53 K03005 Grd E/B Wld. T		300	14600	14600	1	
Nozzle D	SA-53 K03005 Grd E/B Wld. T		300	14600	14600	1	
Nozzle G	SA-312 S30400 Grd TP304 Wl S		300	15000	20000	1.3333	
Nozzle Flng A	SA-182 S30400 Grd F304 For S		300	15000	20000	1.3333	
Nozzle Flng B	SA-182 S30400 Grd F304 For S		300	15000	20000	1.3333	
Nozzle Flng C	SA-105 K03504 Forgings T		300	20000	20000	1	
Nozzle Flng D	SA-105 K03504 Forgings T		300	20000	20000	1	
Nozzle Flng G	SA-182 S30400 Grd F304 For S		300	15000	20000	1.3333	
Front Hd Bolting At TS	SA-193 G41400 Grd B7 Bolt(T		300	25000	25000	1	
Rear Hd Bolting At TS	SA-193 G41400 Grd B7 Bolt(T		300	25000	25000	1	
Distributor Belt A	SA-240 S30400 Grd 304 Plat S		300	18900	20000	1.0582	
Nozzle Flng Bolting A	SA-193 G41400 Grd B7 Bolt(S		300	25000	25000	1	
Nozzle Flng Bolting B	SA-193 G41400 Grd B7 Bolt(S		300	25000	25000	1	
Nozzle Flng Bolting C	SA-193 G41400 Grd B7 Bolt(T		300	25000	25000	1	
Nozzle Flng Bolting D	SA-193 G41400 Grd B7 Bolt(T		300	25000	25000	1	
Nozzle Flng Bolting G	SA-193 G41400 Grd B7 Bolt(S		300	25000	25000	1	

HT/DcR Engineering, Inc.
2830 Parkway Street Lakeland, FL 33811

Date Printed: 9/14/2007

CUSTOMER

Delta-T
133 Waller Mill Road
Williamsburg, VA 23185

VESSEL LOCATION

BUNGE-ERGON

VICKSBURG, MISSISSIPPI

VESSEL DESCRIPTION

PRODUCT CONDENSER

Vessel designed per the ASME Boiler & Pressure Vessel Code,
Section VIII, Division 1, 2004 Edition, 2006 Addenda
with Advanced Pressure Vessel, Version: 9.2.4
Vessel is ASME Code Stamped

Job No: 1494F

Vessel Number: 7793-E4401 Legs

NAMEPLATE INFORMATION

Vessel MAWP: 75.00 PSI and Full Vacuum at 300 °F

MDMT: -20 °F at 75.00 PSI

Serial Number(s): 4401-7793

National Board Number(s): _____

Year Built: 2007

Radiography: NONE

Postweld Heat Treated: NONE

HT/DcR Engineering, Inc.
2830 Parkway Street Lakeland, FL 33811

Date Printed: 9/14/2007



HT/DcR Engineering, Inc.

Leg 1

Customer: Delta-T
Job No: 1494F
Mark Number: LEG1

Vessel Number: 7793-E4401 Legs

Date Printed: 9/14/2007

Leg Information

Design Temperature: 300 °F
Material: SA-36
Condition:
B.P. to Vessel Attachment Length (L): 73.8800 in.
Direction of Applied Force: 0 °
Length of Supports: 83.8800 in.
Quantity: 4
Type: Angle
Description:
d₁: 6.0000 in.
d₂: 6.0000 in.
Weld Attachment Length Top (W_t): 0.0000 in.
Weld Leg Dimension (W_l): 0.3750 in.

Factor B Chart: CS-2
Material Stress (Hot): 21600 PSI
Material Stress (Cold): 21600 PSI
Modulus of Elasticity: 28.3 10⁶ PSI
Yield Strength: 36000 PSI
Dist. From Reference Line: 24.0000 in.
Method of Attachment: Leg In
Molded to Head Curvature: No

t₁: 0.5000 in.
t₂: 0.5000 in.
Side (W_s): 10.0000 in.

Repad Information

Design Temperature: 300 °F
Material: SA-240 304, High
Condition:
Height (L_{rh}): 10.0000 in.
Width (L_{rw}): 10.0000 in.

Material Stress (Hot): 18900 PSI
Material Stress (Cold): 20000 PSI
Thickness: 0.5000 in.
Weld Leg (W_r): 0.3750 in.

Base Plate Information

Design Temperature: 300 °F
Material: SA-36 Plate
Condition:
Length: 8.0000 in.
Width: 8.0000 in.
Leg to B.P. Attachment Factor: 0.7500
Effective Length Factor (K): 1.5000

Material Stress (Hot): 16600 PSI
Material Stress (Cold): 16600 PSI
Yield Strength: 36000 PSI
Thickness: 0.5000 in.
Bending Coefficient (C_m): 1.0000

Anchor Bolt Information

Material: F-1554 Gr. 105
Condition:
Diameter: 0.7500 in.
Quantity: 1
Ultimate 28 Day Concrete Strength: 3000 PSI

Material Stress (Hot): 39000 PSI
Material Stress (Cold): 39000 PSI
Root Area: 1.2940 sq. in.
Bolt Circle Diameter: 41.0000 in.

Operating Pressurized Conditions - Occasional Loads - Seismic Case 5

Support Leg Properties

$$\text{Section Modulus, } S_x = \frac{I_x}{C_x} = \frac{31.7448}{4.2426} = 7.4824 \text{ in.}^3$$

$$\text{Section Modulus, } S_y = \frac{I_y}{C_y} = \frac{8.0709}{2.3826} = 3.3874 \text{ in.}^3$$

$$\text{Radius of gyration, } r_x = \sqrt{\frac{I_x}{A}} = \sqrt{\frac{31.7448}{5.7500}} = 2.3496 \text{ in.}$$

$$\text{Radius of gyration, } r_y = \sqrt{\frac{I_y}{A}} = \sqrt{\frac{8.0709}{5.7500}} = 1.1848 \text{ in.}$$

$$\text{Least radius of gyration, } r_{\min} = \sqrt{\frac{I_{\min}}{A}} = \sqrt{\frac{8.0709}{5.7500}} = 1.1848 \text{ in.}$$

$$\text{Slenderness ratio, } SR_x = \frac{K L}{r_x} = \frac{1.5000 * 73.8800}{2.3496} = 47.1655$$

$$\text{Slenderness ratio, } SR_y = \frac{K L}{r_y} = \frac{1.5000 * 73.8800}{1.1848} = 93.5348$$

$$SR_{\max} = \frac{K L}{r_{\min}} = \frac{1.5000 * 73.8800}{1.1848} = 93.5348$$

$$\text{Critical slenderness ratio, } C_c = \sqrt{\frac{2 \pi^2 E}{F_y}} = \sqrt{\frac{2 * \pi^2 * (28.3 * 10^6)}{36000}} = 124.57$$

$$F'_{ex} = \frac{4}{3} \frac{12 \pi^2 E}{23 SR_x^2} = \frac{4}{3} * \frac{12 * \pi^2 * (28.3 * 10^6)}{23 * 47.1655^2} = 87343 \text{ PSI}$$

$$F'_{ey} = \frac{4}{3} \frac{12 \pi^2 E}{23 SR_y^2} = \frac{4}{3} * \frac{12 * \pi^2 * (28.3 * 10^6)}{23 * 93.5348^2} = 22209 \text{ PSI}$$

For $SR_{\max} \leq C_c$, Allowable compressive stress:

$$F_a = \frac{4}{3} \frac{\left(1 - \frac{SR_{\max}^2}{2 C_c^2}\right) F_y}{\frac{5}{3} + \frac{3 SR_{\max}}{8 C_c} - \frac{SR_{\max}^3}{8 C_c^3}} = \frac{4}{3} * \frac{\left(1 - \frac{93.5348^2}{2 * 124.57^2}\right) * 36000}{\frac{5}{3} + \frac{3 * 93.5348}{8 * 124.57} - \frac{93.5348^3}{8 * 124.57^3}} = 18187 \text{ PSI}$$

$$\text{Allowable bending stress : } S_b = \frac{4}{3} * 0.6 F_y = \frac{4}{3} * 0.6 * 36000 = 28800 \text{ PSI}$$

$$\text{Allowable tension stress : } S_t = \frac{4}{3} * 0.6 F_y = \frac{4}{3} * 0.6 * 36000 = 28800 \text{ PSI}$$

HT/DcR Engineering, Inc.

Leg 1

Vessel Number: 7793-E4401 Legs

Job No: 1494F
Mark Number: LEG1

Date Printed: 9/14/2007

Leg to Vessel Weld Properties

Distance between welds along side of legs (b) = = 7.7782 in.
 $L_w = 2 W_s = 2 * 10.0000$ = 20.0000 in.

$I_{wy} = \frac{W_s^3}{6} = \frac{10.0000^3}{6}$ = 166.6667 in.³

$I_{wz} = \frac{W_s b^2}{2} = \frac{10.0000 * 7.7782^2}{2}$ = 302.5000 in.³

$J_{wx} = I_{wy} + I_{wz} = 166.6667 + 302.5000$ = 469.1667 in.³

Distance from weld neutral axis to top/bottom of welds:

$EF_{yt} = EF_{yb} = \frac{W_s}{2} = \frac{10.0000}{2}$ = 5.0000 in.

Distance from weld neutral axis to bottom of welds:

$EF_z = \frac{b}{2} = \frac{7.7782}{2}$ = 3.8891 in.

NO Wind Analysis Information

Wind Analysis Calculations

No Wind Load Calculations were performed

IBC 2003 Seismic Design Information

Spectral Resp. Accel. at short periods (S_s):	0.200	Response Modification Factor (R):	3.000
Spectral Resp. Accel. at a period of 1 s (S_1):	0.100	Site Class:	D
Seismic Use Group:	I		
Seismic Design Category:	C		

Seismic Analysis Calculations

Seismic Center of Gravity: = 174.4404 in.

$C_s = \frac{SD_s I}{R} = \frac{0.2133 * 1.00}{3.000}$ = 0.0711

$V = W * C_s = 22668.57 * 0.03$ = 1611.99 lb.

$F_s = V C_{eh} = 1611.99 * 0.70$ = 1128 lb.

HT/DcR Engineering, Inc.

Leg 1

Vessel Number: 7793-E4401 Legs

Job No: 1494F
Mark Number: LEG1

Date Printed: 9/14/2007

Loadings and Stresses on Support Legs

Direction of Applied Force = 0°

Leg Orientation °	Moment of Inertia in. ⁴	Lateral Force lb.	Axial Stress PSI	Bending Stresses (f _{bx}) PSI	Bending Stresses (f _{by}) PSI	Acceptance Ratio (Eqn ₁)	Acceptance Ratio (Eqn ₂)
0	8.0709	114	-280	0	1720	0.0751	
90	31.7448	450	-1015	3331	3973	0.3094	
180	8.0709	114	-1750	0	8720	0.3990	
270	31.7448	450	-1015	3331	3973	0.3094	

Direction of Worst case Force = 40°
Highest Stress Ratio = 0.4606

Loadings and Stresses on Leg to Vessel attachment welds

Leg Orientation °	Load F _x lb.	Load F _y lb.	Load F _z lb.	Moment M _x in.-lb.	Moment M _y in.-lb.	Moment M _z in.-lb.	Total Stress PSI	Stress Ratio
0	114	0	-1611	0	-9246	0	785	0.0636
90	0	450	-5836	24925	-10539	813	1765	0.1429
180	-114	0	-10062	0	-11833	0	1633	0.1322
270	0	450	-5836	24925	-10539	813	1765	0.1429

Direction of Worst case Force = 1°
Highest Stress Ratio: 0.1878

Repad to Shell Weld Properties

$$L_w = 2 (L_{rh} + L_{rw}) = 2 * (10.0000 + 10.0000) = 40.0000 \text{ in.}$$

$$I_{wy} = \frac{L_{rw} L_{rh}^2}{2} + \frac{L_{rh}^3}{6} = \frac{10.0000 * 10.0000^2}{2} + \frac{10.0000^3}{6} = 666.6667 \text{ in.}^3$$

$$I_{wz} = \frac{L_{rh} L_{rw}^2}{2} + \frac{L_{rw}^3}{6} = \frac{10.0000 * 10.0000^2}{2} + \frac{10.0000^3}{6} = 666.6667 \text{ in.}^3$$

$$J_{wx} = I_{wy} + I_{wz} = 666.6667 + 666.6667 = 1333.3333 \text{ in.}^3$$

Distance from weld neutral axis to top of repad:

$$EF_y = \frac{L_{rh}}{2} = \frac{10.0000}{2} = 5.0000 \text{ in.}$$

Distance from weld neutral axis to side of repad:

$$EF_z = \frac{L_{rw}}{2} = \frac{10.0000}{2} = 5.0000 \text{ in.}$$

HT/DcR Engineering, Inc.

Leg 1

Vessel Number: 7793-E4401 Legs

Job No: 1494F
Mark Number: LEG1

Date Printed: 9/14/2007

Loadings and Stresses on Repad-to-Shell Attachment Welds

Leg Orientation °	Load F _x lb.	Load F _y lb.	Load F _z lb.	Moment M _x in.-lb.	Moment M _y in.-lb.	Moment M _z in.-lb.	Total Stress PSI	Stress Ratio
0	114	0	-1611	0	-10052	0	235	0.0190
90	0	450	-5836	24925	-13457	1038	755	0.0611
180	-114	0	-10062	0	-16864	0	747	0.0605
270	0	450	-5836	24925	-13457	1038	755	0.0611

Direction of Worst case Force = 1 °
Highest Stress Ratio = 0.0806

Loadings and Pressure on Concrete Foundation

Direction of applied force: = 0 °

Leg Orientation °	Bearing Pressure PSI	Moment M _x in.-lb.	Moment M _y in.-lb.	Maximum Pressure P _x PSI	Maximum Pressure P _y PSI	Max. Concrete Pressure PSI	Concrete Pressure Ratio
0	25	5614	5614	65.79	65.79	156.75	0.1306
90	91	21266	21266	249.21	249.21	589.61	0.4913
180	157	13419	13419	157.25	157.25	471.73	0.3931
270	91	21266	21266	249.21	249.21	589.61	0.4913

Direction of Worst case Force: = 1 °
Highest Stress Ratio = 0.6320

Loadings and Stresses on BasePlate and Anchor bolts

Leg Orientation °	Moment M _x in.-lb.	Moment M _y in.-lb.	Maximum Pressure P _x PSI	Maximum Pressure P _y PSI	Maximum B.P. Stress PSI	BasePlate Stress Ratio	Anchor Bolt Stress PSI	Anchor Bolt Stress Ratio
0	174	163	4183	3912	5727	0.1989	1064	0.0205
90	652	609	15640	14613	21405	0.7432	4114	0.0791
180	615	588	14750	14102	20407	0.7086	973	0.0187
270	652	609	15640	14613	21405	0.7432	4114	0.0791

Direction of Worst case Force: = 1 °
Highest Stress Ratio = 0.9888

Maximum General Longitudinal Stresses

$VE = (C_{de} + 0.2 * SDS * I * C_{ev}) = (1.00 + 0.2 * 0.21 * 1.00 * 0.70) =$ 1.03

$S_{L1} = \frac{M_a}{Z} - \frac{W VE}{A} + \left(\frac{P * D}{4 * t} \right) = \frac{113471}{256.2605} - \frac{22668.57 * 1.03}{28.47} + \left(\frac{76.96 * 36.5000}{4 * 0.2500} \right) =$ 2432 PSI

$S_{L2} = -\frac{M_a}{Z} - \frac{W VE}{A} - \left(\frac{Pe * D}{4 * t} \right) = -\frac{113471}{256.2605} - \frac{22668.57 * 1.03}{28.47} - \left(\frac{14.70 * 36.5000}{4 * 0.2500} \right) =$ -1799 PSI

Allowable Tension Stress, $S_{ta} = 1.2 S E = 1.2 * 18900 * 0.70 =$ 15876 PSI

Allowable Compressive Stress, $S_{ca} = -1.2 B = -1.2 * 8963 =$ -10756 PSI

$R_{SL1} = \frac{S_{L1}}{S_{ta}} = \frac{2432}{15876} =$ 0.1532

$R_{SL2} = \frac{S_{L2}}{S_{ca}} = \frac{-1799}{-10756} =$ 0.1673

Summary

Governing external force	= Seismic load
Total Force	= 1128 lb.
Weight	= 22668.57 lb.
Base Moment	= 196837 in.-lb.
Tangent Moment	= 113471 in.-lb.

Leg Stresses

Maximum combined compressive and bending stress ratio	= 0.4606
--	----------

Leg BasePlate

Concrete Stress Ratio	= 0.6320
Base Plate Stress Ratio	= 0.9888

Host Stresses

SI1 ratio	= 0.1532
SI2 ratio	= 0.1673

Weld Stresses

Leg to vessel weld stress ratio	= 0.1878
Repad to shell weld stress ratio	= 0.0806

Operating Pressurized Conditions - Occasional Loads - Seismic Case 8

Support Leg Properties

$$\text{Section Modulus, } S_x = \frac{I_x}{C_x} = \frac{31.7448}{4.2426} = 7.4824 \text{ in.}^3$$

$$\text{Section Modulus, } S_y = \frac{I_y}{C_y} = \frac{8.0709}{2.3826} = 3.3874 \text{ in.}^3$$

$$\text{Radius of gyration, } r_x = \sqrt{\frac{I_x}{A}} = \sqrt{\frac{31.7448}{5.7500}} = 2.3496 \text{ in.}$$

$$\text{Radius of gyration, } r_y = \sqrt{\frac{I_y}{A}} = \sqrt{\frac{8.0709}{5.7500}} = 1.1848 \text{ in.}$$

$$\text{Least radius of gyration, } r_{\min} = \sqrt{\frac{I_{\min}}{A}} = \sqrt{\frac{8.0709}{5.7500}} = 1.1848 \text{ in.}$$

$$\text{Slenderness ratio, } SR_x = \frac{KL}{r_x} = \frac{1.5000 * 73.8800}{2.3496} = 47.1655$$

$$\text{Slenderness ratio, } SR_y = \frac{KL}{r_y} = \frac{1.5000 * 73.8800}{1.1848} = 93.5348$$

$$SR_{\max} = \frac{KL}{r_{\min}} = \frac{1.5000 * 73.8800}{1.1848} = 93.5348$$

$$\text{Critical slenderness ratio, } C_c = \sqrt{\frac{2 \pi^2 E}{F_y}} = \sqrt{\frac{2 * \pi^2 * (28.3 * 10^6)}{36000}} = 124.57$$

$$F'_{ex} = \frac{4}{3} \frac{12 \pi^2 E}{23 SR_x^2} = \frac{4}{3} * \frac{12 * \pi^2 * (28.3 * 10^6)}{23 * 47.1655^2} = 87343 \text{ PSI}$$

$$F'_{ey} = \frac{4}{3} \frac{12 \pi^2 E}{23 SR_y^2} = \frac{4}{3} * \frac{12 * \pi^2 * (28.3 * 10^6)}{23 * 93.5348^2} = 22209 \text{ PSI}$$

For $SR_{\max} \leq C_c$, Allowable compressive stress:

$$F_a = \frac{4}{3} \frac{\left(1 - \frac{SR_{\max}^2}{2 C_c^2}\right) F_y}{\frac{5}{3} + \frac{3 SR_{\max}}{8 C_c} - \frac{SR_{\max}^3}{8 C_c^3}} = \frac{4}{3} * \frac{\left(1 - \frac{93.5348^2}{2 * 124.57^2}\right) * 36000}{\frac{5}{3} + \frac{3 * 93.5348}{8 * 124.57} - \frac{93.5348^3}{8 * 124.57^3}} = 18187 \text{ PSI}$$

$$\text{Allowable bending stress : } S_b = \frac{4}{3} * 0.6 F_y = \frac{4}{3} * 0.6 * 36000 = 28800 \text{ PSI}$$

$$\text{Allowable tension stress : } S_t = \frac{4}{3} * 0.6 F_y = \frac{4}{3} * 0.6 * 36000 = 28800 \text{ PSI}$$

HT/DcR Engineering, Inc.

Leg 1

Vessel Number: 7793-E4401 Legs

Job No: 1494F
Mark Number: LEG1

Date Printed: 9/14/2007

Leg to Vessel Weld Properties

Distance between welds along side of legs (b) = = 7.7782 in.
 $L_w = 2 W_s = 2 * 10.0000$ = 20.0000 in.

$I_{wy} = \frac{W_s^3}{6} = \frac{10.0000^3}{6}$ = 166.6667 in.³

$I_{wz} = \frac{W_s b^2}{2} = \frac{10.0000 * 7.7782^2}{2}$ = 302.5000 in.³

$J_{wx} = I_{wy} + I_{wz} = 166.6667 + 302.5000$ = 469.1667 in.³

Distance from weld neutral axis to top/bottom of welds:

$EF_{yt} = EF_{yb} = \frac{W_s}{2} = \frac{10.0000}{2}$ = 5.0000 in.

Distance from weld neutral axis to bottom of welds:

$EF_z = \frac{b}{2} = \frac{7.7782}{2}$ = 3.8891 in.

NO Wind Analysis Information

Wind Analysis Calculations

No Wind Load Calculations were performed

IBC 2003 Seismic Design Information

Spectral Resp. Accel. at short periods (S _s):	0.200	Response Modification Factor (R):	3.000
Spectral Resp. Accel. at a period of 1 s (S ₁):	0.100	Site Class:	D
Seismic Use Group:	I		
Seismic Design Category:	C		

Seismic Analysis Calculations

Seismic Center of Gravity: = 174.4404 in.

$C_s = \frac{SD_s I}{R} = \frac{0.2133 * 1.00}{3.000}$ = 0.0711

$V = W * C_s = 22668.57 * 0.03$ = 1611.99 lb.

$F_s = V C_{eh} = 1611.99 * 0.70$ = 1128 lb.

HT/DcR Engineering, Inc.

Leg 1

Vessel Number: 7793-E4401 Legs

Job No: 1494F
Mark Number: LEG1

Date Printed: 9/14/2007

Loadings and Stresses on Support Legs

Direction of Applied Force = 0°

Leg Orientation °	Moment of Inertia in. ⁴	Lateral Force lb.	Axial Stress PSI	Bending Stresses (f _{bx}) PSI	Bending Stresses (f _{by}) PSI	Acceptance Ratio (Eqn1)	Acceptance Ratio (Eqn2)
0	8.0709	114	173	0	2548	0.0965	
90	31.7448	450	-562	3331	2199	0.2229	
180	8.0709	114	-1297	0	6947	0.3125	
270	31.7448	450	-562	3331	2199	0.2229	

Direction of Worst case Force = 40°
Highest Stress Ratio = 0.3741

Loadings and Stresses on Leg to Vessel attachment welds

Leg Orientation °	Load F _x lb.	Load F _y lb.	Load F _z lb.	Moment M _x in.-lb.	Moment M _y in.-lb.	Moment M _z in.-lb.	Total Stress PSI	Stress Ratio
0	114	0	995	0	-4540	0	401	0.0325
90	0	450	-3231	24925	-5835	813	1341	0.1086
180	-114	0	-7457	0	-7129	0	1139	0.0922
270	0	450	-3231	24925	-5835	813	1341	0.1086

Direction of Worst case Force = 1°
Highest Stress Ratio: 0.1501

Repad to Shell Weld Properties

$$L_w = 2 (L_{rh} + L_{rw}) = 2 * (10.0000 + 10.0000) = 40.0000 \text{ in.}$$

$$I_{wy} = \frac{L_{rw} L_{rh}^2}{2} + \frac{L_{rh}^3}{6} = \frac{10.0000 * 10.0000^2}{2} + \frac{10.0000^3}{6} = 666.6667 \text{ in.}^3$$

$$I_{wz} = \frac{L_{rh} L_{rw}^2}{2} + \frac{L_{rw}^3}{6} = \frac{10.0000 * 10.0000^2}{2} + \frac{10.0000^3}{6} = 666.6667 \text{ in.}^3$$

$$J_{wx} = I_{wy} + I_{wz} = 666.6667 + 666.6667 = 1333.3333 \text{ in.}^3$$

Distance from weld neutral axis to top of repad:

$$EF_y = \frac{L_{rh}}{2} = \frac{10.0000}{2} = 5.0000 \text{ in.}$$

Distance from weld neutral axis to side of repad:

$$EF_z = \frac{L_{rw}}{2} = \frac{10.0000}{2} = 5.0000 \text{ in.}$$

HT/DcR Engineering, Inc.

Leg 1

Vessel Number: 7793-E4401 Legs

Job No: 1494F
Mark Number: LEG1

Date Printed: 9/14/2007

Loadings and Stresses on Repad-to-Shell Attachment Welds

Leg Orientation °	Load F _x lb.	Load F _y lb.	Load F _z lb.	Moment M _x in.-lb.	Moment M _y in.-lb.	Moment M _z in.-lb.	Total Stress PSI	Stress Ratio
0	114	0	995	0	-4043	0	111	0.0090
90	0	450	-3231	24925	-7450	1038	568	0.0460
180	-114	0	-7457	0	-10858	0	539	0.0437
270	0	450	-3231	24925	-7450	1038	568	0.0460

Direction of Worst case Force = 1°
Highest Stress Ratio = 0.0645

Loadings and Pressure on Concrete Foundation

Direction of applied force: = 0°

Leg Orientation °	Bearing Pressure PSI	Moment M _x in.-lb.	Moment M _y in.-lb.	Maximum Pressure P _x PSI	Maximum Pressure P _y PSI	Max. Concrete Pressure PSI	Concrete Pressure Ratio
0	-16	1365	1365	16.00	16.00	16.45	0.0137
90	50	17018	17018	199.43	199.43	449.34	0.3745
180	117	9171	9171	107.47	107.47	331.46	0.2762
270	50	17018	17018	199.43	199.43	449.34	0.3745

Direction of Worst case Force: = 1°
Highest Stress Ratio = 0.5151

Loadings and Stresses on BasePlate and Anchor bolts

Leg Orientation °	Moment M _x in.-lb.	Moment M _y in.-lb.	Maximum Pressure P _x PSI	Maximum Pressure P _y PSI	Maximum B.P. Stress PSI	BasePlate Stress Ratio	Anchor Bolt Stress PSI	Anchor Bolt Stress Ratio
0	0	0	0	0	0	0.0000	873	0.0168
90	476	441	11415	10593	15573	0.5407	3762	0.0723
180	439	420	10525	10082	14574	0.5060	557	0.0107
270	476	441	11415	10593	15573	0.5407	3762	0.0723

Direction of Worst case Force: = 1°
Highest Stress Ratio = 0.7863

Maximum General Longitudinal Stresses

$$VE = (C_{de} + 0.2 * SDS * I * C_{ev}) = (0.60 + 0.2 * 0.21 * 1.00 * -0.70) = 0.57$$

$$S_{L1} = \frac{M_a}{Z} - \frac{W VE}{A} + \left(\frac{P * D}{4 * t} \right) = \frac{113471}{256.2605} - \frac{22668.57 * 0.57}{28.47} + \left(\frac{76.08 * 36.5000}{4 * 0.2500} \right) = 2766 \text{ PSI}$$

$$S_{L2} = -\frac{M_a}{Z} - \frac{W VE}{A} - \left(\frac{Pe * D}{4 * t} \right) = -\frac{113471}{256.2605} - \frac{22668.57 * 0.57}{28.47} - \left(\frac{14.70 * 36.5000}{4 * 0.2500} \right) = -1433 \text{ PSI}$$

Allowable Tension Stress, S_{ta} = 1.2 S E = 1.2 * 18900 * 0.70 = 15876 PSI

Allowable Compressive Stress, S_{ca} = -1.2 B = -1.2 * 8963 = -10756 PSI

$$R_{SL1} = \frac{S_{L1}}{S_{ta}} = \frac{2766}{15876} = 0.1742$$

$$R_{SL2} = \frac{S_{L2}}{S_{ca}} = \frac{-1433}{-10756} = 0.1332$$

Summary

Governing external force	= Seismic load
Total Force	= 1128 lb.
Weight	= 22668.57 lb.
Base Moment	= 196837 in.-lb.
Tangent Moment	= 113471 in.-lb.

Leg Stresses

Maximum combined compressive and bending stress ratio	= 0.3741
--	-----------------

Leg BasePlate

Concrete Stress Ratio	= 0.5151
Base Plate Stress Ratio	= 0.7863

Host Stresses

SI1 ratio	= 0.1742
SI2 ratio	= 0.1332

Weld Stresses

Leg to vessel weld stress ratio	= 0.1501
Repad to shell weld stress ratio	= 0.0645

Job No: 1494F
Mark Number: LEG1

Date Printed: 9/14/2007

Operating Pressurized Conditions - Occasional Loads - Wind Case 5

Support Leg Properties

$$\text{Section Modulus, } S_x = \frac{I_x}{C_x} = \frac{31.7448}{4.2426} = 7.4824 \text{ in.}^3$$

$$\text{Section Modulus, } S_y = \frac{I_y}{C_y} = \frac{8.0709}{2.3826} = 3.3874 \text{ in.}^3$$

$$\text{Radius of gyration, } r_x = \sqrt{\frac{I_x}{A}} = \sqrt{\frac{31.7448}{5.7500}} = 2.3496 \text{ in.}$$

$$\text{Radius of gyration, } r_y = \sqrt{\frac{I_y}{A}} = \sqrt{\frac{8.0709}{5.7500}} = 1.1848 \text{ in.}$$

$$\text{Least radius of gyration, } r_{\min} = \sqrt{\frac{I_{\min}}{A}} = \sqrt{\frac{8.0709}{5.7500}} = 1.1848 \text{ in.}$$

$$\text{Slenderness ratio, } SR_x = \frac{KL}{r_x} = \frac{1.5000 * 73.8800}{2.3496} = 47.1655$$

$$\text{Slenderness ratio, } SR_y = \frac{KL}{r_y} = \frac{1.5000 * 73.8800}{1.1848} = 93.5348$$

$$SR_{\max} = \frac{KL}{r_{\min}} = \frac{1.5000 * 73.8800}{1.1848} = 93.5348$$

$$\text{Critical slenderness ratio, } C_c = \sqrt{\frac{2 \pi^2 E}{F_y}} = \sqrt{\frac{2 * \pi^2 * (28.3 * 10^6)}{36000}} = 124.57$$

$$F'_{ex} = \frac{4}{3} \frac{12 \pi^2 E}{23 SR_x^2} = \frac{4}{3} * \frac{12 * \pi^2 * (28.3 * 10^6)}{23 * 47.1655^2} = 87343 \text{ PSI}$$

$$F'_{ey} = \frac{4}{3} \frac{12 \pi^2 E}{23 SR_y^2} = \frac{4}{3} * \frac{12 * \pi^2 * (28.3 * 10^6)}{23 * 93.5348^2} = 22209 \text{ PSI}$$

For $SR_{\max} \leq C_c$, Allowable compressive stress:

$$F_a = \frac{4}{3} \frac{\left(1 - \frac{SR_{\max}^2}{2 C_c^2}\right) F_y}{\frac{5}{3} + \frac{3 SR_{\max}}{8 C_c} - \frac{SR_{\max}^3}{8 C_c^3}} = \frac{4}{3} * \frac{\left(1 - \frac{93.5348^2}{2 * 124.57^2}\right) * 36000}{\frac{5}{3} + \frac{3 * 93.5348}{8 * 124.57} - \frac{93.5348^3}{8 * 124.57^3}} = 18187 \text{ PSI}$$

$$\text{Allowable bending stress : } S_b = \frac{4}{3} * 0.6 F_y = \frac{4}{3} * 0.6 * 36000 = 28800 \text{ PSI}$$

$$\text{Allowable tension stress : } S_t = \frac{4}{3} * 0.6 F_y = \frac{4}{3} * 0.6 * 36000 = 28800 \text{ PSI}$$

Leg to Vessel Weld Properties

Distance between welds along side of legs (b) = = 7.7782 in.
 $L_w = 2 W_s = 2 * 10.0000$ = 20.0000 in.

$I_{wy} = \frac{W_s^3}{6} = \frac{10.0000^3}{6}$ = 166.6667 in.³

$I_{wz} = \frac{W_s b^2}{2} = \frac{10.0000 * 7.7782^2}{2}$ = 302.5000 in.³

$J_{wx} = I_{wy} + I_{wz} = 166.6667 + 302.5000$ = 469.1667 in.³

Distance from weld neutral axis to top/bottom of welds:

$EF_{yt} = EF_{yb} = \frac{W_s}{2} = \frac{10.0000}{2}$ = 5.0000 in.

Distance from weld neutral axis to bottom of welds:

$EF_z = \frac{b}{2} = \frac{7.7782}{2}$ = 3.8891 in.

IBC 2003 Wind Analysis Information

Basic Wind Speed (V):	90	MPH	Wind Exposure type:	C
Importance factor (I):	1.0000		Force (shape) coefficient (C _f):	0.70
Topographic Factor (K _{zt}):	1.00		Directionality Factor (K _d):	1.00

Wind Analysis Calculations

Wind Center of Gravity = 178.6462 in.
 $q_z = 0.00256 K_z K_{zt} K_d V^2 I = 0.00256 * 0.85 * 1.000 * 1.00 * 90^2 * 1.0000$ = 17.626
 $P = q_z G C_f = 17.626 * 0.90 * 0.70$ = 11.10 lb./ft²
Wind Load, F_w = P A C_{wi} = 11.10 * 74.7016 * 1.00 = 829 lb.

NO Seismic Design Information

Seismic Analysis Calculations

No Seismic Analysis Calculations were performed.

HT/DcR Engineering, Inc.

Leg 1

Vessel Number: 7793-E4401 Legs

Job No: 1494F
Mark Number: LEG1

Date Printed: 9/14/2007

Loadings and Stresses on Support Legs

Direction of Applied Force =

0°

Leg Orientation °	Moment of Inertia in. ⁴	Lateral Force lb.	Axial Stress PSI	Bending Stresses (f _{bx}) PSI	Bending Stresses (f _{by}) PSI	Acceptance Ratio (Eqn ₁)	Acceptance Ratio (Eqn ₂)
0	8.0709	84	-431	0	2145	0.0982	
90	31.7448	331	-986	2448	3858	0.2732	
180	8.0709	84	-1540	0	7403	0.3417	
270	31.7448	331	-986	2448	3858	0.2732	

Direction of Worst case Force =
Highest Stress Ratio =

40°
0.3860

Loadings and Stresses on Leg to Vessel attachment welds

Leg Orientation °	Load F _x lb.	Load F _y lb.	Load F _z lb.	Moment M _x in.-lb.	Moment M _y in.-lb.	Moment M _z in.-lb.	Total Stress PSI	Stress Ratio
0	84	0	-2478	0	-9132	0	812	0.0658
90	0	331	-5667	18316	-10234	598	1539	0.1246
180	-84	0	-8856	0	-11336	0	1482	0.1200
270	0	331	-5667	18316	-10234	598	1539	0.1246

Direction of Worst case Force =
Highest Stress Ratio:

1°
0.1595

Repad to Shell Weld Properties

$$L_w = 2 (L_{rh} + L_{rw}) = 2 * (10.0000 + 10.0000) = 40.0000 \text{ in.}$$

$$I_{wy} = \frac{L_{rw} L_{rh}^2}{2} + \frac{L_{rh}^3}{6} = \frac{10.0000 * 10.0000^2}{2} + \frac{10.0000^3}{6} = 666.6667 \text{ in.}^3$$

$$I_{wz} = \frac{L_{rh} L_{rw}^2}{2} + \frac{L_{rw}^3}{6} = \frac{10.0000 * 10.0000^2}{2} + \frac{10.0000^3}{6} = 666.6667 \text{ in.}^3$$

$$J_{wx} = I_{wy} + I_{wz} = 666.6667 + 666.6667 = 1333.3333 \text{ in.}^3$$

Distance from weld neutral axis to top of repad:

$$EF_y = \frac{L_{rh}}{2} = \frac{10.0000}{2} = 5.0000 \text{ in.}$$

Distance from weld neutral axis to side of repad:

$$EF_z = \frac{L_{rw}}{2} = \frac{10.0000}{2} = 5.0000 \text{ in.}$$

HT/DcR Engineering, Inc.

Leg 1

Vessel Number: 7793-E4401 Legs

Job No: 1494F
Mark Number: LEG1

Date Printed: 9/14/2007

Loadings and Stresses on Repad-to-Shell Attachment Welds

Leg Orientation °	Load F _x lb.	Load F _y lb.	Load F _z lb.	Moment M _x in.-lb.	Moment M _y in.-lb.	Moment M _z in.-lb.	Total Stress PSI	Stress Ratio
0	84	0	-2478	0	-10371	0	270	0.0219
90	0	331	-5667	18316	-13067	763	658	0.0533
180	-84	0	-8856	0	-15764	0	667	0.0540
270	0	331	-5667	18316	-13067	763	658	0.0533

Direction of Worst case Force = 1°
Highest Stress Ratio = 0.0683

Loadings and Pressure on Concrete Foundation

Direction of applied force: = 0°

Leg Orientation °	Bearing Pressure PSI	Moment M _x in.-lb.	Moment M _y in.-lb.	Maximum Pressure P _x PSI	Maximum Pressure P _y PSI	Max. Concrete Pressure PSI	Concrete Pressure Ratio
0	39	6235	6235	73.07	73.07	184.85	0.1540
90	89	17874	17874	209.46	209.46	507.47	0.4229
180	138	12244	12244	143.48	143.48	425.34	0.3545
270	89	17874	17874	209.46	209.46	507.47	0.4229

Direction of Worst case Force: = 1°
Highest Stress Ratio = 0.5292

Loadings and Stresses on BasePlate and Anchor bolts

Leg Orientation °	Moment M _x in.-lb.	Moment M _y in.-lb.	Maximum Pressure P _x PSI	Maximum Pressure P _y PSI	Maximum B.P. Stress PSI	BasePlate Stress Ratio	Anchor Bolt Stress PSI	Anchor Bolt Stress Ratio
0	216	203	5172	4871	7105	0.2467	976	0.0188
90	572	536	13729	12865	18815	0.6533	3222	0.0620
180	550	526	13210	12619	18268	0.6343	951	0.0183
270	572	536	13729	12865	18815	0.6533	3222	0.0620

Direction of Worst case Force: = 1°
Highest Stress Ratio = 0.8388

Maximum General Longitudinal Stresses

VE = C_{de} = 1.00 = 1.00

$$S_{L1} = \frac{M_a}{Z} - \frac{W VE}{A} + \left(\frac{P * D}{4 * t} \right) = \frac{86871}{256.2605} - \frac{22668.57 * 1.00}{28.47} + \left(\frac{76.90 * 36.5000}{4 * 0.2500} \right) = 2350 \text{ PSI}$$

$$S_{L2} = -\frac{M_a}{Z} - \frac{W VE}{A} - \left(\frac{P_e * D}{4 * t} \right) = -\frac{86871}{256.2605} - \frac{22668.57 * 1.00}{28.47} - \left(\frac{14.70 * 36.5000}{4 * 0.2500} \right) = -1672 \text{ PSI}$$

Allowable Tension Stress, S_{ta} = 1.2 S E = 1.2 * 18900 * 0.70 = 15876 PSI

Allowable Compressive Stress, S_{ca} = -1.2 B = -1.2 * 8963 = -10756 PSI

$$R_{SL1} = \frac{S_{L1}}{S_{ta}} = \frac{2350}{15876} = 0.1480$$

$$R_{SL2} = \frac{S_{L2}}{S_{ca}} = \frac{-1672}{-10756} = 0.1555$$

Summary

Governing external force	= Wind load
Total Force	= 829 lb.
Weight	= 22668.57 lb.
Base Moment	= 148132 in.-lb.
Tangent Moment	= 86871 in.-lb.

Leg Stresses

Maximum combined compressive and bending stress ratio	= 0.3860
--	----------

Leg BasePlate

Concrete Stress Ratio	= 0.5292
Base Plate Stress Ratio	= 0.8388

Host Stresses

SI1 ratio	= 0.1480
SI2 ratio	= 0.1555

Weld Stresses

Leg to vessel weld stress ratio	= 0.1595
Repad to shell weld stress ratio	= 0.0683

Operating Pressurized Condition - Sustained Loads

Support Leg Properties

$$\text{Section Modulus, } S_x = \frac{I_x}{C_x} = \frac{31.7448}{4.2426} = 7.4824 \text{ in.}^3$$

$$\text{Section Modulus, } S_y = \frac{I_y}{C_y} = \frac{8.0709}{2.3826} = 3.3874 \text{ in.}^3$$

$$\text{Radius of gyration, } r_x = \sqrt{\frac{I_x}{A}} = \sqrt{\frac{31.7448}{5.7500}} = 2.3496 \text{ in.}$$

$$\text{Radius of gyration, } r_y = \sqrt{\frac{I_y}{A}} = \sqrt{\frac{8.0709}{5.7500}} = 1.1848 \text{ in.}$$

$$\text{Least radius of gyration, } r_{\min} = \sqrt{\frac{I_{\min}}{A}} = \sqrt{\frac{8.0709}{5.7500}} = 1.1848 \text{ in.}$$

$$\text{Slenderness ratio, } SR_x = \frac{K L}{r_x} = \frac{1.5000 * 73.8800}{2.3496} = 47.1655$$

$$\text{Slenderness ratio, } SR_y = \frac{K L}{r_y} = \frac{1.5000 * 73.8800}{1.1848} = 93.5348$$

$$SR_{\max} = \frac{K L}{r_{\min}} = \frac{1.5000 * 73.8800}{1.1848} = 93.5348$$

$$\text{Critical slenderness ratio, } C_c = \sqrt{\frac{2 \pi^2 E}{F_y}} = \sqrt{\frac{2 * \pi^2 * (28.3 * 10^6)}{36000}} = 124.57$$

$$F'_{ex} = \frac{12 \pi^2 E}{23 SR_x^2} = \frac{12 * \pi^2 * (28.3 * 10^6)}{23 * 47.1655^2} = 65507 \text{ PSI}$$

$$F'_{ey} = \frac{12 \pi^2 E}{23 SR_y^2} = \frac{12 * \pi^2 * (28.3 * 10^6)}{23 * 93.5348^2} = 16657 \text{ PSI}$$

For $SR_{\max} \leq C_c$, Allowable compressive stress:

$$F_a = \frac{\left(1 - \frac{SR_{\max}^2}{2 C_c^2}\right) F_y}{\frac{5}{3} + \frac{3 SR_{\max}}{8 C_c} - \frac{SR_{\max}^3}{8 C_c^3}} = \frac{\left(1 - \frac{93.5348^2}{2 * 124.57^2}\right) * 36000}{\frac{5}{3} + \frac{3 * 93.5348}{8 * 124.57} - \frac{93.5348^3}{8 * 124.57^3}} = 13640 \text{ PSI}$$

Allowable bending stress : $S_b = 0.6 F_y = 0.6 * 36000 = 21600 \text{ PSI}$

Allowable tension stress : $S_t = 0.6 F_y = 0.6 * 36000 = 21600 \text{ PSI}$

HT/DcR Engineering, Inc.

Leg 1

Vessel Number: 7793-E4401 Legs

Job No: 1494F
Mark Number: LEG1

Date Printed: 9/14/2007

Leg to Vessel Weld Properties

Distance between welds along side of legs (b) = = 7.7782 in.
 $L_w = 2 W_s = 2 * 10.0000$ = 20.0000 in.

$I_{wy} = \frac{W_s^3}{6} = \frac{10.0000^3}{6}$ = 166.6667 in.³

$I_{wz} = \frac{W_s b^2}{2} = \frac{10.0000 * 7.7782^2}{2}$ = 302.5000 in.³

$J_{wx} = I_{wy} + I_{wz} = 166.6667 + 302.5000$ = 469.1667 in.³

Distance from weld neutral axis to top/bottom of welds:

$EF_{yt} = EF_{yb} = \frac{W_s}{2} = \frac{10.0000}{2}$ = 5.0000 in.

Distance from weld neutral axis to bottom of welds:

$EF_z = \frac{b}{2} = \frac{7.7782}{2}$ = 3.8891 in.

NO Wind Analysis Information

Wind Analysis Calculations

No Wind Load Calculations were performed

NO Seismic Design Information

Seismic Analysis Calculations

No Seismic Analysis Calculations were performed.

Loadings and Stresses on Support Legs

Direction of Applied Force = 0 °

Leg Orientation °	Moment of Inertia in. ⁴	Lateral Force lb.	Axial Stress PSI	Bending Stresses (f _{bx}) PSI	Bending Stresses (f _{by}) PSI	Acceptance Ratio (Eqn ₁)	Acceptance Ratio (Eqn ₂)
0	8.0709	0	-986	0	3858	0.2509	
90	31.7448	0	-986	0	3858	0.2509	
180	8.0709	0	-986	0	3858	0.2509	
270	31.7448	0	-986	0	3858	0.2509	

Direction of Worst case Force = 0 °
 Highest Stress Ratio = 0.2509

HT/DcR Engineering, Inc.

Leg 1

Vessel Number: 7793-E4401 Legs

Job No: 1494F
Mark Number: LEG1

Date Printed: 9/14/2007

Loadings and Stresses on Leg to Vessel attachment welds

Leg Orientation °	Load F _x lb.	Load F _y lb.	Load F _z lb.	Moment M _x in.-lb.	Moment M _y in.-lb.	Moment M _z in.-lb.	Total Stress PSI	Stress Ratio
0	0	0	-5667	0	-10234	0	1114	0.1203
90	0	0	-5667	0	-10234	0	1114	0.1203
180	0	0	-5667	0	-10234	0	1114	0.1203
270	0	0	-5667	0	-10234	0	1114	0.1203

Direction of Worst case Force = 0°
Highest Stress Ratio = 0.1203

Repad to Shell Weld Properties

$$L_w = 2(L_{rh} + L_{rw}) = 2 * (10.0000 + 10.0000) = 40.0000 \text{ in.}$$

$$I_{wy} = \frac{L_{rw} L_{rh}^2}{2} + \frac{L_{rh}^3}{6} = \frac{10.0000 * 10.0000^2}{2} + \frac{10.0000^3}{6} = 666.6667 \text{ in.}^3$$

$$I_{wz} = \frac{L_{rh} L_{rw}^2}{2} + \frac{L_{rw}^3}{6} = \frac{10.0000 * 10.0000^2}{2} + \frac{10.0000^3}{6} = 666.6667 \text{ in.}^3$$

$$J_{wx} = I_{wy} + I_{wz} = 666.6667 + 666.6667 = 1333.3333 \text{ in.}^3$$

Distance from weld neutral axis to top of repad:

$$EF_y = \frac{L_{rh}}{2} = \frac{10.0000}{2} = 5.0000 \text{ in.}$$

Distance from weld neutral axis to side of repad:

$$EF_z = \frac{L_{rw}}{2} = \frac{10.0000}{2} = 5.0000 \text{ in.}$$

Loadings and Stresses on Repad-to-Shell Attachment Welds

Leg Orientation °	Load F _x lb.	Load F _y lb.	Load F _z lb.	Moment M _x in.-lb.	Moment M _y in.-lb.	Moment M _z in.-lb.	Total Stress PSI	Stress Ratio
0	0	0	-5667	0	-13067	0	459	0.0496
90	0	0	-5667	0	-13067	0	459	0.0496
180	0	0	-5667	0	-13067	0	459	0.0496
270	0	0	-5667	0	-13067	0	459	0.0496

Direction of Worst case Force = 0°
Highest Stress Ratio = 0.0496

HT/DcR Engineering, Inc.

Leg 1

Vessel Number: 7793-E4401 Legs

Job No: 1494F
Mark Number: LEG1

Date Printed: 9/14/2007

Loadings and Pressure on Concrete Foundation

Direction of applied force: = 0°

Leg Orientation °	Bearing Pressure PSI	Moment M _x in.-lb.	Moment M _y in.-lb.	Maximum Pressure P _x PSI	Maximum Pressure P _y PSI	Max. Concrete Pressure PSI	Concrete Pressure Ratio
0	89	9240	9240	108.28	108.28	305.11	0.3390
90	89	9240	9240	108.28	108.28	305.11	0.3390
180	89	9240	9240	108.28	108.28	305.11	0.3390
270	89	9240	9240	108.28	108.28	305.11	0.3390

Direction of Worst case Force: = 0°
Highest Stress Ratio = 0.3390

Loadings and Stresses on BasePlate and Anchor bolts

Leg Orientation °	Moment M _x in.-lb.	Moment M _y in.-lb.	Maximum Pressure P _x PSI	Maximum Pressure P _y PSI	Maximum B.P. Stress PSI	BasePlate Stress Ratio	Anchor Bolt Stress PSI	Anchor Bolt Stress Ratio
0	383	364	9191	8745	12687	0.5874	936	0.0240
90	383	364	9191	8745	12687	0.5874	936	0.0240
180	383	364	9191	8745	12687	0.5874	936	0.0240
270	383	364	9191	8745	12687	0.5874	936	0.0240

Direction of Worst case Force: = 0°
Highest Stress Ratio = 0.5874

Maximum General Longitudinal Stresses

VE = 1.00 1.00

$$S_{L1} = \frac{M_a}{Z} - \frac{W VE}{A} + \left(\frac{P * D}{4 * t} \right) = \frac{0}{256.2605} - \frac{22668.57 * 1.00}{28.47} + \left(\frac{76.90 * 36.5000}{4 * 0.2500} \right) = 2011 \text{ PSI}$$

$$S_{L2} = -\frac{M_a}{Z} - \frac{W VE}{A} - \left(\frac{P_e * D}{4 * t} \right) = -\frac{0}{256.2605} - \frac{22668.57 * 1.00}{28.47} - \left(\frac{14.70 * 36.5000}{4 * 0.2500} \right) = -1333 \text{ PSI}$$

Allowable Tension Stress, S_{ta} = S E = 18900 * 0.70 = 13230 PSI

Allowable Compressive Stress, S_{ca} = -B = -8963 PSI

$$R_{SL1} = \frac{S_{L1}}{S_{ta}} = \frac{2011}{13230} = 0.1520$$

$$R_{SL2} = \frac{S_{L2}}{S_{ca}} = \frac{-1333}{-8963} = 0.1487$$

Summary

Governing external force	= None
Total Force	= 0 lb.
Weight	= 22668.57 lb.
Base Moment	= 0 in.-lb.
Tangent Moment	= 0 in.-lb.
Leg Stresses	
Maximum combined compressive and bending stress ratio	= 0.2509
Leg BasePlate	
Concrete Stress Ratio	= 0.3390
Base Plate Stress Ratio	= 0.5874
Host Stresses	
SI1 ratio	= 0.1520
SI2 ratio	= 0.1487
Weld Stresses	
Leg to vessel weld stress ratio	= 0.1203
Repad to shell weld stress ratio	= 0.0496

Empty Pressurized Conditions - Occasional Loads - Seismic Case 8

Support Leg Properties

$$\text{Section Modulus, } S_x = \frac{I_x}{C_x} = \frac{31.7448}{4.2426} = 7.4824 \text{ in.}^3$$

$$\text{Section Modulus, } S_y = \frac{I_y}{C_y} = \frac{8.0709}{2.3826} = 3.3874 \text{ in.}^3$$

$$\text{Radius of gyration, } r_x = \sqrt{\frac{I_x}{A}} = \sqrt{\frac{31.7448}{5.7500}} = 2.3496 \text{ in.}$$

$$\text{Radius of gyration, } r_y = \sqrt{\frac{I_y}{A}} = \sqrt{\frac{8.0709}{5.7500}} = 1.1848 \text{ in.}$$

$$\text{Least radius of gyration, } r_{\min} = \sqrt{\frac{I_{\min}}{A}} = \sqrt{\frac{8.0709}{5.7500}} = 1.1848 \text{ in.}$$

$$\text{Slenderness ratio, } SR_x = \frac{K L}{r_x} = \frac{1.5000 * 73.8800}{2.3496} = 47.1655$$

$$\text{Slenderness ratio, } SR_y = \frac{K L}{r_y} = \frac{1.5000 * 73.8800}{1.1848} = 93.5348$$

$$SR_{\max} = \frac{K L}{r_{\min}} = \frac{1.5000 * 73.8800}{1.1848} = 93.5348$$

$$\text{Critical slenderness ratio, } C_c = \sqrt{\frac{2 \pi^2 E}{F_y}} = \sqrt{\frac{2 * \pi^2 * (28.3 * 10^6)}{36000}} = 124.57$$

$$F'_{ex} = \frac{4}{3} \frac{12 \pi^2 E}{23 SR_x^2} = \frac{4}{3} * \frac{12 * \pi^2 * (28.3 * 10^6)}{23 * 47.1655^2} = 87343 \text{ PSI}$$

$$F'_{ey} = \frac{4}{3} \frac{12 \pi^2 E}{23 SR_y^2} = \frac{4}{3} * \frac{12 * \pi^2 * (28.3 * 10^6)}{23 * 93.5348^2} = 22209 \text{ PSI}$$

For $SR_{\max} \leq C_c$, Allowable compressive stress:

$$F_a = \frac{4}{3} \frac{\left(1 - \frac{SR_{\max}^2}{2 C_c^2}\right) F_y}{\frac{5}{3} + \frac{3 SR_{\max}}{8 C_c} - \frac{SR_{\max}^3}{8 C_c^3}} = \frac{4}{3} * \frac{\left(1 - \frac{93.5348^2}{2 * 124.57^2}\right) * 36000}{\frac{5}{3} + \frac{3 * 93.5348}{8 * 124.57} - \frac{93.5348^3}{8 * 124.57^3}} = 18187 \text{ PSI}$$

$$\text{Allowable bending stress : } S_b = \frac{4}{3} 0.6 F_y = \frac{4}{3} * 0.6 * 36000 = 28800 \text{ PSI}$$

$$\text{Allowable tension stress : } S_t = \frac{4}{3} 0.6 F_y = \frac{4}{3} * 0.6 * 36000 = 28800 \text{ PSI}$$

HT/DcR Engineering, Inc.

Leg 1

Vessel Number: 7793-E4401 Legs

Job No: 1494F
Mark Number: LEG1

Date Printed: 9/14/2007

Leg to Vessel Weld Properties

Distance between welds along side of legs (b) = = 7.7782 in.
 $L_w = 2 W_s = 2 * 10.0000$ = 20.0000 in.

$I_{wy} = \frac{W_s^3}{6} = \frac{10.0000^3}{6}$ = 166.6667 in.³

$I_{wz} = \frac{W_s b^2}{2} = \frac{10.0000 * 7.7782^2}{2}$ = 302.5000 in.³

$J_{wx} = I_{wy} + I_{wz} = 166.6667 + 302.5000$ = 469.1667 in.³

Distance from weld neutral axis to top/bottom of welds:

$EF_{yt} = EF_{yb} = \frac{W_s}{2} = \frac{10.0000}{2}$ = 5.0000 in.

Distance from weld neutral axis to bottom of welds:

$EF_z = \frac{b}{2} = \frac{7.7782}{2}$ = 3.8891 in.

NO Wind Analysis Information

Wind Analysis Calculations

No Wind Load Calculations were performed

IBC 2003 Seismic Design Information

Spectral Resp. Accel. at short periods (S _s):	0.200	Response Modification Factor (R):	3.000
Spectral Resp. Accel. at a period of 1 s (S ₁):	0.100	Site Class:	D
Seismic Use Group:	I		
Seismic Design Category:	C		

Seismic Analysis Calculations

Seismic Center of Gravity: = 179.4448 in.

$C_s = \frac{SDS I}{R} = \frac{0.2133 * 1.00}{3.000}$ = 0.0711

$V = W * C_s = 14283.61 * 0.03$ = 1015.72 lb.

$F_s = V C_{eh} = 1015.72 * 0.70$ = 711 lb.

HT/DcR Engineering, Inc.

Leg 1

Job No: 1494F
Mark Number: LEG1

Vessel Number: 7793-E4401 Legs

Date Printed: 9/14/2007

Loadings and Stresses on Support Legs

Direction of Applied Force = 0 °

Leg Orientation °	Moment of Inertia in. ⁴	Lateral Force lb.	Axial Stress PSI	Bending Stresses (f _{bx}) PSI	Bending Stresses (f _{by}) PSI	Acceptance Ratio (Eqn ₁)	Acceptance Ratio (Eqn ₂)
0	8.0709	72	124	0	1663	0.0635	
90	31.7448	283	-354	2099	1386	0.1405	
180	8.0709	72	-832	0	4435	0.1997	
270	31.7448	283	-354	2099	1386	0.1405	

Direction of Worst case Force = 41 °
Highest Stress Ratio = 0.2376

Loadings and Stresses on Leg to Vessel attachment welds

Leg Orientation °	Load F _x lb.	Load F _y lb.	Load F _z lb.	Moment M _x in.-lb.	Moment M _y in.-lb.	Moment M _z in.-lb.	Total Stress PSI	Stress Ratio
0	72	0	712	0	-2707	0	245	0.0198
90	0	283	-2036	15705	-3677	511	845	0.0684
180	-72	0	-4784	0	-4646	0	733	0.0594
270	0	283	-2036	15705	-3677	511	845	0.0684

Direction of Worst case Force = 1 °
Highest Stress Ratio: 0.0956

Repad to Shell Weld Properties

$$L_w = 2 (L_{rh} + L_{rw}) = 2 * (10.0000 + 10.0000) = 40.0000 \text{ in.}$$

$$I_{wy} = \frac{L_{rw} L_{rh}^2}{2} + \frac{L_{rh}^3}{6} = \frac{10.0000 * 10.0000^2}{2} + \frac{10.0000^3}{6} = 666.6667 \text{ in.}^3$$

$$I_{wz} = \frac{L_{rh} L_{rw}^2}{2} + \frac{L_{rw}^3}{6} = \frac{10.0000 * 10.0000^2}{2} + \frac{10.0000^3}{6} = 666.6667 \text{ in.}^3$$

$$J_{wx} = I_{wy} + I_{wz} = 666.6667 + 666.6667 = 1333.3333 \text{ in.}^3$$

Distance from weld neutral axis to top of repad:

$$EF_y = \frac{L_{rh}}{2} = \frac{10.0000}{2} = 5.0000 \text{ in.}$$

Distance from weld neutral axis to side of repad:

$$EF_z = \frac{L_{rw}}{2} = \frac{10.0000}{2} = 5.0000 \text{ in.}$$

HT/DcR Engineering, Inc.

Leg 1

Job No: 1494F
Mark Number: LEG1

Vessel Number: 7793-E4401 Legs

Date Printed: 9/14/2007

Loadings and Stresses on Repad-to-Shell Attachment Welds

Leg Orientation °	Load F _x lb.	Load F _y lb.	Load F _z lb.	Moment M _x in.-lb.	Moment M _y in.-lb.	Moment M _z in.-lb.	Total Stress PSI	Stress Ratio
0	72	0	712	0	-2351	0	70	0.0057
90	0	283	-2036	15705	-4695	653	358	0.0290
180	-72	0	-4784	0	-7038	0	347	0.0281
270	0	283	-2036	15705	-4695	653	358	0.0290

Direction of Worst case Force = 1°
Highest Stress Ratio = 0.0411

Loadings and Pressure on Concrete Foundation

Direction of applied force: = 0°

Leg Orientation °	Bearing Pressure PSI	Moment M _x in.-lb.	Moment M _y in.-lb.	Maximum Pressure P _x PSI	Maximum Pressure P _y PSI	Max. Concrete Pressure PSI	Concrete Pressure Ratio
0	-11	721	721	8.45	8.45	5.77	0.0048
90	32	10723	10723	125.66	125.66	283.13	0.2359
180	75	5918	5918	69.35	69.35	213.45	0.1779
270	32	10723	10723	125.66	125.66	283.13	0.2359

Direction of Worst case Force: = 1°
Highest Stress Ratio = 0.3275

Loadings and Stresses on BasePlate and Anchor bolts

Leg Orientation °	Moment M _x in.-lb.	Moment M _y in.-lb.	Maximum Pressure P _x PSI	Maximum Pressure P _y PSI	Maximum B.P. Stress PSI	BasePlate Stress Ratio	Anchor Bolt Stress PSI	Anchor Bolt Stress Ratio
0	0	0	0	0	0	0.0000	575	0.0111
90	300	278	7193	6675	9813	0.3407	2371	0.0456
180	282	270	6770	6484	9374	0.3255	365	0.0070
270	300	278	7193	6675	9813	0.3407	2371	0.0456

Direction of Worst case Force: = 1°
Highest Stress Ratio = 0.5006

Maximum General Longitudinal Stresses

$VE = (C_{de} + 0.2 * SDS * I * C_{ev}) = (0.60 + 0.2 * 0.21 * 1.00 * -0.70) =$ 0.57

$S_{L1} = \frac{M_a}{Z} - \frac{W VE}{A} + \left(\frac{P * D}{4 * t} \right) = \frac{75057}{256.2605} - \frac{14283.61 * 0.57}{28.47} + \left(\frac{75.00 * 36.5000}{4 * 0.2500} \right)$ = 2744 PSI

$S_{L2} = -\frac{M_a}{Z} - \frac{W VE}{A} - \left(\frac{Pe * D}{4 * t} \right) = -\frac{75057}{256.2605} - \frac{14283.61 * 0.57}{28.47} - \left(\frac{14.70 * 36.5000}{4 * 0.2500} \right)$ = -1115 PSI

Allowable Tension Stress, $S_{ta} = 1.2 S E = 1.2 * 18900 * 0.70$ = 15876 PSI

Allowable Compressive Stress, $S_{ca} = -1.2 B = -1.2 * 8963$ = -10756 PSI

$R_{SL1} = \frac{S_{L1}}{S_{ta}} = \frac{2744}{15876}$ = 0.1728

$R_{SL2} = \frac{S_{L2}}{S_{ca}} = \frac{-1115}{-10756}$ = 0.1037

Summary

Governing external force	= Seismic load
Total Force	= 711 lb.
Weight	= 14283.61 lb.
Base Moment	= 127586 in.-lb.
Tangent Moment	= 75057 in.-lb.
Leg Stresses	
Maximum combined compressive and bending stress ratio	= 0.2376
Leg BasePlate	
Concrete Stress Ratio	= 0.3275
Base Plate Stress Ratio	= 0.5006
Host Stresses	
SI1 ratio	= 0.1728
SI2 ratio	= 0.1037
Weld Stresses	
Leg to vessel weld stress ratio	= 0.0956
Repad to shell weld stress ratio	= 0.0411

Empty Pressurized Conditions - Occasional Loads - Wind Case 7

Support Leg Properties

$$\text{Section Modulus, } S_x = \frac{I_x}{C_x} = \frac{31.7448}{4.2426} = 7.4824 \text{ in.}^3$$

$$\text{Section Modulus, } S_y = \frac{I_y}{C_y} = \frac{8.0709}{2.3826} = 3.3874 \text{ in.}^3$$

$$\text{Radius of gyration, } r_x = \sqrt{\frac{I_x}{A}} = \sqrt{\frac{31.7448}{5.7500}} = 2.3496 \text{ in.}$$

$$\text{Radius of gyration, } r_y = \sqrt{\frac{I_y}{A}} = \sqrt{\frac{8.0709}{5.7500}} = 1.1848 \text{ in.}$$

$$\text{Least radius of gyration, } r_{\min} = \sqrt{\frac{I_{\min}}{A}} = \sqrt{\frac{8.0709}{5.7500}} = 1.1848 \text{ in.}$$

$$\text{Slenderness ratio, } SR_x = \frac{K L}{r_x} = \frac{1.5000 * 73.8800}{2.3496} = 47.1655$$

$$\text{Slenderness ratio, } SR_y = \frac{K L}{r_y} = \frac{1.5000 * 73.8800}{1.1848} = 93.5348$$

$$SR_{\max} = \frac{K L}{r_{\min}} = \frac{1.5000 * 73.8800}{1.1848} = 93.5348$$

$$\text{Critical slenderness ratio, } C_c = \sqrt{\frac{2 \pi^2 E}{F_y}} = \sqrt{\frac{2 * \pi^2 * (28.3 * 10^6)}{36000}} = 124.57$$

$$F'_{ex} = \frac{4}{3} \frac{12 \pi^2 E}{23 SR_x^2} = \frac{4}{3} * \frac{12 * \pi^2 * (28.3 * 10^6)}{23 * 47.1655^2} = 87343 \text{ PSI}$$

$$F'_{ey} = \frac{4}{3} \frac{12 \pi^2 E}{23 SR_y^2} = \frac{4}{3} * \frac{12 * \pi^2 * (28.3 * 10^6)}{23 * 93.5348^2} = 22209 \text{ PSI}$$

For $SR_{\max} \leq C_c$, Allowable compressive stress:

$$F_a = \frac{4}{3} \frac{\left(1 - \frac{SR_{\max}^2}{2 C_c^2}\right) F_y}{\frac{5}{3} + \frac{3 SR_{\max}}{8 C_c} - \frac{SR_{\max}^3}{8 C_c^3}} = \frac{4}{3} * \frac{\left(1 - \frac{93.5348^2}{2 * 124.57^2}\right) * 36000}{\frac{5}{3} + \frac{3 * 93.5348}{8 * 124.57} - \frac{93.5348^3}{8 * 124.57^3}} = 18187 \text{ PSI}$$

$$\text{Allowable bending stress : } S_b = \frac{4}{3} 0.6 F_y = \frac{4}{3} * 0.6 * 36000 = 28800 \text{ PSI}$$

$$\text{Allowable tension stress : } S_t = \frac{4}{3} 0.6 F_y = \frac{4}{3} * 0.6 * 36000 = 28800 \text{ PSI}$$

HT/DcR Engineering, Inc.

Leg 1

Vessel Number: 7793-E4401 Legs

Job No: 1494F
Mark Number: LEG1

Date Printed: 9/14/2007

Leg to Vessel Weld Properties

Distance between welds along side of legs (b) = = 7.7782 in.
 $L_w = 2 W_s = 2 * 10.0000$ = 20.0000 in.

$I_{wy} = \frac{W_s^3}{6} = \frac{10.0000^3}{6}$ = 166.6667 in.³

$I_{wz} = \frac{W_s b^2}{2} = \frac{10.0000 * 7.7782^2}{2}$ = 302.5000 in.³

$J_{wx} = I_{wy} + I_{wz} = 166.6667 + 302.5000$ = 469.1667 in.³

Distance from weld neutral axis to top/bottom of welds:

$EF_{yt} = EF_{yb} = \frac{W_s}{2} = \frac{10.0000}{2}$ = 5.0000 in.

Distance from weld neutral axis to bottom of welds:

$EF_z = \frac{b}{2} = \frac{7.7782}{2}$ = 3.8891 in.

IBC 2003 Wind Analysis Information

Basic Wind Speed (V):	90	MPH	Wind Exposure type:	C
Importance factor (I):	1.0000		Force (shape) coefficient (C _f):	0.70
Topographic Factor (K _{zt}):	1.00		Directionality Factor (K _d):	1.00

Wind Analysis Calculations

Wind Center of Gravity = 178.6462 in.
 $q_z = 0.00256 K_z K_{zt} K_d V^2 I = 0.00256 * 0.85 * 1.000 * 1.00 * 90^2 * 1.0000$ = 17.626
 $P = q_z G C_f = 17.626 * 0.90 * 0.70$ = 11.10 lb./ft²
Wind Load, F_w = P A C_{wi} = 11.10 * 74.7016 * 1.00 = 829 lb.

NO Seismic Design Information

Seismic Analysis Calculations

No Seismic Analysis Calculations were performed.

HT/DcR Engineering, Inc.

Leg 1

Job No: 1494F
Mark Number: LEG1

Vessel Number: 7793-E4401 Legs

Date Printed: 9/14/2007

Loadings and Stresses on Support Legs

Direction of Applied Force = 0 °

Leg Orientation °	Moment of Inertia in. ⁴	Lateral Force lb.	Axial Stress PSI	Bending Stresses (f _{bx}) PSI	Bending Stresses (f _{by}) PSI	Acceptance Ratio (Eqn ₁)	Acceptance Ratio (Eqn ₂)
0	8.0709	84	182	0	2087	0.0809	
90	31.7448	331	-373	2448	1459	0.1562	
180	8.0709	84	-927	0	5004	0.2247	
270	31.7448	331	-373	2448	1459	0.1562	

Direction of Worst case Force = 40 °
Highest Stress Ratio = 0.2690

Loadings and Stresses on Leg to Vessel attachment welds

Leg Orientation °	Load F _x lb.	Load F _y lb.	Load F _z lb.	Moment M _x in.-lb.	Moment M _y in.-lb.	Moment M _z in.-lb.	Total Stress PSI	Stress Ratio
0	84	0	1047	0	-2766	0	271	0.0219
90	0	331	-2143	18316	-3870	598	951	0.0770
180	-84	0	-5332	0	-4972	0	809	0.0655
270	0	331	-2143	18316	-3870	598	951	0.0770

Direction of Worst case Force = 1 °
Highest Stress Ratio: 0.1080

Repad to Shell Weld Properties

$$L_w = 2 (L_{rh} + L_{rw}) = 2 * (10.0000 + 10.0000) = 40.0000 \text{ in.}$$

$$I_{wy} = \frac{L_{rw} L_{rh}^2}{2} + \frac{L_{rh}^3}{6} = \frac{10.0000 * 10.0000^2}{2} + \frac{10.0000^3}{6} = 666.6667 \text{ in.}^3$$

$$I_{wz} = \frac{L_{rh} L_{rw}^2}{2} + \frac{L_{rw}^3}{6} = \frac{10.0000 * 10.0000^2}{2} + \frac{10.0000^3}{6} = 666.6667 \text{ in.}^3$$

$$J_{wx} = I_{wy} + I_{wz} = 666.6667 + 666.6667 = 1333.3333 \text{ in.}^3$$

Distance from weld neutral axis to top of repad:

$$EF_y = \frac{L_{rh}}{2} = \frac{10.0000}{2} = 5.0000 \text{ in.}$$

Distance from weld neutral axis to side of repad:

$$EF_z = \frac{L_{rw}}{2} = \frac{10.0000}{2} = 5.0000 \text{ in.}$$

HT/DcR Engineering, Inc.

Leg 1

Vessel Number: 7793-E4401 Legs

Job No: 1494F
Mark Number: LEG1

Date Printed: 9/14/2007

Loadings and Stresses on Repad-to-Shell Attachment Welds

Leg Orientation °	Load F _x lb.	Load F _y lb.	Load F _z lb.	Moment M _x in.-lb.	Moment M _y in.-lb.	Moment M _z in.-lb.	Total Stress PSI	Stress Ratio
0	84	0	1047	0	-2243	0	86	0.0070
90	0	331	-2143	18316	-4941	763	402	0.0326
180	-84	0	-5332	0	-7638	0	385	0.0312
270	0	331	-2143	18316	-4941	763	402	0.0326

Direction of Worst case Force = 1°
Highest Stress Ratio = 0.0464

Loadings and Pressure on Concrete Foundation

Direction of applied force: = 0°

Leg Orientation °	Bearing Pressure PSI	Moment M _x in.-lb.	Moment M _y in.-lb.	Maximum Pressure P _x PSI	Maximum Pressure P _y PSI	Max. Concrete Pressure PSI	Concrete Pressure Ratio
0	-16	488	488	5.72	5.72	0.00	0.0000
90	33	12128	12128	142.13	142.13	317.73	0.2648
180	83	6498	6498	76.15	76.15	235.61	0.1963
270	33	12128	12128	142.13	142.13	317.73	0.2648

Direction of Worst case Force: = 1°
Highest Stress Ratio = 0.3710

Loadings and Stresses on BasePlate and Anchor bolts

Leg Orientation °	Moment M _x in.-lb.	Moment M _y in.-lb.	Maximum Pressure P _x PSI	Maximum Pressure P _y PSI	Maximum B.P. Stress PSI	BasePlate Stress Ratio	Anchor Bolt Stress PSI	Anchor Bolt Stress Ratio
0	0	0	0	0	0	0.0000	566	0.0109
90	334	309	8013	7427	10926	0.3794	2735	0.0526
180	312	299	7494	7180	10379	0.3604	386	0.0074
270	334	309	8013	7427	10926	0.3794	2735	0.0526

Direction of Worst case Force: = 1°
Highest Stress Ratio = 0.5648

Maximum General Longitudinal Stresses

VE = C_{de} = 0.60 = 0.60

$$S_{L1} = \frac{M_a}{Z} - \frac{W VE}{A} + \left(\frac{P * D}{4 * t} \right) = \frac{86871}{256.2605} - \frac{14283.61 * 0.60}{28.47} + \left(\frac{75.00 * 36.5000}{4 * 0.2500} \right) = 2775 \text{ PSI}$$

$$S_{L2} = -\frac{M_a}{Z} - \frac{W VE}{A} - \left(\frac{Pe * D}{4 * t} \right) = -\frac{86871}{256.2605} - \frac{14283.61 * 0.60}{28.47} - \left(\frac{14.70 * 36.5000}{4 * 0.2500} \right) = -1177 \text{ PSI}$$

Allowable Tension Stress, S_{ta} = 1.2 S E = 1.2 * 18900 * 0.70 = 15876 PSI

Allowable Compressive Stress, S_{ca} = -1.2 B = -1.2 * 8963 = -10756 PSI

$$R_{SL1} = \frac{S_{L1}}{S_{ta}} = \frac{2775}{15876} = 0.1748$$

$$R_{SL2} = \frac{S_{L2}}{S_{ca}} = \frac{-1177}{-10756} = 0.1094$$

Summary

Governing external force	= Wind load
Total Force	= 829 lb.
Weight	= 14283.61 lb.
Base Moment	= 148132 in.-lb.
Tangent Moment	= 86871 in.-lb.
Leg Stresses	
Maximum combined compressive and bending stress ratio	= 0.2690
Leg BasePlate	
Concrete Stress Ratio	= 0.3710
Base Plate Stress Ratio	= 0.5648
Host Stresses	
S11 ratio	= 0.1748
S12 ratio	= 0.1094
Weld Stresses	
Leg to vessel weld stress ratio	= 0.1080
Repad to shell weld stress ratio	= 0.0464

Empty Pressurized Condition - Sustained Loads

Support Leg Properties

$$\text{Section Modulus, } S_x = \frac{I_x}{C_x} = \frac{31.7448}{4.2426} = 7.4824 \text{ in.}^3$$

$$\text{Section Modulus, } S_y = \frac{I_y}{C_y} = \frac{8.0709}{2.3826} = 3.3874 \text{ in.}^3$$

$$\text{Radius of gyration, } r_x = \sqrt{\frac{I_x}{A}} = \sqrt{\frac{31.7448}{5.7500}} = 2.3496 \text{ in.}$$

$$\text{Radius of gyration, } r_y = \sqrt{\frac{I_y}{A}} = \sqrt{\frac{8.0709}{5.7500}} = 1.1848 \text{ in.}$$

$$\text{Least radius of gyration, } r_{\min} = \sqrt{\frac{I_{\min}}{A}} = \sqrt{\frac{8.0709}{5.7500}} = 1.1848 \text{ in.}$$

$$\text{Slenderness ratio, } SR_x = \frac{K L}{r_x} = \frac{1.5000 * 73.8800}{2.3496} = 47.1655$$

$$\text{Slenderness ratio, } SR_y = \frac{K L}{r_y} = \frac{1.5000 * 73.8800}{1.1848} = 93.5348$$

$$SR_{\max} = \frac{K L}{r_{\min}} = \frac{1.5000 * 73.8800}{1.1848} = 93.5348$$

$$\text{Critical slenderness ratio, } C_c = \sqrt{\frac{2 \pi^2 E}{F_y}} = \sqrt{\frac{2 * \pi^2 * (28.3 * 10^6)}{36000}} = 124.57$$

$$F'_{ex} = \frac{12 \pi^2 E}{23 SR_x^2} = \frac{12 * \pi^2 * (28.3 * 10^6)}{23 * 47.1655^2} = 65507 \text{ PSI}$$

$$F'_{ey} = \frac{12 \pi^2 E}{23 SR_y^2} = \frac{12 * \pi^2 * (28.3 * 10^6)}{23 * 93.5348^2} = 16657 \text{ PSI}$$

For $SR_{\max} \leq C_c$, Allowable compressive stress:

$$F_a = \frac{\left(1 - \frac{SR_{\max}^2}{2 C_c^2}\right) F_y}{\frac{5}{3} + \frac{3 SR_{\max}}{8 C_c} - \frac{SR_{\max}^3}{8 C_c^3}} = \frac{\left(1 - \frac{93.5348^2}{2 * 124.57^2}\right) * 36000}{\frac{5}{3} + \frac{3 * 93.5348}{8 * 124.57} - \frac{93.5348^3}{8 * 124.57^3}} = 13640 \text{ PSI}$$

$$F_a = \frac{\left(1 - \frac{93.5348^2}{2 * 124.57^2}\right) * 36000}{\frac{5}{3} + \frac{3 * 93.5348}{8 * 124.57} - \frac{93.5348^3}{8 * 124.57^3}} = 13640 \text{ PSI}$$

$$\text{Allowable bending stress : } S_b = 0.6 F_y = 0.6 * 36000 = 21600 \text{ PSI}$$

$$\text{Allowable tension stress : } S_t = 0.6 F_y = 0.6 * 36000 = 21600 \text{ PSI}$$

HT/DcR Engineering, Inc.

Leg 1

Vessel Number: 7793-E4401 Legs

Job No: 1494F
Mark Number: LEG1

Date Printed: 9/14/2007

Leg to Vessel Weld Properties

Distance between welds along side of legs (b) = = 7.7782 in.
 $L_w = 2 W_s = 2 * 10.0000$ = 20.0000 in.

$I_{wy} = \frac{W_s^3}{6} = \frac{10.0000^3}{6}$ = 166.6667 in.³

$I_{wz} = \frac{W_s b^2}{2} = \frac{10.0000 * 7.7782^2}{2}$ = 302.5000 in.³

$J_{wx} = I_{wy} + I_{wz} = 166.6667 + 302.5000$ = 469.1667 in.³

Distance from weld neutral axis to top/bottom of welds:

$EF_{yt} = EF_{yb} = \frac{W_s}{2} = \frac{10.0000}{2}$ = 5.0000 in.

Distance from weld neutral axis to bottom of welds:

$EF_z = \frac{b}{2} = \frac{7.7782}{2}$ = 3.8891 in.

NO Wind Analysis Information

Wind Analysis Calculations

No Wind Load Calculations were performed

NO Seismic Design Information

Seismic Analysis Calculations

No Seismic Analysis Calculations were performed.

Loadings and Stresses on Support Legs

Direction of Applied Force = 0 °

Leg Orientation °	Moment of Inertia in. ⁴	Lateral Force lb.	Axial Stress PSI	Bending Stresses (f _{bx}) PSI	Bending Stresses (f _{by}) PSI	Acceptance Ratio (Eqn ₁)	Acceptance Ratio (Eqn ₂)
0	8.0709	0	-621	0	2431	0.1581	
90	31.7448	0	-621	0	2431	0.1581	
180	8.0709	0	-621	0	2431	0.1581	
270	31.7448	0	-621	0	2431	0.1581	

Direction of Worst case Force = 0 °
 Highest Stress Ratio = 0.1581

HT/DcR Engineering, Inc.

Leg 1

Vessel Number: 7793-E4401 Legs

Job No: 1494F
Mark Number: LEG1

Date Printed: 9/14/2007

Loadings and Stresses on Leg to Vessel attachment welds

Leg Orientation °	Load F _x lb.	Load F _y lb.	Load F _z lb.	Moment M _x in.-lb.	Moment M _y in.-lb.	Moment M _z in.-lb.	Total Stress PSI	Stress Ratio
0	0	0	-3571	0	-6449	0	702	0.0758
90	0	0	-3571	0	-6449	0	702	0.0758
180	0	0	-3571	0	-6449	0	702	0.0758
270	0	0	-3571	0	-6449	0	702	0.0758

Direction of Worst case Force = 0 °
Highest Stress Ratio: 0.0758

Repad to Shell Weld Properties

$$L_w = 2 (L_{rh} + L_{rw}) = 2 * (10.0000 + 10.0000) = 40.0000 \text{ in.}$$

$$I_{wy} = \frac{L_{rw} L_{rh}^2}{2} + \frac{L_{rh}^3}{6} = \frac{10.0000 * 10.0000^2}{2} + \frac{10.0000^3}{6} = 666.6667 \text{ in.}^3$$

$$I_{wz} = \frac{L_{rh} L_{rw}^2}{2} + \frac{L_{rw}^3}{6} = \frac{10.0000 * 10.0000^2}{2} + \frac{10.0000^3}{6} = 666.6667 \text{ in.}^3$$

$$J_{wx} = I_{wy} + I_{wz} = 666.6667 + 666.6667 = 1333.3333 \text{ in.}^3$$

Distance from weld neutral axis to top of repad:

$$EF_y = \frac{L_{rh}}{2} = \frac{10.0000}{2} = 5.0000 \text{ in.}$$

Distance from weld neutral axis to side of repad:

$$EF_z = \frac{L_{rw}}{2} = \frac{10.0000}{2} = 5.0000 \text{ in.}$$

Loadings and Stresses on Repad-to-Shell Attachment Welds

Leg Orientation °	Load F _x lb.	Load F _y lb.	Load F _z lb.	Moment M _x in.-lb.	Moment M _y in.-lb.	Moment M _z in.-lb.	Total Stress PSI	Stress Ratio
0	0	0	-3571	0	-8234	0	289	0.0312
90	0	0	-3571	0	-8234	0	289	0.0312
180	0	0	-3571	0	-8234	0	289	0.0312
270	0	0	-3571	0	-8234	0	289	0.0312

Direction of Worst case Force = 0 °
Highest Stress Ratio = 0.0312

HT/DcR Engineering, Inc.

Leg 1

Vessel Number: 7793-E4401 Legs

Job No: 1494F
Mark Number: LEG1

Date Printed: 9/14/2007

Loadings and Pressure on Concrete Foundation

Direction of applied force: = 0°

Leg Orientation °	Bearing Pressure PSI	Moment M _x in.-lb.	Moment M _y in.-lb.	Maximum Pressure P _x PSI	Maximum Pressure P _y PSI	Max. Concrete Pressure PSI	Concrete Pressure Ratio
0	56	5822	5822	68.23	68.23	192.25	0.2136
90	56	5822	5822	68.23	68.23	192.25	0.2136
180	56	5822	5822	68.23	68.23	192.25	0.2136
270	56	5822	5822	68.23	68.23	192.25	0.2136

Direction of Worst case Force: = 0°
Highest Stress Ratio = 0.2136

Loadings and Stresses on BasePlate and Anchor bolts

Leg Orientation °	Moment M _x in.-lb.	Moment M _y in.-lb.	Maximum Pressure P _x PSI	Maximum Pressure P _y PSI	Maximum B.P. Stress PSI	BasePlate Stress Ratio	Anchor Bolt Stress PSI	Anchor Bolt Stress Ratio
0	241	230	5792	5510	7994	0.3701	589	0.0151
90	241	230	5792	5510	7994	0.3701	589	0.0151
180	241	230	5792	5510	7994	0.3701	589	0.0151
270	241	230	5792	5510	7994	0.3701	589	0.0151

Direction of Worst case Force: = 0°
Highest Stress Ratio = 0.3701

Maximum General Longitudinal Stresses

VE = 1.00 1.00

$$S_{L1} = \frac{M_a}{Z} - \frac{W VE}{A} + \left(\frac{P * D}{4 * t} \right) = \frac{0}{256.2605} - \frac{14283.61 * 1.00}{28.47} + \left(\frac{75.00 * 36.5000}{4 * 0.2500} \right) = 2236 \text{ PSI}$$

$$S_{L2} = -\frac{M_a}{Z} - \frac{W VE}{A} - \left(\frac{P_e * D}{4 * t} \right) = -\frac{0}{256.2605} - \frac{14283.61 * 1.00}{28.47} - \left(\frac{14.70 * 36.5000}{4 * 0.2500} \right) = -1038 \text{ PSI}$$

Allowable Tension Stress, S_{ta} = S E = 18900 * 0.70 = 13230 PSI

Allowable Compressive Stress, S_{ca} = -B = -8963 = -8963 PSI

$$R_{SL1} = \frac{S_{L1}}{S_{ta}} = \frac{2236}{13230} = 0.1690$$

$$R_{SL2} = \frac{S_{L2}}{S_{ca}} = \frac{-1038}{-8963} = 0.1158$$

Summary

Governing external force	= None
Total Force	= 0 lb.
Weight	= 14283.61 lb.
Base Moment	= 0 in.-lb.
Tangent Moment	= 0 in.-lb.
Leg Stresses	
Maximum combined compressive and bending stress ratio	= 0.1581
Leg BasePlate	
Concrete Stress Ratio	= 0.2136
Base Plate Stress Ratio	= 0.3701
Host Stresses	
SI1 ratio	= 0.1690
SI2 ratio	= 0.1158
Weld Stresses	
Leg to vessel weld stress ratio	= 0.0758
Repad to shell weld stress ratio	= 0.0312

HT/DcR Engineering, Inc.

Customer: Delta-T
Job No: 1494F

Vessel Number: 7793-E4401 Legs

Date Printed: 9/14/2007

Loading Summary

Type	Starting Elevation (in.)	Ending Elevation (in.)	Density (lb./Ft ³)	Thickness (in.)	Wind Diameter (in.)	Wind Pressure (lb./ft. ²)
Liquid	32.0000	280.0000	62.4000	-	-	-
Insulation	0.0000	0.0000	-	-	-	-
Wind	32.0000	290.0000	-	-	42.0000	-

Attachment Summary

Attachment No.	Elevation (in.)	Description	Attachment Weight (lb.)	Horizontal Force (lb.)	Attachment Moment (in.-lb.)
1	180.0000	BUNDLE PLUS	12000.00	0	0

HT/DcR Engineering, Inc.

Customer: Delta-T
Job No: 1494F

Vessel Number: 7793-E4401 Legs

Date Printed: 9/14/2007

Summary Information

	<u>Dry Weight</u>	<u>Flooded Weight</u>
Shell	1981.56 lb.	10817.27 lb.
Head	302.05 lb.	890.11 lb.
Totals	<hr/> 2283.61 lb.	<hr/> 11707.38 lb.
	<u>Volume</u>	
Shell	1057.65 Gal.	
Head	70.51 Gal.	
Totals	<hr/> 1128.16 Gal.	
	<u>Area</u>	
Shell	191.11 Sq. Ft.	
Head	23.13 Sq. Ft.	
Totals	<hr/> 214.24 Sq. Ft.	

Hydrostatic Test Information (UG-99)

Gauge at Top

Component with controlling ratio is : Shell 1
Component with controlling pressure is : Shell 1

$$\text{Calculated Test Pressure} = P * 1.3 * \frac{\text{Cold Stress}}{\text{Hot Stress}} = 75.00 * 1.3 * \frac{20000}{18900} = 103.17 \text{ PSI}$$

Table of Contents

eg Information	1
ttachment/Loading Information	37
ummary Information	38

HT/DCR Engineering, Inc.

Calculation Number:
1494F-7793-E4401-01

Client: DcR Construction	Project: 1494F - 7793 - E4401	Discipline: Structural
Subject/Title: E-4401 LIFTING LUGS & LEGS QUALIFICATIONS	Job Number: 1494F	
Objective: QUALIFY LIFTING LUGS AND LEGS		
System or Equipment ID: 7793-E4401		

Contents

Topic	Page	Attachments (Computer Printouts, Technical Papers, Sketches, Correspondence)	# of Pages
Purpose	2	#1 - pg 120 Pressure Vessel Handbook 10th Ed.	1
Summary of Conclusions	2		
Methodology	2	#2 - BIAE OUTPUT FOR WTS.	2
Assumptions	2		
Criteria	2	#3 - APV OUTPUT FOR LEGS	41
Design Inputs/References	2		
Body of Calculations	3		

Last Page Number: 5

Version Record

Version No.	Description	Originator/Date Signature	Reviewer/Date Signature	Approver/Date Signature
A	FOR RECORD	<i>Frank P. Kelly</i> 9-13-07		

HT/DcR Engineering, Inc.

Client: DcR Construction	Project: 1494F	Calculation Number: 1494F-7793-E4401-01
-----------------------------	-------------------	--

Title: LIFTING LUGS & LEGS QUALIFICATIONS	Sheet: 2
--	-------------

Purpose:

Summary LUGS & LEGS FOR E4401

Summary:

LUGS & LEGS OK PER DRAWINGS

Methodology

LUGS based on conventional Methods & PER MATERIAL

Legs based on APV program.

Assumptions

HEAD LUGS ONLY FOR LIFTING HEAD ASSEMBLY

Spreader bars used for vertical lifts

Criteria

Per Reference Material

Design Inputs/References

BJAC output for weights

Pressure Vessel Handbook by Eugene F. Megyas, 10th Ed.

APV OUTPUT FOR LEG QUALIFICATIONS

HT/DcR Engineering, Inc.


Client: DcR Construction	Project: 1494F	Calculation Number: 1494F-7793-E4401-01
-----------------------------	-------------------	--

Title: LIFTING LUGS & LEGS QUALIFICATIONS	Sheet: 3
--	-------------

QUINCY HEAD LUGS

LUG 1/2" THICK
D = 1" ϕ
R = 1 1/2"

SA-36
F_y = 32,400 psi

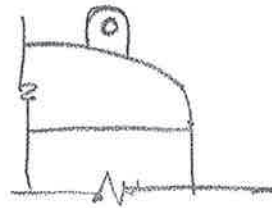

Pressure Vessel Handbook

$$t = \frac{P}{2S(R-D/2)}$$

Design Load = 1.5 (1/2 (522)) = 392[#]

WT OF FRONT HEAD
199[#] Shell
213[#] Head
110[#] Flng

522[#]

LUG STRESS = $\frac{392}{2(1/2)(1.125 - 1/2)} = \underline{\underline{627 \text{ psi}}}$

HEAD MATERIAL 3/8" THICK

STRESS = $\frac{627}{3/8} = \underline{\underline{1673 \text{ psi}}}$
Very Small Stress

HEAD LUGS OK

HT/DcR Engineering, Inc.

Client: DcR Construction	Project: 1494F	Calculation Number: 1494F-7793-E4401-01
-----------------------------	-------------------	--


Title: LIFTING LUGS & LEGS QUALIFICATIONS	Sheet: 4
--	-------------

Shell Lugs (3 TOTAL)

DEAD WT VESSEL $\approx 14,000^*$

$$\text{LOAD / LOG} = \frac{14,000}{3} \times 1.5 \text{ IMPACT} = 7,000^*$$

$$\text{LOG STRESS} = \frac{7,000}{2(1/2)(2-1)} = 7,000 \text{ psi}$$

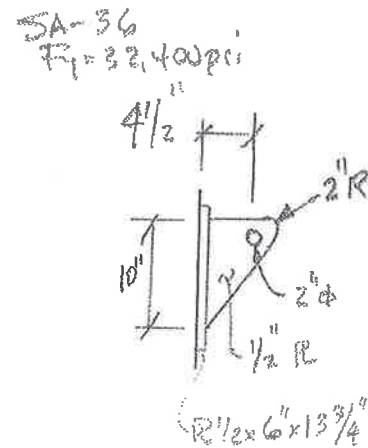

$$\text{SHEAR ALLOW} = .4F_y = 12,960 \text{ psi} > 7,000 \text{ psi}$$

LOG STRESS OK

STRESSES @ FACE OF VESSEL

$$\text{Vertical Shear} = 7,000^*$$

$$\text{Moment} = 7,000 (4 1/2) = 31,500 \text{ #-in}$$

$$\text{Stress } f_b = \frac{7,000}{1/2 \times 10} + \frac{31,500}{1/6 (1/2) (10^2)} = 1400 + 3780 = 5180 \text{ psi}$$

OK

Stresses @ Repair



$$\text{Area weld} = 2(6 + 13 3/4) = 39 1/2$$

$$\text{S_weld} = 6 \times 13 3/4 + \frac{13 3/4^2}{2} = 145 \text{ in}^2$$

$$f_w = \frac{7,000}{39.5} + \frac{31,500}{145} = 177 + 217 = 394 \text{ #/in} \Rightarrow \text{REPAIR } f = \frac{394}{1/2} = 788 \text{ psi}$$

REPAIR OK

Stress @ Shell

$$f_{\text{shell}} = 394 / 0.25 = 1600 \text{ psi} \text{ SMALL SHELL OK}$$

HT/DCR Engineering, Inc.

Client: DcR Construction	Project: 1494F	Calculation Number: 1494F-7793-E4401-01
-----------------------------	-------------------	--

Title: LIFTING LUGS & LEGS QUALIFICATIONS	Sheet: 5
--	-------------

SUPPORT LEGS

SEE APV ANALYSIS

SPUR CONNECTION

$$\text{WELD CAPACITY} = 2 \times [3 \times 4" \times (9600 \times 1/2)] = 115,200 \# / \text{ANGLE}$$

$$\text{BOLT CAPACITY} = 2 \times [3 \times 10.8 \text{K}] = 63,600 \# / \text{ANGLE}$$

OK BY INSPECTION

L 6x6x1/2 LEGS OK

LIFTING ATTACHMENTS (cont.)


RECOMMENDED MATERIAL: A 515-70, A 302 or equivalent. The thickness and length of the lifting lug shall be determined by calculation.*

WELD: When fillet welds are used, it is recommended that throat areas be at least 50 per cent greater than the cross sectional area of the lug.

To design the lugs the entire load should be assumed to act on one lug.

All possible directions of loading should be considered (during shipment, storage, erection, handling.) When two or more lugs are used for multileg sling, the angle between each leg of the sling and the horizontal should be assumed to be 30 degrees.

EYE - BOLT

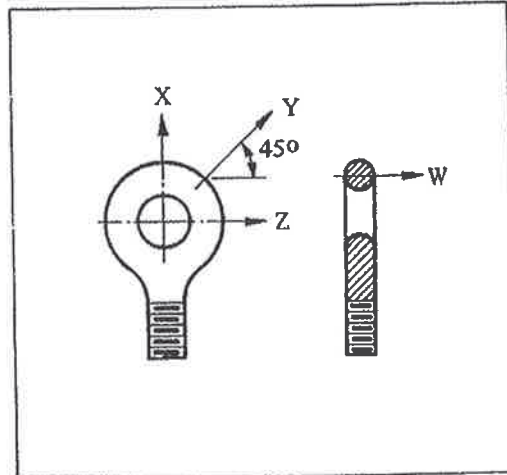

Threaded fasteners smaller than 5/8" diameter should not be used for lifting because of the danger of overtightening during assembly.

Commercial eyebolts are supplied with a rated breaking strength in the X direction.

For loadings other than along the axis of the eyebolt, the following ratings are recommended. These are expressed as percentage of the rating in the axial direction.

X = 100% Y = 33%
Z = 20% W = 10%

EXAMPLE:

An eyebolt of 1 in. diameter which is good for 4960 lb. load in tension (direction x) can carry only $4960 \times 0.33 = 1637$ lb. load if it acts in direction y.

The above dimensions and recommendations are taken from C. V. Moore: Designing Lifting Attachments, Machine Design, March 18, 1965.

*Assuming shear load only thru the minimum section, the required thickness may be calculated by the formula:

$$t = \frac{P}{2S (R \cdot D_1 / 2)}$$

where t = required thickness of lug, in.
P = load, lbs.
S = allowable shear stress, psi.

See page 459 for design of weld and length of lug.

7793-4401

FINISHED DIMENSIONS
ATTACHMENT *2
Teams 2006 Page 1 Pg. 1/2

Heat Exchanger Mechanical Design

File: E-4401-7793.BJT

Date: 8/24/2007

Time: 9:37:29 AM

Bill of Materials - Finished dimensions

Num	Name	Part	Material	Qty	Dimensions			Thk.	Weight lb	Cost		
					Dim1 In	Dim2 In	lg			Labor Dollar(US)	Total Dollar(US)	
1	Shell Cylinder		SA-240 S30400 Grd Plate(G5)	1	36	od	187.25	lg	0.25	1519	365	4230
2	Fr Hd Cylinder		SA-516 K02700 Grd Plate	1	36	od	16.625	lg	0.375	199	271	362
3	Re Hd Cylinder		SA-516 K02700 Grd Plate	1	36	od	26.1875	lg	0.375	314	288	429
5	Fr Hd Cover Ellip.		SA-516 K02700 Grd Plate	1	36	od	2	sf	0.375	213	0	788
6	Re Hd Cover Ellip.		SA-516 K02700 Grd Plate	1	36	od	2	sf	0.375	213	0	788
9	Shell Lift Lugs		SA-36 K02600 Plate	3	4	od	0		1.5	7	0	4
11	Front TubSh		SA-240 S30400 Grd Plate	1	39.5	od	0		2.5	514	3740	6305
12	Rear TubSh		SA-240 S30400 Grd Plate	1	39.5	od	0		2.5	514	3740	6305
17	Fr Hd Fing TubSh		SA-516 K02700 Grd Plate	1	39.5	od	36.125	ld	2.0625	110	218	732
18	Re Hd Fing TubSh		SA-516 K02700 Grd Plate	1	39.5	od	36.125	ld	2.0625	110	218	732
31	Fr Hd Gskt TubSh		Solid Teflon 1/8in Thickness	1	37.25	od	36.125	ld	0.125	0	88	418
32	Re Hd Gskt TubSh		Solid Teflon 1/8in Thickness	1	37.25	od	36.125	ld	0.125	0	88	418
38	Tubes (min wall)		SA-249 S30400 Grd Wld. t	1127	0.75	od	192	lg	0.049	7200	1429	61904
39	Baffles		SA-240 S30400 Grd Plate	9	35.3125	od	0		0.3125	260	7839	10520
40	Tie Rods		SA-479 S30400 Grd Bar	14	0.5	od	176	lg	0	139	122	418
41	Spacers		SA-249 S30400 Grd Wld. t	104	0.75	od	33.5	lg	0.109	279	68	532
41	Spacers		SA-249 S30400 Grd Wld. t	18	0.75	od	16.75	lg	0.109	0	0	0
44	FH Partitions		SA-516 K02700 Grd Plate	2	27.8125	lg	35.25	wl	0.5	278	190	321
45	RH Partitions		SA-516 K02700 Grd Plate	1	37.375	lg	35.25	wl	0.5	373	342	518
45	RH Partitions		SA-516 K02700 Grd Plate	2	37.375	od	17.625	lg	0.5	0	0	0
51	Coupling A		SA-182 S30400 Grd Forging	1	0.5	od	0		0	0	0	7
52	Coupling B		SA-182 S30400 Grd Forging	1	0.5	od	0		0	0	0	7
53	Coupling C		SA-182 S30400 Grd Forging	1	0.75	od	0		0	1	0	13
54	Coupling D		SA-182 S30400 Grd Forging	1	0.75	od	0		0	1	0	13
61	Nozzle A		SA-312 S30400 Grd Wld. p	1	24	od	6	lg	0.375	48	103	531
62	Nozzle B		SA-312 S30400 Grd Wld. p	1	2.375	od	6	lg	0.154	2	9	25
63	Nozzle C		SA-53 K03005 Grd Wld. pipe	1	10.75	od	6	lg	0.365	20	45	59
64	Nozzle D		SA-53 K03005 Grd Wld. pipe	1	10.75	od	6	lg	0.365	20	45	59

Heat Exchanger Mechanical Design

File: E-4401-7793.BJT

Date: 8/24/2007

Time: 9:37:30 AM

65	Nozzle G	SA-312 S30400 Grd Wld. p	1	6.625	od	6	lg	0.134	5	25	67
81	Nozzle Flng A Slip On	SA-182 S30400 Grd Forging	1	150	AN	24	dl	0	185	0	1700
82	Nozzle Flng B Slip On	SA-182 S30400 Grd Forging	1	150	AN	2.375	dl	0	5	0	47
83	Nozzle Flng C Slip On	SA-105 K03504 Forgings	1	150	AN	10.75	dl	0	36	0	57
84	Nozzle Flng D Slip On	SA-105 K03504 Forgings	1	150	AN	10.75	dl	0	36	0	57
85	Nozzle Flng G Slip On	SA-182 S30400 Grd Forging	1	150	AN	6.625	dl	0	17	0	157
101	Fr Hd Blts TubSh	SA-193 G41400 Grd Bolt(<= 2	60	0.5	od	7	lg	0	23	0	58
102	Re Hd Blts TubSh	SA-193 G41400 Grd Bolt(<= 2	60	0.5	od	7	lg	0	23	0	58
115	Distrib. Belt A	SA-240 S30400 Grd Plate(G5	1	52	od	42	sf	0.5	1555	1682	7022
122	Dist.Belt An.Fng	SA-240 S30400 Grd Plate(G5	2	52		0		0.625	0	0	0

HT/DcR Engineering, Inc.
2830 Parkway Street Lakeland, FL 33811

Date Printed: 9/14/2007

CUSTOMER

Delta-T
133 Waller Mill Road
Williamsburg, VA 23185

VESSEL LOCATION

BUNGE-ERGON

VICKSBURG, MISSISSIPPI

VESSEL DESCRIPTION

PRODUCT CONDENSER

Vessel designed per the ASME Boiler & Pressure Vessel Code,
Section VIII, Division 1, 2004 Edition, 2006 Addenda
with Advanced Pressure Vessel, Version: 9.2.4
Vessel is ASME Code Stamped

Job No: 1494F

Vessel Number: 7793-E4401 Legs

NAMEPLATE INFORMATION

Vessel MAWP: 75.00 PSI and Full Vacuum at 300 °F

MDMT: -20 °F at 75.00 PSI

Serial Number(s): 4401-7793

National Board Number(s): _____

Year Built: 2007

Radiography: NONE

Postweld Heat Treated: NONE

HT/DcR Engineering, Inc.
2830 Parkway Street Lakeland, FL 33811

Date Printed: 9/14/2007



HT/DcR Engineering, Inc.

Leg 1

Customer: Delta-T
Job No: 1494F
Mark Number: LEG1

Vessel Number: 7793-E4401 Legs

Date Printed: 9/14/2007

Leg Information

Design Temperature:	300 °F	Factor B Chart:	CS-2
Material:	SA-36	Material Stress (Hot):	21600 PSI
Condition:		Material Stress (Cold):	21600 PSI
B.P. to Vessel Attachment Length (L):	73.8800 in.	Modulus of Elasticity:	28.3 10 ⁶ PSI
Direction of Applied Force:	0 °	Yield Strength:	36000 PSI
Length of Supports:	83.8800 in.	Dist. From Reference Line:	24.0000 in.
Quantity:	4	Method of Attachment:	Leg In
Type:	Angle	Molded to Head Curvature:	No
Description:		t ₁ :	0.5000 in.
d ₁ :	6.0000 in.	t ₂ :	0.5000 in.
d ₂ :	6.0000 in.	Side (W _s):	10.0000 in.
Weld Attachment Length Top (W _t):	0.0000 in.		
Weld Leg Dimension (W _l):	0.3750 in.		

Repad Information

Design Temperature:	300 °F	Material Stress (Hot):	18900 PSI
Material:	SA-240 304, High	Material Stress (Cold):	20000 PSI
Condition:		Thickness:	0.5000 in.
Height (L _{rh}):	10.0000 in.	Weld Leg (W _r):	0.3750 in.
Width (L _{rw}):	10.0000 in.		

Base Plate Information

Design Temperature:	300 °F	Material Stress (Hot):	16600 PSI
Material:	SA-36 Plate	Material Stress (Cold):	16600 PSI
Condition:		Yield Strength:	36000 PSI
Length:	8.0000 in.	Thickness:	0.5000 in.
Width:	8.0000 in.	Bending Coefficient (C _m):	1.0000
Leg to B.P. Attachment Factor:	0.7500		
Effective Length Factor (K):	1.5000		

Anchor Bolt Information

Material:	F-1554 Gr. 105	Material Stress (Hot):	39000 PSI
Condition:		Material Stress (Cold):	39000 PSI
Diameter:	0.7500 in.	Root Area:	1.2940 sq. in.
Quantity:	1	Bolt Circle Diameter:	41.0000 in.
Ultimate 28 Day Concrete Strength:	3000 PSI		

Operating Pressurized Conditions - Occasional Loads - Seismic Case 5

Support Leg Properties

$$\text{Section Modulus, } S_x = \frac{I_x}{C_x} = \frac{31.7448}{4.2426} = 7.4824 \text{ in.}^3$$

$$\text{Section Modulus, } S_y = \frac{I_y}{C_y} = \frac{8.0709}{2.3826} = 3.3874 \text{ in.}^3$$

$$\text{Radius of gyration, } r_x = \sqrt{\frac{I_x}{A}} = \sqrt{\frac{31.7448}{5.7500}} = 2.3496 \text{ in.}$$

$$\text{Radius of gyration, } r_y = \sqrt{\frac{I_y}{A}} = \sqrt{\frac{8.0709}{5.7500}} = 1.1848 \text{ in.}$$

$$\text{Least radius of gyration, } r_{\min} = \sqrt{\frac{I_{\min}}{A}} = \sqrt{\frac{8.0709}{5.7500}} = 1.1848 \text{ in.}$$

$$\text{Slenderness ratio, } SR_x = \frac{K L}{r_x} = \frac{1.5000 * 73.8800}{2.3496} = 47.1655$$

$$\text{Slenderness ratio, } SR_y = \frac{K L}{r_y} = \frac{1.5000 * 73.8800}{1.1848} = 93.5348$$

$$SR_{\max} = \frac{K L}{r_{\min}} = \frac{1.5000 * 73.8800}{1.1848} = 93.5348$$

$$\text{Critical slenderness ratio, } C_c = \sqrt{\frac{2 \pi^2 E}{F_y}} = \sqrt{\frac{2 * \pi^2 * (28.3 * 10^6)}{36000}} = 124.57$$

$$F'_{ex} = \frac{4}{3} \frac{12 \pi^2 E}{23 SR_x^2} = \frac{4}{3} * \frac{12 * \pi^2 * (28.3 * 10^6)}{23 * 47.1655^2} = 87343 \text{ PSI}$$

$$F'_{ey} = \frac{4}{3} \frac{12 \pi^2 E}{23 SR_y^2} = \frac{4}{3} * \frac{12 * \pi^2 * (28.3 * 10^6)}{23 * 93.5348^2} = 22209 \text{ PSI}$$

For $SR_{\max} \leq C_c$, Allowable compressive stress:

$$F_a = \frac{4}{3} \frac{\left(1 - \frac{SR_{\max}^2}{2 C_c^2}\right) F_y}{\frac{5}{3} + \frac{3 SR_{\max}}{8 C_c} - \frac{SR_{\max}^3}{8 C_c^3}} = \frac{4}{3} * \frac{\left(1 - \frac{93.5348^2}{2 * 124.57^2}\right) * 36000}{\frac{5}{3} + \frac{3 * 93.5348}{8 * 124.57} - \frac{93.5348^3}{8 * 124.57^3}} = 18187 \text{ PSI}$$

$$\text{Allowable bending stress : } S_b = \frac{4}{3} 0.6 F_y = \frac{4}{3} * 0.6 * 36000 = 28800 \text{ PSI}$$

$$\text{Allowable tension stress : } S_t = \frac{4}{3} 0.6 F_y = \frac{4}{3} * 0.6 * 36000 = 28800 \text{ PSI}$$

HT/DcR Engineering, Inc.

Leg 1

Vessel Number: 7793-E4401 Legs

Job No: 1494F
Mark Number: LEG1

Date Printed: 9/14/2007

Leg to Vessel Weld Properties

Distance between welds along side of legs (b) = = 7.7782 in.
 $L_w = 2 W_s = 2 * 10.0000$ = 20.0000 in.

$I_{wy} = \frac{W_s^3}{6} = \frac{10.0000^3}{6}$ = 166.6667 in.³

$I_{wz} = \frac{W_s b^2}{2} = \frac{10.0000 * 7.7782^2}{2}$ = 302.5000 in.³

$J_{wx} = I_{wy} + I_{wz} = 166.6667 + 302.5000$ = 469.1667 in.³

Distance from weld neutral axis to top/bottom of welds:

$EF_{yt} = EF_{yb} = \frac{W_s}{2} = \frac{10.0000}{2}$ = 5.0000 in.

Distance from weld neutral axis to bottom of welds:

$EF_z = \frac{b}{2} = \frac{7.7782}{2}$ = 3.8891 in.

NO Wind Analysis Information

Wind Analysis Calculations

No Wind Load Calculations were performed

IBC 2003 Seismic Design Information

Spectral Resp. Accel. at short periods (S_s):	0.200	Response Modification Factor (R):	3.000
Spectral Resp. Accel. at a period of 1 s (S_1):	0.100	Seismic Use Group:	I
		Site Class:	D
Seismic Design Category:	C		

Seismic Analysis Calculations

Seismic Center of Gravity: = 174.4404 in.

$C_s = \frac{SDS I}{R} = \frac{0.2133 * 1.00}{3.000}$ = 0.0711

$V = W * C_s = 22668.57 * 0.03$ = 1611.99 lb.

$F_s = V C_{eh} = 1611.99 * 0.70$ = 1128 lb.

HT/DcR Engineering, Inc.

Leg 1

Vessel Number: 7793-E4401 Legs

Job No: 1494F
Mark Number: LEG1

Date Printed: 9/14/2007

Loadings and Stresses on Support Legs

Direction of Applied Force = 0°

Leg Orientation °	Moment of Inertia in. ⁴	Lateral Force lb.	Axial Stress PSI	Bending Stresses (f _{bx}) PSI	Bending Stresses (f _{by}) PSI	Acceptance Ratio (Eqn ₁)	Acceptance Ratio (Eqn ₂)
0	8.0709	114	-280	0	1720	0.0751	
90	31.7448	450	-1015	3331	3973	0.3094	
180	8.0709	114	-1750	0	8720	0.3990	
270	31.7448	450	-1015	3331	3973	0.3094	

Direction of Worst case Force = 40°
Highest Stress Ratio = 0.4606

Loadings and Stresses on Leg to Vessel attachment welds

Leg Orientation °	Load F _x lb.	Load F _y lb.	Load F _z lb.	Moment M _x in.-lb.	Moment M _y in.-lb.	Moment M _z in.-lb.	Total Stress PSI	Stress Ratio
0	114	0	-1611	0	-9246	0	785	0.0636
90	0	450	-5836	24925	-10539	813	1765	0.1429
180	-114	0	-10062	0	-11833	0	1633	0.1322
270	0	450	-5836	24925	-10539	813	1765	0.1429

Direction of Worst case Force = 1°
Highest Stress Ratio: 0.1878

Repad to Shell Weld Properties

$$L_w = 2 (L_{rh} + L_{rw}) = 2 * (10.0000 + 10.0000) = 40.0000 \text{ in.}$$

$$I_{wy} = \frac{L_{rw} L_{rh}^2}{2} + \frac{L_{rh}^3}{6} = \frac{10.0000 * 10.0000^2}{2} + \frac{10.0000^3}{6} = 666.6667 \text{ in.}^3$$

$$I_{wz} = \frac{L_{rh} L_{rw}^2}{2} + \frac{L_{rw}^3}{6} = \frac{10.0000 * 10.0000^2}{2} + \frac{10.0000^3}{6} = 666.6667 \text{ in.}^3$$

$$J_{wx} = I_{wy} + I_{wz} = 666.6667 + 666.6667 = 1333.3333 \text{ in.}^3$$

Distance from weld neutral axis to top of repad:

$$EF_y = \frac{L_{rh}}{2} = \frac{10.0000}{2} = 5.0000 \text{ in.}$$

Distance from weld neutral axis to side of repad:

$$EF_z = \frac{L_{rw}}{2} = \frac{10.0000}{2} = 5.0000 \text{ in.}$$

HT/DcR Engineering, Inc.

Leg 1

Vessel Number: 7793-E4401 Legs

Job No: 1494F
Mark Number: LEG1

Date Printed: 9/14/2007

Loadings and Stresses on Repad-to-Shell Attachment Welds

Leg Orientation °	Load F _x lb.	Load F _y lb.	Load F _z lb.	Moment M _x in.-lb.	Moment M _y in.-lb.	Moment M _z in.-lb.	Total Stress PSI	Stress Ratio
0	114	0	-1611	0	-10052	0	235	0.0190
90	0	450	-5836	24925	-13457	1038	755	0.0611
180	-114	0	-10062	0	-16864	0	747	0.0605
270	0	450	-5836	24925	-13457	1038	755	0.0611

Direction of Worst case Force = 1°
Highest Stress Ratio = 0.0806

Loadings and Pressure on Concrete Foundation

Direction of applied force: = 0°

Leg Orientation °	Bearing Pressure PSI	Moment M _x in.-lb.	Moment M _y in.-lb.	Maximum Pressure P _x PSI	Maximum Pressure P _y PSI	Max. Concrete Pressure PSI	Concrete Pressure Ratio
0	25	5614	5614	65.79	65.79	156.75	0.1306
90	91	21266	21266	249.21	249.21	589.61	0.4913
180	157	13419	13419	157.25	157.25	471.73	0.3931
270	91	21266	21266	249.21	249.21	589.61	0.4913

Direction of Worst case Force: = 1°
Highest Stress Ratio = 0.6320

Loadings and Stresses on BasePlate and Anchor bolts

Leg Orientation °	Moment M _x in.-lb.	Moment M _y in.-lb.	Maximum Pressure P _x PSI	Maximum Pressure P _y PSI	Maximum B.P. Stress PSI	BasePlate Stress Ratio	Anchor Bolt Stress PSI	Anchor Bolt Stress Ratio
0	174	163	4183	3912	5727	0.1989	1064	0.0205
90	652	609	15640	14613	21405	0.7432	4114	0.0791
180	615	588	14750	14102	20407	0.7086	973	0.0187
270	652	609	15640	14613	21405	0.7432	4114	0.0791

Direction of Worst case Force: = 1°
Highest Stress Ratio = 0.9888

Maximum General Longitudinal Stresses

$VE = (C_{de} + 0.2 * SDS * I * C_{ev}) = (1.00 + 0.2 * 0.21 * 1.00 * 0.70) = 1.03$

$S_{L1} = \frac{M_a}{Z} - \frac{W VE}{A} + \left(\frac{P * D}{4 * t} \right) = \frac{113471}{256.2605} - \frac{22668.57 * 1.03}{28.47} + \left(\frac{76.96 * 36.5000}{4 * 0.2500} \right) = 2432 \text{ PSI}$

$S_{L2} = -\frac{M_a}{Z} - \frac{W VE}{A} - \left(\frac{P_e * D}{4 * t} \right) = -\frac{113471}{256.2605} - \frac{22668.57 * 1.03}{28.47} - \left(\frac{14.70 * 36.5000}{4 * 0.2500} \right) = -1799 \text{ PSI}$

Allowable Tension Stress, $S_{ta} = 1.2 S E = 1.2 * 18900 * 0.70 = 15876 \text{ PSI}$

Allowable Compressive Stress, $S_{ca} = -1.2 B = -1.2 * 8963 = -10756 \text{ PSI}$

$R_{SL1} = \frac{S_{L1}}{S_{ta}} = \frac{2432}{15876} = 0.1532$

$R_{SL2} = \frac{S_{L2}}{S_{ca}} = \frac{-1799}{-10756} = 0.1673$

Summary

Governing external force	= Seismic load
Total Force	= 1128 lb.
Weight	= 22668.57 lb.
Base Moment	= 196837 in.-lb.
Tangent Moment	= 113471 in.-lb.
Leg Stresses	
Maximum combined compressive and bending stress ratio	= 0.4606
Leg BasePlate	
Concrete Stress Ratio	= 0.6320
Base Plate Stress Ratio	= 0.9888
Host Stresses	
S11 ratio	= 0.1532
S12 ratio	= 0.1673
Weld Stresses	
Leg to vessel weld stress ratio	= 0.1878
Repad to shell weld stress ratio	= 0.0806

Operating Pressurized Conditions - Occasional Loads - Seismic Case 8

Support Leg Properties

$$\text{Section Modulus, } S_x = \frac{I_x}{C_x} = \frac{31.7448}{4.2426} = 7.4824 \text{ in.}^3$$

$$\text{Section Modulus, } S_y = \frac{I_y}{C_y} = \frac{8.0709}{2.3826} = 3.3874 \text{ in.}^3$$

$$\text{Radius of gyration, } r_x = \sqrt{\frac{I_x}{A}} = \sqrt{\frac{31.7448}{5.7500}} = 2.3496 \text{ in.}$$

$$\text{Radius of gyration, } r_y = \sqrt{\frac{I_y}{A}} = \sqrt{\frac{8.0709}{5.7500}} = 1.1848 \text{ in.}$$

$$\text{Least radius of gyration, } r_{\min} = \sqrt{\frac{I_{\min}}{A}} = \sqrt{\frac{8.0709}{5.7500}} = 1.1848 \text{ in.}$$

$$\text{Slenderness ratio, } SR_x = \frac{K L}{r_x} = \frac{1.5000 * 73.8800}{2.3496} = 47.1655$$

$$\text{Slenderness ratio, } SR_y = \frac{K L}{r_y} = \frac{1.5000 * 73.8800}{1.1848} = 93.5348$$

$$SR_{\max} = \frac{K L}{r_{\min}} = \frac{1.5000 * 73.8800}{1.1848} = 93.5348$$

$$\text{Critical slenderness ratio, } C_c = \sqrt{\frac{2 \pi^2 E}{F_y}} = \sqrt{\frac{2 * \pi^2 * (28.3 * 10^6)}{36000}} = 124.57$$

$$F'_{ex} = \frac{4}{3} \frac{12 \pi^2 E}{23 SR_x^2} = \frac{4}{3} * \frac{12 * \pi^2 * (28.3 * 10^6)}{23 * 47.1655^2} = 87343 \text{ PSI}$$

$$F'_{ey} = \frac{4}{3} \frac{12 \pi^2 E}{23 SR_y^2} = \frac{4}{3} * \frac{12 * \pi^2 * (28.3 * 10^6)}{23 * 93.5348^2} = 22209 \text{ PSI}$$

For $SR_{\max} \leq C_c$, Allowable compressive stress:

$$F_a = \frac{4}{3} \frac{\left(1 - \frac{SR_{\max}^2}{2 C_c^2}\right) F_y}{\frac{5}{3} + \frac{3 SR_{\max}}{8 C_c} - \frac{SR_{\max}^3}{8 C_c^3}} = \frac{4}{3} * \frac{\left(1 - \frac{93.5348^2}{2 * 124.57^2}\right) * 36000}{\frac{5}{3} + \frac{3 * 93.5348}{8 * 124.57} - \frac{93.5348^3}{8 * 124.57^3}} = 18187 \text{ PSI}$$

$$\text{Allowable bending stress : } S_b = \frac{4}{3} * 0.6 F_y = \frac{4}{3} * 0.6 * 36000 = 28800 \text{ PSI}$$

$$\text{Allowable tension stress : } S_t = \frac{4}{3} * 0.6 F_y = \frac{4}{3} * 0.6 * 36000 = 28800 \text{ PSI}$$

HT/DcR Engineering, Inc.

Leg 1

Vessel Number: 7793-E4401 Legs

Job No: 1494F
Mark Number: LEG1

Date Printed: 9/14/2007

Leg to Vessel Weld Properties

Distance between welds along side of legs (b) = = 7.7782 in.
 $L_w = 2 W_s = 2 * 10.0000$ = 20.0000 in.

$I_{wy} = \frac{W_s^3}{6} = \frac{10.0000^3}{6}$ = 166.6667 in.³

$I_{wz} = \frac{W_s b^2}{2} = \frac{10.0000 * 7.7782^2}{2}$ = 302.5000 in.³

$J_{wx} = I_{wy} + I_{wz} = 166.6667 + 302.5000$ = 469.1667 in.³

Distance from weld neutral axis to top/bottom of welds:

$EF_{yt} = EF_{yb} = \frac{W_s}{2} = \frac{10.0000}{2}$ = 5.0000 in.

Distance from weld neutral axis to bottom of welds:

$EF_z = \frac{b}{2} = \frac{7.7782}{2}$ = 3.8891 in.

NO Wind Analysis Information

Wind Analysis Calculations

No Wind Load Calculations were performed

IBC 2003 Seismic Design Information

Spectral Resp. Accel. at short periods (S_s):	0.200	Response Modification Factor (R):	3.000
Spectral Resp. Accel. at a period of 1 s (S_1):	0.100	Site Class:	D
Seismic Use Group:	I		
Seismic Design Category:	C		

Seismic Analysis Calculations

Seismic Center of Gravity: = 174.4404 in.

$C_s = \frac{SDS I}{R} = \frac{0.2133 * 1.00}{3.000}$ = 0.0711

$V = W * C_s = 22668.57 * 0.03$ = 1611.99 lb.

$F_s = V C_{eh} = 1611.99 * 0.70$ = 1128 lb.

HT/DcR Engineering, Inc.

Leg 1

Vessel Number: 7793-E4401 Legs

Job No: 1494F
Mark Number: LEG1

Date Printed: 9/14/2007

Loadings and Stresses on Support Legs

Direction of Applied Force = 0°

Leg Orientation °	Moment of Inertia in. ⁴	Lateral Force lb.	Axial Stress PSI	Bending Stresses (f _{bx}) PSI	Bending Stresses (f _{by}) PSI	Acceptance Ratio (Eqn ₁)	Acceptance Ratio (Eqn ₂)
0	8.0709	114	173	0	2548	0.0965	
90	31.7448	450	-562	3331	2199	0.2229	
180	8.0709	114	-1297	0	6947	0.3125	
270	31.7448	450	-562	3331	2199	0.2229	

Direction of Worst case Force = 40°
Highest Stress Ratio = 0.3741

Loadings and Stresses on Leg to Vessel attachment welds

Leg Orientation °	Load F _x lb.	Load F _y lb.	Load F _z lb.	Moment M _x in.-lb.	Moment M _y in.-lb.	Moment M _z in.-lb.	Total Stress PSI	Stress Ratio
0	114	0	995	0	-4540	0	401	0.0325
90	0	450	-3231	24925	-5835	813	1341	0.1086
180	-114	0	-7457	0	-7129	0	1139	0.0922
270	0	450	-3231	24925	-5835	813	1341	0.1086

Direction of Worst case Force = 1°
Highest Stress Ratio: 0.1501

Repad to Shell Weld Properties

$$L_w = 2 (L_{rh} + L_{rw}) = 2 * (10.0000 + 10.0000) = 40.0000 \text{ in.}$$

$$I_{wy} = \frac{L_{rw} L_{rh}^2}{2} + \frac{L_{rh}^3}{6} = \frac{10.0000 * 10.0000^2}{2} + \frac{10.0000^3}{6} = 666.6667 \text{ in.}^3$$

$$I_{wz} = \frac{L_{rh} L_{rw}^2}{2} + \frac{L_{rw}^3}{6} = \frac{10.0000 * 10.0000^2}{2} + \frac{10.0000^3}{6} = 666.6667 \text{ in.}^3$$

$$J_{wx} = I_{wy} + I_{wz} = 666.6667 + 666.6667 = 1333.3333 \text{ in.}^3$$

Distance from weld neutral axis to top of repad:

$$EF_y = \frac{L_{rh}}{2} = \frac{10.0000}{2} = 5.0000 \text{ in.}$$

Distance from weld neutral axis to side of repad:

$$EF_z = \frac{L_{rw}}{2} = \frac{10.0000}{2} = 5.0000 \text{ in.}$$

HT/DcR Engineering, Inc.

Leg 1

Vessel Number: 7793-E4401 Legs

Job No: 1494F
Mark Number: LEG1

Date Printed: 9/14/2007

Loadings and Stresses on Repad-to-Shell Attachment Welds

Leg Orientation °	Load F _x lb.	Load F _y lb.	Load F _z lb.	Moment M _x in.-lb.	Moment M _y in.-lb.	Moment M _z in.-lb.	Total Stress PSI	Stress Ratio
0	114	0	995	0	-4043	0	111	0.0090
90	0	450	-3231	24925	-7450	1038	568	0.0460
180	-114	0	-7457	0	-10858	0	539	0.0437
270	0	450	-3231	24925	-7450	1038	568	0.0460

Direction of Worst case Force = 1 °
Highest Stress Ratio = 0.0645

Loadings and Pressure on Concrete Foundation

Direction of applied force: = 0 °

Leg Orientation °	Bearing Pressure PSI	Moment M _x in.-lb.	Moment M _y in.-lb.	Maximum Pressure P _x PSI	Maximum Pressure P _y PSI	Max. Concrete Pressure PSI	Concrete Pressure Ratio
0	-16	1365	1365	16.00	16.00	16.45	0.0137
90	50	17018	17018	199.43	199.43	449.34	0.3745
180	117	9171	9171	107.47	107.47	331.46	0.2762
270	50	17018	17018	199.43	199.43	449.34	0.3745

Direction of Worst case Force: = 1 °
Highest Stress Ratio = 0.5151

Loadings and Stresses on BasePlate and Anchor bolts

Leg Orientation °	Moment M _x in.-lb.	Moment M _y in.-lb.	Maximum Pressure P _x PSI	Maximum Pressure P _y PSI	Maximum B.P. Stress PSI	BasePlate Stress Ratio	Anchor Bolt Stress PSI	Anchor Bolt Stress Ratio
0	0	0	0	0	0	0.0000	873	0.0168
90	476	441	11415	10593	15573	0.5407	3762	0.0723
180	439	420	10525	10082	14574	0.5060	557	0.0107
270	476	441	11415	10593	15573	0.5407	3762	0.0723

Direction of Worst case Force: = 1 °
Highest Stress Ratio = 0.7863

Maximum General Longitudinal Stresses

$VE = (C_{de} + 0.2 * SDS * I * C_{ev}) = (0.60 + 0.2 * 0.21 * 1.00 * -0.70) =$ 0.57

$S_{L1} = \frac{M_a}{Z} - \frac{W VE}{A} + \left(\frac{P * D}{4 * t} \right) = \frac{113471}{256.2605} - \frac{22668.57 * 0.57}{28.47} + \left(\frac{76.08 * 36.5000}{4 * 0.2500} \right) =$ 2766 PSI

$S_{L2} = -\frac{M_a}{Z} - \frac{W VE}{A} - \left(\frac{P_e * D}{4 * t} \right) = -\frac{113471}{256.2605} - \frac{22668.57 * 0.57}{28.47} - \left(\frac{14.70 * 36.5000}{4 * 0.2500} \right) =$ -1433 PSI

Allowable Tension Stress, $S_{ta} = 1.2 S E = 1.2 * 18900 * 0.70 =$ 15876 PSI

Allowable Compressive Stress, $S_{ca} = -1.2 B = -1.2 * 8963 =$ -10756 PSI

$R_{SL1} = \frac{S_{L1}}{S_{ta}} = \frac{2766}{15876} =$ 0.1742

$R_{SL2} = \frac{S_{L2}}{S_{ca}} = \frac{-1433}{-10756} =$ 0.1332

Summary

Governing external force	= Seismic load
Total Force	= 1128 lb.
Weight	= 22668.57 lb.
Base Moment	= 196837 in.-lb.
Tangent Moment	= 113471 in.-lb.
Leg Stresses	
Maximum combined compressive and bending stress ratio	= 0.3741
Leg BasePlate	
Concrete Stress Ratio	= 0.5151
Base Plate Stress Ratio	= 0.7863
Host Stresses	
SI1 ratio	= 0.1742
SI2 ratio	= 0.1332
Weld Stresses	
Leg to vessel weld stress ratio	= 0.1501
Repad to shell weld stress ratio	= 0.0645

Operating Pressurized Conditions - Occasional Loads - Wind Case 5

Support Leg Properties

$$\text{Section Modulus, } S_x = \frac{I_x}{C_x} = \frac{31.7448}{4.2426} = 7.4824 \text{ in.}^3$$

$$\text{Section Modulus, } S_y = \frac{I_y}{C_y} = \frac{8.0709}{2.3826} = 3.3874 \text{ in.}^3$$

$$\text{Radius of gyration, } r_x = \sqrt{\frac{I_x}{A}} = \sqrt{\frac{31.7448}{5.7500}} = 2.3496 \text{ in.}$$

$$\text{Radius of gyration, } r_y = \sqrt{\frac{I_y}{A}} = \sqrt{\frac{8.0709}{5.7500}} = 1.1848 \text{ in.}$$

$$\text{Least radius of gyration, } r_{\min} = \sqrt{\frac{I_{\min}}{A}} = \sqrt{\frac{8.0709}{5.7500}} = 1.1848 \text{ in.}$$

$$\text{Slenderness ratio, } SR_x = \frac{K L}{r_x} = \frac{1.5000 * 73.8800}{2.3496} = 47.1655$$

$$\text{Slenderness ratio, } SR_y = \frac{K L}{r_y} = \frac{1.5000 * 73.8800}{1.1848} = 93.5348$$

$$SR_{\max} = \frac{K L}{r_{\min}} = \frac{1.5000 * 73.8800}{1.1848} = 93.5348$$

$$\text{Critical slenderness ratio, } C_c = \sqrt{\frac{2 \pi^2 E}{F_y}} = \sqrt{\frac{2 * \pi^2 * (28.3 * 10^6)}{36000}} = 124.57$$

$$F'_{ex} = \frac{4}{3} \frac{12 \pi^2 E}{23 SR_x^2} = \frac{4}{3} * \frac{12 * \pi^2 * (28.3 * 10^6)}{23 * 47.1655^2} = 87343 \text{ PSI}$$

$$F'_{ey} = \frac{4}{3} \frac{12 \pi^2 E}{23 SR_y^2} = \frac{4}{3} * \frac{12 * \pi^2 * (28.3 * 10^6)}{23 * 93.5348^2} = 22209 \text{ PSI}$$

For $SR_{\max} \leq C_c$, Allowable compressive stress:

$$F_a = \frac{4}{3} \frac{\left(1 - \frac{SR_{\max}^2}{2 C_c^2}\right) F_y}{\frac{5}{3} + \frac{3 SR_{\max}}{8 C_c} - \frac{SR_{\max}^3}{8 C_c^3}} = \frac{4}{3} * \frac{\left(1 - \frac{93.5348^2}{2 * 124.57^2}\right) * 36000}{\frac{5}{3} + \frac{3 * 93.5348}{8 * 124.57} - \frac{93.5348^3}{8 * 124.57^3}} = 18187 \text{ PSI}$$

$$\text{Allowable bending stress : } S_b = \frac{4}{3} 0.6 F_y = \frac{4}{3} * 0.6 * 36000 = 28800 \text{ PSI}$$

$$\text{Allowable tension stress : } S_t = \frac{4}{3} 0.6 F_y = \frac{4}{3} * 0.6 * 36000 = 28800 \text{ PSI}$$

HT/DcR Engineering, Inc.

Leg 1

Vessel Number: 7793-E4401 Legs

Job No: 1494F
Mark Number: LEG1

Date Printed: 9/14/2007

Leg to Vessel Weld Properties

Distance between welds along side of legs (b) = = 7.7782 in.
 $L_w = 2 W_s = 2 * 10.0000$ = 20.0000 in.

$I_{wy} = \frac{W_s^3}{6} = \frac{10.0000^3}{6}$ = 166.6667 in.³

$I_{wz} = \frac{W_s b^2}{2} = \frac{10.0000 * 7.7782^2}{2}$ = 302.5000 in.³

$J_{wx} = I_{wy} + I_{wz} = 166.6667 + 302.5000$ = 469.1667 in.³

Distance from weld neutral axis to top/bottom of welds:

$EF_{yt} = EF_{yb} = \frac{W_s}{2} = \frac{10.0000}{2}$ = 5.0000 in.

Distance from weld neutral axis to bottom of welds:

$EF_z = \frac{b}{2} = \frac{7.7782}{2}$ = 3.8891 in.

IBC 2003 Wind Analysis Information

Basic Wind Speed (V):	90	MPH	Wind Exposure type:	C
Importance factor (I):	1.0000		Force (shape) coefficient (C _f):	0.70
Topographic Factor (K _{zt}):	1.00		Directionality Factor (K _d):	1.00

Wind Analysis Calculations

Wind Center of Gravity = 178.6462 in.

$q_z = 0.00256 K_z K_{zt} K_d V^2 I = 0.00256 * 0.85 * 1.000 * 1.00 * 90^2 * 1.0000$ = 17.626

$P = q_z G C_f = 17.626 * 0.90 * 0.70$ = 11.10 lb./ft²

Wind Load, F_w = P A C_{wi} = 11.10 * 74.7016 * 1.00 = 829 lb.

NO Seismic Design Information

Seismic Analysis Calculations

No Seismic Analysis Calculations were performed.

HT/DcR Engineering, Inc.

Leg 1

Vessel Number: 7793-E4401 Legs

Job No: 1494F
Mark Number: LEG1

Date Printed: 9/14/2007

Loadings and Stresses on Support Legs

Direction of Applied Force = 0°

Leg Orientation °	Moment of Inertia in. ⁴	Lateral Force lb.	Axial Stress PSI	Bending Stresses (f _{bx}) PSI	Bending Stresses (f _{by}) PSI	Acceptance Ratio (Eqn ₁)	Acceptance Ratio (Eqn ₂)
0	8.0709	84	-431	0	2145	0.0982	
90	31.7448	331	-986	2448	3858	0.2732	
180	8.0709	84	-1540	0	7403	0.3417	
270	31.7448	331	-986	2448	3858	0.2732	

Direction of Worst case Force = 40°
Highest Stress Ratio = 0.3860

Loadings and Stresses on Leg to Vessel attachment welds

Leg Orientation °	Load F _x lb.	Load F _y lb.	Load F _z lb.	Moment M _x in.-lb.	Moment M _y in.-lb.	Moment M _z in.-lb.	Total Stress PSI	Stress Ratio
0	84	0	-2478	0	-9132	0	812	0.0658
90	0	331	-5667	18316	-10234	598	1539	0.1246
180	-84	0	-8856	0	-11336	0	1482	0.1200
270	0	331	-5667	18316	-10234	598	1539	0.1246

Direction of Worst case Force = 1°
Highest Stress Ratio: 0.1595

Repad to Shell Weld Properties

$$L_w = 2 (L_{rh} + L_{rw}) = 2 * (10.0000 + 10.0000) = 40.0000 \text{ in.}$$

$$I_{wy} = \frac{L_{rw} L_{rh}^2}{2} + \frac{L_{rh}^3}{6} = \frac{10.0000 * 10.0000^2}{2} + \frac{10.0000^3}{6} = 666.6667 \text{ in.}^3$$

$$I_{wz} = \frac{L_{rh} L_{rw}^2}{2} + \frac{L_{rw}^3}{6} = \frac{10.0000 * 10.0000^2}{2} + \frac{10.0000^3}{6} = 666.6667 \text{ in.}^3$$

$$J_{wx} = I_{wy} + I_{wz} = 666.6667 + 666.6667 = 1333.3333 \text{ in.}^3$$

Distance from weld neutral axis to top of repad:

$$EF_y = \frac{L_{rh}}{2} = \frac{10.0000}{2} = 5.0000 \text{ in.}$$

Distance from weld neutral axis to side of repad:

$$EF_z = \frac{L_{rw}}{2} = \frac{10.0000}{2} = 5.0000 \text{ in.}$$

HT/DcR Engineering, Inc.

Leg 1

Vessel Number: 7793-E4401 Legs

Job No: 1494F
Mark Number: LEG1

Date Printed: 9/14/2007

Loadings and Stresses on Repad-to-Shell Attachment Welds

Leg Orientation °	Load F _x lb.	Load F _y lb.	Load F _z lb.	Moment M _x in.-lb.	Moment M _y in.-lb.	Moment M _z in.-lb.	Total Stress PSI	Stress Ratio
0	84	0	-2478	0	-10371	0	270	0.0219
90	0	331	-5667	18316	-13067	763	658	0.0533
180	-84	0	-8856	0	-15764	0	667	0.0540
270	0	331	-5667	18316	-13067	763	658	0.0533

Direction of Worst case Force = 1°
Highest Stress Ratio = 0.0683

Loadings and Pressure on Concrete Foundation

Direction of applied force: = 0°

Leg Orientation °	Bearing Pressure PSI	Moment M _x in.-lb.	Moment M _y in.-lb.	Maximum Pressure P _x PSI	Maximum Pressure P _y PSI	Max. Concrete Pressure PSI	Concrete Pressure Ratio
0	39	6235	6235	73.07	73.07	184.85	0.1540
90	89	17874	17874	209.46	209.46	507.47	0.4229
180	138	12244	12244	143.48	143.48	425.34	0.3545
270	89	17874	17874	209.46	209.46	507.47	0.4229

Direction of Worst case Force: = 1°
Highest Stress Ratio = 0.5292

Loadings and Stresses on BasePlate and Anchor bolts

Leg Orientation °	Moment M _x in.-lb.	Moment M _y in.-lb.	Maximum Pressure P _x PSI	Maximum Pressure P _y PSI	Maximum B.P. Stress PSI	BasePlate Stress Ratio	Anchor Bolt Stress PSI	Anchor Bolt Stress Ratio
0	216	203	5172	4871	7105	0.2467	976	0.0188
90	572	536	13729	12865	18815	0.6533	3222	0.0620
180	550	526	13210	12619	18268	0.6343	951	0.0183
270	572	536	13729	12865	18815	0.6533	3222	0.0620

Direction of Worst case Force: = 1°
Highest Stress Ratio = 0.8388

Maximum General Longitudinal Stresses

VE = C_{de} = 1.00 = 1.00

$$S_{L1} = \frac{M_a}{Z} - \frac{W VE}{A} + \left(\frac{P * D}{4 * t} \right) = \frac{86871}{256.2605} - \frac{22668.57 * 1.00}{28.47} + \left(\frac{76.90 * 36.5000}{4 * 0.2500} \right) = 2350 \text{ PSI}$$

$$S_{L2} = -\frac{M_a}{Z} - \frac{W VE}{A} - \left(\frac{P_e * D}{4 * t} \right) = -\frac{86871}{256.2605} - \frac{22668.57 * 1.00}{28.47} - \left(\frac{14.70 * 36.5000}{4 * 0.2500} \right) = -1672 \text{ PSI}$$

Allowable Tension Stress, S_{ta} = 1.2 S E = 1.2 * 18900 * 0.70 = 15876 PSI

Allowable Compressive Stress, S_{ca} = -1.2 B = -1.2 * 8963 = -10756 PSI

$$R_{SL1} = \frac{S_{L1}}{S_{ta}} = \frac{2350}{15876} = 0.1480$$

$$R_{SL2} = \frac{S_{L2}}{S_{ca}} = \frac{-1672}{-10756} = 0.1555$$

Summary

Governing external force	= Wind load
Total Force	= 829 lb.
Weight	= 22668.57 lb.
Base Moment	= 148132 in.-lb.
Tangent Moment	= 86871 in.-lb.

Leg Stresses

Maximum combined compressive and bending stress ratio	= 0.3860
--	----------

Leg BasePlate

Concrete Stress Ratio	= 0.5292
Base Plate Stress Ratio	= 0.8388

Host Stresses

SI1 ratio	= 0.1480
SI2 ratio	= 0.1555

Weld Stresses

Leg to vessel weld stress ratio	= 0.1595
Repad to shell weld stress ratio	= 0.0683

Operating Pressurized Condition - Sustained Loads

Support Leg Properties

$$\text{Section Modulus, } S_x = \frac{I_x}{C_x} = \frac{31.7448}{4.2426} = 7.4824 \text{ in.}^3$$

$$\text{Section Modulus, } S_y = \frac{I_y}{C_y} = \frac{8.0709}{2.3826} = 3.3874 \text{ in.}^3$$

$$\text{Radius of gyration, } r_x = \sqrt{\frac{I_x}{A}} = \sqrt{\frac{31.7448}{5.7500}} = 2.3496 \text{ in.}$$

$$\text{Radius of gyration, } r_y = \sqrt{\frac{I_y}{A}} = \sqrt{\frac{8.0709}{5.7500}} = 1.1848 \text{ in.}$$

$$\text{Least radius of gyration, } r_{\min} = \sqrt{\frac{I_{\min}}{A}} = \sqrt{\frac{8.0709}{5.7500}} = 1.1848 \text{ in.}$$

$$\text{Slenderness ratio, } SR_x = \frac{K L}{r_x} = \frac{1.5000 * 73.8800}{2.3496} = 47.1655$$

$$\text{Slenderness ratio, } SR_y = \frac{K L}{r_y} = \frac{1.5000 * 73.8800}{1.1848} = 93.5348$$

$$SR_{\max} = \frac{K L}{r_{\min}} = \frac{1.5000 * 73.8800}{1.1848} = 93.5348$$

$$\text{Critical slenderness ratio, } C_c = \sqrt{\frac{2 \pi^2 E}{F_y}} = \sqrt{\frac{2 * \pi^2 * (28.3 * 10^6)}{36000}} = 124.57$$

$$F'_{ex} = \frac{12 \pi^2 E}{23 SR_x^2} = \frac{12 * \pi^2 * (28.3 * 10^6)}{23 * 47.1655^2} = 65507 \text{ PSI}$$

$$F'_{ey} = \frac{12 \pi^2 E}{23 SR_y^2} = \frac{12 * \pi^2 * (28.3 * 10^6)}{23 * 93.5348^2} = 16657 \text{ PSI}$$

For $SR_{\max} \leq C_c$, Allowable compressive stress:

$$F_a = \frac{\left(1 - \frac{SR_{\max}^2}{2 C_c^2}\right) F_y}{\frac{5}{3} + \frac{3 SR_{\max}}{8 C_c} - \frac{SR_{\max}^3}{8 C_c^3}} = \frac{\left(1 - \frac{93.5348^2}{2 * 124.57^2}\right) * 36000}{\frac{5}{3} + \frac{3 * 93.5348}{8 * 124.57} - \frac{93.5348^3}{8 * 124.57^3}} = 13640 \text{ PSI}$$

Allowable bending stress : $S_b = 0.6 F_y = 0.6 * 36000 = 21600 \text{ PSI}$

Allowable tension stress : $S_t = 0.6 F_y = 0.6 * 36000 = 21600 \text{ PSI}$

Leg to Vessel Weld Properties

Distance between welds along side of legs (b) = = 7.7782 in.
 $L_w = 2 W_s = 2 * 10.0000$ = 20.0000 in.

$I_{wy} = \frac{W_s^3}{6} = \frac{10.0000^3}{6}$ = 166.6667 in.³

$I_{wz} = \frac{W_s b^2}{2} = \frac{10.0000 * 7.7782^2}{2}$ = 302.5000 in.³

$J_{wx} = I_{wy} + I_{wz} = 166.6667 + 302.5000$ = 469.1667 in.³

Distance from weld neutral axis to top/bottom of welds:

$EF_{yt} = EF_{yb} = \frac{W_s}{2} = \frac{10.0000}{2}$ = 5.0000 in.

Distance from weld neutral axis to bottom of welds:

$EF_z = \frac{b}{2} = \frac{7.7782}{2}$ = 3.8891 in.

NO Wind Analysis Information

Wind Analysis Calculations

No Wind Load Calculations were performed

NO Seismic Design Information

Seismic Analysis Calculations

No Seismic Analysis Calculations were performed.

Loadings and Stresses on Support Legs

Direction of Applied Force = 0°

Leg Orientation °	Moment of Inertia in. ⁴	Lateral Force lb.	Axial Stress PSI	Bending Stresses (f _{bx}) PSI	Bending Stresses (f _{by}) PSI	Acceptance Ratio (Eqn ₁)	Acceptance Ratio (Eqn ₂)
0	8.0709	0	-986	0	3858	0.2509	
90	31.7448	0	-986	0	3858	0.2509	
180	8.0709	0	-986	0	3858	0.2509	
270	31.7448	0	-986	0	3858	0.2509	

Direction of Worst case Force = 0°
 Highest Stress Ratio = 0.2509

HT/DcR Engineering, Inc.

Leg 1

Vessel Number: 7793-E4401 Legs

Job No: 1494F
Mark Number: LEG1

Date Printed: 9/14/2007

Loadings and Stresses on Leg to Vessel attachment welds

Leg Orientation °	Load F _x lb.	Load F _y lb.	Load F _z lb.	Moment M _x in.-lb.	Moment M _y in.-lb.	Moment M _z in.-lb.	Total Stress PSI	Stress Ratio
0	0	0	-5667	0	-10234	0	1114	0.1203
90	0	0	-5667	0	-10234	0	1114	0.1203
180	0	0	-5667	0	-10234	0	1114	0.1203
270	0	0	-5667	0	-10234	0	1114	0.1203

Direction of Worst case Force = 0 °
Highest Stress Ratio: 0.1203

Repad to Shell Weld Properties

$$L_w = 2 (L_{rh} + L_{rw}) = 2 * (10.0000 + 10.0000) = 40.0000 \text{ in.}$$

$$I_{wy} = \frac{L_{rw} L_{rh}^2}{2} + \frac{L_{rh}^3}{6} = \frac{10.0000 * 10.0000^2}{2} + \frac{10.0000^3}{6} = 666.6667 \text{ in.}^3$$

$$I_{wz} = \frac{L_{rh} L_{rw}^2}{2} + \frac{L_{rw}^3}{6} = \frac{10.0000 * 10.0000^2}{2} + \frac{10.0000^3}{6} = 666.6667 \text{ in.}^3$$

$$J_{wx} = I_{wy} + I_{wz} = 666.6667 + 666.6667 = 1333.3333 \text{ in.}^3$$

Distance from weld neutral axis to top of repad:

$$EF_y = \frac{L_{rh}}{2} = \frac{10.0000}{2} = 5.0000 \text{ in.}$$

Distance from weld neutral axis to side of repad:

$$EF_z = \frac{L_{rw}}{2} = \frac{10.0000}{2} = 5.0000 \text{ in.}$$

Loadings and Stresses on Repad-to-Shell Attachment Welds

Leg Orientation °	Load F _x lb.	Load F _y lb.	Load F _z lb.	Moment M _x in.-lb.	Moment M _y in.-lb.	Moment M _z in.-lb.	Total Stress PSI	Stress Ratio
0	0	0	-5667	0	-13067	0	459	0.0496
90	0	0	-5667	0	-13067	0	459	0.0496
180	0	0	-5667	0	-13067	0	459	0.0496
270	0	0	-5667	0	-13067	0	459	0.0496

Direction of Worst case Force = 0 °
Highest Stress Ratio = 0.0496

HT/DcR Engineering, Inc.

Leg 1

Vessel Number: 7793-E4401 Legs

Job No: 1494F
Mark Number: LEG1

Date Printed: 9/14/2007

Loadings and Pressure on Concrete Foundation

Direction of applied force: = 0°

Leg Orientation °	Bearing Pressure PSI	Moment M _x in.-lb.	Moment M _y in.-lb.	Maximum Pressure P _x PSI	Maximum Pressure P _y PSI	Max. Concrete Pressure PSI	Concrete Pressure Ratio
0	89	9240	9240	108.28	108.28	305.11	0.3390
90	89	9240	9240	108.28	108.28	305.11	0.3390
180	89	9240	9240	108.28	108.28	305.11	0.3390
270	89	9240	9240	108.28	108.28	305.11	0.3390

Direction of Worst case Force: = 0°
Highest Stress Ratio = 0.3390

Loadings and Stresses on BasePlate and Anchor bolts

Leg Orientation °	Moment M _x in.-lb.	Moment M _y in.-lb.	Maximum Pressure P _x PSI	Maximum Pressure P _y PSI	Maximum B.P. Stress PSI	BasePlate Stress Ratio	Anchor Bolt Stress PSI	Anchor Bolt Stress Ratio
0	383	364	9191	8745	12687	0.5874	936	0.0240
90	383	364	9191	8745	12687	0.5874	936	0.0240
180	383	364	9191	8745	12687	0.5874	936	0.0240
270	383	364	9191	8745	12687	0.5874	936	0.0240

Direction of Worst case Force: = 0°
Highest Stress Ratio = 0.5874

Maximum General Longitudinal Stresses

VE = 1.00 1.00

$$S_{L1} = \frac{M_a}{Z} - \frac{W VE}{A} + \left(\frac{P * D}{4 * t} \right) = \frac{0}{256.2605} - \frac{22668.57 * 1.00}{28.47} + \left(\frac{76.90 * 36.5000}{4 * 0.2500} \right) = 2011 \text{ PSI}$$

$$S_{L2} = -\frac{M_a}{Z} - \frac{W VE}{A} - \left(\frac{P_e * D}{4 * t} \right) = -\frac{0}{256.2605} - \frac{22668.57 * 1.00}{28.47} - \left(\frac{14.70 * 36.5000}{4 * 0.2500} \right) = -1333 \text{ PSI}$$

Allowable Tension Stress, S_{ta} = S E = 18900 * 0.70 = 13230 PSI
 Allowable Compressive Stress, S_{ca} = -B = -8963 PSI

$$R_{SL1} = \frac{S_{L1}}{S_{ta}} = \frac{2011}{13230} = 0.1520$$

$$R_{SL2} = \frac{S_{L2}}{S_{ca}} = \frac{-1333}{-8963} = 0.1487$$

Summary

Governing external force	= None
Total Force	= 0 lb.
Weight	= 22668.57 lb.
Base Moment	= 0 in.-lb.
Tangent Moment	= 0 in.-lb.
Leg Stresses	
Maximum combined compressive and bending stress ratio	= 0.2509
Leg BasePlate	
Concrete Stress Ratio	= 0.3390
Base Plate Stress Ratio	= 0.5874
Host Stresses	
SI1 ratio	= 0.1520
SI2 ratio	= 0.1487
Weld Stresses	
Leg to vessel weld stress ratio	= 0.1203
Repad to shell weld stress ratio	= 0.0496

Empty Pressurized Conditions - Occasional Loads - Seismic Case 8

Support Leg Properties

$$\text{Section Modulus, } S_x = \frac{I_x}{C_x} = \frac{31.7448}{4.2426} = 7.4824 \text{ in.}^3$$

$$\text{Section Modulus, } S_y = \frac{I_y}{C_y} = \frac{8.0709}{2.3826} = 3.3874 \text{ in.}^3$$

$$\text{Radius of gyration, } r_x = \sqrt{\frac{I_x}{A}} = \sqrt{\frac{31.7448}{5.7500}} = 2.3496 \text{ in.}$$

$$\text{Radius of gyration, } r_y = \sqrt{\frac{I_y}{A}} = \sqrt{\frac{8.0709}{5.7500}} = 1.1848 \text{ in.}$$

$$\text{Least radius of gyration, } r_{\min} = \sqrt{\frac{I_{\min}}{A}} = \sqrt{\frac{8.0709}{5.7500}} = 1.1848 \text{ in.}$$

$$\text{Slenderness ratio, } SR_x = \frac{K L}{r_x} = \frac{1.5000 * 73.8800}{2.3496} = 47.1655$$

$$\text{Slenderness ratio, } SR_y = \frac{K L}{r_y} = \frac{1.5000 * 73.8800}{1.1848} = 93.5348$$

$$SR_{\max} = \frac{K L}{r_{\min}} = \frac{1.5000 * 73.8800}{1.1848} = 93.5348$$

$$\text{Critical slenderness ratio, } C_c = \sqrt{\frac{2 \pi^2 E}{F_y}} = \sqrt{\frac{2 * \pi^2 * (28.3 * 10^6)}{36000}} = 124.57$$

$$F'_{ex} = \frac{4}{3} \frac{12 \pi^2 E}{23 SR_x^2} = \frac{4}{3} * \frac{12 * \pi^2 * (28.3 * 10^6)}{23 * 47.1655^2} = 87343 \text{ PSI}$$

$$F'_{ey} = \frac{4}{3} \frac{12 \pi^2 E}{23 SR_y^2} = \frac{4}{3} * \frac{12 * \pi^2 * (28.3 * 10^6)}{23 * 93.5348^2} = 22209 \text{ PSI}$$

For $SR_{\max} \leq C_c$, Allowable compressive stress:

$$F_a = \frac{4}{3} \frac{\left(1 - \frac{SR_{\max}^2}{2 C_c^2}\right) F_y}{\frac{5}{3} + \frac{3 SR_{\max}}{8 C_c} - \frac{SR_{\max}^3}{8 C_c^3}} = \frac{4}{3} * \frac{\left(1 - \frac{93.5348^2}{2 * 124.57^2}\right) * 36000}{\frac{5}{3} + \frac{3 * 93.5348}{8 * 124.57} - \frac{93.5348^3}{8 * 124.57^3}} = 18187 \text{ PSI}$$

$$\text{Allowable bending stress : } S_b = \frac{4}{3} 0.6 F_y = \frac{4}{3} * 0.6 * 36000 = 28800 \text{ PSI}$$

$$\text{Allowable tension stress : } S_t = \frac{4}{3} 0.6 F_y = \frac{4}{3} * 0.6 * 36000 = 28800 \text{ PSI}$$

HT/DcR Engineering, Inc.

Leg 1

Vessel Number: 7793-E4401 Legs

Job No: 1494F
Mark Number: LEG1

Date Printed: 9/14/2007

Leg to Vessel Weld Properties

Distance between welds along side of legs (b) = = 7.7782 in.
 $L_w = 2 W_s = 2 * 10.0000$ = 20.0000 in.

$I_{wy} = \frac{W_s^3}{6} = \frac{10.0000^3}{6}$ = 166.6667 in.³

$I_{wz} = \frac{W_s b^2}{2} = \frac{10.0000 * 7.7782^2}{2}$ = 302.5000 in.³

$J_{wx} = I_{wy} + I_{wz} = 166.6667 + 302.5000$ = 469.1667 in.³

Distance from weld neutral axis to top/bottom of welds:

$EF_{yt} = EF_{yb} = \frac{W_s}{2} = \frac{10.0000}{2}$ = 5.0000 in.

Distance from weld neutral axis to bottom of welds:

$EF_z = \frac{b}{2} = \frac{7.7782}{2}$ = 3.8891 in.

NO Wind Analysis Information

Wind Analysis Calculations

No Wind Load Calculations were performed

IBC 2003 Seismic Design Information

Spectral Resp. Accel. at short periods (S_s):	0.200	Response Modification Factor (R):	3.000
Spectral Resp. Accel. at a period of 1 s (S_1):	0.100	Site Class:	D
Seismic Use Group:	I		
Seismic Design Category:	C		

Seismic Analysis Calculations

Seismic Center of Gravity: = 179.4448 in.

$C_s = \frac{SDS I}{R} = \frac{0.2133 * 1.00}{3.000}$ = 0.0711

$V = W * C_s = 14283.61 * 0.07$ = 1015.72 lb.

$F_s = V C_{eh} = 1015.72 * 0.70$ = 711 lb.

HT/DcR Engineering, Inc.

Leg 1

Vessel Number: 7793-E4401 Legs

Job No: 1494F
Mark Number: LEG1

Date Printed: 9/14/2007

Loadings and Stresses on Support Legs

Direction of Applied Force = 0°

Leg Orientation °	Moment of Inertia in. ⁴	Lateral Force lb.	Axial Stress PSI	Bending Stresses (f _{bx}) PSI	Bending Stresses (f _{by}) PSI	Acceptance Ratio (Eqn ₁)	Acceptance Ratio (Eqn ₂)
0	8.0709	72	124	0	1663	0.0635	
90	31.7448	283	-354	2099	1386	0.1405	
180	8.0709	72	-832	0	4435	0.1997	
270	31.7448	283	-354	2099	1386	0.1405	

Direction of Worst case Force = 41°
Highest Stress Ratio = 0.2376

Loadings and Stresses on Leg to Vessel attachment welds

Leg Orientation °	Load F _x lb.	Load F _y lb.	Load F _z lb.	Moment M _x in.-lb.	Moment M _y in.-lb.	Moment M _z in.-lb.	Total Stress PSI	Stress Ratio
0	72	0	712	0	-2707	0	245	0.0198
90	0	283	-2036	15705	-3677	511	845	0.0684
180	-72	0	-4784	0	-4646	0	733	0.0594
270	0	283	-2036	15705	-3677	511	845	0.0684

Direction of Worst case Force = 1°
Highest Stress Ratio: 0.0956

Repad to Shell Weld Properties

$$L_w = 2 (L_{rh} + L_{rw}) = 2 * (10.0000 + 10.0000) = 40.0000 \text{ in.}$$

$$I_{wy} = \frac{L_{rw} L_{rh}^2}{2} + \frac{L_{rh}^3}{6} = \frac{10.0000 * 10.0000^2}{2} + \frac{10.0000^3}{6} = 666.6667 \text{ in.}^3$$

$$I_{wz} = \frac{L_{rh} L_{rw}^2}{2} + \frac{L_{rw}^3}{6} = \frac{10.0000 * 10.0000^2}{2} + \frac{10.0000^3}{6} = 666.6667 \text{ in.}^3$$

$$J_{wx} = I_{wy} + I_{wz} = 666.6667 + 666.6667 = 1333.3333 \text{ in.}^3$$

Distance from weld neutral axis to top of repad:

$$EF_y = \frac{L_{rh}}{2} = \frac{10.0000}{2} = 5.0000 \text{ in.}$$

Distance from weld neutral axis to side of repad:

$$EF_z = \frac{L_{rw}}{2} = \frac{10.0000}{2} = 5.0000 \text{ in.}$$

HT/DcR Engineering, Inc.

Leg 1

Vessel Number: 7793-E4401 Legs

Job No: 1494F
Mark Number: LEG1

Date Printed: 9/14/2007

Loadings and Stresses on Repad-to-Shell Attachment Welds

Leg Orientation °	Load F _x lb.	Load F _y lb.	Load F _z lb.	Moment M _x in.-lb.	Moment M _y in.-lb.	Moment M _z in.-lb.	Total Stress PSI	Stress Ratio
0	72	0	712	0	-2351	0	70	0.0057
90	0	283	-2036	15705	-4695	653	358	0.0290
180	-72	0	-4784	0	-7038	0	347	0.0281
270	0	283	-2036	15705	-4695	653	358	0.0290

Direction of Worst case Force = 1°
Highest Stress Ratio = 0.0411

Loadings and Pressure on Concrete Foundation

Direction of applied force: = 0°

Leg Orientation °	Bearing Pressure PSI	Moment M _x in.-lb.	Moment M _y in.-lb.	Maximum Pressure P _x PSI	Maximum Pressure P _y PSI	Max. Concrete Pressure PSI	Concrete Pressure Ratio
0	-11	721	721	8.45	8.45	5.77	0.0048
90	32	10723	10723	125.66	125.66	283.13	0.2359
180	75	5918	5918	69.35	69.35	213.45	0.1779
270	32	10723	10723	125.66	125.66	283.13	0.2359

Direction of Worst case Force: = 1°
Highest Stress Ratio = 0.3275

Loadings and Stresses on BasePlate and Anchor bolts

Leg Orientation °	Moment M _x in.-lb.	Moment M _y in.-lb.	Maximum Pressure P _x PSI	Maximum Pressure P _y PSI	Maximum B.P. Stress PSI	BasePlate Stress Ratio	Anchor Bolt Stress PSI	Anchor Bolt Stress Ratio
0	0	0	0	0	0	0.0000	575	0.0111
90	300	278	7193	6675	9813	0.3407	2371	0.0456
180	282	270	6770	6484	9374	0.3255	365	0.0070
270	300	278	7193	6675	9813	0.3407	2371	0.0456

Direction of Worst case Force: = 1°
Highest Stress Ratio = 0.5006

Maximum General Longitudinal Stresses

$$VE = (C_{de} + 0.2 * SDS * I * C_{ev}) = (0.60 + 0.2 * 0.21 * 1.00 * -0.70) = \quad \quad \quad 0.57$$

$$S_{L1} = \frac{M_a}{Z} - \frac{W VE}{A} + \left(\frac{P * D}{4 * t} \right) = \frac{75057}{256.2605} - \frac{14283.61 * 0.57}{28.47} + \left(\frac{75.00 * 36.5000}{4 * 0.2500} \right) = 2744 \text{ PSI}$$

$$S_{L2} = -\frac{M_a}{Z} - \frac{W VE}{A} - \left(\frac{Pe * D}{4 * t} \right) = -\frac{75057}{256.2605} - \frac{14283.61 * 0.57}{28.47} - \left(\frac{14.70 * 36.5000}{4 * 0.2500} \right) = -1115 \text{ PSI}$$

$$\text{Allowable Tension Stress, } S_{ta} = 1.2 SE = 1.2 * 18900 * 0.70 = 15876 \text{ PSI}$$

$$\text{Allowable Compressive Stress, } S_{ca} = -1.2 B = -1.2 * 8963 = -10756 \text{ PSI}$$

$$R_{SL1} = \frac{S_{L1}}{S_{ta}} = \frac{2744}{15876} = 0.1728$$

$$R_{SL2} = \frac{S_{L2}}{S_{ca}} = \frac{-1115}{-10756} = 0.1037$$

Summary

Governing external force	= Seismic load
Total Force	= 711 lb.
Weight	= 14283.61 lb.
Base Moment	= 127586 in.-lb.
Tangent Moment	= 75057 in.-lb.
Leg Stresses	
Maximum combined compressive and bending stress ratio	= 0.2376
Leg BasePlate	
Concrete Stress Ratio	= 0.3275
Base Plate Stress Ratio	= 0.5006
Host Stresses	
S11 ratio	= 0.1728
S12 ratio	= 0.1037
Weld Stresses	
Leg to vessel weld stress ratio	= 0.0956
Repad to shell weld stress ratio	= 0.0411

Empty Pressurized Conditions - Occasional Loads - Wind Case 7

Support Leg Properties

$$\text{Section Modulus, } S_x = \frac{I_x}{C_x} = \frac{31.7448}{4.2426} = 7.4824 \text{ in.}^3$$

$$\text{Section Modulus, } S_y = \frac{I_y}{C_y} = \frac{8.0709}{2.3826} = 3.3874 \text{ in.}^3$$

$$\text{Radius of gyration, } r_x = \sqrt{\frac{I_x}{A}} = \sqrt{\frac{31.7448}{5.7500}} = 2.3496 \text{ in.}$$

$$\text{Radius of gyration, } r_y = \sqrt{\frac{I_y}{A}} = \sqrt{\frac{8.0709}{5.7500}} = 1.1848 \text{ in.}$$

$$\text{Least radius of gyration, } r_{\min} = \sqrt{\frac{I_{\min}}{A}} = \sqrt{\frac{8.0709}{5.7500}} = 1.1848 \text{ in.}$$

$$\text{Slenderness ratio, } SR_x = \frac{K L}{r_x} = \frac{1.5000 * 73.8800}{2.3496} = 47.1655$$

$$\text{Slenderness ratio, } SR_y = \frac{K L}{r_y} = \frac{1.5000 * 73.8800}{1.1848} = 93.5348$$

$$SR_{\max} = \frac{K L}{r_{\min}} = \frac{1.5000 * 73.8800}{1.1848} = 93.5348$$

$$\text{Critical slenderness ratio, } C_c = \sqrt{\frac{2 \pi^2 E}{F_y}} = \sqrt{\frac{2 * \pi^2 * (28.3 * 10^6)}{36000}} = 124.57$$

$$F'_{ex} = \frac{4}{3} \frac{12 \pi^2 E}{23 SR_x^2} = \frac{4}{3} * \frac{12 * \pi^2 * (28.3 * 10^6)}{23 * 47.1655^2} = 87343 \text{ PSI}$$

$$F'_{ey} = \frac{4}{3} \frac{12 \pi^2 E}{23 SR_y^2} = \frac{4}{3} * \frac{12 * \pi^2 * (28.3 * 10^6)}{23 * 93.5348^2} = 22209 \text{ PSI}$$

For $SR_{\max} \leq C_c$, Allowable compressive stress:

$$F_a = \frac{4}{3} \frac{\left(1 - \frac{SR_{\max}^2}{2 C_c^2}\right) F_y}{\frac{5}{3} + \frac{3 SR_{\max}}{8 C_c} - \frac{SR_{\max}^3}{8 C_c^3}} = \frac{4}{3} * \frac{\left(1 - \frac{93.5348^2}{2 * 124.57^2}\right) * 36000}{\frac{5}{3} + \frac{3 * 93.5348}{8 * 124.57} - \frac{93.5348^3}{8 * 124.57^3}} = 18187 \text{ PSI}$$

$$\text{Allowable bending stress : } S_b = \frac{4}{3} * 0.6 F_y = \frac{4}{3} * 0.6 * 36000 = 28800 \text{ PSI}$$

$$\text{Allowable tension stress : } S_t = \frac{4}{3} * 0.6 F_y = \frac{4}{3} * 0.6 * 36000 = 28800 \text{ PSI}$$

HT/DcR Engineering, Inc.

Leg 1

Vessel Number: 7793-E4401 Legs

Job No: 1494F
Mark Number: LEG1

Date Printed: 9/14/2007

Leg to Vessel Weld Properties

Distance between welds along side of legs (b) = = 7.7782 in.
 $L_w = 2 W_s = 2 * 10.0000$ = 20.0000 in.

$I_{wy} = \frac{W_s^3}{6} = \frac{10.0000^3}{6}$ = 166.6667 in.³

$I_{wz} = \frac{W_s b^2}{2} = \frac{10.0000 * 7.7782^2}{2}$ = 302.5000 in.³

$J_{wx} = I_{wy} + I_{wz} = 166.6667 + 302.5000$ = 469.1667 in.³

Distance from weld neutral axis to top/bottom of welds:

$EF_{yt} = EF_{yb} = \frac{W_s}{2} = \frac{10.0000}{2}$ = 5.0000 in.

Distance from weld neutral axis to bottom of welds:

$EF_z = \frac{b}{2} = \frac{7.7782}{2}$ = 3.8891 in.

IBC 2003 Wind Analysis Information

Basic Wind Speed (V):	90	MPH	Wind Exposure type:	C
Importance factor (I):	1.0000		Force (shape) coefficient (C _f):	0.70
Topographic Factor (K _{zt}):	1.00		Directionality Factor (K _d):	1.00

Wind Analysis Calculations

Wind Center of Gravity = 178.6462 in.

$q_z = 0.00256 K_z K_{zt} K_d V^2 I = 0.00256 * 0.85 * 1.000 * 1.00 * 90^2 * 1.0000$ = 17.626

$P = q_z G C_f = 17.626 * 0.90 * 0.70$ = 11.10 lb./ft²

Wind Load, F_w = P A C_{wi} = 11.10 * 74.7016 * 1.00 = 829 lb.

NO Seismic Design Information

Seismic Analysis Calculations

No Seismic Analysis Calculations were performed.

HT/DcR Engineering, Inc.

Leg 1

Vessel Number: 7793-E4401 Legs

Job No: 1494F
Mark Number: LEG1

Date Printed: 9/14/2007

Loadings and Stresses on Support Legs

Direction of Applied Force = 0°

Leg Orientation °	Moment of Inertia in. ⁴	Lateral Force lb.	Axial Stress PSI	Bending Stresses (f _{bx}) PSI	Bending Stresses (f _{by}) PSI	Acceptance Ratio (Eqn ₁)	Acceptance Ratio (Eqn ₂)
0	8.0709	84	182	0	2087	0.0809	
90	31.7448	331	-373	2448	1459	0.1562	
180	8.0709	84	-927	0	5004	0.2247	
270	31.7448	331	-373	2448	1459	0.1562	

Direction of Worst case Force = 40°
Highest Stress Ratio = 0.2690

Loadings and Stresses on Leg to Vessel attachment welds

Leg Orientation °	Load F _x lb.	Load F _y lb.	Load F _z lb.	Moment M _x in.-lb.	Moment M _y in.-lb.	Moment M _z in.-lb.	Total Stress PSI	Stress Ratio
0	84	0	1047	0	-2766	0	271	0.0219
90	0	331	-2143	18316	-3870	598	951	0.0770
180	-84	0	-5332	0	-4972	0	809	0.0655
270	0	331	-2143	18316	-3870	598	951	0.0770

Direction of Worst case Force = 1°
Highest Stress Ratio: 0.1080

Repad to Shell Weld Properties

$$L_w = 2 (L_{rh} + L_{rw}) = 2 * (10.0000 + 10.0000) = 40.0000 \text{ in.}$$

$$I_{wy} = \frac{L_{rw} L_{rh}^2}{2} + \frac{L_{rh}^3}{6} = \frac{10.0000 * 10.0000^2}{2} + \frac{10.0000^3}{6} = 666.6667 \text{ in.}^3$$

$$I_{wz} = \frac{L_{rh} L_{rw}^2}{2} + \frac{L_{rw}^3}{6} = \frac{10.0000 * 10.0000^2}{2} + \frac{10.0000^3}{6} = 666.6667 \text{ in.}^3$$

$$J_{wx} = I_{wy} + I_{wz} = 666.6667 + 666.6667 = 1333.3333 \text{ in.}^3$$

Distance from weld neutral axis to top of repad:

$$EF_y = \frac{L_{rh}}{2} = \frac{10.0000}{2} = 5.0000 \text{ in.}$$

Distance from weld neutral axis to side of repad:

$$EF_z = \frac{L_{rw}}{2} = \frac{10.0000}{2} = 5.0000 \text{ in.}$$

HT/DcR Engineering, Inc.

Leg 1

Vessel Number: 7793-E4401 Legs

Job No: 1494F
Mark Number: LEG1

Date Printed: 9/14/2007

Loadings and Stresses on Repad-to-Shell Attachment Welds

Leg Orientation °	Load F _x lb.	Load F _y lb.	Load F _z lb.	Moment M _x in.-lb.	Moment M _y in.-lb.	Moment M _z in.-lb.	Total Stress PSI	Stress Ratio
0	84	0	1047	0	-2243	0	86	0.0070
90	0	331	-2143	18316	-4941	763	402	0.0326
180	-84	0	-5332	0	-7638	0	385	0.0312
270	0	331	-2143	18316	-4941	763	402	0.0326

Direction of Worst case Force = 1 °
Highest Stress Ratio = 0.0464

Loadings and Pressure on Concrete Foundation

Direction of applied force: = 0 °

Leg Orientation °	Bearing Pressure PSI	Moment M _x in.-lb.	Moment M _y in.-lb.	Maximum Pressure P _x PSI	Maximum Pressure P _y PSI	Max. Concrete Pressure PSI	Concrete Pressure Ratio
0	-16	488	488	5.72	5.72	0.00	0.0000
90	33	12128	12128	142.13	142.13	317.73	0.2648
180	83	6498	6498	76.15	76.15	235.61	0.1963
270	33	12128	12128	142.13	142.13	317.73	0.2648

Direction of Worst case Force: = 1 °
Highest Stress Ratio = 0.3710

Loadings and Stresses on BasePlate and Anchor bolts

Leg Orientation °	Moment M _x in.-lb.	Moment M _y in.-lb.	Maximum Pressure P _x PSI	Maximum Pressure P _y PSI	Maximum B.P. Stress PSI	BasePlate Stress Ratio	Anchor Bolt Stress PSI	Anchor Bolt Stress Ratio
0	0	0	0	0	0	0.0000	566	0.0109
90	334	309	8013	7427	10926	0.3794	2735	0.0526
180	312	299	7494	7180	10379	0.3604	386	0.0074
270	334	309	8013	7427	10926	0.3794	2735	0.0526

Direction of Worst case Force: = 1 °
Highest Stress Ratio = 0.5648

Maximum General Longitudinal Stresses

VE = C_{de} = 0.60 = 0.60

$$S_{L1} = \frac{M_a}{Z} - \frac{W VE}{A} + \left(\frac{P * D}{4 * t} \right) = \frac{86871}{256.2605} - \frac{14283.61 * 0.60}{28.47} + \left(\frac{75.00 * 36.5000}{4 * 0.2500} \right) = 2775 \text{ PSI}$$

$$S_{L2} = -\frac{M_a}{Z} - \frac{W VE}{A} - \left(\frac{P_e * D}{4 * t} \right) = -\frac{86871}{256.2605} - \frac{14283.61 * 0.60}{28.47} - \left(\frac{14.70 * 36.5000}{4 * 0.2500} \right) = -1177 \text{ PSI}$$

Allowable Tension Stress, S_{ta} = 1.2 S E = 1.2 * 18900 * 0.70 = 15876 PSI

Allowable Compressive Stress, S_{ca} = -1.2 B = -1.2 * 8963 = -10756 PSI

$$R_{SL1} = \frac{S_{L1}}{S_{ta}} = \frac{2775}{15876} = 0.1748$$

$$R_{SL2} = \frac{S_{L2}}{S_{ca}} = \frac{-1177}{-10756} = 0.1094$$

Summary

Governing external force	= Wind load
Total Force	= 829 lb.
Weight	= 14283.61 lb.
Base Moment	= 148132 in.-lb.
Tangent Moment	= 86871 in.-lb.
Leg Stresses	
Maximum combined compressive and bending stress ratio	= 0.2690
Leg BasePlate	
Concrete Stress Ratio	= 0.3710
Base Plate Stress Ratio	= 0.5648
Host Stresses	
S1 ratio	= 0.1748
S12 ratio	= 0.1094
Weld Stresses	
Leg to vessel weld stress ratio	= 0.1080
Repad to shell weld stress ratio	= 0.0464

Empty Pressurized Condition - Sustained Loads

Support Leg Properties

$$\text{Section Modulus, } S_x = \frac{I_x}{C_x} = \frac{31.7448}{4.2426} = 7.4824 \text{ in.}^3$$

$$\text{Section Modulus, } S_y = \frac{I_y}{C_y} = \frac{8.0709}{2.3826} = 3.3874 \text{ in.}^3$$

$$\text{Radius of gyration, } r_x = \sqrt{\frac{I_x}{A}} = \sqrt{\frac{31.7448}{5.7500}} = 2.3496 \text{ in.}$$

$$\text{Radius of gyration, } r_y = \sqrt{\frac{I_y}{A}} = \sqrt{\frac{8.0709}{5.7500}} = 1.1848 \text{ in.}$$

$$\text{Least radius of gyration, } r_{\min} = \sqrt{\frac{I_{\min}}{A}} = \sqrt{\frac{8.0709}{5.7500}} = 1.1848 \text{ in.}$$

$$\text{Slenderness ratio, } SR_x = \frac{K L}{r_x} = \frac{1.5000 * 73.8800}{2.3496} = 47.1655$$

$$\text{Slenderness ratio, } SR_y = \frac{K L}{r_y} = \frac{1.5000 * 73.8800}{1.1848} = 93.5348$$

$$SR_{\max} = \frac{K L}{r_{\min}} = \frac{1.5000 * 73.8800}{1.1848} = 93.5348$$

$$\text{Critical slenderness ratio, } C_c = \sqrt{\frac{2 \pi^2 E}{F_y}} = \sqrt{\frac{2 * \pi^2 * (28.3 * 10^6)}{36000}} = 124.57$$

$$F'_{ex} = \frac{12 \pi^2 E}{23 SR_x^2} = \frac{12 * \pi^2 * (28.3 * 10^6)}{23 * 47.1655^2} = 65507 \text{ PSI}$$

$$F'_{ey} = \frac{12 \pi^2 E}{23 SR_y^2} = \frac{12 * \pi^2 * (28.3 * 10^6)}{23 * 93.5348^2} = 16657 \text{ PSI}$$

For $SR_{\max} \leq C_c$, Allowable compressive stress:

$$F_a = \frac{\left(1 - \frac{SR_{\max}^2}{2 C_c^2}\right) F_y}{\frac{5}{3} + \frac{3 SR_{\max}}{8 C_c} - \frac{SR_{\max}^3}{8 C_c^3}} = \frac{\left(1 - \frac{93.5348^2}{2 * 124.57^2}\right) * 36000}{\frac{5}{3} + \frac{3 * 93.5348}{8 * 124.57} - \frac{93.5348^3}{8 * 124.57^3}} = 13640 \text{ PSI}$$


$$\text{Allowable bending stress : } S_b = 0.6 F_y = 0.6 * 36000 = 21600 \text{ PSI}$$

$$\text{Allowable tension stress : } S_t = 0.6 F_y = 0.6 * 36000 = 21600 \text{ PSI}$$

HT/DcR Engineering, Inc.

Leg 1

Vessel Number: 7793-E4401 Legs

Job No: 1494F
Mark Number: LEG1

Date Printed: 9/14/2007

Leg to Vessel Weld Properties

Distance between welds along side of legs (b) = = 7.7782 in.
 $L_w = 2 W_s = 2 * 10.0000$ = 20.0000 in.

$I_{wy} = \frac{W_s^3}{6} = \frac{10.0000^3}{6}$ = 166.6667 in.³

$I_{wz} = \frac{W_s b^2}{2} = \frac{10.0000 * 7.7782^2}{2}$ = 302.5000 in.³

$J_{wx} = I_{wy} + I_{wz} = 166.6667 + 302.5000$ = 469.1667 in.³

Distance from weld neutral axis to top/bottom of welds:

$EF_{yt} = EF_{yb} = \frac{W_s}{2} = \frac{10.0000}{2}$ = 5.0000 in.

Distance from weld neutral axis to bottom of welds:

$EF_z = \frac{b}{2} = \frac{7.7782}{2}$ = 3.8891 in.

NO Wind Analysis Information

Wind Analysis Calculations

No Wind Load Calculations were performed

NO Seismic Design Information

Seismic Analysis Calculations

No Seismic Analysis Calculations were performed.

Loadings and Stresses on Support Legs

Direction of Applied Force = 0 °

Leg Orientation °	Moment of Inertia in. ⁴	Lateral Force lb.	Axial Stress PSI	Bending Stresses (f _{bx}) PSI	Bending Stresses (f _{by}) PSI	Acceptance Ratio (Eqn ₁)	Acceptance Ratio (Eqn ₂)
0	8.0709	0	-621	0	2431	0.1581	
90	31.7448	0	-621	0	2431	0.1581	
180	8.0709	0	-621	0	2431	0.1581	
270	31.7448	0	-621	0	2431	0.1581	

Direction of Worst case Force = 0 °
 Highest Stress Ratio = 0.1581

HT/DcR Engineering, Inc.

Leg 1

Job No: 1494F
Mark Number: LEG1

Vessel Number: 7793-E4401 Legs

Date Printed: 9/14/2007

Loadings and Stresses on Leg to Vessel attachment welds

Leg Orientation °	Load F _x lb.	Load F _y lb.	Load F _z lb.	Moment M _x in.-lb.	Moment M _y in.-lb.	Moment M _z in.-lb.	Total Stress PSI	Stress Ratio
0	0	0	-3571	0	-6449	0	702	0.0758
90	0	0	-3571	0	-6449	0	702	0.0758
180	0	0	-3571	0	-6449	0	702	0.0758
270	0	0	-3571	0	-6449	0	702	0.0758

Direction of Worst case Force = 0 °
Highest Stress Ratio: 0.0758

Repad to Shell Weld Properties

$$L_w = 2 (L_{rh} + L_{rw}) = 2 * (10.0000 + 10.0000) = 40.0000 \text{ in.}$$

$$I_{wy} = \frac{L_{rw} L_{rh}^2}{2} + \frac{L_{rh}^3}{6} = \frac{10.0000 * 10.0000^2}{2} + \frac{10.0000^3}{6} = 666.6667 \text{ in.}^3$$

$$I_{wz} = \frac{L_{rh} L_{rw}^2}{2} + \frac{L_{rw}^3}{6} = \frac{10.0000 * 10.0000^2}{2} + \frac{10.0000^3}{6} = 666.6667 \text{ in.}^3$$

$$J_{wx} = I_{wy} + I_{wz} = 666.6667 + 666.6667 = 1333.3333 \text{ in.}^3$$

Distance from weld neutral axis to top of repad:

$$EF_y = \frac{L_{rh}}{2} = \frac{10.0000}{2} = 5.0000 \text{ in.}$$

Distance from weld neutral axis to side of repad:

$$EF_z = \frac{L_{rw}}{2} = \frac{10.0000}{2} = 5.0000 \text{ in.}$$

Loadings and Stresses on Repad-to-Shell Attachment Welds

Leg Orientation °	Load F _x lb.	Load F _y lb.	Load F _z lb.	Moment M _x in.-lb.	Moment M _y in.-lb.	Moment M _z in.-lb.	Total Stress PSI	Stress Ratio
0	0	0	-3571	0	-8234	0	289	0.0312
90	0	0	-3571	0	-8234	0	289	0.0312
180	0	0	-3571	0	-8234	0	289	0.0312
270	0	0	-3571	0	-8234	0	289	0.0312

Direction of Worst case Force = 0 °
Highest Stress Ratio = 0.0312

HT/DcR Engineering, Inc.

Leg 1

Vessel Number: 7793-E4401 Legs

Job No: 1494F
Mark Number: LEG1

Date Printed: 9/14/2007

Loadings and Pressure on Concrete Foundation

Direction of applied force: = 0°

Leg Orientation °	Bearing Pressure PSI	Moment M _x in.-lb.	Moment M _y in.-lb.	Maximum Pressure P _x PSI	Maximum Pressure P _y PSI	Max. Concrete Pressure PSI	Concrete Pressure Ratio
0	56	5822	5822	68.23	68.23	192.25	0.2136
90	56	5822	5822	68.23	68.23	192.25	0.2136
180	56	5822	5822	68.23	68.23	192.25	0.2136
270	56	5822	5822	68.23	68.23	192.25	0.2136

Direction of Worst case Force: = 0°
Highest Stress Ratio = 0.2136

Loadings and Stresses on BasePlate and Anchor bolts

Leg Orientation °	Moment M _x in.-lb.	Moment M _y in.-lb.	Maximum Pressure P _x PSI	Maximum Pressure P _y PSI	Maximum B.P. Stress PSI	BasePlate Stress Ratio	Anchor Bolt Stress PSI	Anchor Bolt Stress Ratio
0	241	230	5792	5510	7994	0.3701	589	0.0151
90	241	230	5792	5510	7994	0.3701	589	0.0151
180	241	230	5792	5510	7994	0.3701	589	0.0151
270	241	230	5792	5510	7994	0.3701	589	0.0151

Direction of Worst case Force: = 0°
Highest Stress Ratio = 0.3701

Maximum General Longitudinal Stresses

VE = 1.00 1.00

$$S_{L1} = \frac{M_a}{Z} - \frac{W VE}{A} + \left(\frac{P \cdot D}{4 \cdot t} \right) = \frac{0}{256.2605} - \frac{14283.61 \cdot 1.00}{28.47} + \left(\frac{75.00 \cdot 36.5000}{4 \cdot 0.2500} \right) = 2236 \text{ PSI}$$

$$S_{L2} = -\frac{M_a}{Z} - \frac{W VE}{A} - \left(\frac{P_e \cdot D}{4 \cdot t} \right) = -\frac{0}{256.2605} - \frac{14283.61 \cdot 1.00}{28.47} - \left(\frac{14.70 \cdot 36.5000}{4 \cdot 0.2500} \right) = -1038 \text{ PSI}$$

Allowable Tension Stress, S_{ta} = S E = 18900 * 0.70 = 13230 PSI

Allowable Compressive Stress, S_{ca} = -B = -8963 = -8963 PSI

$$R_{SL1} = \frac{S_{L1}}{S_{ta}} = \frac{2236}{13230} = 0.1690$$

$$R_{SL2} = \frac{S_{L2}}{S_{ca}} = \frac{-1038}{-8963} = 0.1158$$

Summary

Governing external force	= None
Total Force	= 0 lb.
Weight	= 14283.61 lb.
Base Moment	= 0 in.-lb.
Tangent Moment	= 0 in.-lb.
Leg Stresses	
Maximum combined compressive and bending stress ratio	= 0.1581
Leg BasePlate	
Concrete Stress Ratio	= 0.2136
Base Plate Stress Ratio	= 0.3701
Host Stresses	
SI1 ratio	= 0.1690
SI2 ratio	= 0.1158
Weld Stresses	
Leg to vessel weld stress ratio	= 0.0758
Repad to shell weld stress ratio	= 0.0312

HT/DcR Engineering, Inc.
Customer: Delta-T Job No: 1494F
Vessel Number: 7793-E4401 Legs
Date Printed: 9/14/2007

Loading Summary						
Type	Starting Elevation (in.)	Ending Elevation (in.)	Density (lb./Ft ³)	Thickness (in.)	Wind Diameter (in.)	Wind Pressure (lb./ft. ²)
Liquid	32.0000	280.0000	62.4000	-	-	-
Insulation	0.0000	0.0000	-	-	-	-
Wind	32.0000	290.0000	-	-	42.0000	-

Attachment Summary					
Attachment No.	Elevation (in.)	Description	Attachment Weight (lb.)	Horizontal Force (lb.)	Attachment Moment (in.-lb.)
1	180.0000	BUNDLE PLUS	12000.00	0	0

Customer: Delta-T
Job No: 1494F

HT/DcR Engineering, Inc.

Vessel Number: 7793-E4401 Legs

Date Printed: 9/14/2007

Summary Information

	<u>Dry Weight</u>	<u>Flooded Weight</u>
Shell	1981.56 lb.	10817.27 lb.
Head	302.05 lb.	890.11 lb.
Totals	<hr/> 2283.61 lb.	<hr/> 11707.38 lb.
	<u>Volume</u>	
Shell	1057.65 Gal.	
Head	70.51 Gal.	
Totals	<hr/> 1128.16 Gal.	
	<u>Area</u>	
Shell	191.11 Sq. Ft.	
Head	23.13 Sq. Ft.	
Totals	<hr/> 214.24 Sq. Ft.	

Hydrostatic Test Information (UG-99)

Gauge at Top

Component with controlling ratio is : Shell 1
Component with controlling pressure is : Shell 1

$$\text{Calculated Test Pressure} = P * 1.3 * \frac{\text{Cold Stress}}{\text{Hot Stress}} = 75.00 * 1.3 * \frac{20000}{18900} = 103.17 \text{ PSI}$$

Table of Contents

eg Information	1
ttachment/Loading Information	37
ummary Information	38