



Dimensions: in

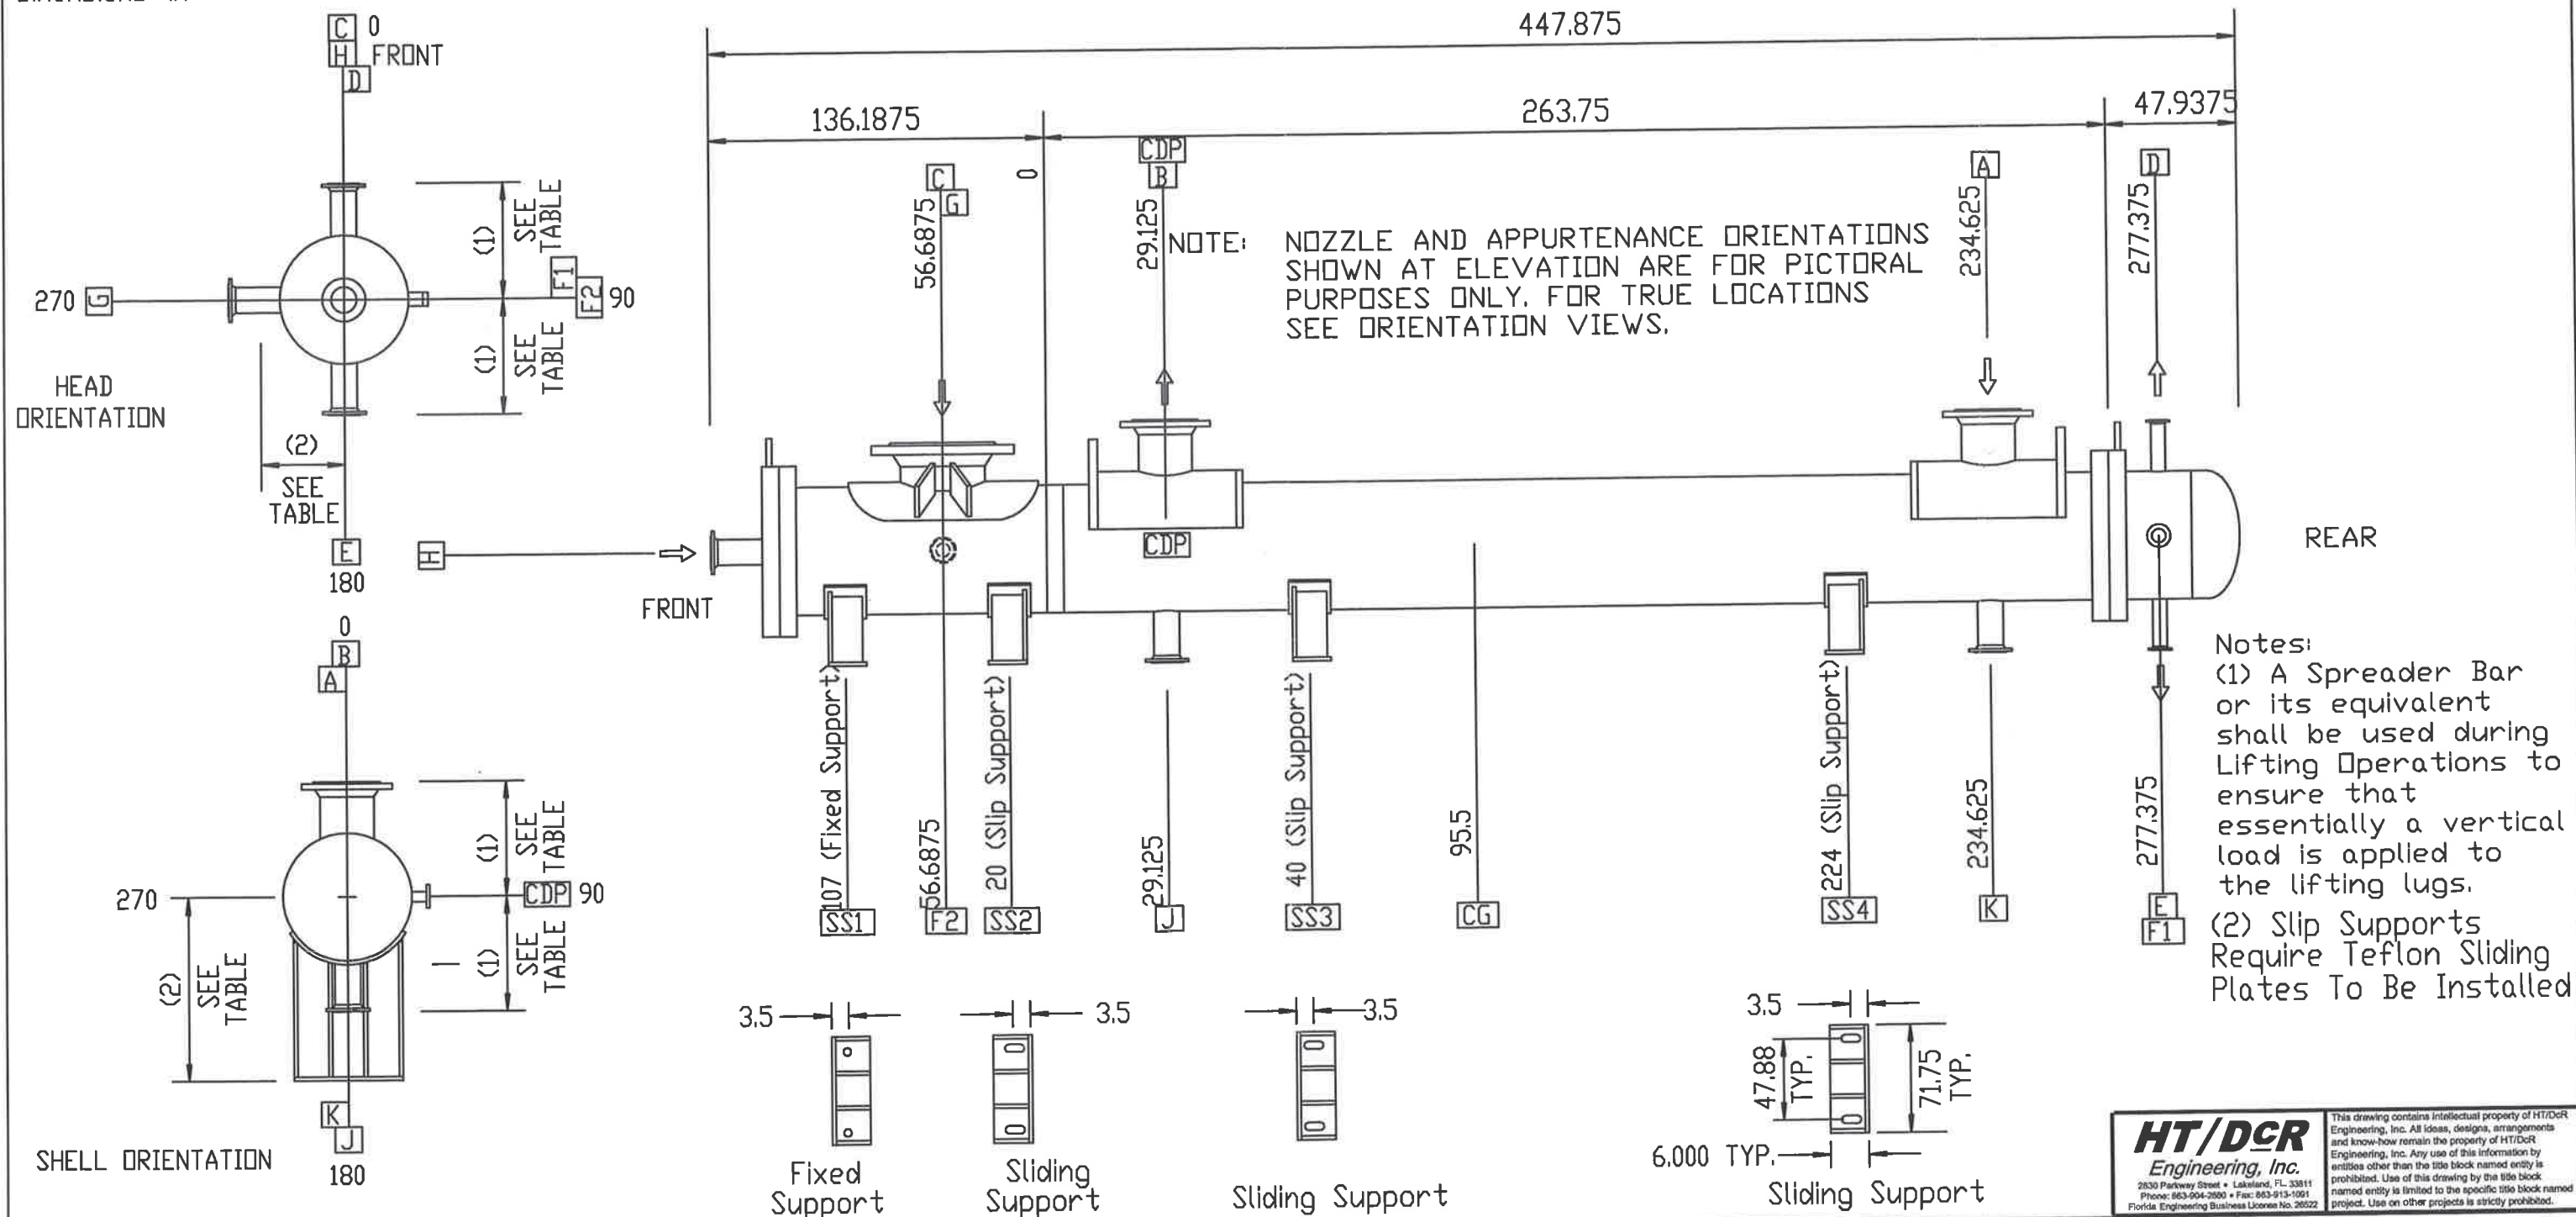


Nozzles				(1)			Couplings / Supports(2)			Design Specifications			Shell		Tube		Company: DCR Construction, Inc. Location: Bunge-Ergon Evaporator Condenser Item No: E-4504 Date: May 5, 2007 Job No: 7793			
Label	Size	Description	Project	Label	Size	Description	Project	Design Pressure	psig	150/15	50/15	DCR Construction, Inc. Lakeland, Florida	ASME VIII-1 2004 A06	Setting Plan	TEMA Type: NEM	Size: 71-264	Dwg No: E-4504 01A	Rev: 4		
A	30"	150 # ANSI S.O.R.F	53.00	F1	0.5	3000 # Half Length	36.9375	Test Pressure	psig	195	65									
B	30"	150 # ANSI S.O.R.F	53.00	F2	0.5	3000 # Half Length	36.9375	Min. Design Temperature	F	200	300									
C	54"	150 # ANSI S.O.R.F	54.75	SS1	SADDLE1 W/2 1.25 HOLES		60	Max. Design Temperature	F	200	300									
D	6"	150 # ANSI S.O.R.F	42	SS2	SADDLE2 W/2 1.25X2.5 SLOTS		60	Number of Passes		1	1									
E	6"	150 # ANSI S.O.R.F	42	SS3	SADDLE3 W/2 1.25X2.5 SLOTS		60	Corrosion Allowance	in	0.0625	0.0									
G	4"	150 # ANSI S.O.R.F	42	SS4	SADDLE4 W/2 1.25X2.5 SLOTS		60	Radiographing		None	None									
H	3"	150 # ANSI S.O.R.F	6	CDP	CODE DATA PLATE			Post-Weld Heat Treatment		None	None	TEMA Class: C								
J	2"	150 # ANSI S.O.R.F	42					Wt Empty: 63056 Full: 121779 Bundle: 30902 lb												
K	2"	150 # ANSI S.O.R.F	42					Revi	Date	Description	Dwg	Ckd	Appd							
								4	1-09-08	CERTIFIED AS-BUILT	AGB	DGB	PW							

Dimensions: in



Front Head

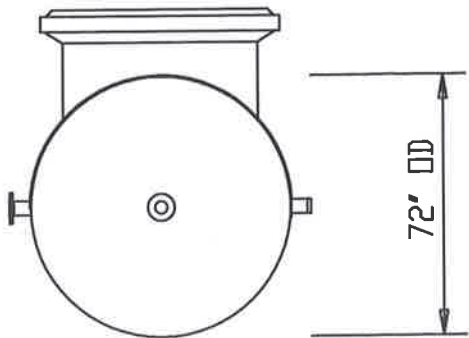

Shell

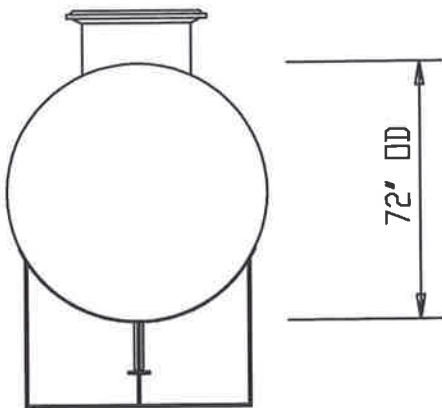

Rear Head

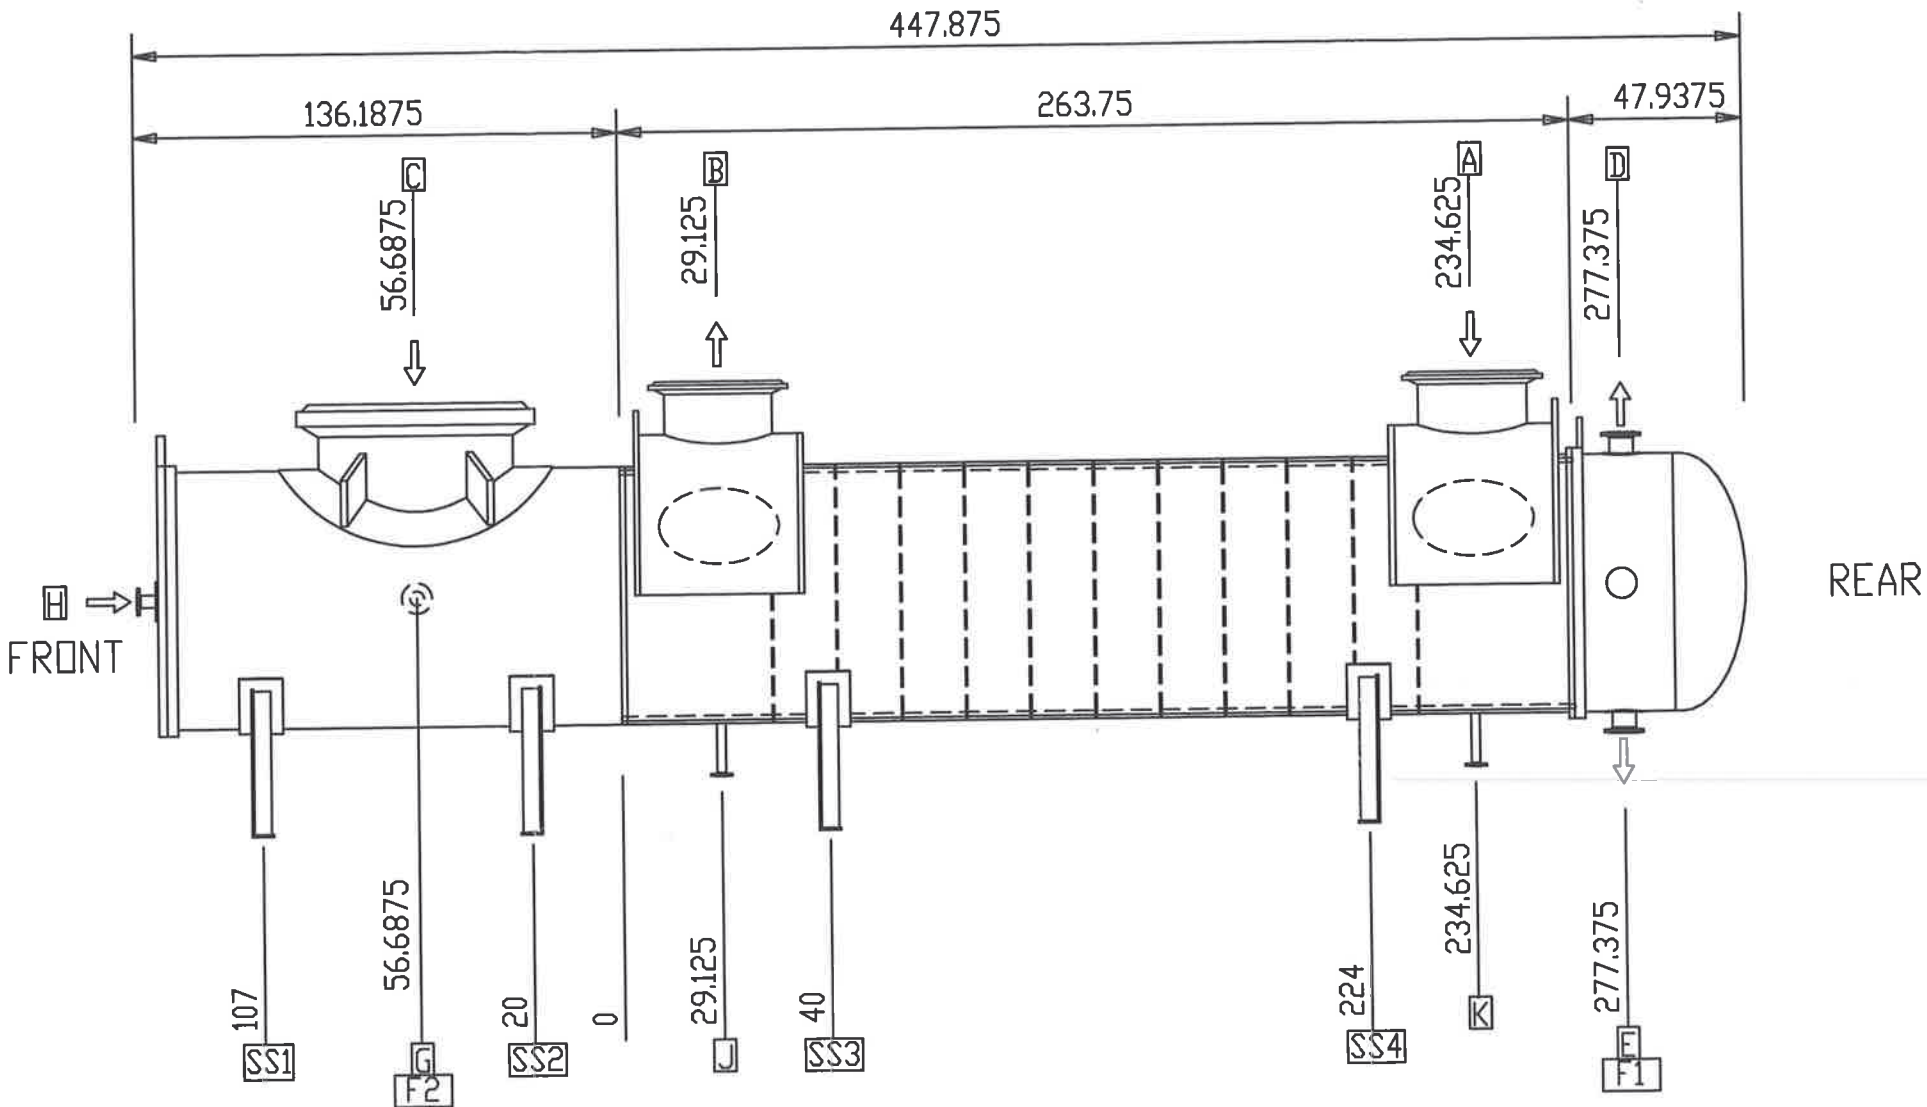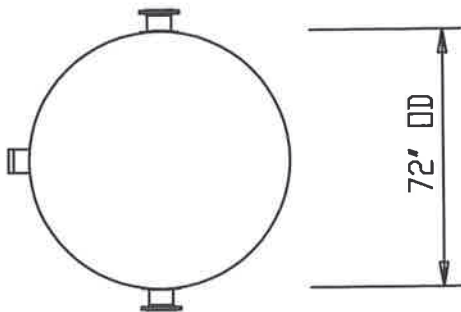


NOTE: NOZZLE AND APPURTENANCE ORIENTATIONS SHOWN IN ABOVE VIEW ARE FOR PICTORAL PURPOSES ONLY. FOR TRUE LOCATIONS SEE ORIENTATIONS ON DRG E-4504-01A

HT/DCR
Engineering, Inc.

Nozzles			Couplings / Supports(2)			Design Specifications			Shell	Tube	Company: DCR Construction, Inc. Location: Bunge-Ergon Evaporator Condenser Item No: E-4504 Date: May 5, 2007 Job No: 7793 DCR Construction, Inc. Lakeland, Florida			
Label	Size	Description	Project	Label	Size	Description	Project	Design Pressure	psig	150/15				
A	30"	150 # ANSI S.O.R.F	53.00	F1	0.5	3000 # Half Length	36.9375	Test Pressure	psig	195				
B	30"	150 # ANSI S.O.R.F	53.00	F2	0.5	3000 # Half Length	36.9375	Design Temperature	F	200				
C	54"	150 # ANSI S.O.R.F	54.75	SS1		SADDLE1 W/2 HOLES	60	Number of Passes		1	ASME VIII-1 2004 A06 Setting Plan TEMA Type: NEM Size: 71-264 TEMA Class: C			
D	6"	150 # ANSI S.O.R.F	42	SS2		SADDLE2 W/2 1.25X2.5 SLOTS	60	Corrosion Allowance	in	0.0625				
E	6"	150 # ANSI S.O.R.F	42	SS3		SADDLE3 W/2 1.25X2.5 SLOTS	60	Radiographing		None				
G	4"	150 # ANSI S.O.R.F	42	SS4		SADDLE4 W/2 1.25X2.5 SLOTS	60	Wt Empty: 63056 Full: 121779 Bundle: 30902 lb						
H	3"	150 # ANSI S.O.R.F	6	CDP		CODE DATA PLATE		Rev:	Date:	Description	Dwg	Ckd	Appd	Dwg No: E-4504 01B Rev: 4
J	2"	150 # ANSI S.O.R.F	42					4	01-09-08	CERTIFIED AS-BUILT	AGB	DGB	PW	
K	2"	150 # ANSI S.O.R.F	42					2	08-30-07	REVISED PER CLIENT	KFF	DGB	PW	
								3	09-18-07	REVISED AS NOTED	KFF	DGB	PW	

Component				O.D.	Thk.	Materials of Construction	Dimensions: in	
Nozzle	A	Cooling Wtr.Inlet	30.0	0.500	150# Series B 30" SDRF B16.47 SA-105 Forged Flange	<div><div><div><div><div>HT/DCR</div><div>Engineering, Inc.</div></div><div><div><div>2830 Parkway Street • Lakeland, FL 33811</div><div>Phone: 863-904-2880 • Fax: 863-913-1091</div><div>Florida Engineering Business License No. 26522</div></div></div><div><div>This drawing contains intellectual property of HT/DCR Engineering, Inc. All ideas, designs, arrangements and know-how remain the property of HT/DCR Engineering, Inc. Any use of this information by entities other than the title block named entity is prohibited. Use of this drawing by the title block named entity is limited to the specific title block named project. Use on other projects is strictly prohibited.</div></div></div></div></div>	Design Specifications <table><tr><td></td><td>Shell Side</td><td>Tube Side</td></tr><tr><td>Design Pressure</td><td>psig 150/15</td><td>50/15</td></tr><tr><td>Test Pressure</td><td>psig 195</td><td>65</td></tr><tr><td>Design Temperature</td><td>F 200</td><td>300</td></tr><tr><td>Number of Passes</td><td>1</td><td>1</td></tr><tr><td>Corrosion Allowance</td><td>in 0.0625</td><td>0.0</td></tr><tr><td>Radiographing</td><td>None</td><td>None</td></tr><tr><td>TEMA Type: NEM</td><td>Size: 71-264</td><td>Area: 12863 ft2</td></tr><tr><td>Tube Type: Plain</td><td># Holes: 1785</td><td>Length: 264.25 in</td></tr><tr><td>Layout: 1.5625 in (30)</td><td>Tube-Ts Joint: Exp/Str.Welded</td><td></td></tr><tr><td>Baffle Type: Double Seg.</td><td>Cut: 30% V</td><td>No: 11</td></tr><tr><td>Baffle Spacing (C-C): 17.875</td><td>Inlet: 40.0 in</td><td></td></tr><tr><td>Impingement Protection: None</td><td></td><td></td></tr><tr><td>Code: ASME VIII-1 2004 A06</td><td>TEMA Class: C</td><td></td></tr><tr><td>Wt Empty: 63056</td><td>Full: 121779</td><td>Bundle: 30902 lb</td></tr><tr><td>Drawn By: RM</td><td>Ckd By:</td><td>Apvd By:</td></tr><tr><td>Dwg No:</td><td>Rev: 4</td><td>Date: 01-09-08</td></tr></table> <div>Company: DCR Construction, Inc. Location: Bunge-Ergon Evaporator Condenser Item No: E-4504 Date: May 5, 2007 Job No: 7793</div> <div>DCR Construction, Inc. Lakeland, Florida</div>				Shell Side	Tube Side	Design Pressure	psig 150/15	50/15	Test Pressure	psig 195	65	Design Temperature	F 200	300	Number of Passes	1	1	Corrosion Allowance	in 0.0625	0.0	Radiographing	None	None	TEMA Type: NEM	Size: 71-264	Area: 12863 ft2	Tube Type: Plain	# Holes: 1785	Length: 264.25 in	Layout: 1.5625 in (30)	Tube-Ts Joint: Exp/Str.Welded		Baffle Type: Double Seg.	Cut: 30% V	No: 11	Baffle Spacing (C-C): 17.875	Inlet: 40.0 in		Impingement Protection: None			Code: ASME VIII-1 2004 A06	TEMA Class: C		Wt Empty: 63056	Full: 121779	Bundle: 30902 lb	Drawn By: RM	Ckd By:	Apvd By:	Dwg No:	Rev: 4	Date: 01-09-08
Nozzle	B	Cooling Wtr.Outlet	30.0	0.500	150# Series B 30" SDRF B16.47 Forged Flange SA-105	
Nozzle	C	Vapor Inlet	54.0	0.625	150# Series B 54" FFWN B16.47 Forged Flange on SA-240 S30400 Grd 304 Plate	
Nozzle	D	Vapor Outlet	6.625	0.28	150 # ANSI S.D.R.F Flg SA-182 on SA-312 S30400 Grd TP304 Wld. pipe	
Nozzle	E	Non. Cond Outlet	6.625	0.28	150 # ANSI S.D.R.F Flg SA-182 on SA-312 S30400 Grd TP304 Wld. pipe	
Nozzle	G	Tube Side Inlet	4.5	0.337	150 # ANSI S.D.R.F Flg SA-182 on SA-312 S30400 Grd TP304 Wld. pipe	
Nozzle	H	Tube Side Inlet	3.5	0.300	150 # ANSI S.D.R.F Flg SA-182 on SA-312 S30400 Grd TP304 Wld. pipe	
Nozzle	J	Spare Port	2.375	0.344	150 # ANSI S.D.R.F Flg SA-105 on SA-53 K03005 Grd. E/B Wld. Pipe	
Nozzle	K	Spare Port	2.375	0.344	150 # ANSI S.D.R.F Flg SA-105 on SA-53 K03005 Grd. E/B Wld. Pipe	
Coupling	F1		0.5		3000 # Half Length SA-182 S30400 Grd F304 Forgings	
Coupling	F2		0.5		3000 # Half Length SA-182 S30400 Grd F304 Forgings	
Shell Cylinder			72	0.5	SA-516 K02700 Grd 70 Plate	
Front Head Cylinder			72	0.375	SA-240 S30400 Grd 304 Plate	
Rear Head Cylinder			72	0.3125	SA-240 S30400 Grd 304 Plate	
Fr Hd Cover			75.625	2.8125	SA-516 K02700 Grd 70 Plate (Flat Cover) (Alloy Overlayed)	
Re Hd Cover			72	0.3125	SA-240 S30400 Grd 304 Plate (Ellipsoidal Cover)	
Front TubSh			72	1.5	SA-240 S30400 Grd 304 Plate	
Rear TubSh			75.5	1.5	SA-240 S30400 Grd 304 Plate	
Re Hd Flng			75.5	2.9375	SA-516 K02700 Grd 70 Plate (Ring Flange) (Alloy Overlayed)	
Fr Hd Flng			75.625	2.125	SA-240 S30400 Grd 304 Plate	
Re Hd Gskt TubSh			73.25	0.125	Solid Teflon 1/8in Thickness (Periph. Width 0.5 in)	
Fr Hd Gskt Cover			73.375	0.125	Solid Teflon 1/8in Thickness (Periph. Width 0.5 in)	
Re Hd Blts TubSh			0.5		SA-193 G41400 Grd B7 Bolt (72 Bolts on 74.25 in B.C.)	
Fr Hd Blts Cover			0.5		SA-193 G41400 Grd B7 Bolt (72 Bolts on 74.375 in B.C.)	
Tubes			1.25	0.049	SA-249 S30400 Grd TP304 Wld. tube (Plain Tubes)	
Baffles			70.625	0.5	A-36 K02600 Plate	
Distributor Belts			89.5	0.75	SA-516 K02700 Grd 70 Plate (Tube-Ts Joint)	
Shell Supports				0.625	SA-516 K02700 Grd 70 Plate	
Distributor belt closure				1.0	SA-516 K02700 Grd 70 Plate	
CDP Bracket				0.25	SA-36 K02600 Plate	
CODE DATA PLATE				0.1046	SA-240 S30400 Grd 304 Plate	
Nozzle C Repad			103	0.625	SA-240 S30400 Grd 304 Plate	
Head Lift Lugs				0.500	SA-240 S30400 Grd 304 Plate	
Nozzle C Facing			56.75	0.375	SA-240 S30400 Grd 304 FLAT BAR 1 3/4" X 3/8" ROLLED HARD WAY	
Shell Support Repad				0.50	SA-240 S30400 Grd 304 Plate (SS1,SS2)	
Shell Support Repad				0.50	SA-516 K02700 Grd 70 Plate (SS3,SS4)	
Nozzle C Gussets				0.750	SA-240 S30400 Grd 304 Plate	
Nozzle H Repad			11.00	0.750	SA-516 K02700 Grd 70 Plate	

All Dimensions
In Inches

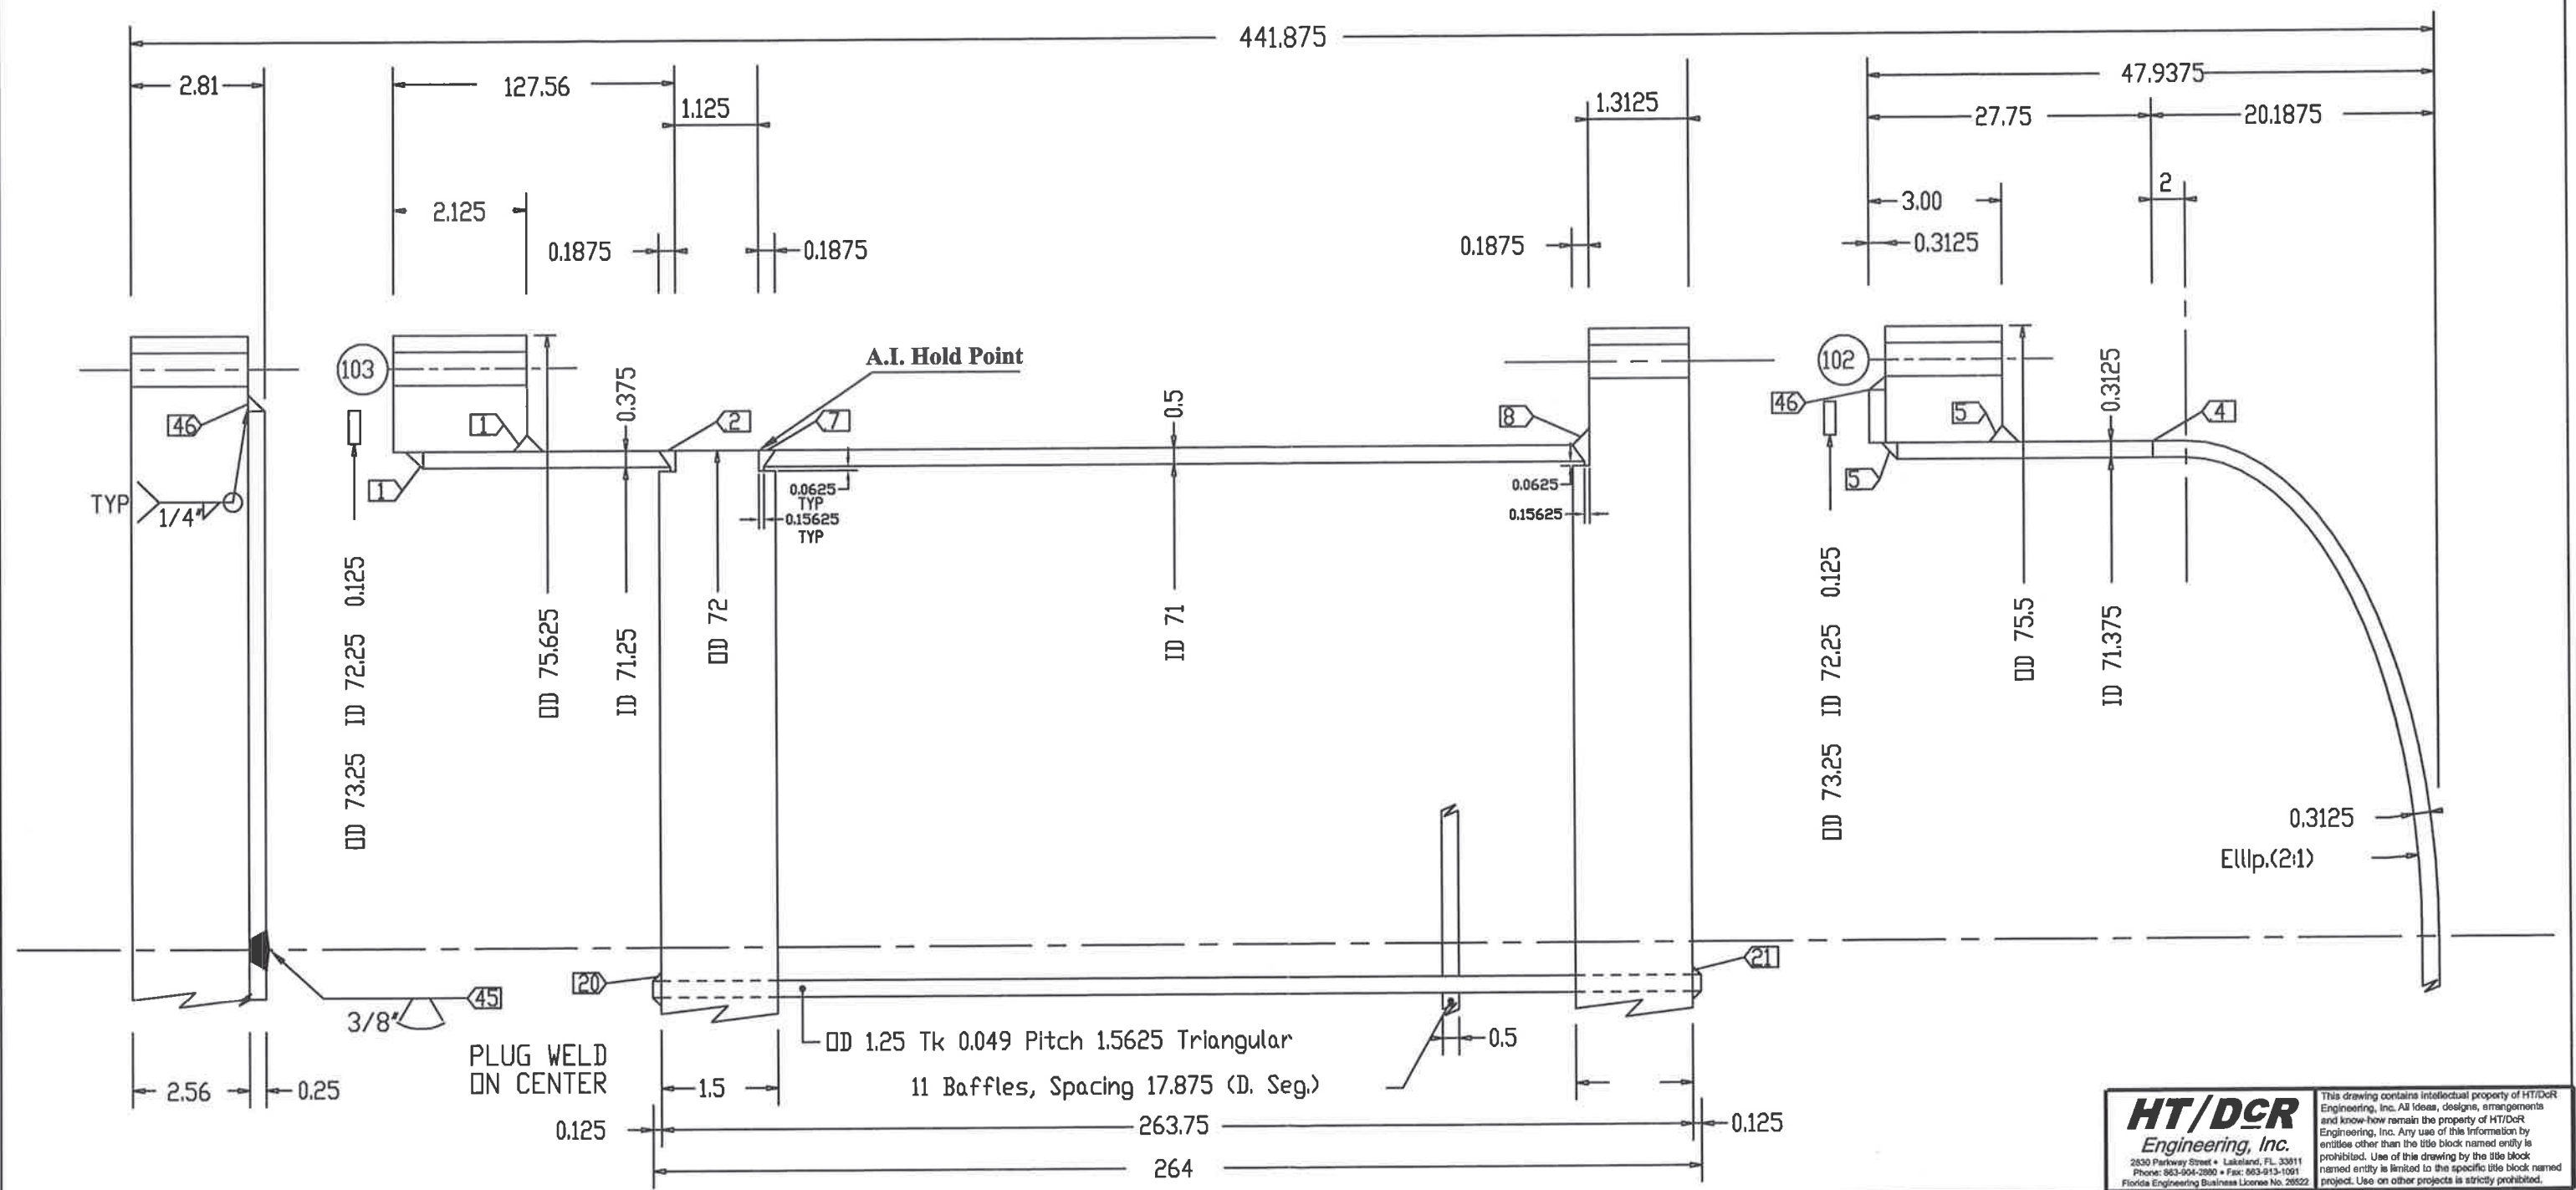

HT/DCR
Engineering, Inc.
2830 Parkway Street • Lakeland, FL 33811
Phone: 863-904-2800 • Fax: 863-913-1091
Florida Engineering Business License No. 28522

This drawing contains intellectual property of HT/DCR Engineering, Inc. All ideas, designs, arrangements and know-how remain the property of HT/DCR Engineering, Inc. Any use of this information by entities other than the title block named entity is prohibited. Use of this drawing by the title block named entity is limited to the specific title block named project. Use on other projects is strictly prohibited.

Notes:

Company: DCR Construction, Inc.
Location: Bunge-Ergon
Evaporator Condenser
Item No: E-4504
Date: May 5, 2007 Job No: 7793

DCR Construction, Inc.
Lakeland, Florida


Scale: NTS

Ref	No	Bolt Dia.	Bolt Length	Bolt Circle	Bolt Hole
103	72	0.5	7.5	74.375	0.625
102	72	0.5	6.5	74.25	0.625
Bolting					


Rev:	Date:	Description	Dwg	Ckd	Appd	ASME VIII-1 2004 A06	Sectional Plan	
4	01-09-08	CERTIFIED AS-BUILT	AGB	DGB	PW	TEMA Type: NEM	Dwg No: E-4504 03	Rev: 4
2	08-30-07	REVISIONS PER CLIENT	KFF	DGB	PW	Size: 71-264		
3	09-25-07	CHANGED ALLOY FACING	KFF	DGB	PW	TEMA Class: C		

Dimensions: in


Front

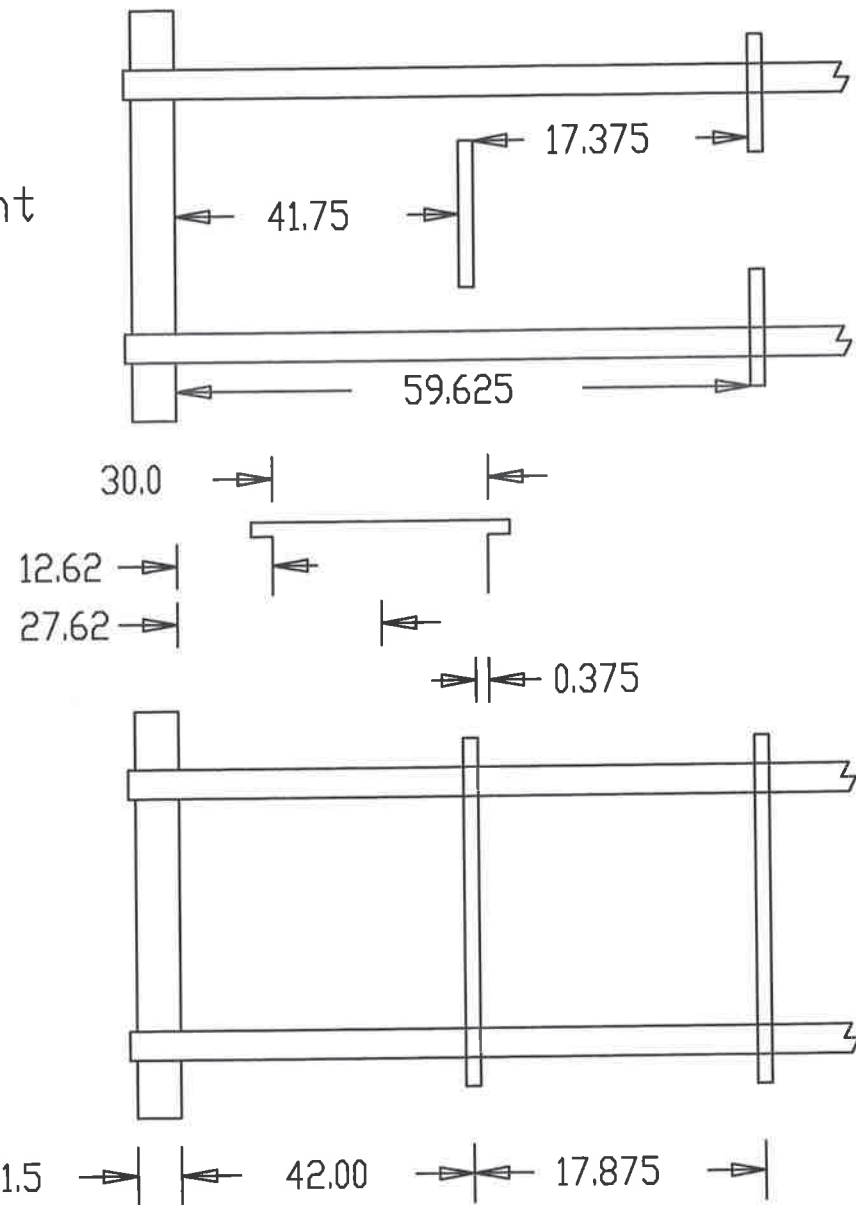

Top View

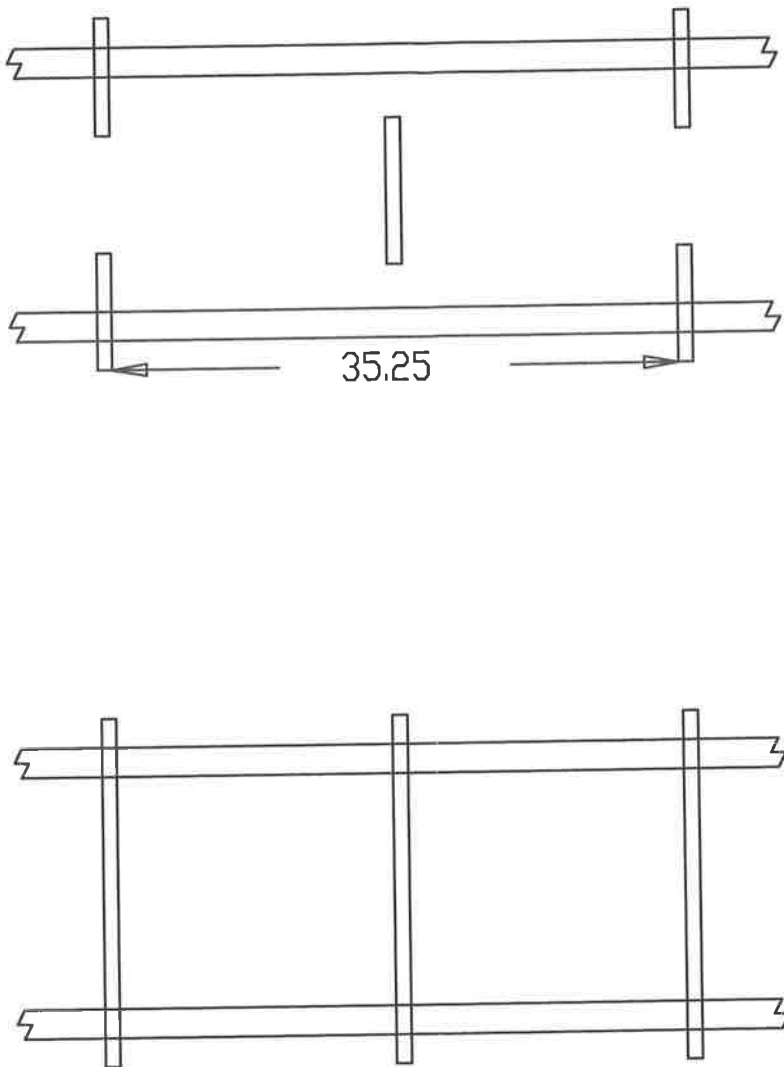


Side View

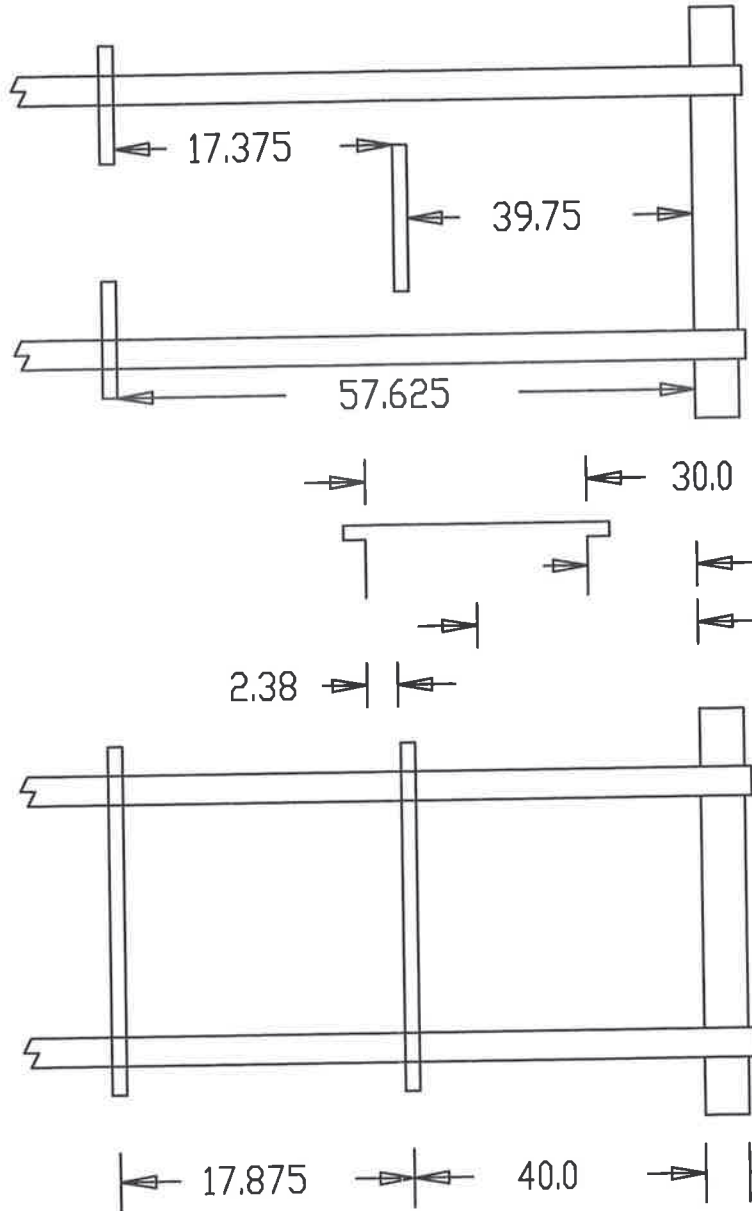

Rear

TEMA Type: E

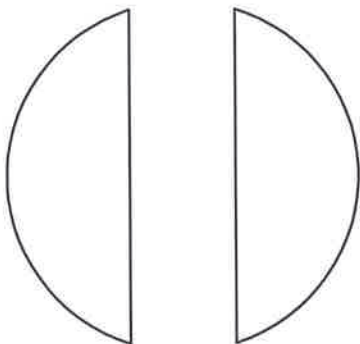

Baffles

Notes:

Scale: NTS

Rev:	Date:	Description	Dwg	Ckd	Appd
1	08-22-07	ISSUED FOR CONSTRUCTION	KFF	DGB	PW
2	08-22-07	REVISED PER CLIENT	KFF	DGB	PW
3	01-09-08	CERTIFIED AS-BUILT	AGB	DGB	PW

Company: DCR Construction, Inc.
Location: Bunge-Ergon
Evaporator Condenser
Item No: E-4504
Date: May 5, 2007 Job No: 7793

DCR Construction, Inc.
Lakeland, Florida

ASME VIII-1 2004 A06
TEMA Type: NEM
Size: 71-264
TEMA Class: C

Bundle Detail

Dwg No:
E-4504 04




Rev:
3

HT/DCR
Engineering, Inc.

2830 Parkway Street • Lakeland, FL 33811
Phone: 863-904-2880 • Fax: 863-913-1001
Florida Engineering Business License No. 28522

This drawing contains intellectual property of HT/DCR Engineering, Inc. All ideas, designs, arrangements and know-how remain the property of HT/DCR Engineering, Inc. Any use of this information by entities other than the title block named entity is prohibited. Use of this drawing by the title block named entity is limited to the specific title block named project. Use on other projects is strictly prohibited.



Shell ID 71 in
 O.T.L. 70.375 in
 Baffle cut to C/L 10.825 in
 18.944 in

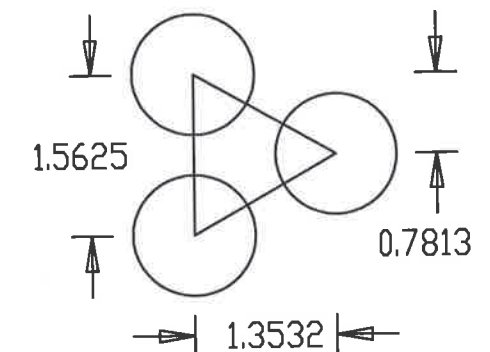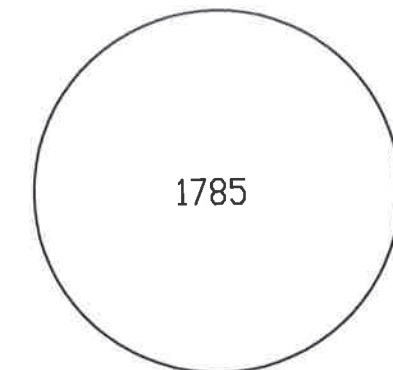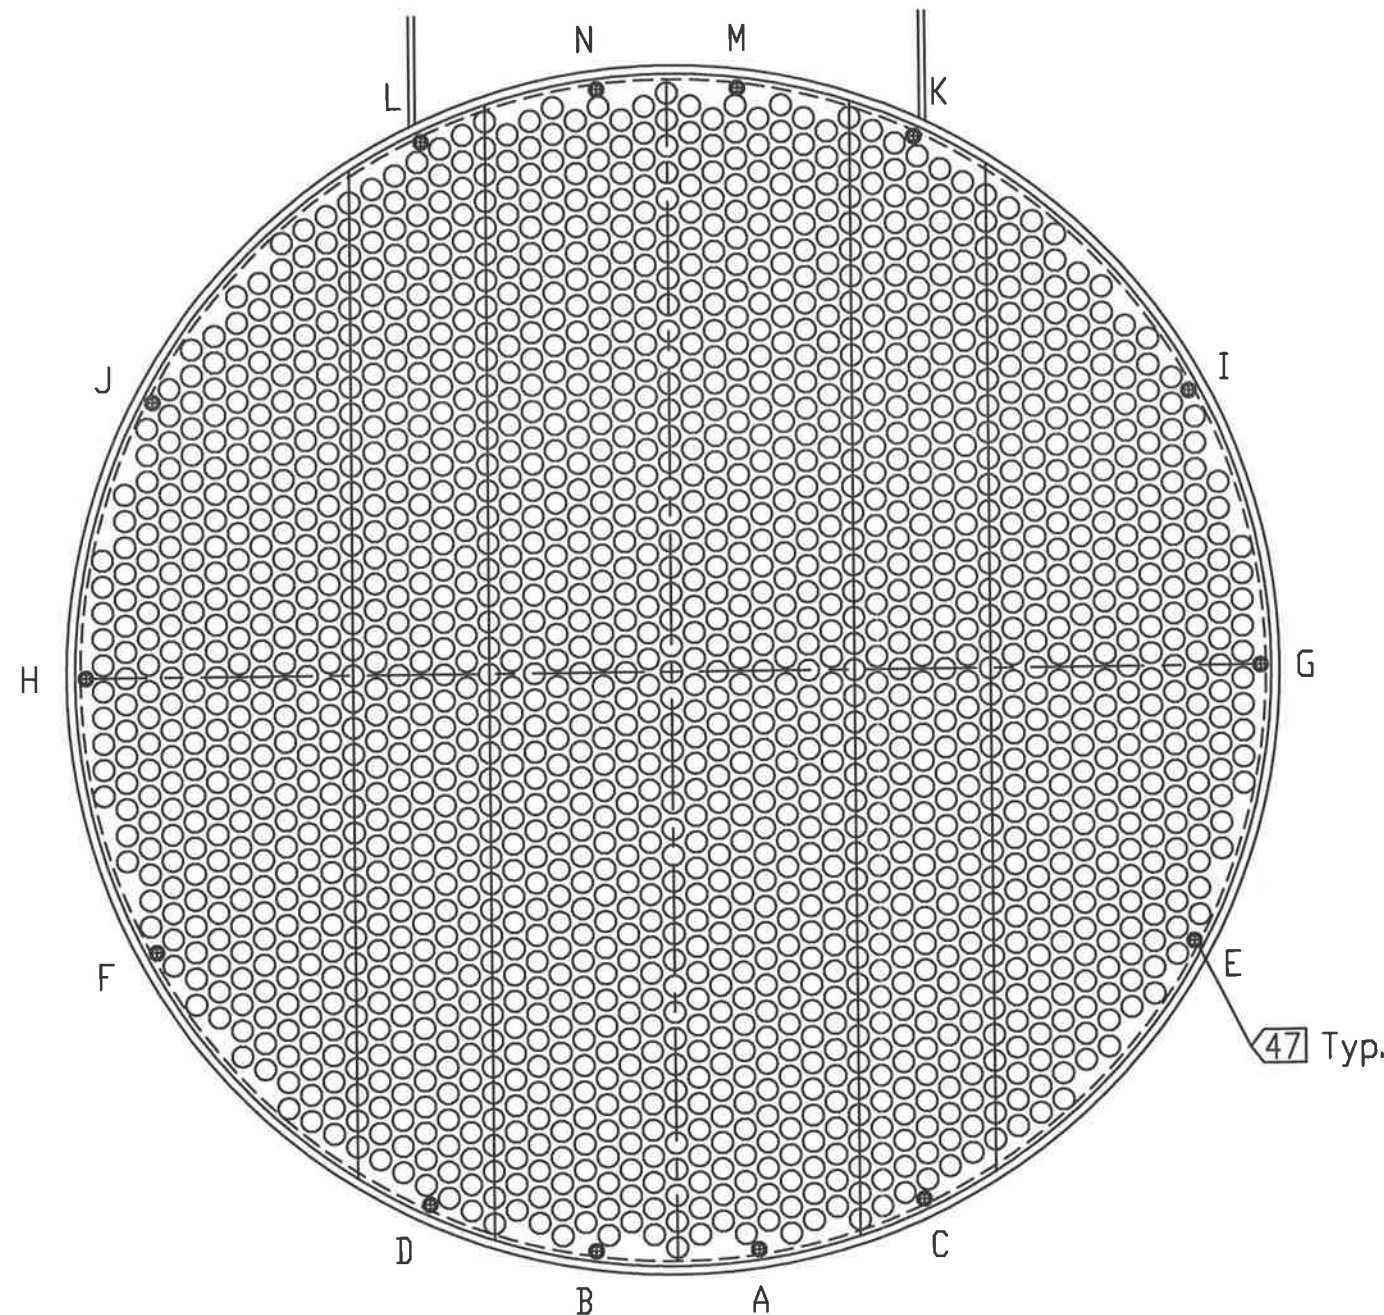

HT/DCR
 Engineering, Inc.
 2830 Parkway Street • Lakeland, FL 33811
 Phone: 863-904-2880 • Fax: 863-913-1091
 Florida Engineering Business License No. 28822

This drawing contains intellectual property of HT/DCR Engineering, Inc. All ideas, designs, arrangements and know-how remain the property of HT/DCR Engineering, Inc. Any use of this information by entities other than the title block named entity is prohibited. Use of this drawing by the title block named entity is limited to the specific title block named project. Use on other projects is strictly prohibited.

Design Specifications										Company: DCR Construction, Inc. Location: Bunge-Ergon Evaporator Condenser Item No: E-4504 Date: May 5, 2007 Job No: 7793		
Number of Tube Holes	1785	Tie Rod Locations		Tie Rod Locations (CONT.)						DCR Construction, Inc. Lakeland, Florida		
Tube Outside Diameter	1.25 in	A	4.8103 -34.5417	K	14.6675 31.6406							
Tube Pitch	1.5625 in	B	-4.8103 -34.5417	L	-14.6675 31.6406							
Tube Pattern	Triangular	C	14.6675 -31.6406	M	4.8103 34.5417							
Tube Passes	1	D	-14.6675 -31.6406	N	-4.8103 34.5417							
Number of Tie Rods	14	E	30.775 -16.4063							ASME VIII-1 2004 A06 TEMA Type: NEM Size: 71-264 TEMA Class: C		
Tie Rod Diameter	0.625 in	F	-30.775 -16.4063	Scale: NTS								
Baffle Diameter	70.625 in	G	34.875 0	Rev:	Date:	Description	Dwg	Ckd	Appd			
Baffle Type	Double Segmental	H	-34.875 0	1	08-22-07	ISSUED FOR CONSTRUCTION	KFF	DGB	PW			
Baffle Cut	30%	I	30.775 16.4063	2	01-09-08	CERTIFIED AS-BUILT	AGB	DGB	PW			
Tube Thickness	0.049 in	J	-30.775 16.4063							Dwg No: E-4504 05		Rev: 2

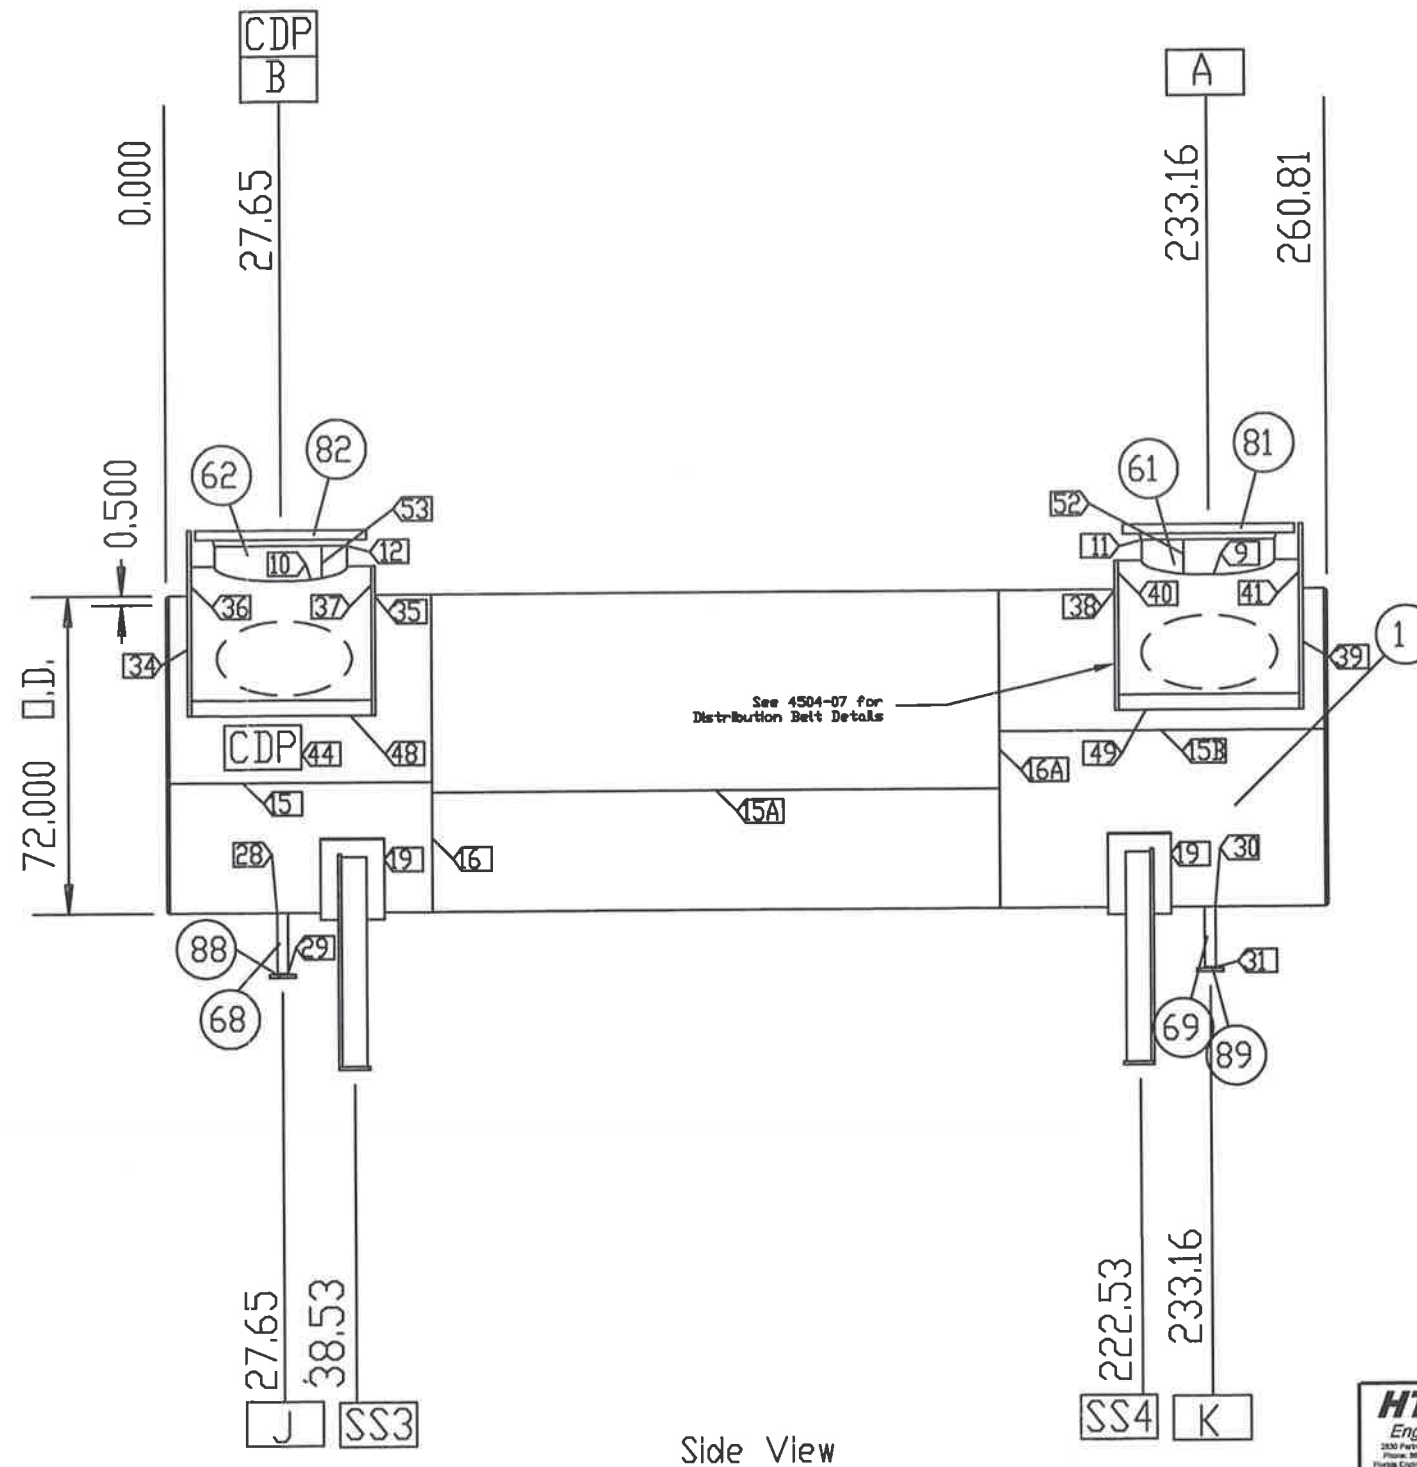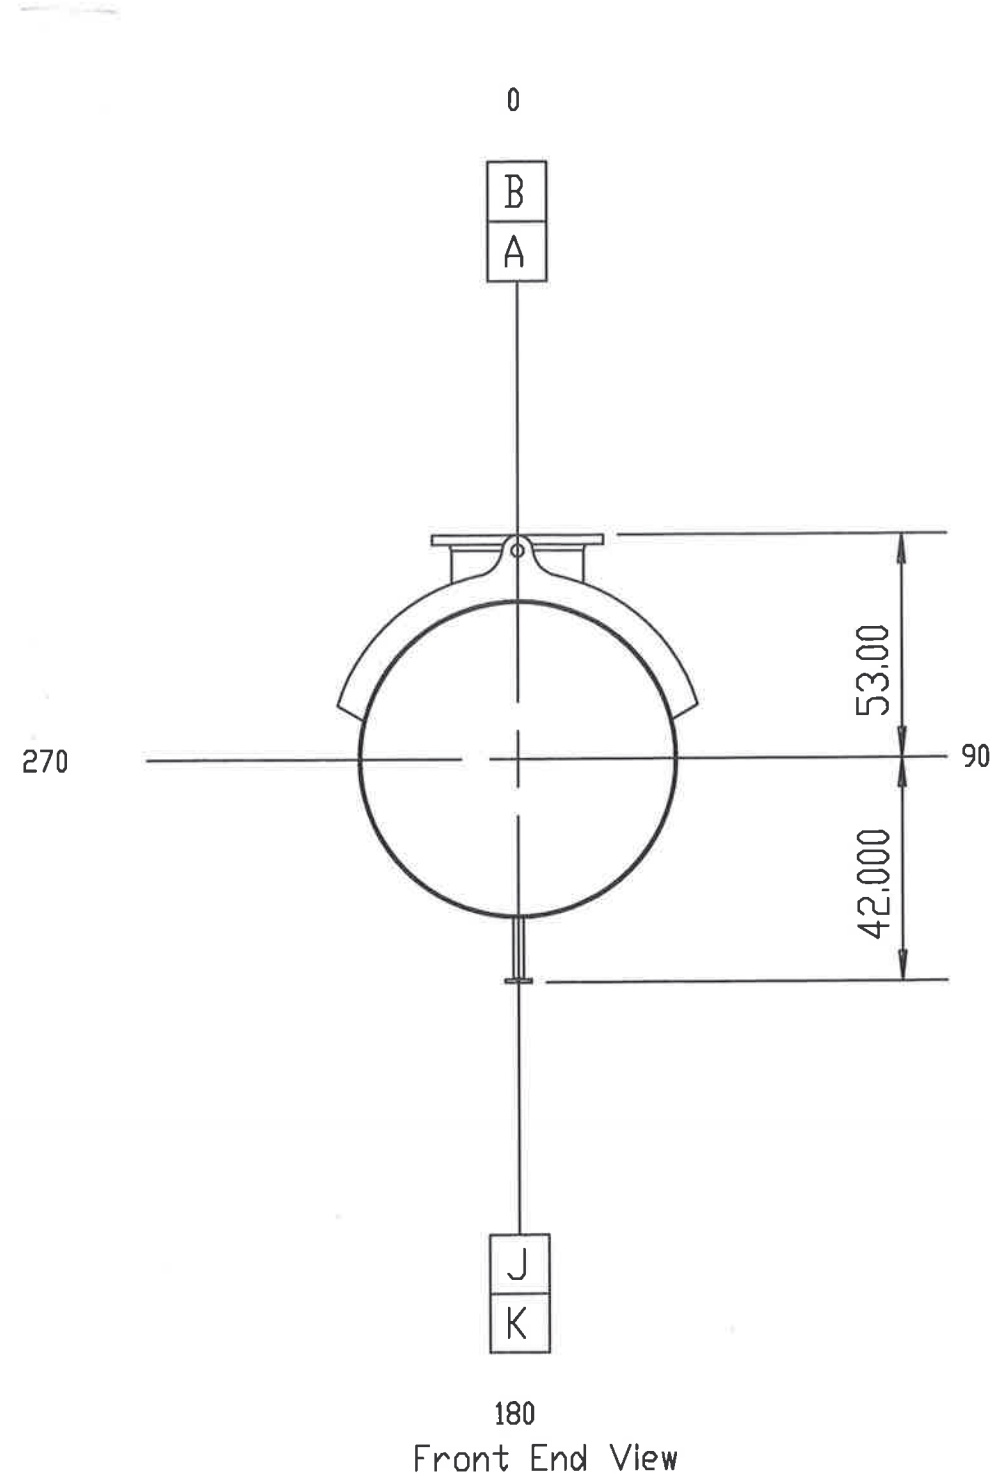

HT/DCR
Engineering, Inc.
2000 Parkway Drive • Lakeland, FL 33811
Phone: 863-944-2800 • Fax: 863-943-1591
Florida Engineering Business License No. 20022

This drawing contains intellectual property of HT/DCR Engineering, Inc. All ideas, designs, arrangements and know-how remain the property of HT/DCR Engineering, Inc. Any use of this information by entities other than the title block named entity is prohibited. Use of this drawing by the title block named entity is limited to the specific title block named project. Use on other projects is strictly prohibited.


Notes:
All Dimensions In Inches
Bolt holes to straddle centerlines
Weld joint details per drawing 20

Company: DCR Construction, Inc.
Location: Bunge-Ergon
Evaporator Condenser
Item No: E-4504
Date: May 5, 2007 Job No: 7793


DCR Construction, Inc.
Lakeland, Florida

Rev	Date	Description	Dwg	Ckd	Appd
5	01-09-08	CERTIFIED AS-BUILT	AGB	DGB	PW
2	08-30-07	REVISED PER CLIENT	KFF	DGB	PW
3	09-27-07	REVISED AS NOTED	KFF	DGB	PW
4	10-04-07	ADDED WELD SEAM	KFF	DGB	PW



ASME VIII-1 2004 A06	Shell Detail	Rev: 5
TEMA Type: NEM		
Size: 71-264		
TEMA Class: C		

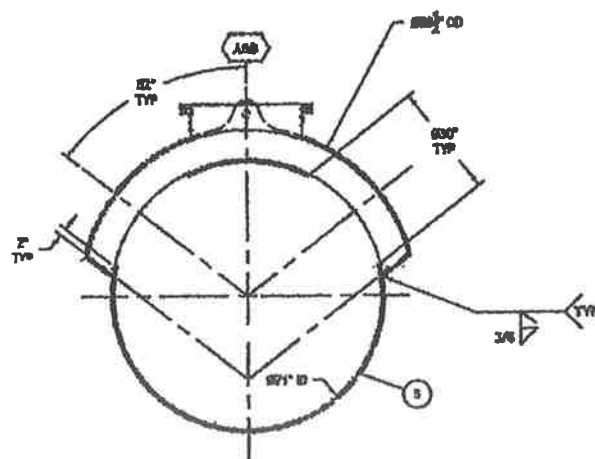


DISTRIBUTION BELT ASSY DETAIL
SCALE: 1/2" = 1"

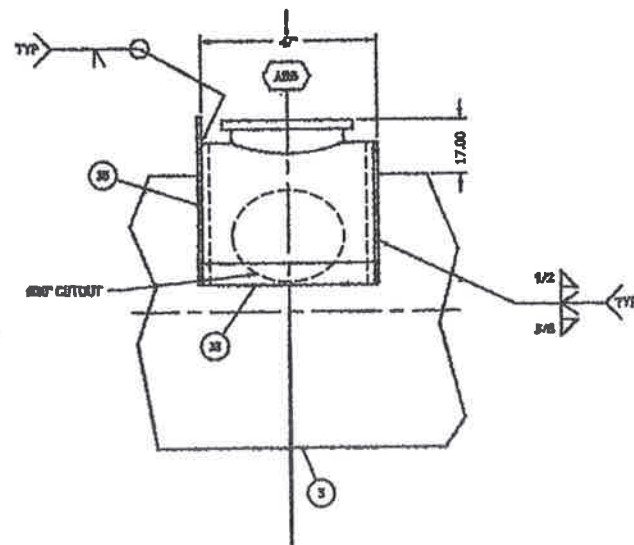

DISTRIBUTION BELT CLOSURE W/LUG DETAIL
SCALE: 1" = 1"

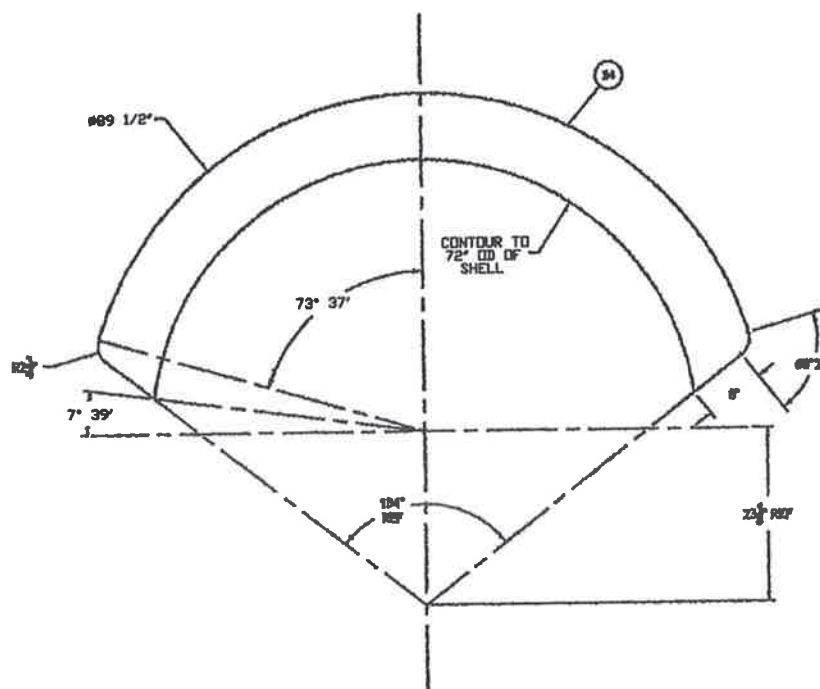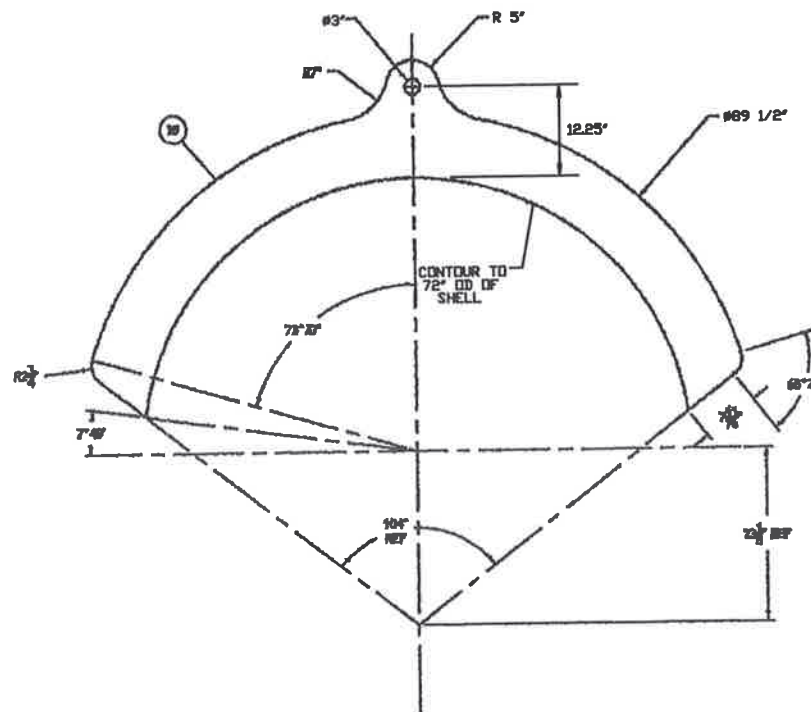

DISTRIBUTION BELT CLOSURE DETAIL
SCALE: 1" = 1"

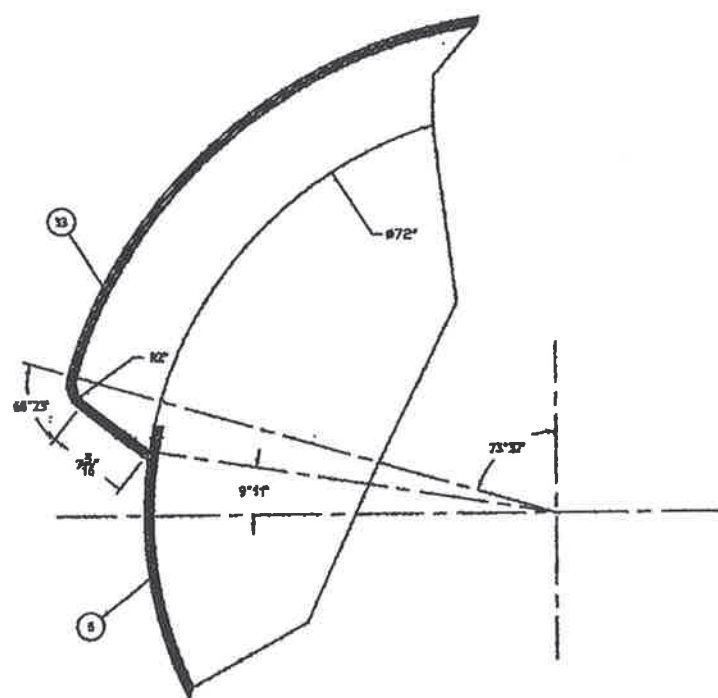

DISTRIBUTION BELT DETAIL
SCALE: 1/2" = 1"

HT/DCR
Engineering, Inc.

2830 Parkway Street • Lakeland, FL 33811
Phone: 863-904-2880 • Fax: 863-913-1091
Florida Engineering Business License No. 26522

This drawing contains intellectual property of HT/DCR Engineering, Inc. All ideas, designs, arrangements and know-how remain the property of HT/DCR Engineering, Inc. Any use of this information by entities other than the title block named entity is prohibited. Use of this drawing by the title block named entity is limited to the specific title block named project. Use on other projects is strictly prohibited.



Notes:
All Dimensions In Inches
Welding in accordance with Code

Company: DCR Construction, Inc.
Location: Bunge-Ergon
Evaporator Condenser
Item No: E-4504
Date: May 5, 2007 Job No: 7793

DCR Construction, Inc.
Lakeland, Florida

Scale: NTS

Rev	Date	Description	Dwg	Ckd	Appd	ASME VIII-1 2004 A06	Distribution Belt Detail	
4	01-09-08	CERTIFIED AS-BUILT	AGB	DGB	PW	TEMA Type: NEM	Dwg No.: E-4504 07	Rev: 4
2	08-30-07	REVISED PER CLIENT	KFF	DGB	PW	Size: 71-264		
3	09-27-07	REVISED AS NOTED	KFF	DGB	PW	TEMA Class: C		

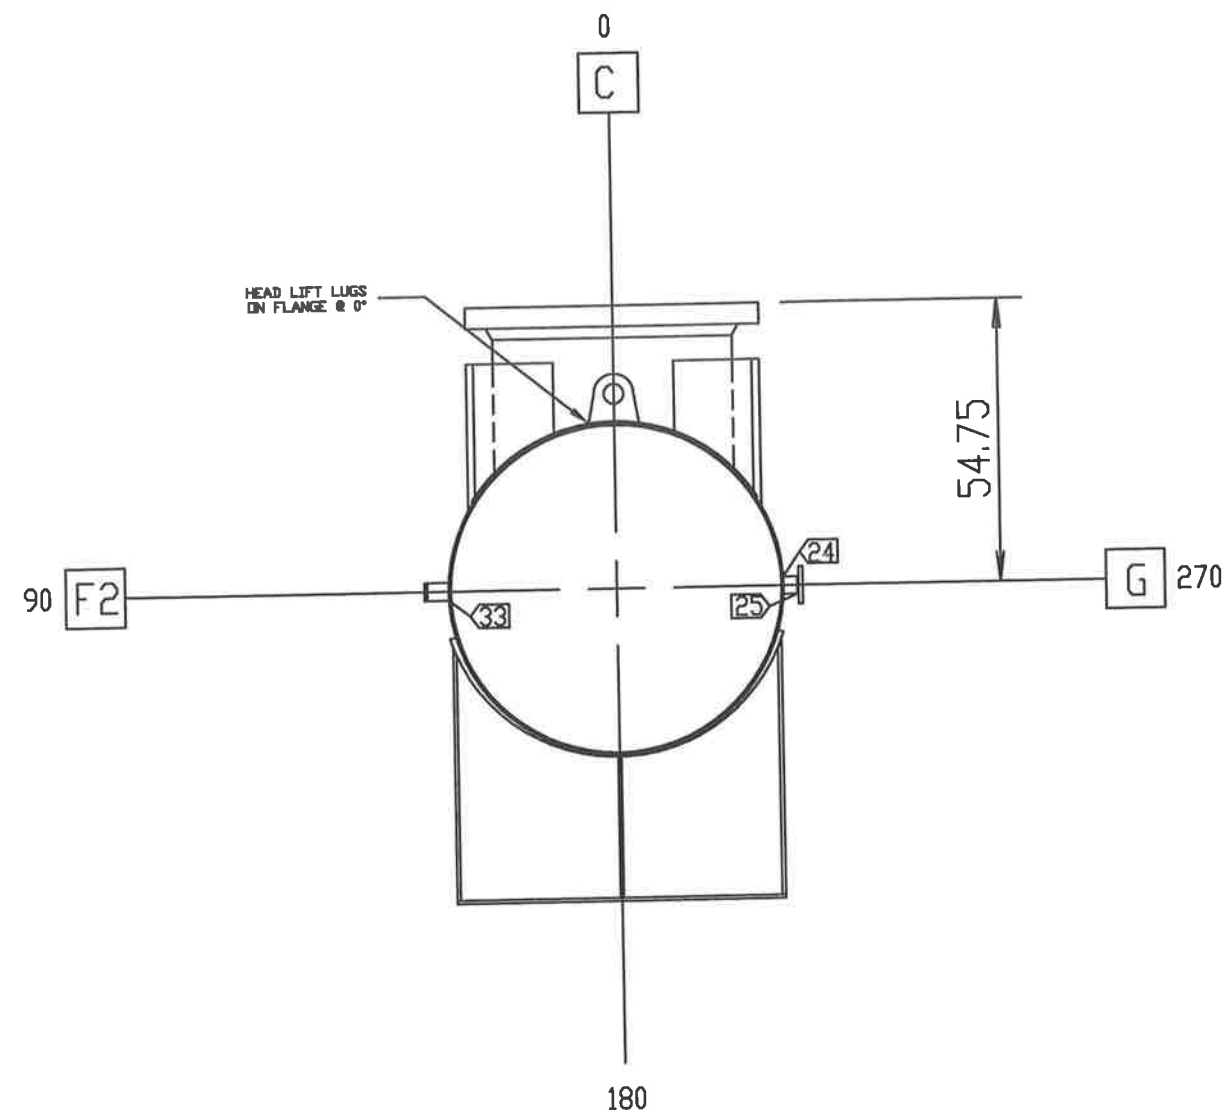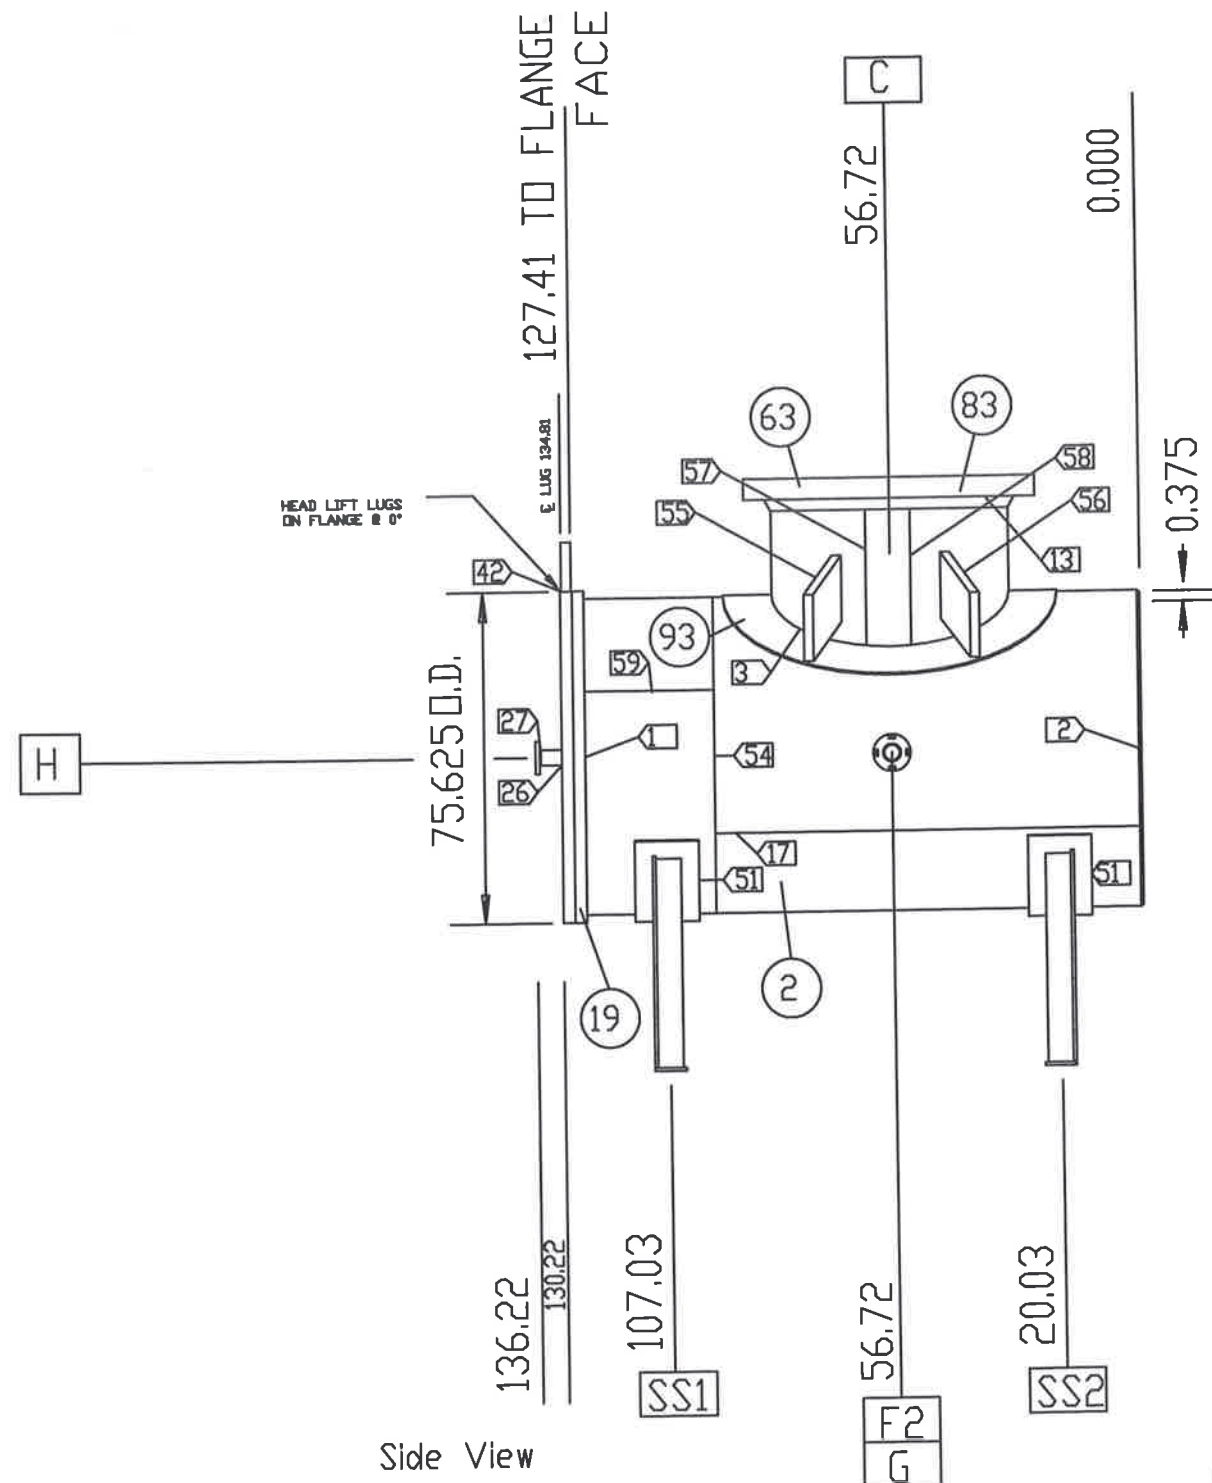

HT/DCR
Engineering, Inc.

2830 Parkway Street • Lakeland, FL 33811
Phone: 883-904-2000 • Fax: 883-913-1091
Florida Engineering Business License No. 26522

This drawing contains intellectual property of HT/DCR Engineering, Inc. All ideas, designs, arrangements and know-how remain the property of HT/DCR Engineering, Inc. Any use of this information by entities other than the title block named entity is prohibited. Use of this drawing by the title block named entity is limited to the specific title block named project. Use on other projects is strictly prohibited.

Notes:
All Dimensions In Inches
Bolt holes to straddle centerlines
Weld joint details per drawing 20

Scale: NTS

Rev	Date	Description	Dwg	Ckd	Appd
5	01-09-08	CERTIFIED AS-BUILT	AGB	DGB	PW
2	08-30-07	REVISED PER CLIENT CHANGES	KFF	DGB	PW
3	09-18-07	REVISED AS NOTED	KFF	DGB	PW
4	10-04-07	ADDED WELD SEAM	KFF	DGB	PW

Company: DCR Construction, Inc.
Location: Bunge-Ergon
Evaporator Condenser
Item No: E-4504
Date: May 5, 2007 Job No: 7793


DCR Construction, Inc.
Lakeland, Florida

ASME VIII-1 2004 A06
TEMA Type: NEM
Size: 71-264
TEMA Class: C

Front Head Detail


Dwg No: E-4504 08

Rev: 5

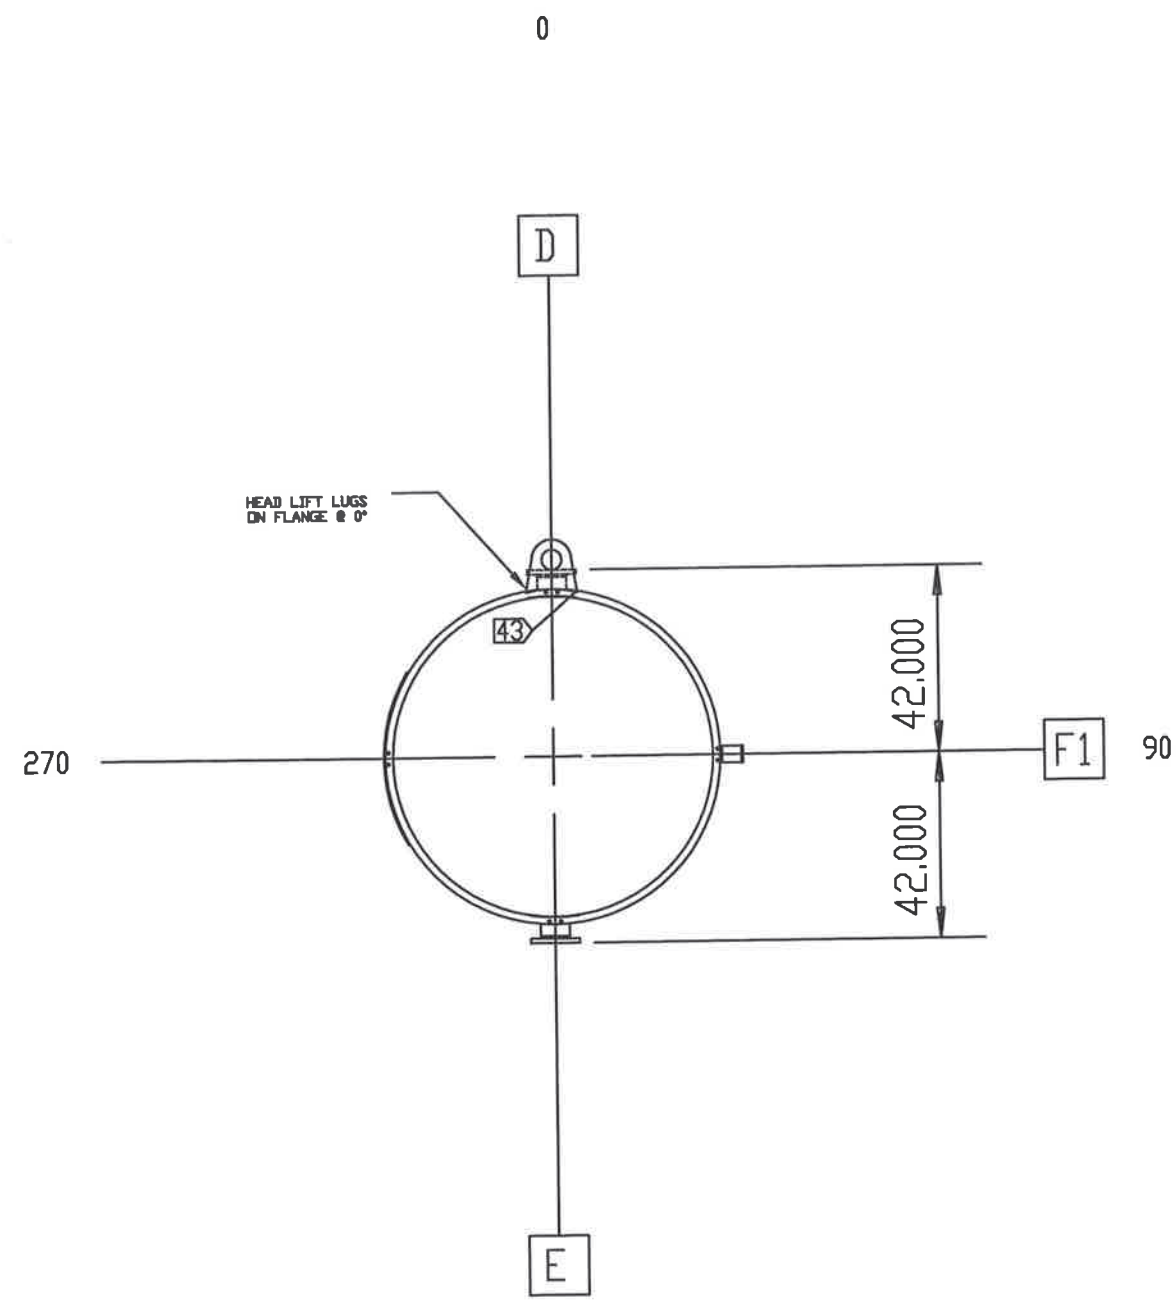

Front End View

180

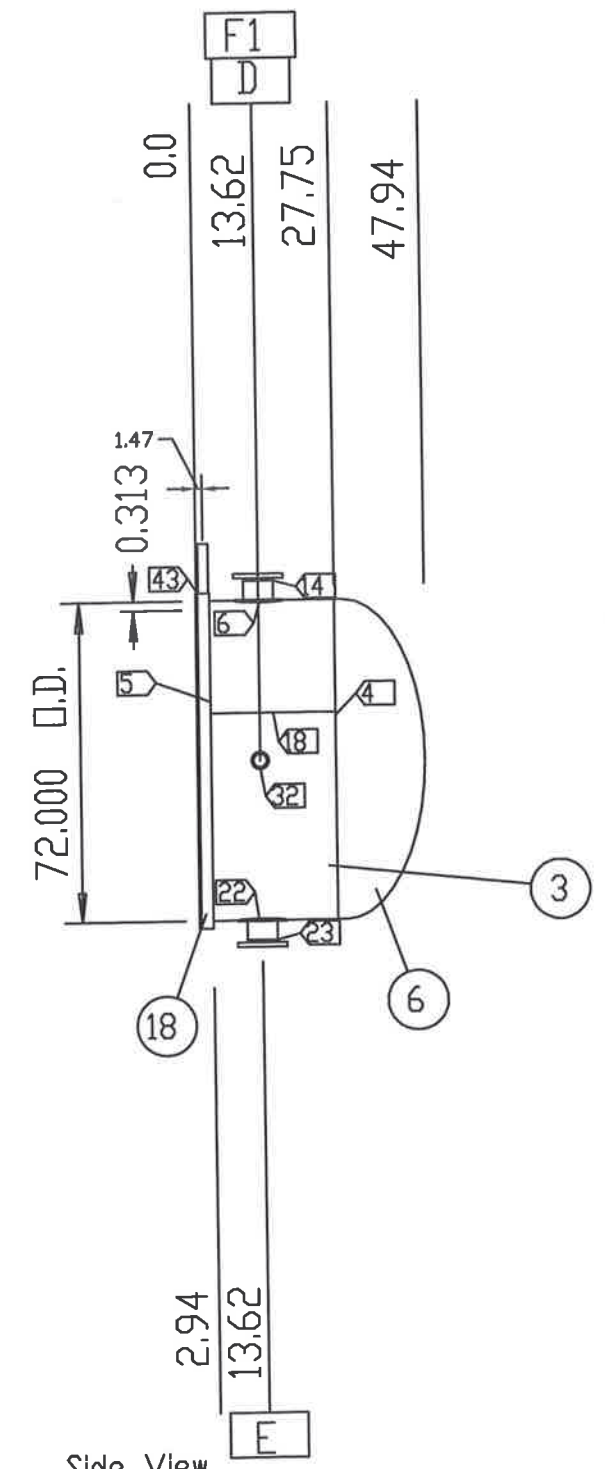

Side View

HT/DCR
Engineering, Inc.

This drawing contains intellectual property of HT/DCR Engineering, Inc. All ideas, designs, arrangements and know-how remain the property of HT/DCR Engineering, Inc. Any use of this information by entities other than the title block named entity is prohibited. Use of this drawing by the title block named entity is limited to the specific title block named project. Use on other projects is strictly prohibited.

Notes:
All Dimensions In Inches
Bolt holes to straddle centerlines
Weld joint details per drawing 20

Company: DCR Construction, Inc.
Location: Bunge-Ergon
Evaporator Condenser
Item No: E-4504
Date: May 5, 2007 Job No: 7793

DCR Construction, Inc.
Lakeland, Florida


Scale: NTS

Rev:	Date:	Description	Dwg	Ckd	Appd	ASME VIII-1 2004 A06
1	08-22-07	ISSUED FOR CONSTRUCTION	KFF	DGB	PW	TEMA Type: NEM
2	08-30-07	REVISED PER CLIENT	KFF	DGB	PW	Size: 71-264
3	01-09-08	CERTIFIED AS-BUILT	AGB	DGB	PW	TEMA Class: C


Rear Head Detail

Dwg No: E-4504 09
Rev: 3

Plan
View

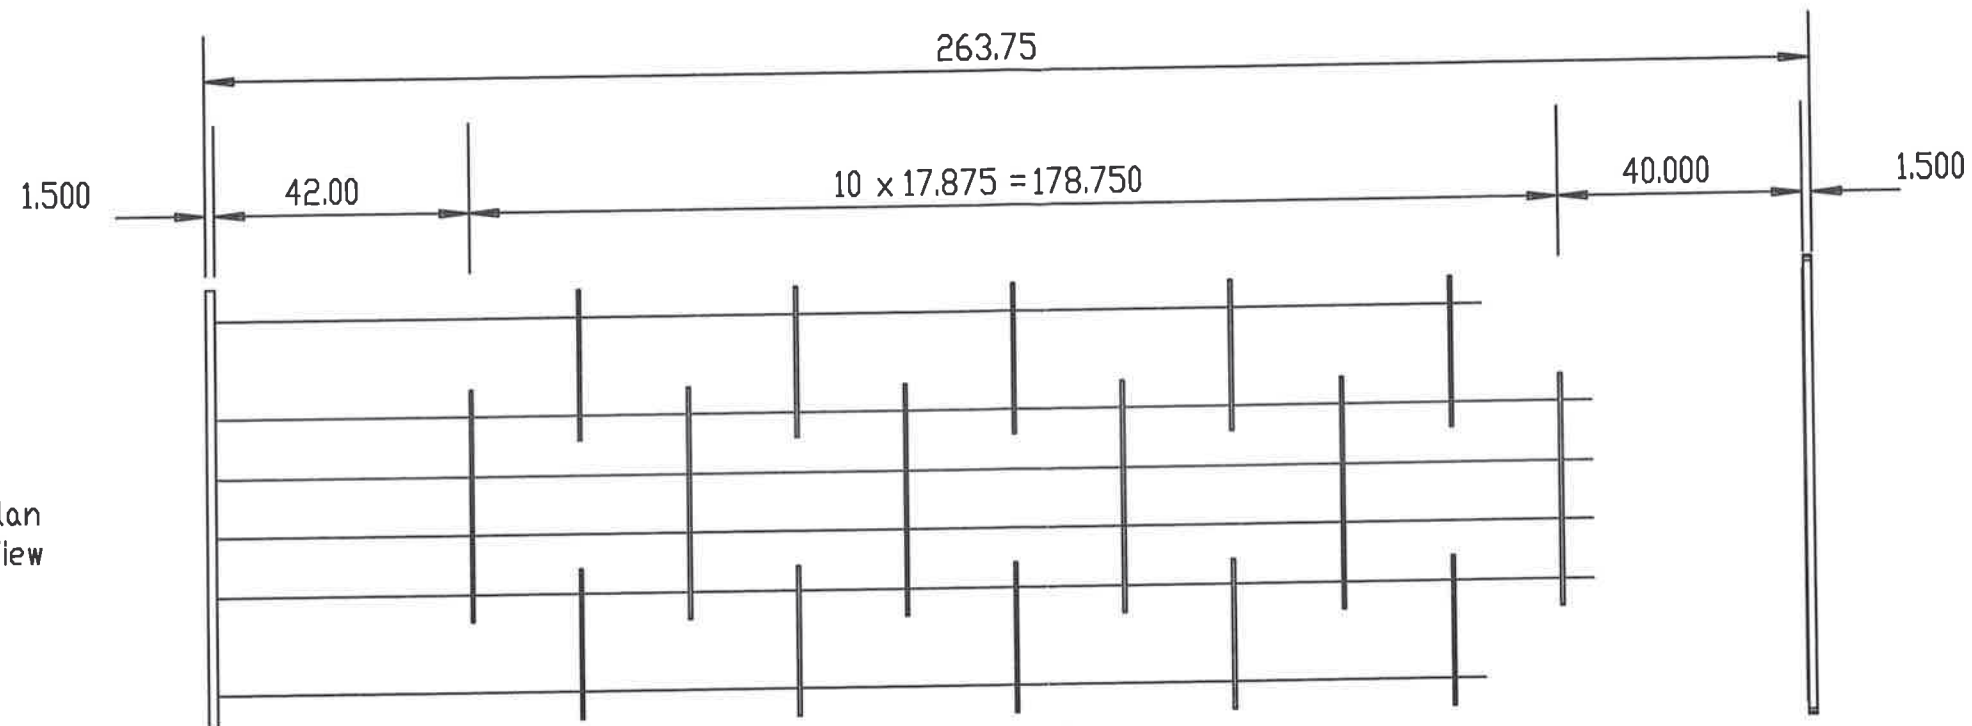

Elevation
View

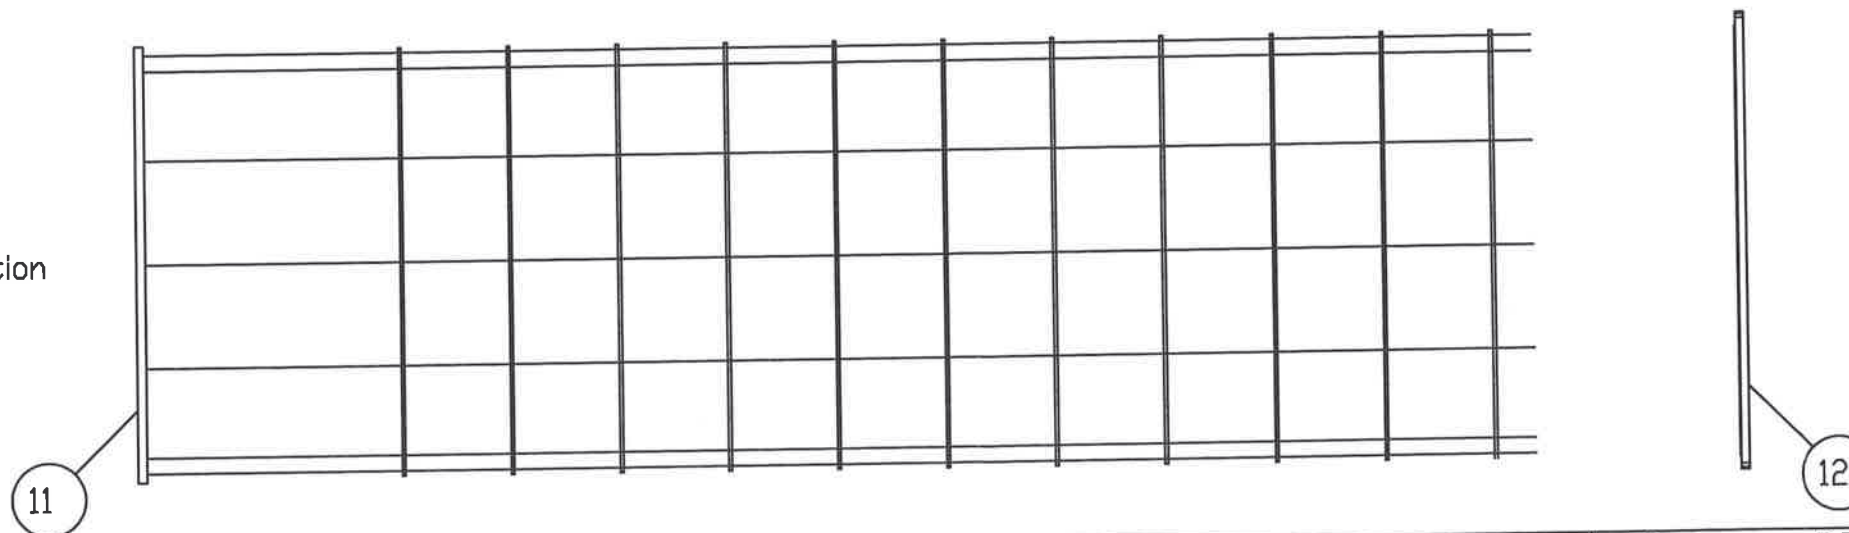

12

HT/DCR
Engineering, Inc.
2830 Parkway Street • Lakeland, FL 33811
Phone: 863-904-2880 • Fax: 863-913-1091
Florida Engineering Business License No. 28522

This drawing contains intellectual property of HT/DCR Engineering, Inc. All ideas, designs, arrangements and know-how remain the property of HT/DCR Engineering, Inc. Any use of this information by entities other than the title block named entity is prohibited. Use of this drawing by the title block named entity is limited to the specific title block named project. Use on other projects is strictly prohibited.


Notes:
All Dimensions In Inches
Bolt holes to straddle centerlines
Weld joint details per drawing 20

Company: DCR Construction, Inc.
Location: Bunge-Ergon
Evaporator Condenser
Item No: E-4504
Date: May 5, 2007 Job No: 7793


DCR Construction, Inc.
Lakeland, Florida

Scale: NTS

Rev	Date	Description	Dwg	Ckd	Appd	ASME VIII-1 2004 A06	Bundle Detail	
1	08-22-07	ISSUED FOR CONSTRUCTION	KFF	DGB	PW	TEMA Type: NEM	Dwg No: E-4504 11	Rev: 3
2	08-30-07	REVISED PER CLIENT	KFF	DGB	PW	Size: 71-264		
3	01-09-08	CERTIFIED AS-BUILT	AGB	DGB	PW	TEMA Class: C		

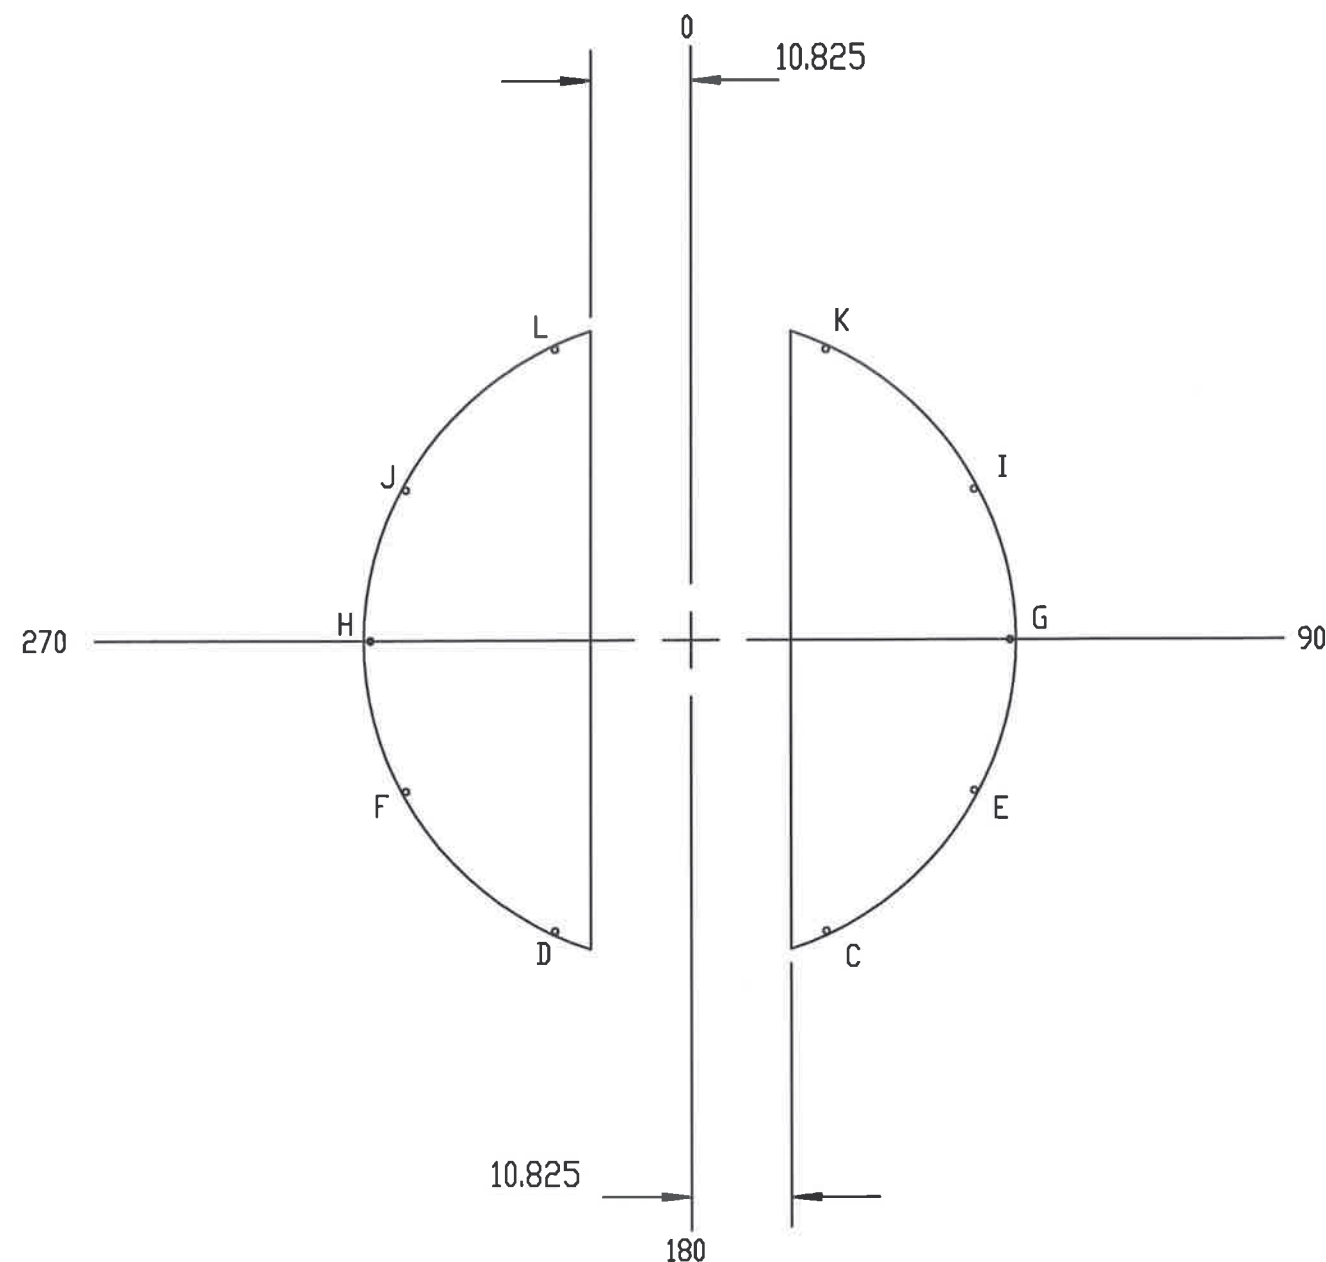

(39 A) 5 Baffles 70.625 O.D. 0.500 Tk

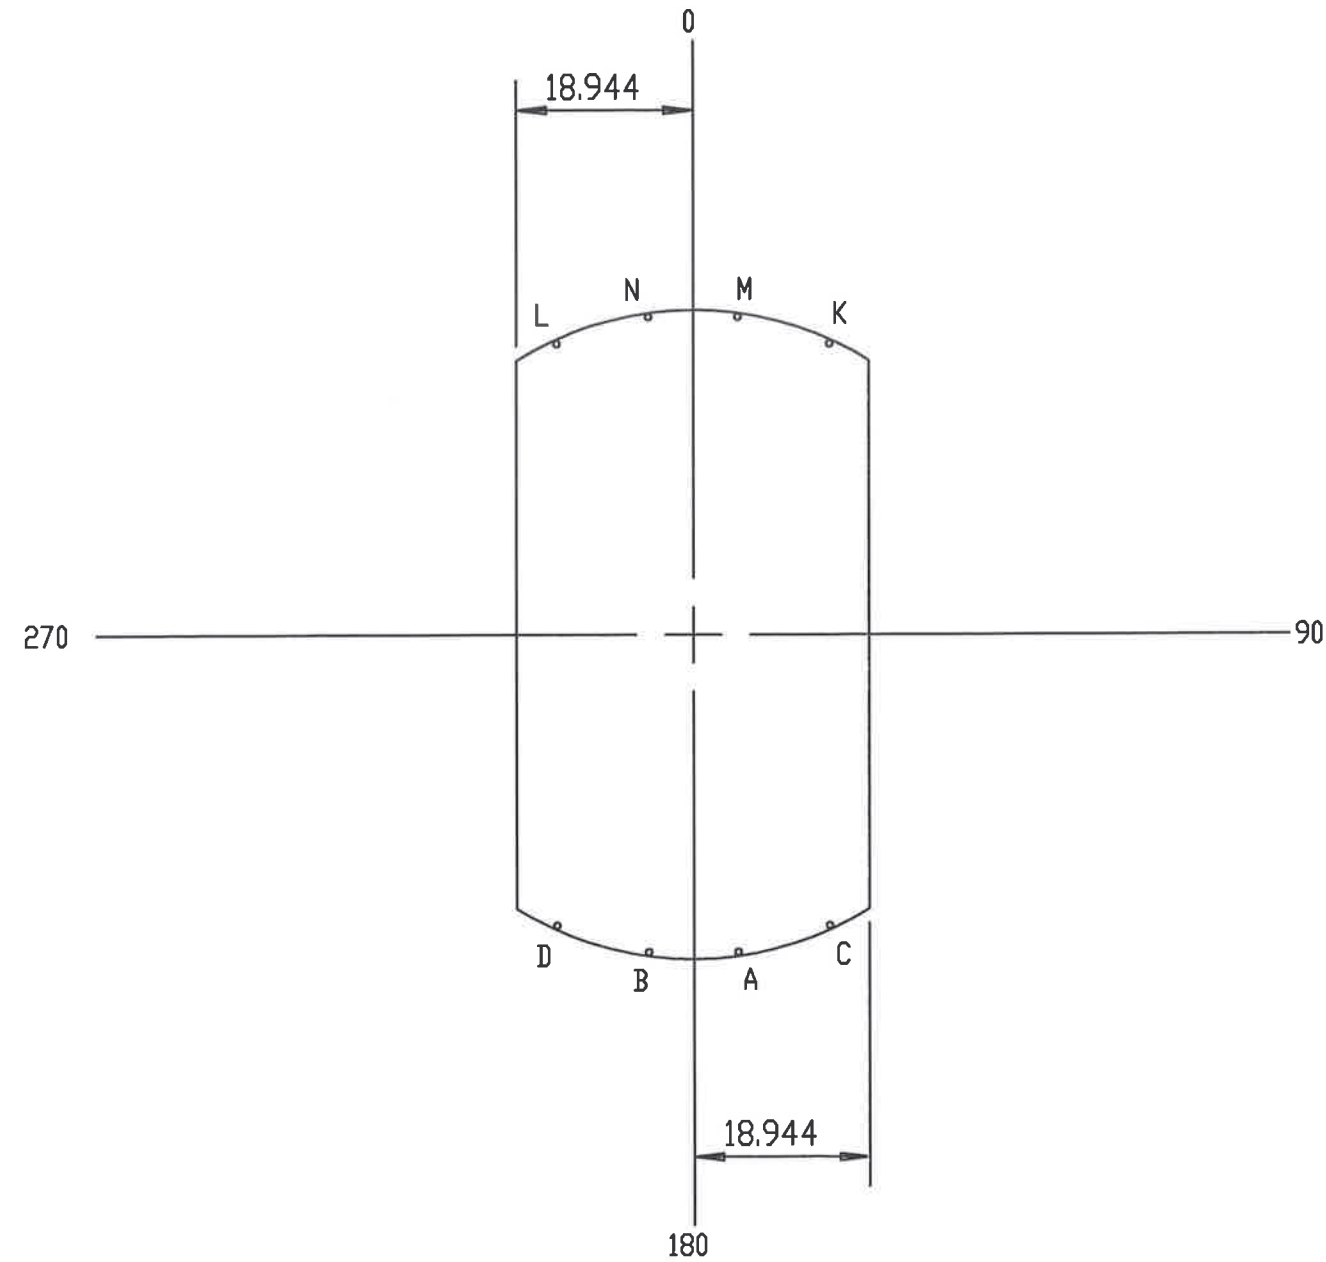

(39 B) 6 Baffles 70.625 O.D. 0.500 Tk

Notes:
All Dimensions In Inches
Weld joint details per drawing 20






This drawing contains intellectual property of HT/DCR Engineering, Inc. All ideas, designs, arrangements and know-how remain the property of HT/DCR Engineering, Inc. Any use of this information by entities other than the title block named entity is prohibited. Use of this drawing by the title block named entity is limited to the specific title block named project. Use on other projects is strictly prohibited.

Company: DCR Construction, Inc.
Location: Bunge-Ergon
Evaporator Condenser
Item No: E-4504
Date: May 5, 2007 Job No: 7793

DCR Construction, Inc.
Lakeland, Florida

Scale: NTS

Rev:	Date:	Description	Dwg	Ckd	Appd	ASME VIII-1 2004 A06	Baffle Detail	Dwg No: E-4504 12	Rev: 2
1	08-22-07	ISSUED FOR CONSTRUCTION	KFF	DGB	PW	TEMA Type: NEM			
2	01-09-08	CERTIFIED AS-BUILT	AGB	DGB	PW	Size: 71-264			
						TEMA Class: C			

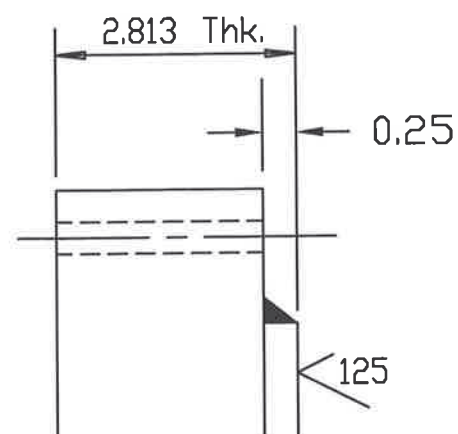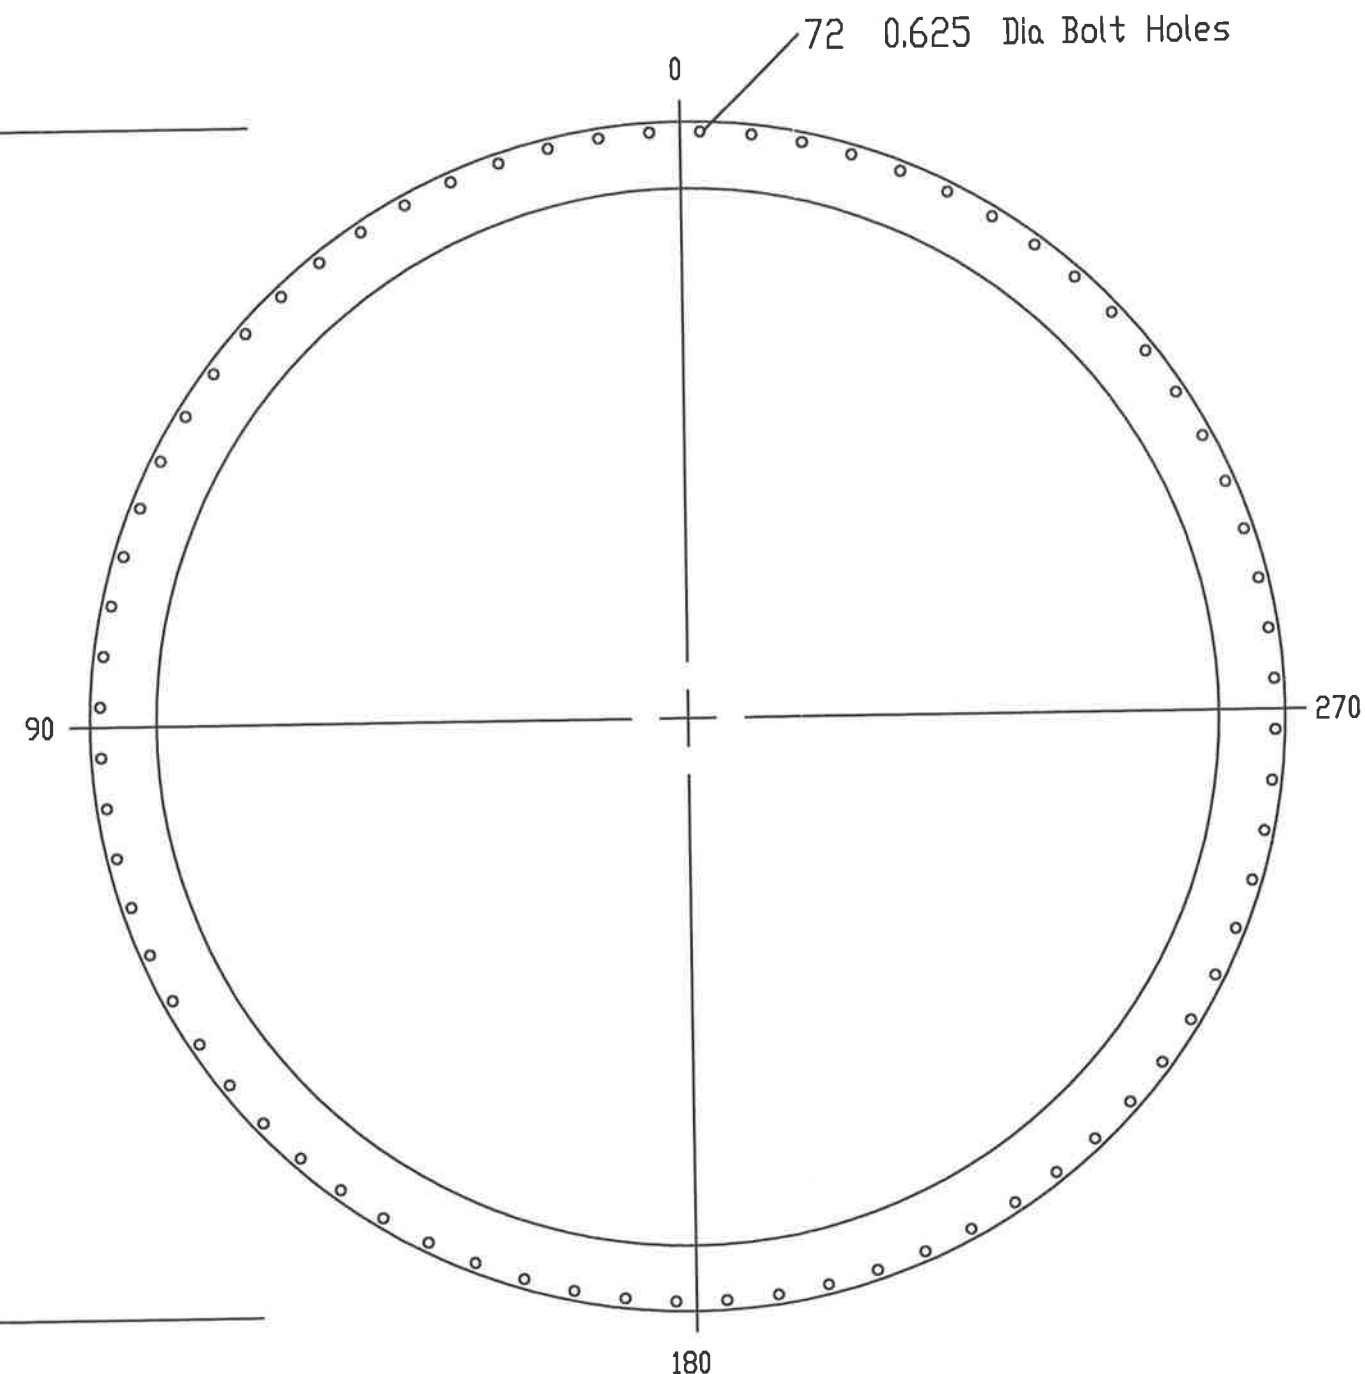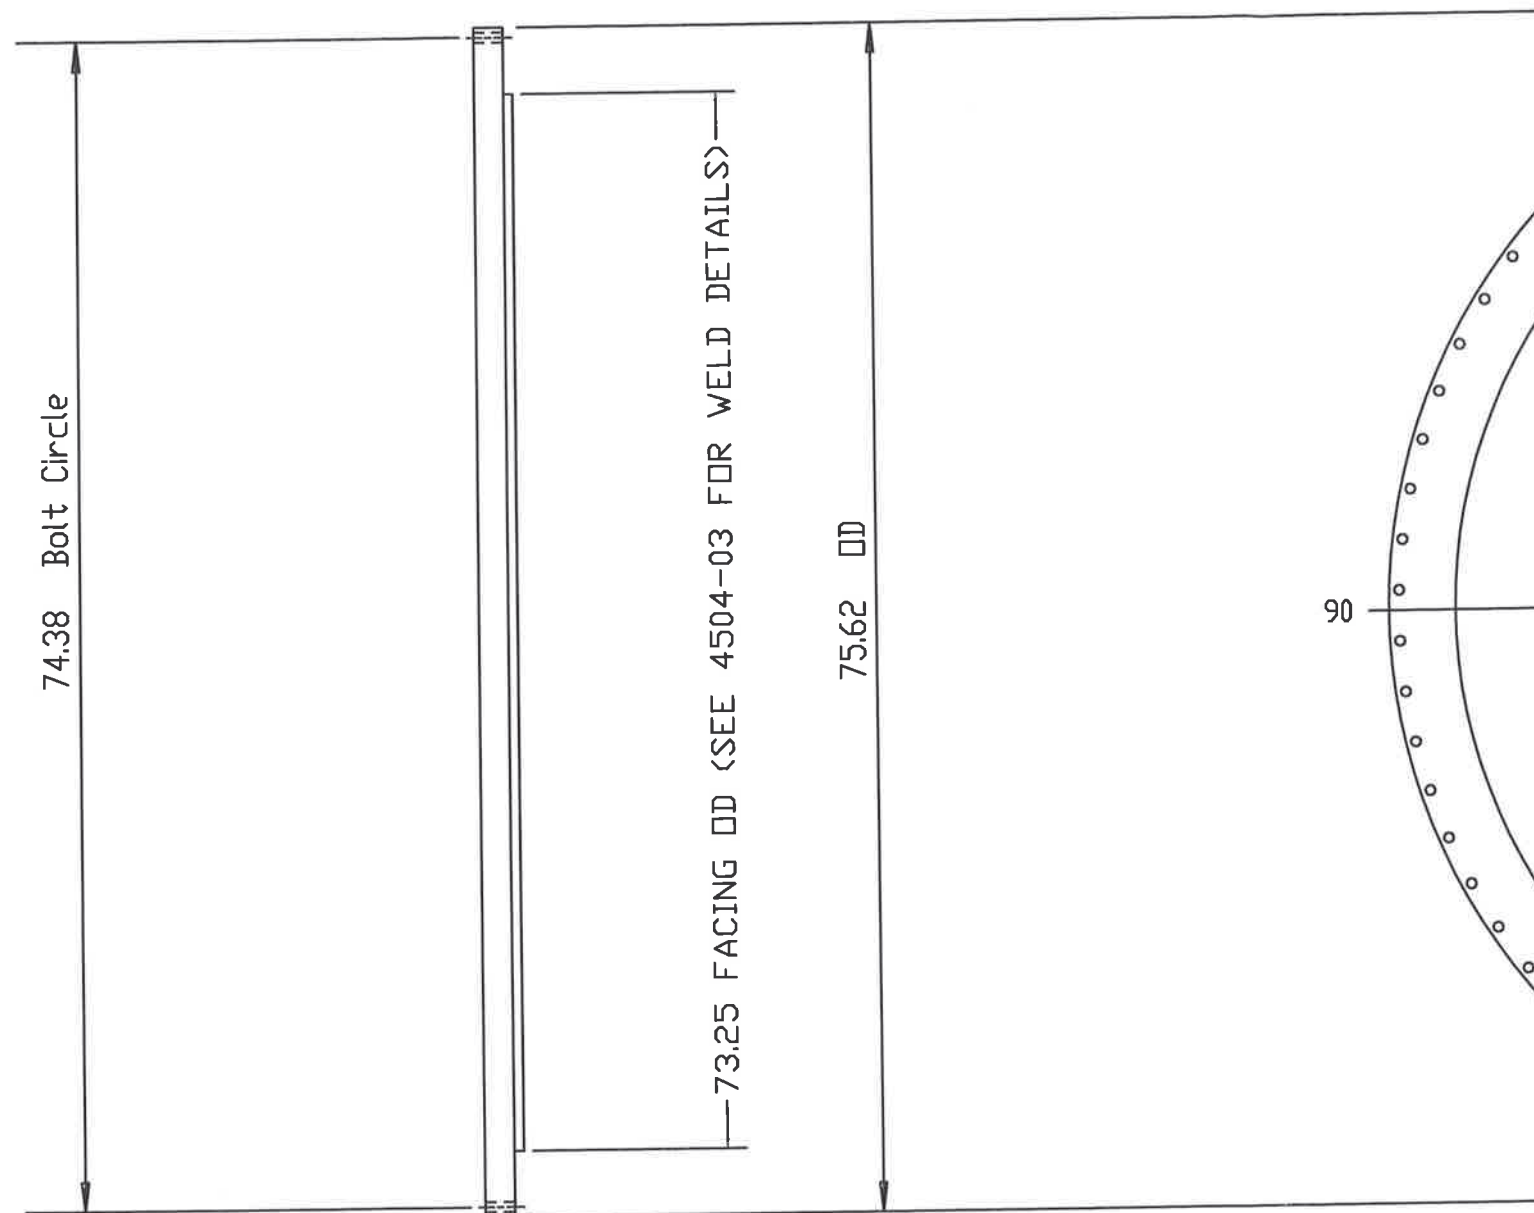

5 Front Head Cover

Notes:
All Dimensions In Inches
Bolt holes to straddle centerlines

HT/DCR
Engineering, Inc.
2830 Parkway Street • Lakeland, FL 33811
Phone: 863-904-2500 • Fax: 863-913-1971
Florida Engineering Business License No. 20522




This drawing contains intellectual property of HT/DCR Engineering, Inc. All ideas, designs, arrangements and know-how remain the property of HT/DCR Engineering, Inc. Any use of this information by entities other than the title block named entity is prohibited. Use of this drawing by the title block named entity is limited to the specific use block named project. Use on other projects is strictly prohibited.

Company: DCR Construction, Inc.
Location: Bunge-Ergon
Evaporator Condenser
Item No: E-4504
Date: May 5, 2007 Job No: 7793

DCR Construction, Inc.
Lakeland, Florida

Scale: NTS

Rev:	Date:	Description	Dwg	Ckd	Appd	ASME VIII-1 2004 A06	Flat Cover Detail	
1	08-22-07	ISSUED FOR CONSTRUCTION	KFF	DGB	PW	TEMA Type: NEM	Dwg No: E-4504 13	Rev: 3
2	09-25-07	CHANGED ALLOY FACING	KFF	DGB	PW	Size: 71-264		
3	01-09-08	CERTIFIED AS-BUILT	AGB	DGB	PW	TEMA Class: C		

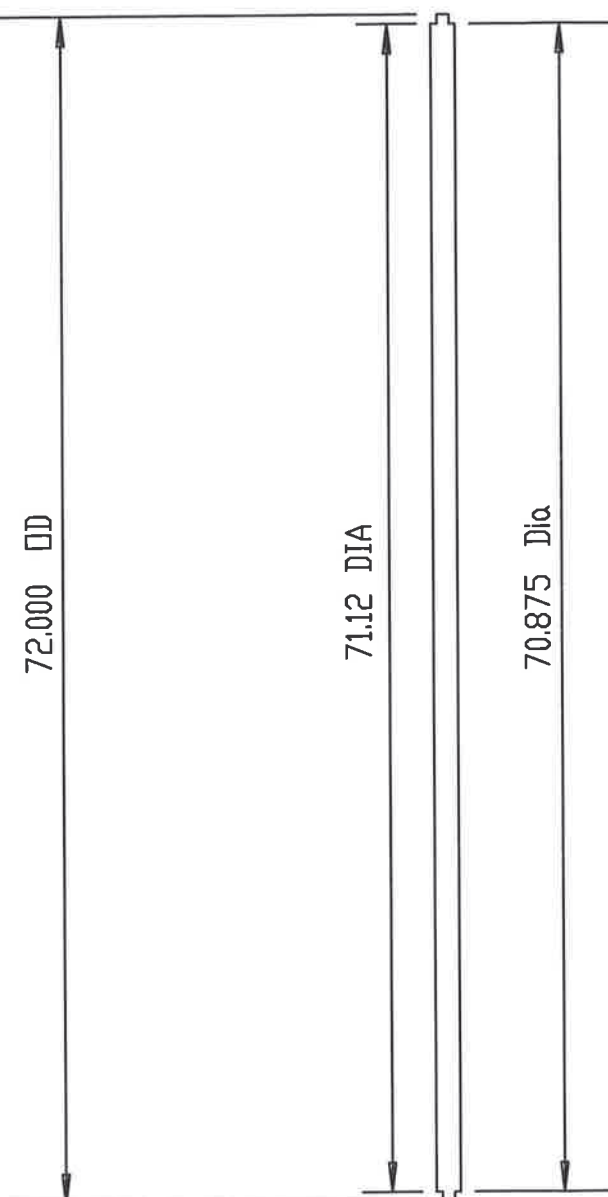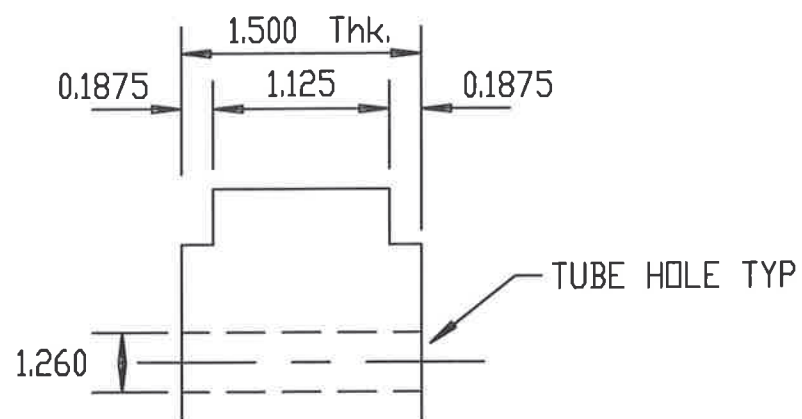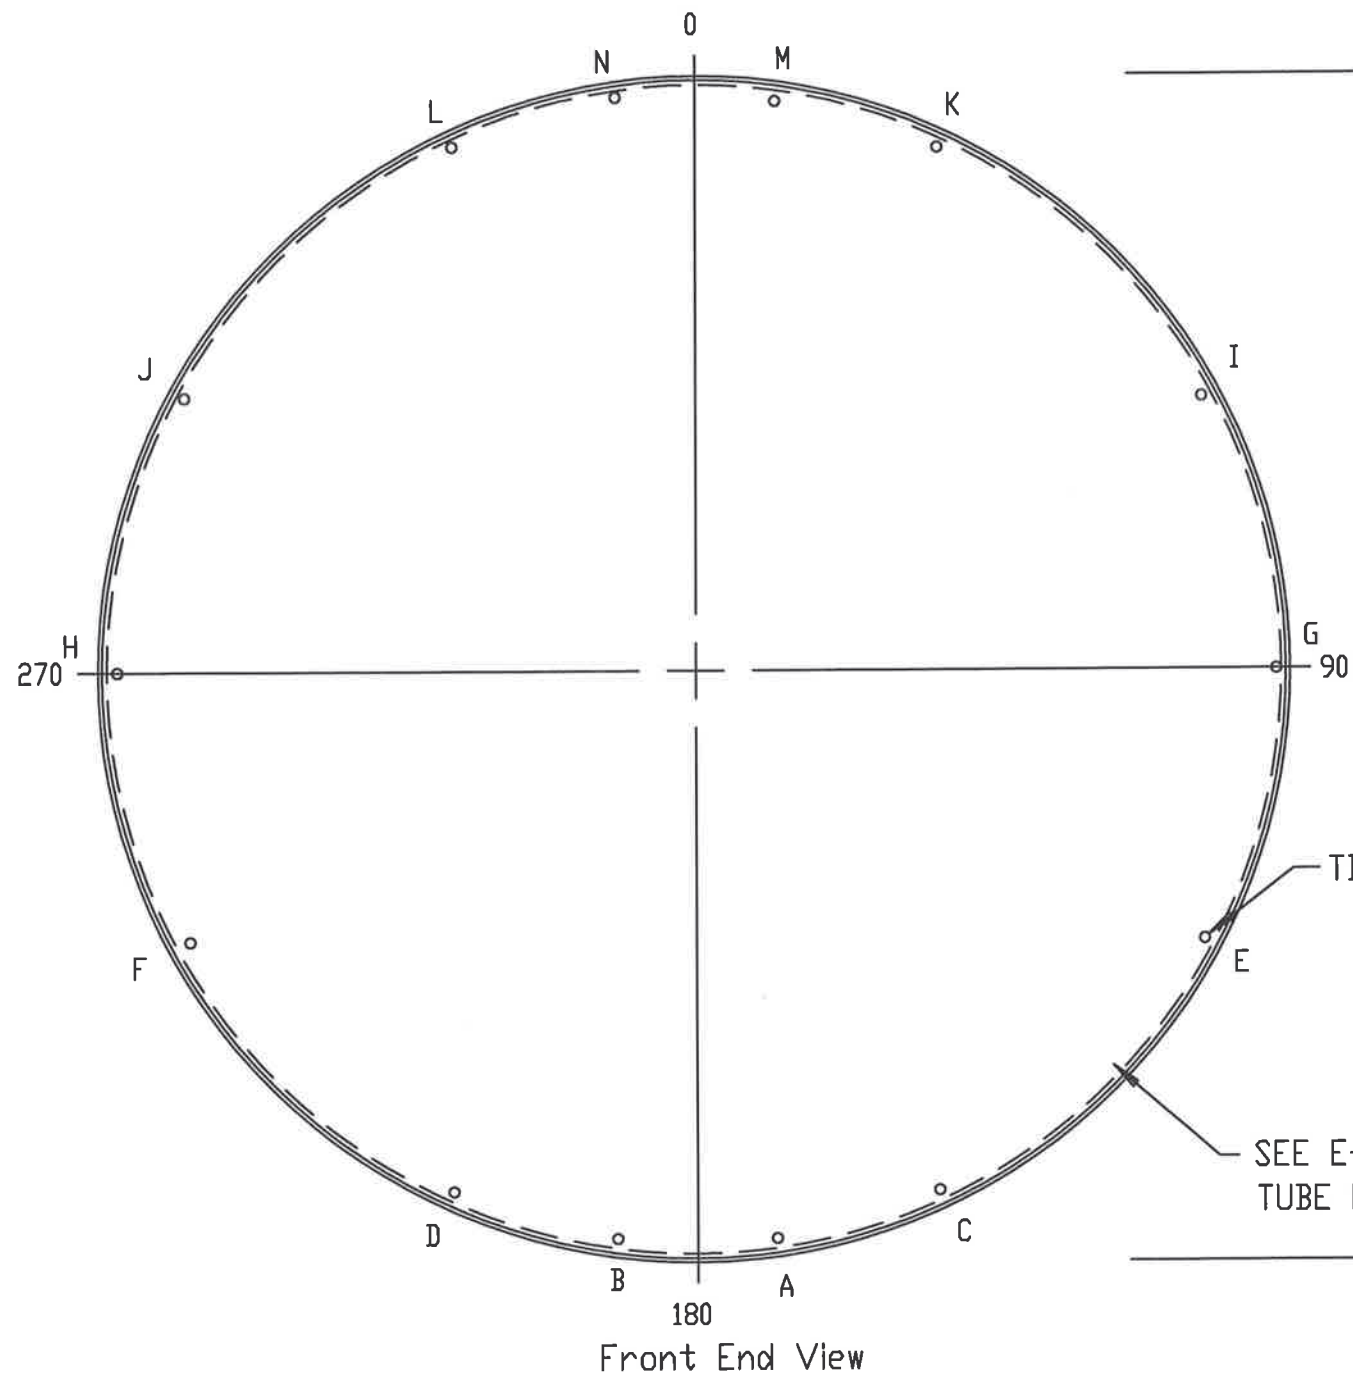

13 Front TubSh

Notes:
All Dimensions In Inches
Bolt holes to straddle centerlines

HT/DCR
Engineering, Inc.
2830 Parkway Street • Lakeland, FL 33811
Phone: 863-964-2800 • Fax: 863-913-1091
Florida Engineering Business License No. 26522




This drawing contains intellectual property of HT/DCR Engineering, Inc. All ideas, designs, arrangements and know-how remain the property of HT/DCR Engineering, Inc. Any use of this information by entities other than the title block named entity is prohibited. Use of this drawing by the title block named entity is limited to the specific title block named project. Use on other projects is strictly prohibited.

Company: DCR Construction, Inc.
Location: Bunge-Ergon
Evaporator Condenser
Item No: E-4504
Date: May 5, 2007 Job No: 7793

DCR Construction, Inc.
Lakeland, Florida

Scale: NTS

Rev:	Date:	Description	Dwg	Ckd	Appd	ASME VIII-1 2004 A06	Front Tubesheet Detail	
1	08-22-07	ISSUED FOR CONSTRUCTION	KFF	DGB	PW	TEMA Type: NEM	Dwg No: E-4504 14	Rev: 2
2	01-09-08	CERTIFIED AS-BUILT	AGB	DGB	PW	Size: 71-264 TEMA Class: C		

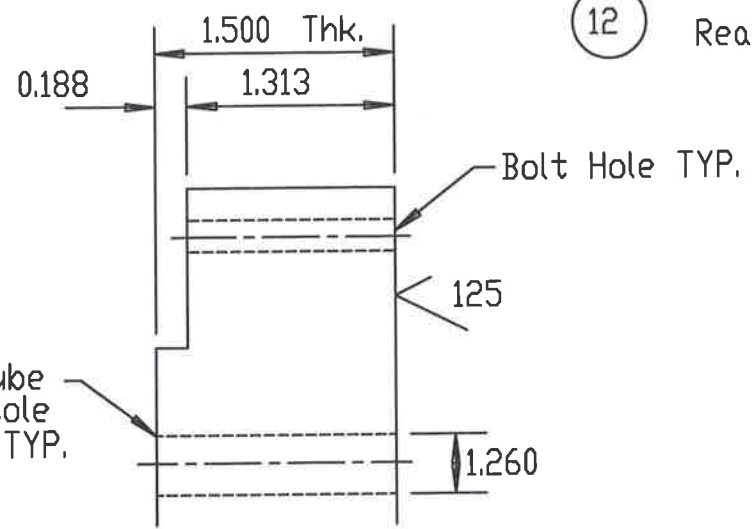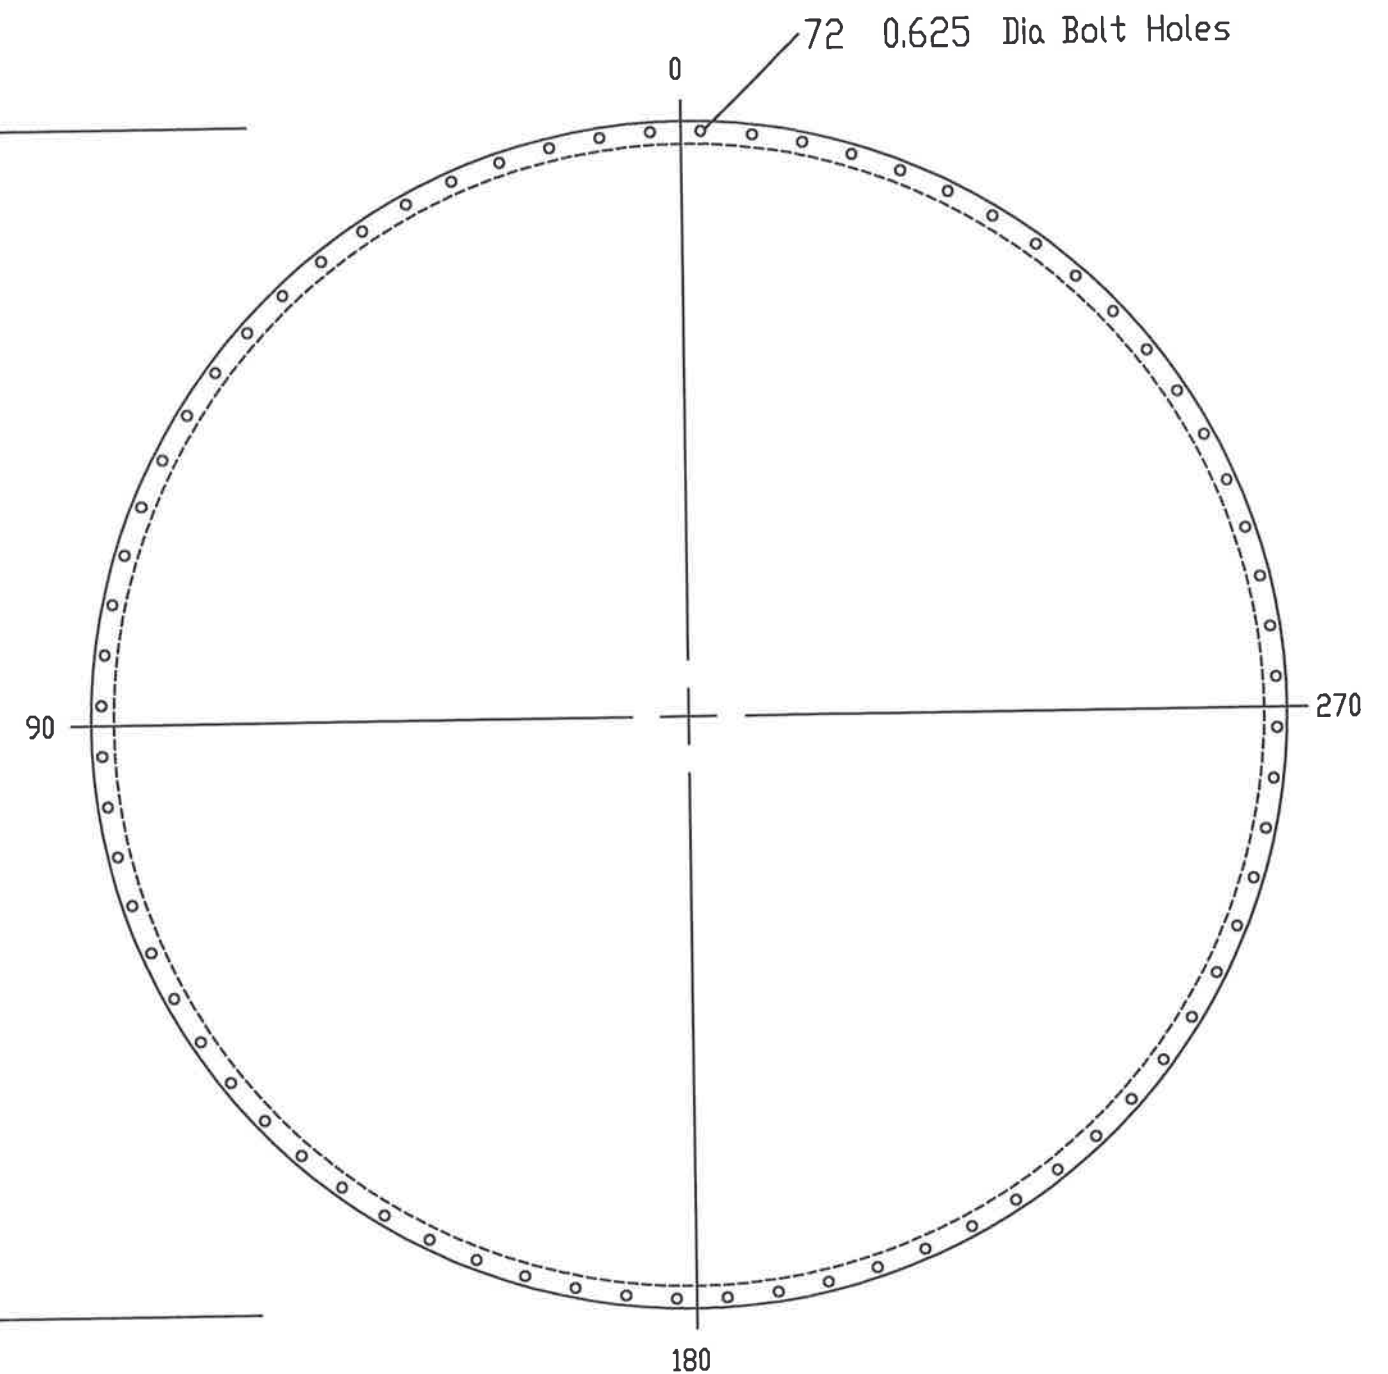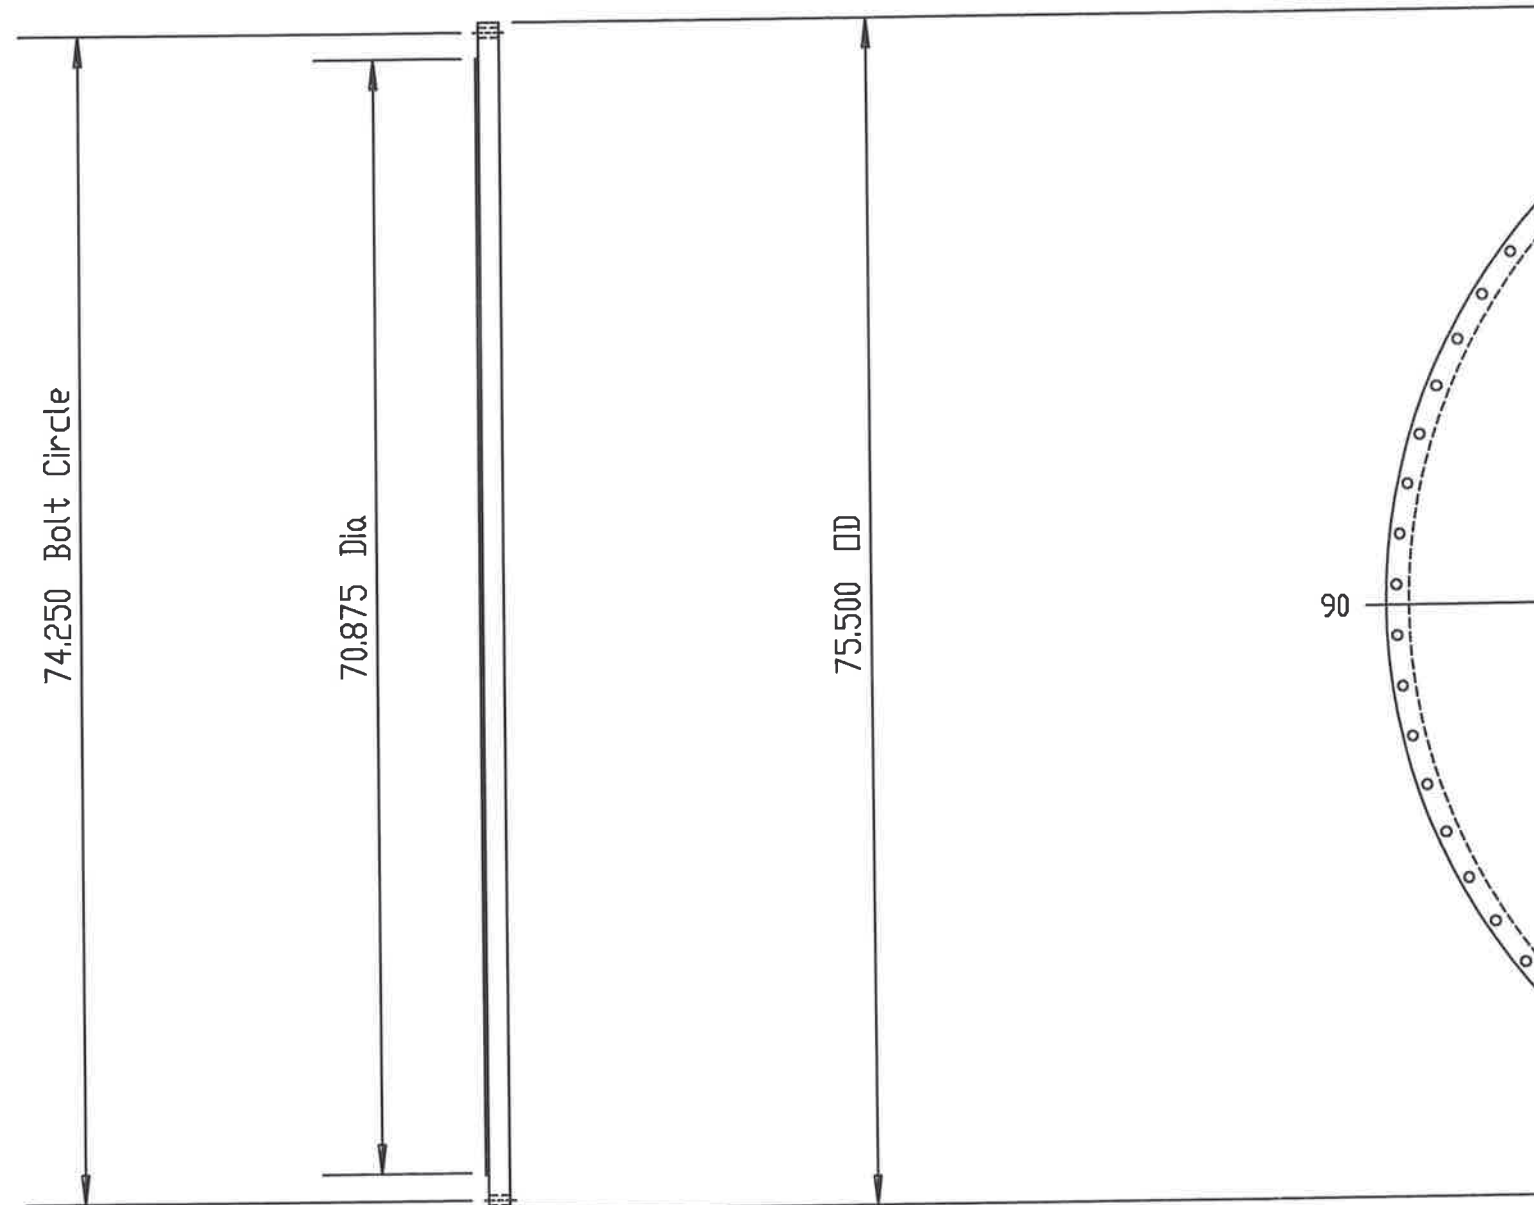

12 Rear TubSh


Notes:
All Dimensions In Inches
Bolt holes to straddle centerlines

HT/DCR
Engineering, Inc.
2830 Parkway Street • Lakeland, FL 33811
Phone: 863-904-2800 • Fax: 863-913-1091
Florida Engineering Business License No. 26522

Company: DCR Construction, Inc.
Location: Bunge-Ergon
Evaporator Condenser
Item No: E-4504
Date: May 5, 2007 Job No: 7793

DCR Construction, Inc.
Lakeland, Florida

Scale: NTS									
Rev:	Date:	Description	Dwg	Ckd	Appd	ASME VIII-1 2004 A06	Rear Tubesheet Detail		
1	08-22-07	ISSUED FOR CONSTRUCTION	KFF	DGB	PW	TEMA Type: NEM			
2	01-09-08	CERTIFIED AS-BUILT	AGB	DGB	PW	Size: 71-264	Dwg No: E-4504 15		Rev: 2
						TEMA Class: C			

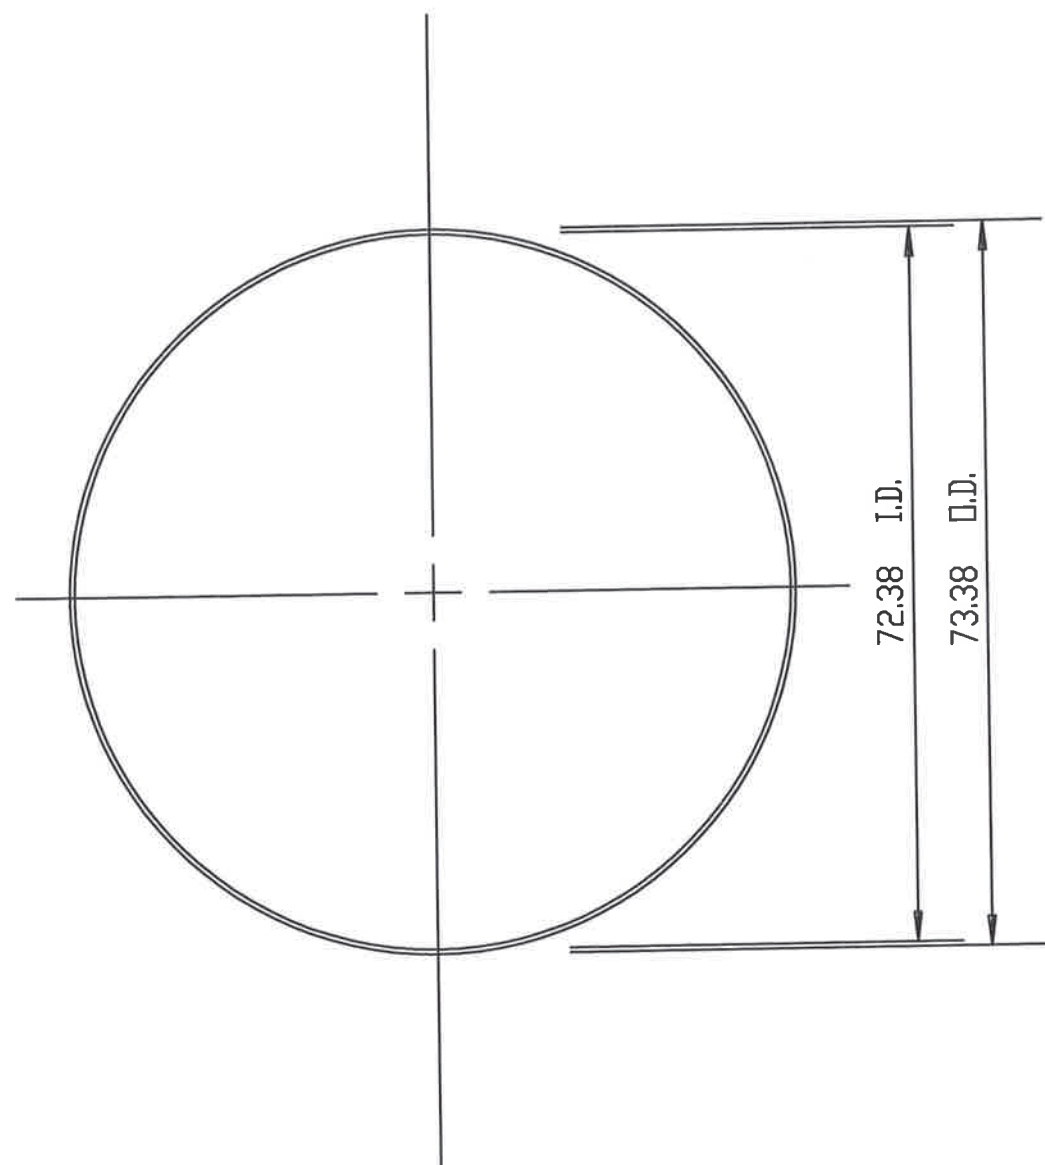

33 Front Head Gasket at Cover

0.125 Thk.

HT/DCR
Engineering, Inc.

2830 Parkway Street • Lakeland, FL 33811
Phone: 863-604-2880 • Fax: 863-613-1091
Florida Engineering Business License No. 26522

This drawing contains intellectual property of HT/DCR Engineering, Inc. All ideas, designs, arrangements and know-how remain the property of HT/DCR Engineering, Inc. Any use of this information by entities other than the title block named entity is prohibited. Use of this drawing by the title block named entity is limited to the specific title block named project. Use on other projects is strictly prohibited.

Notes:
All Dimensions In Inches
Bolt holes to straddle centerlines

Company: DCR Construction, Inc.
Location: Bunge-Ergon
Evaporator Condenser
Item No: E-4504
Date: May 5, 2007 Job No: 7793

DCR Construction, Inc.
Lakeland, Florida

Scale: NTS

Rev:	Date:	Description	Dwg	Ckd	Appd
1	08-22-07	ISSUED FOR CONSTRUCTION	KFF	DGB	PW
2	01-09-08	CERTIFIED AS-BUILT	AGB	DGB	PW

ASME VIII-1 2004 A06

TEMA Type: NEM


Size: 71-264

TEMA Class: C

Front Head Gasket Detail

Dwg No.:
E-4504 17A

Rev:
2

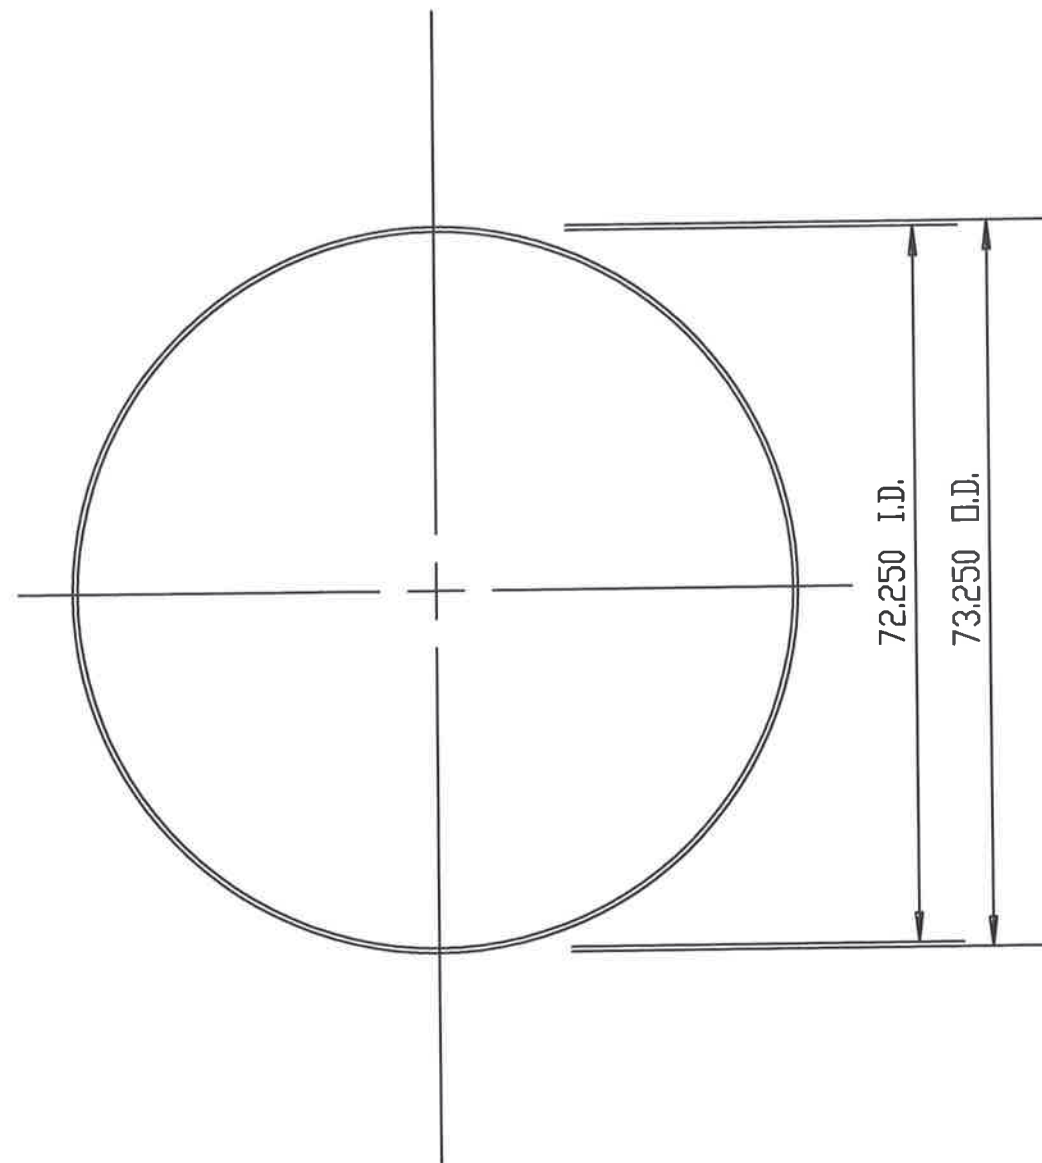

32 Rear Head Gasket at Tbsht
 0.125 Thk.

HT/DCR
 Engineering, Inc.
2830 Parkway Street • Lakeland, FL 33811
 Phone: 863-904-2800 • Fax: 863-913-1001
 Florida Engineering Business License No. 25522

This drawing contains intellectual property of HT/DCR Engineering, Inc. All ideas, designs, arrangements and know-how remain the property of HT/DCR Engineering, Inc. Any use of this information by entities other than the title block named entity is prohibited. Use of this drawing by the title block named entity is limited to the specific title block named project. Use on other projects is strictly prohibited.


Notes:
 All Dimensions In Inches
 Bolt holes to straddle centerlines

Company: DCR Construction, Inc.
 Location: Bunge-Ergon
 Evaporator Condenser
 Item No: E-4504
 Date: May 5, 2007 Job No: 7793

DCR Construction, Inc.
 Lakeland, Florida

Scale: NTS

Rev:	Date:	Description	Dwg	Ckd	Appd	ASME VIII-1 2004 A06	Rear Head Gasket Detail	
1	08-22-07	ISSUED FOR CONSTRUCTION	KFF	DGB	PW	TEMA Type: NEM		
2	01-09-08	CERTIFIED AS-BUILT	AGB	DGB	PW	Size: 71-264	Dwg No.: E-4504 17B	Rev: 2
						TEMA Class: C		

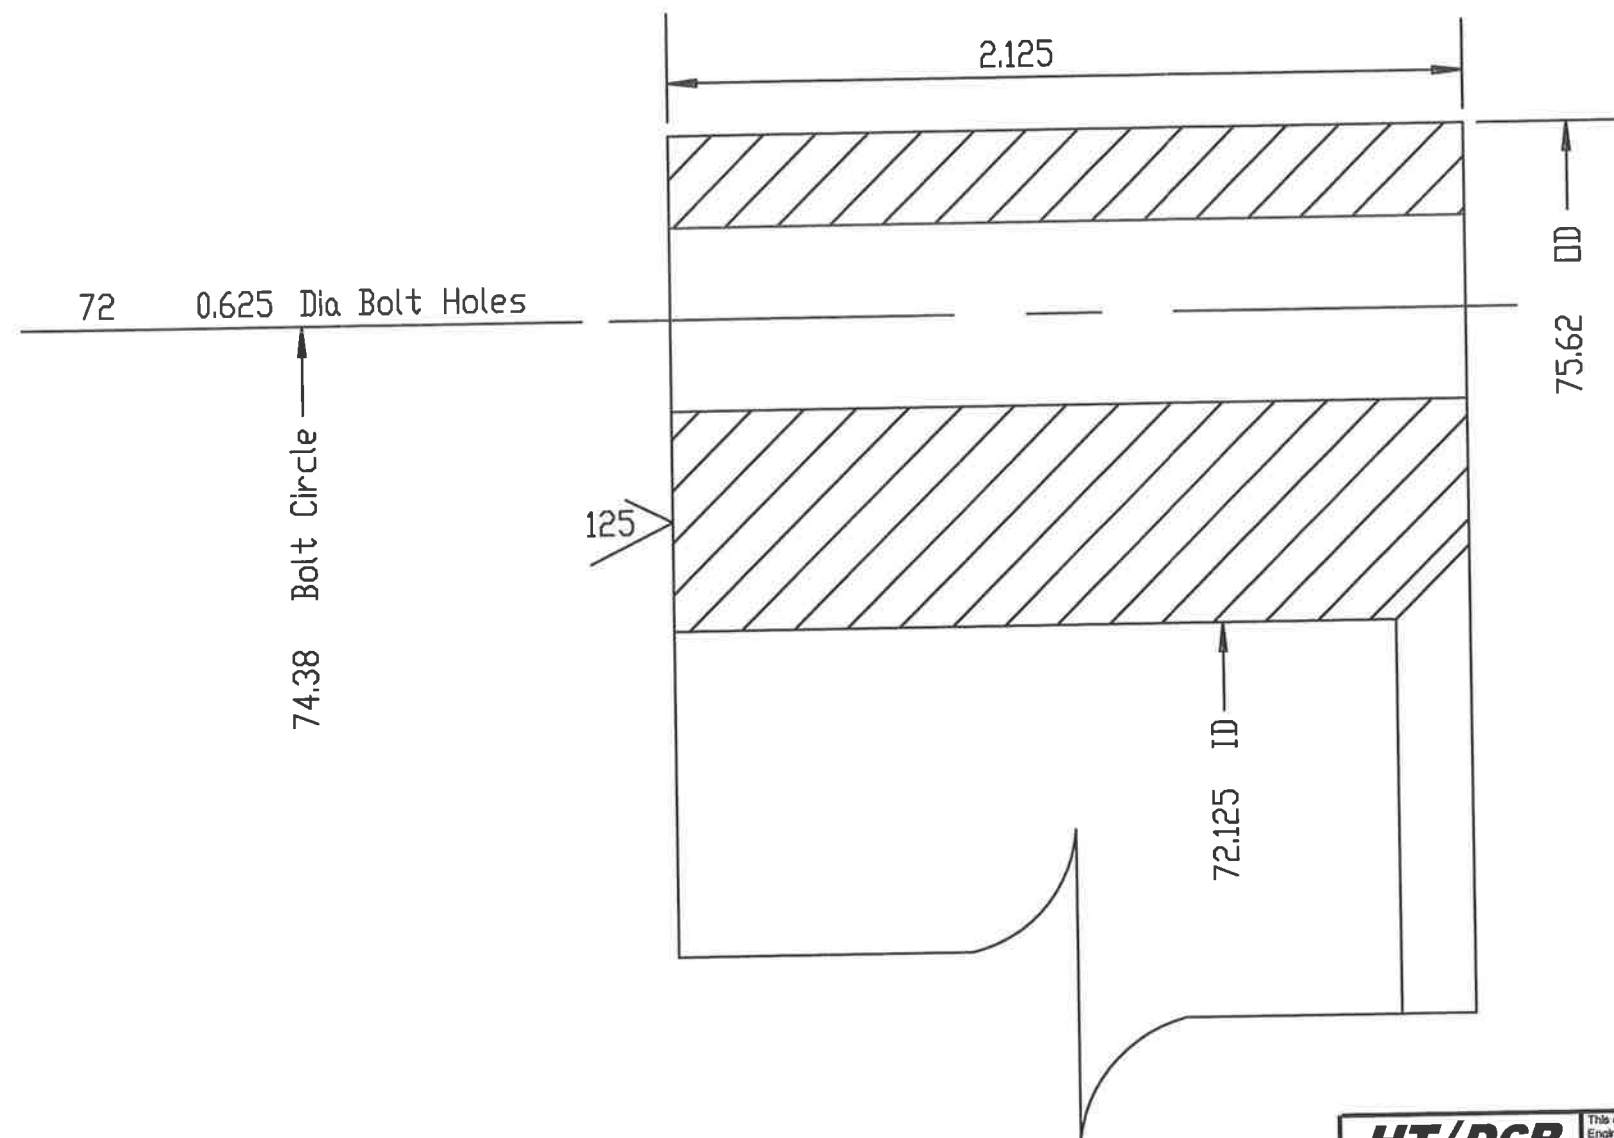

19 Fr Hd Flng

HT/DCR
Engineering, Inc.
2830 Parkway Street • Lakeland, FL 33811
Phone: 863-604-2880 • Fax: 863-613-1091
Florida Engineering Business License No. 26522

This drawing contains intellectual property of HT/DCR Engineering, Inc. All ideas, designs, arrangements and know-how remain the property of HT/DCR Engineering, Inc. Any use of this information by entities other than the title block named entity is prohibited. Use of this drawing by the title block named entity is limited to the specific title block named project. Use on other projects is strictly prohibited.


Notes:
All Dimensions In Inches
Bolt holes to straddle centerlines

Company: DCR Construction, Inc.
Location: Bunge-Ergon
Evaporator Condenser
Item No: E-4504
Date: May 5, 2007 Job No: 7793

DCR Construction, Inc.
Lakeland, Florida

Scale: NTS

Rev	Date	Description	Dwg	Ckd	Appd	ASME VIII-1 2004 A06	Flange Detail	
1	08-22-07	ISSUED FOR CONSTRUCTION	KFF	DGB	PW	TEMA Type: NEM	Dwg No: E-4504 18A	Rev: 2
2	01-09-08	CERTIFIED AS-BUILT	AGB	DGB	PW	Size: 71-264 TEMA Class: C		

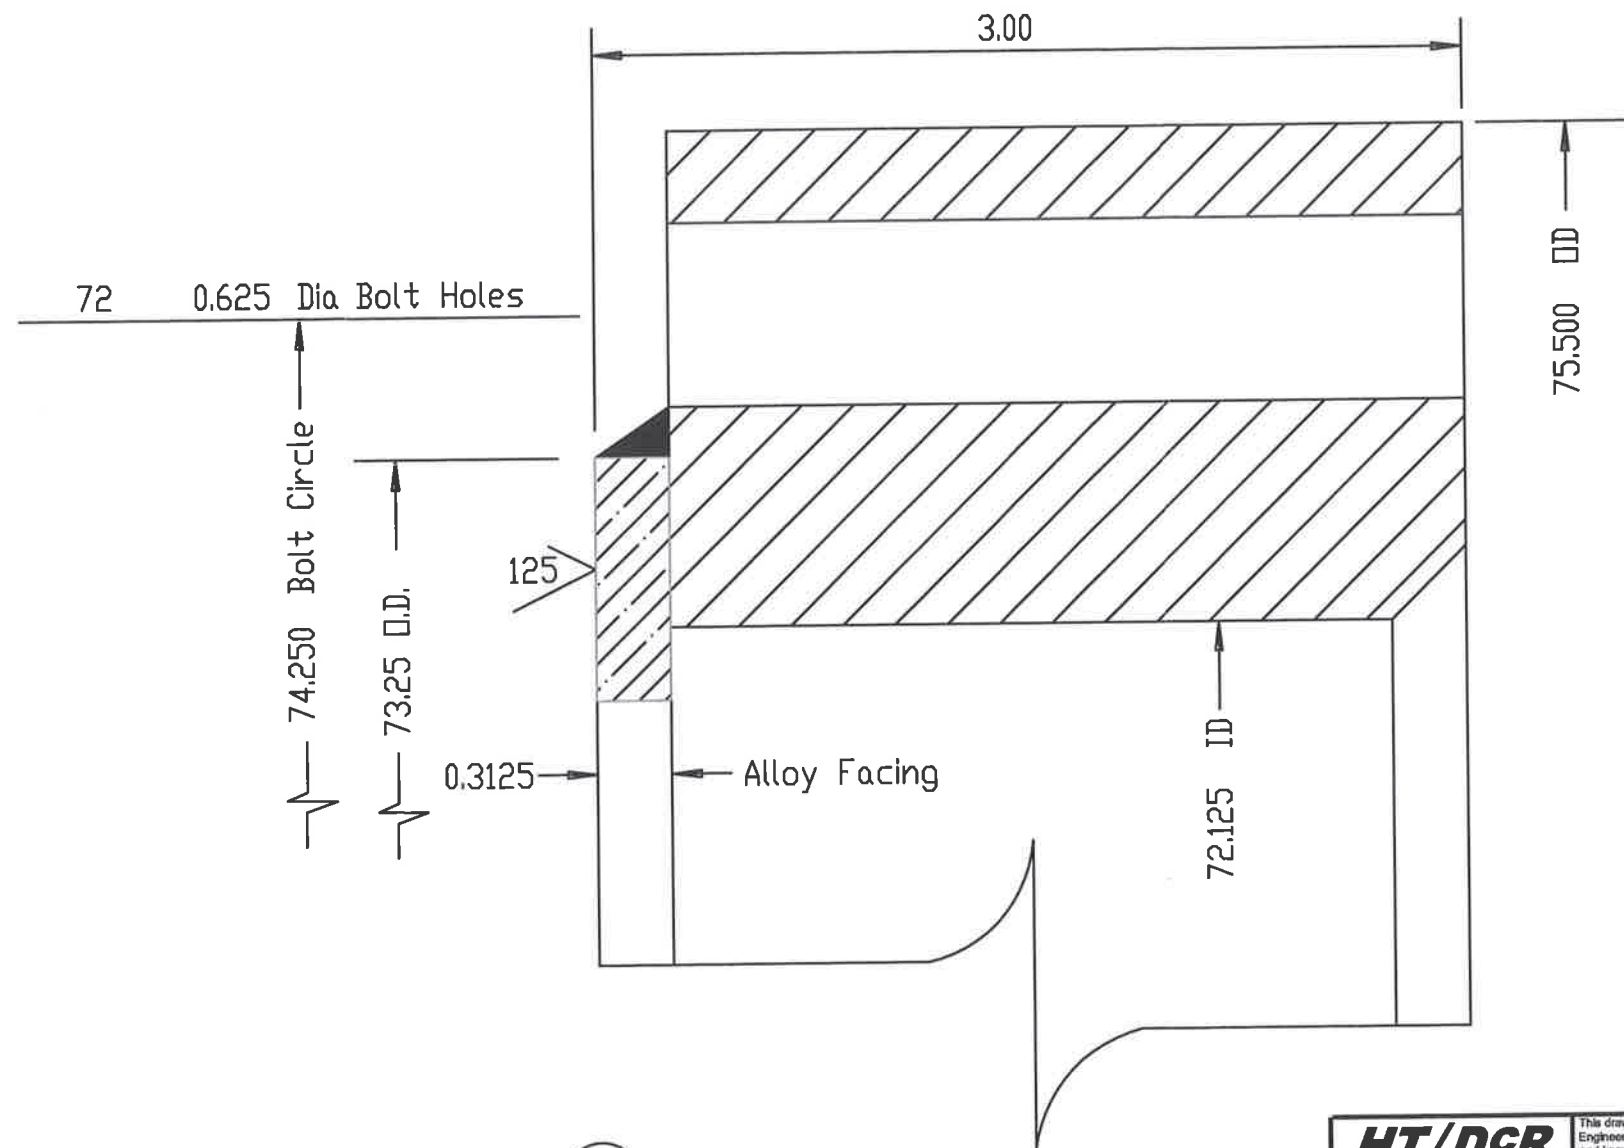

18 Re Hd Flng

HT/DCR
Engineering, Inc.
2800 Parkway Street • Lakeland, FL 33811
Phone: 863-944-2280 • Fax: 863-913-1091
Florida Engineering Business License No. 25522

This drawing contains intellectual property of HT/DCR Engineering, Inc. All ideas, designs, arrangements and know-how remain the property of HT/DCR Engineering, Inc. Any use of this information by entities other than the title block named entity is prohibited. Use of this drawing by the title block named entity is limited to the specific title block named project. Use on other projects is strictly prohibited.




Notes:
All Dimensions In Inches
Bolt holes to straddle centerlines

Company: DCR Construction, Inc.
Location: Bunge-Ergon
Evaporator Condenser
Item No: E-4504
Date: May 5, 2007 Job No: 7793

DCR Construction, Inc.
Lakeland, Florida


Scale: NTS

Rev	Date	Description	Dwg	Ckd	Appd	ASME VIII-1 2004 A06	Flange Detail	
1	08-22-07	ISSUED FOR CONSTRUCTION	KFF	DGB	PW	TEMA Type: NEM	Dwg No: E-4504 18B	Rev: 3
2	09-25-07	CHANGED ALLOW FACING	KFF	DGB	PW	Size: 71-264		
3	01-09-08	CERTIFIED AS-BUILT	AGB	DGB	PW	TEMA Class: C		

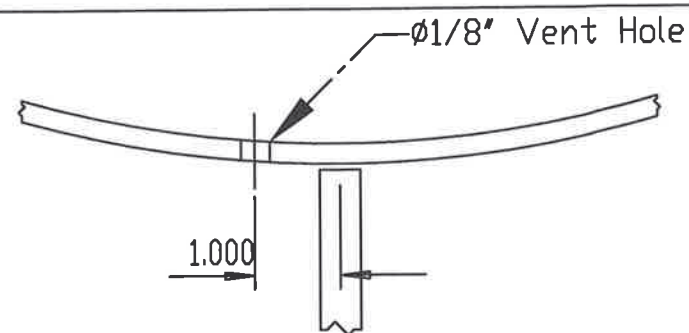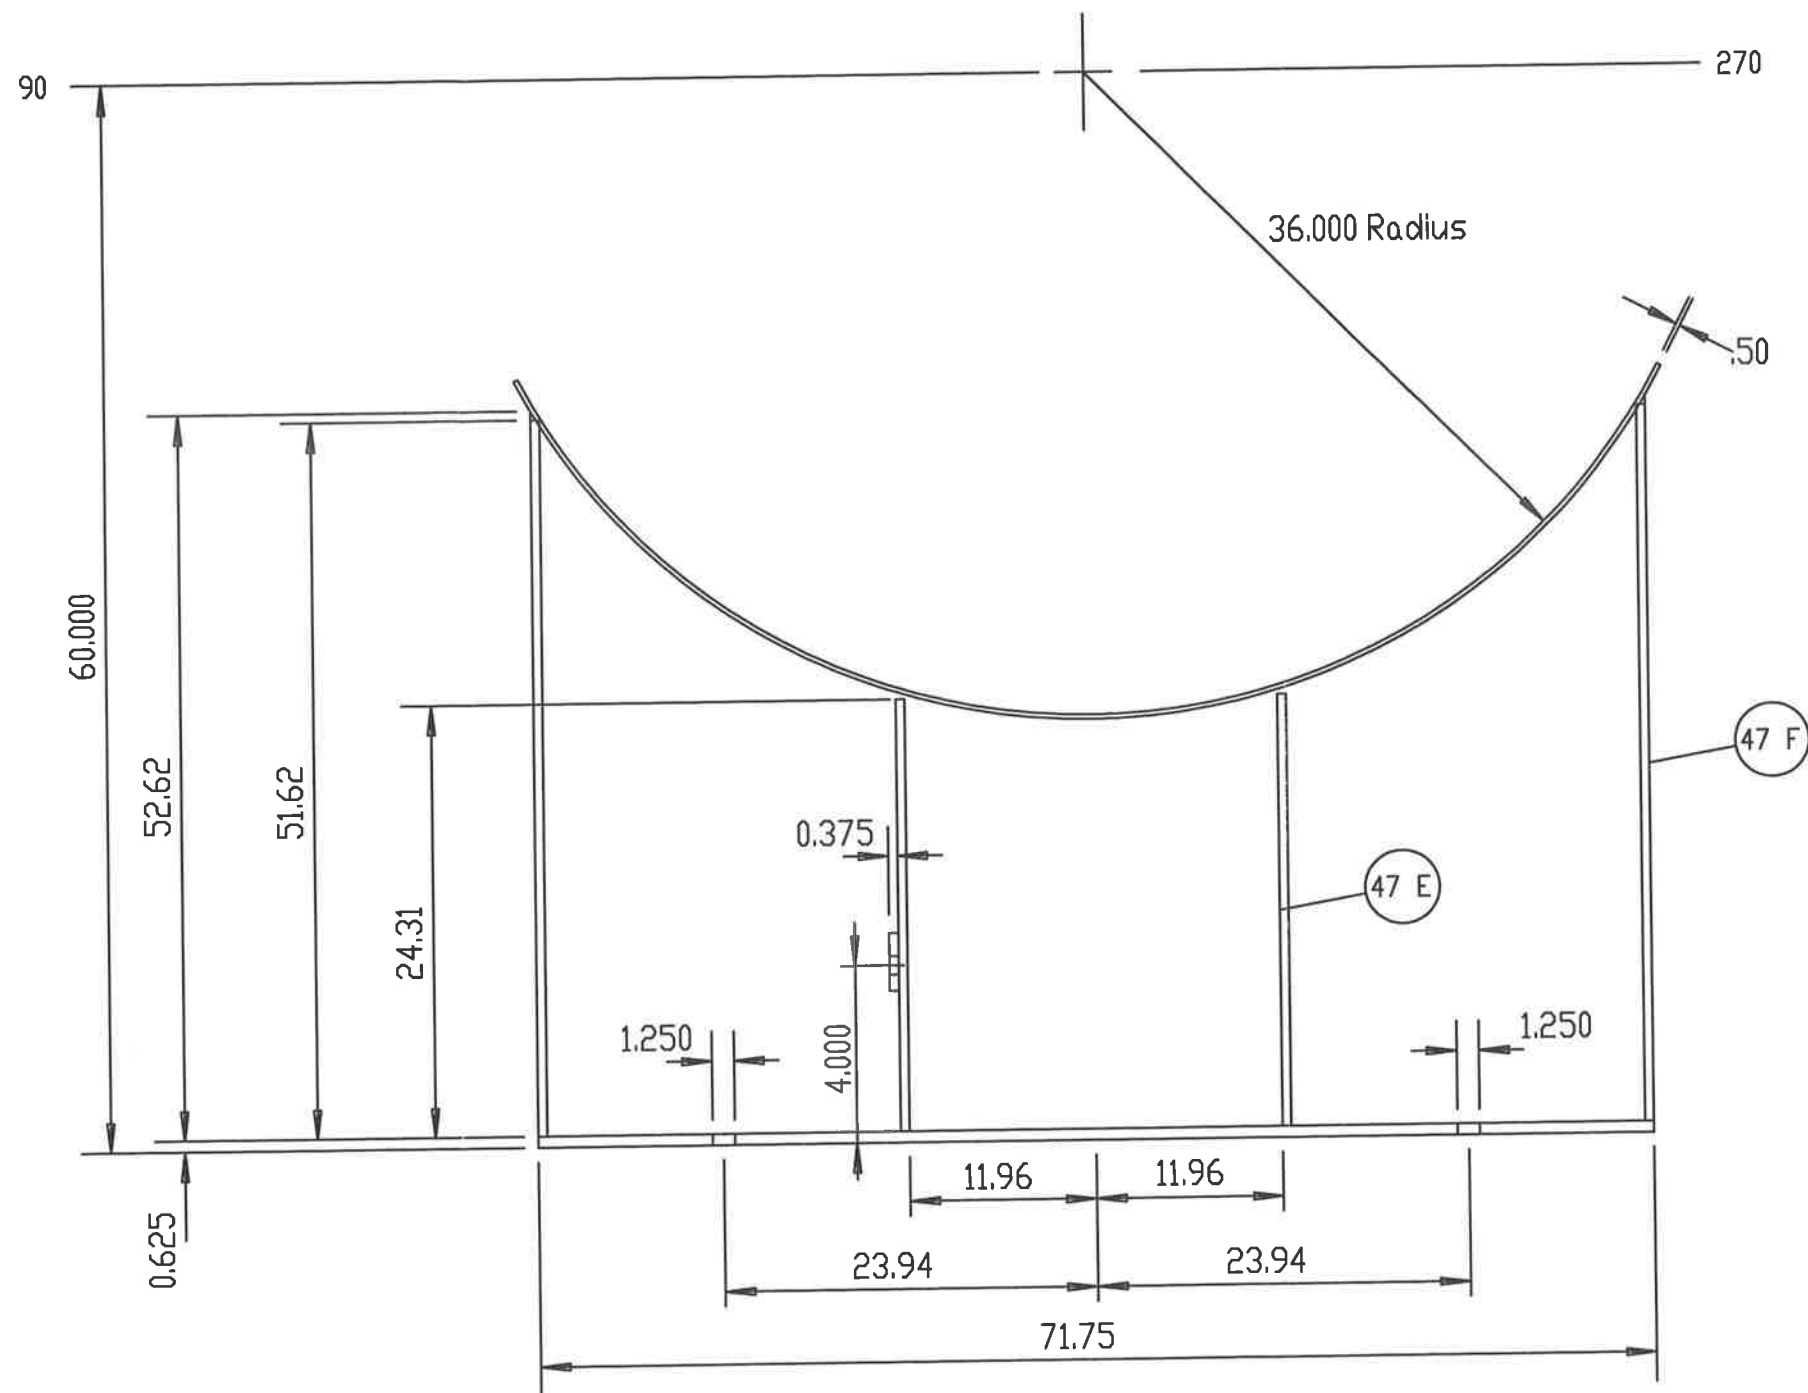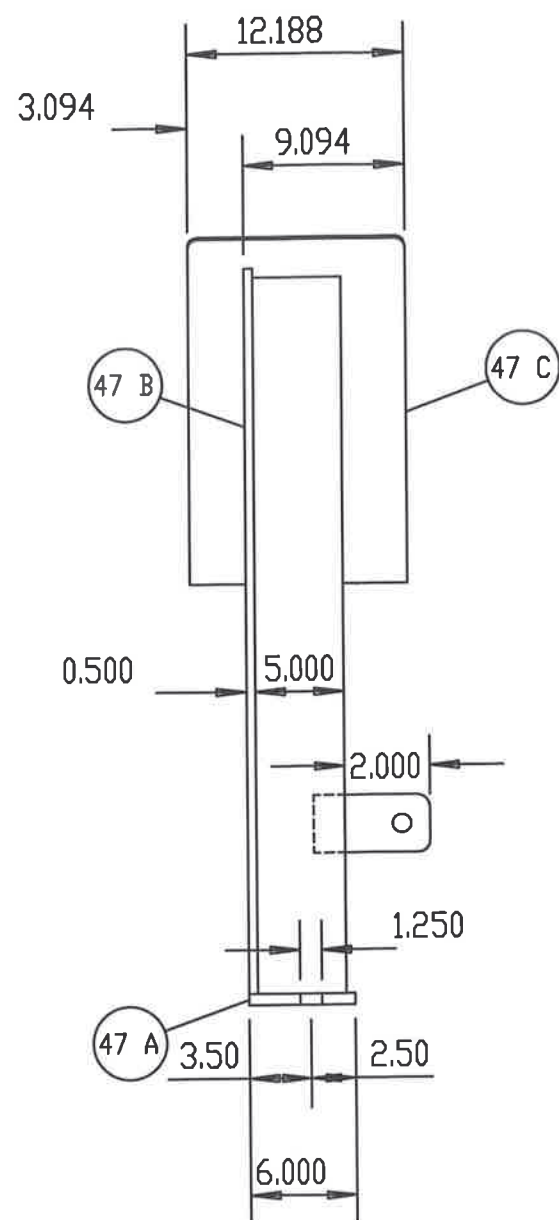

Front View

Vent Hole Detail (Not to Scale)

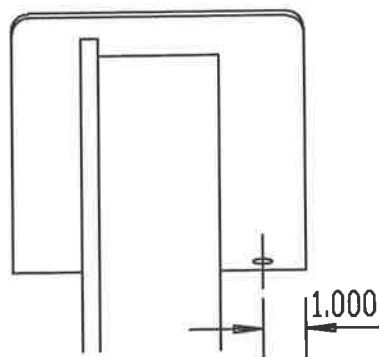

Side View

Notes:
All Dimensions In Inches

HT/DCR
Engineering, Inc.

2830 Parkway Street • Lakeland, FL 33811
Phone: 863-904-2880 • Fax: 863-913-1091
Florida Engineering Business License No. 26522



This drawing contains intellectual property of HT/DCR Engineering, Inc. All ideas, designs, arrangements and know-how remain the property of HT/DCR Engineering, Inc. Any use of this information by entities other than the title block named entity is prohibited. Use of this drawing by the title block named entity is limited to the specific title block named project. Use on other projects is strictly prohibited.

Company: DCR Construction, Inc.
Location: Bunge-Ergon
Evaporator Condenser
Item No: E-4504
Date: May 5, 2007 Job No: 7793

DCR Construction, Inc.
Lakeland, Florida

Scale: NTS


Rev:	Date:	Description	Dwg	Ckd	Appd	ASME VIII-1 2004 A06	SS1 Fixed Support Detail	Rev:
1	08-22-07	ISSUED FOR CONSTRUCTION	KFF	DGB	PW	TEMA Type: NEM	Dwg No: E-4504 19A	2
2	01-09-08	CERTIFIED AS-BUILT	AGB	DGB	PW	Size: 71-264 TEMA Class: C		

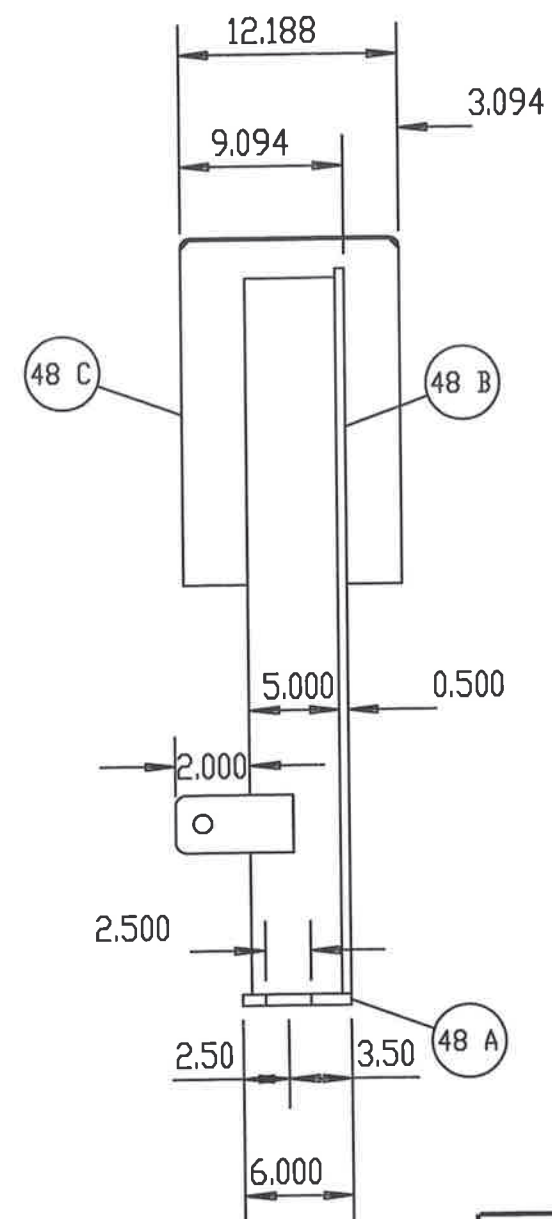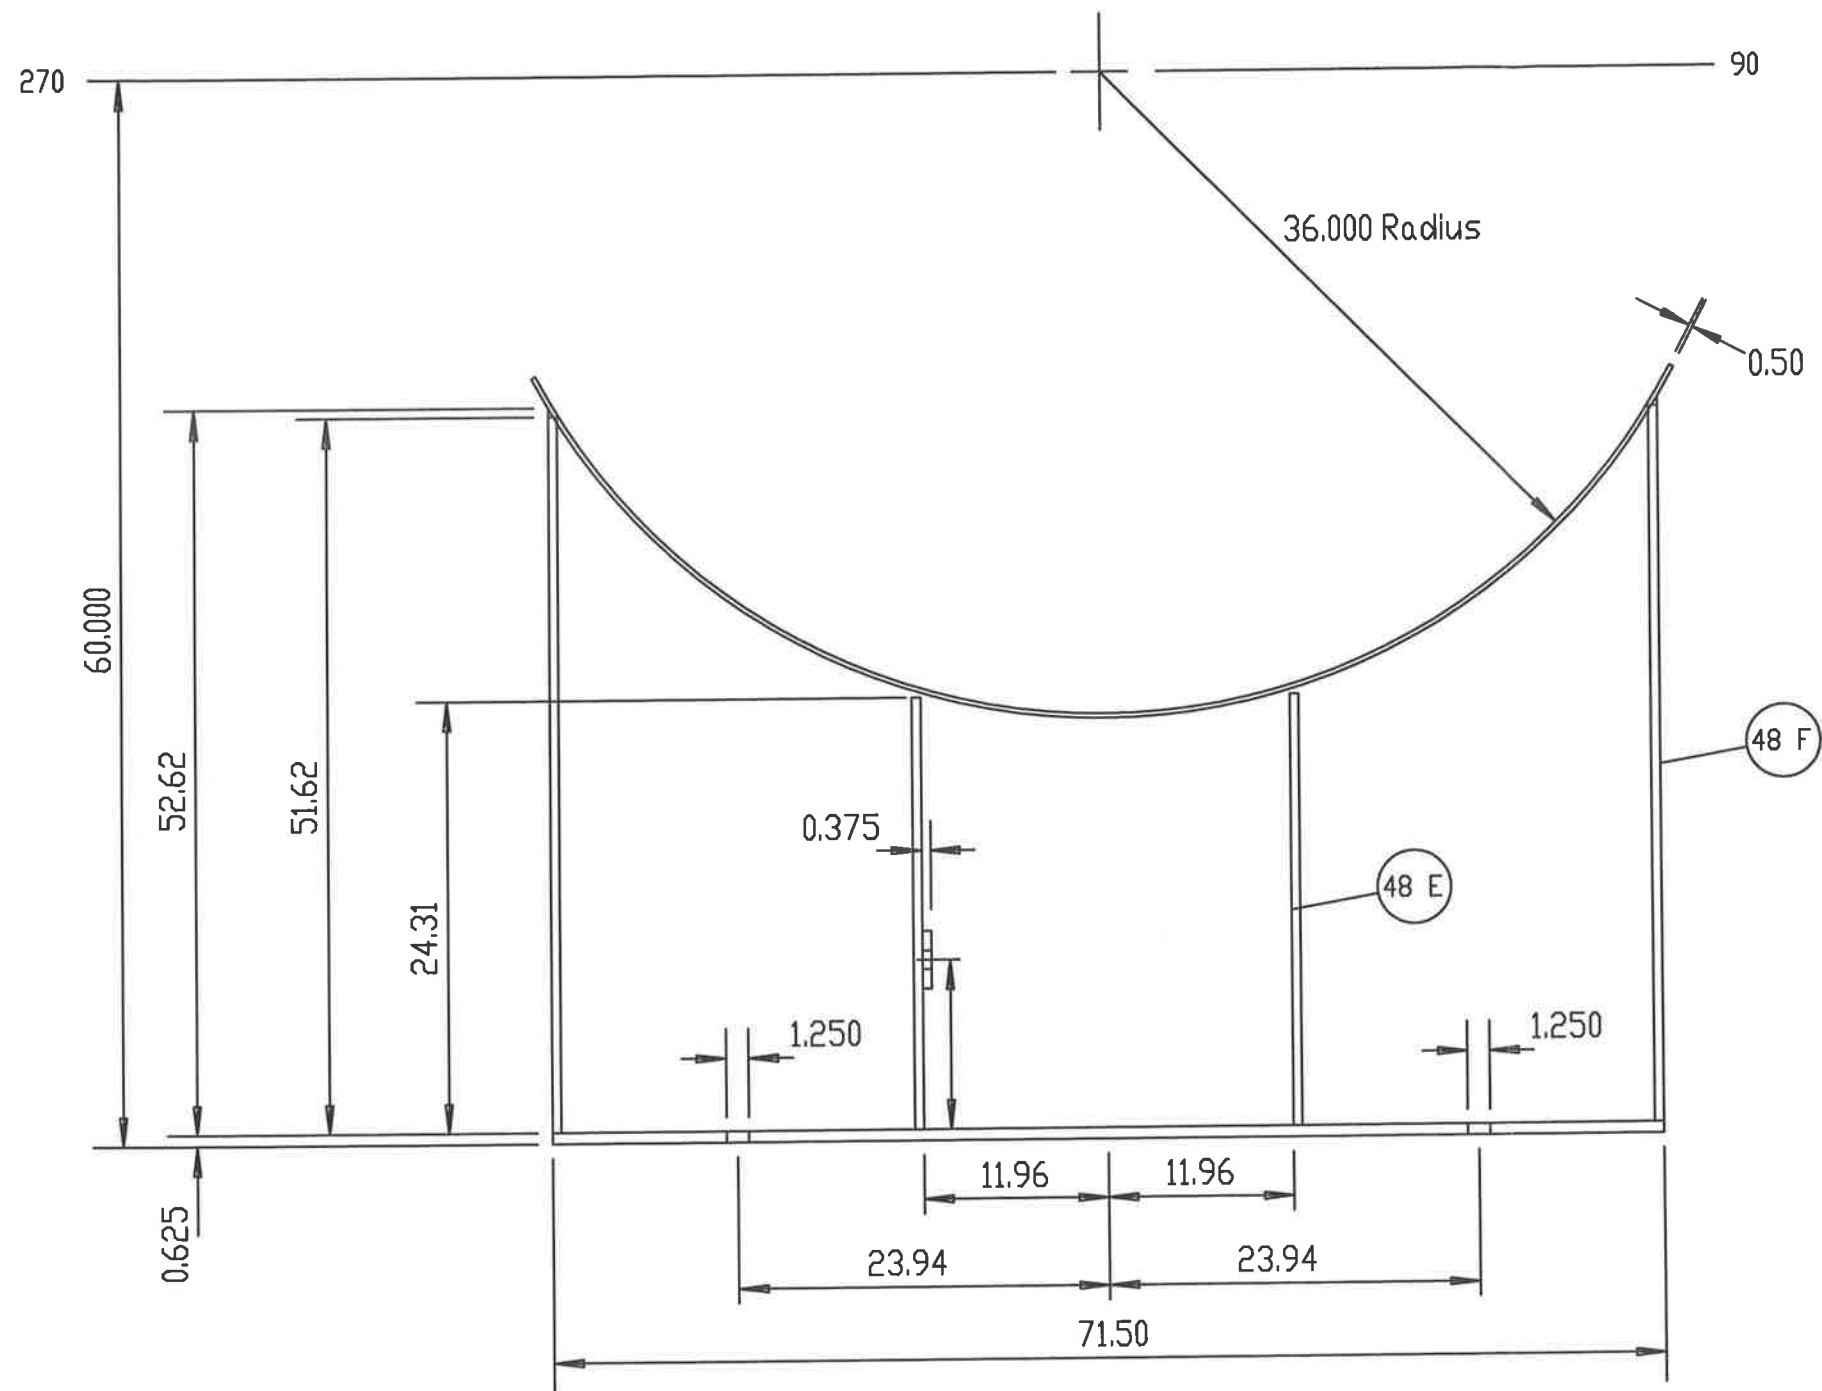

HT/DCR
Engineering, Inc.


2535 Parkway Street • Lakeland, FL 33811
Phone: 863-944-2880 • Fax: 863-913-1091
Florida Engineering Business License No. 26522

This drawing contains intellectual property of HT/DCR Engineering, Inc. All ideas, designs, arrangements and know-how remain the property of HT/DCR Engineering, Inc. Any use of this information by entities other than the title block named entity is prohibited. Use of this drawing by the title block named entity is limited to the specific title block named project. Use on other projects is strictly prohibited.

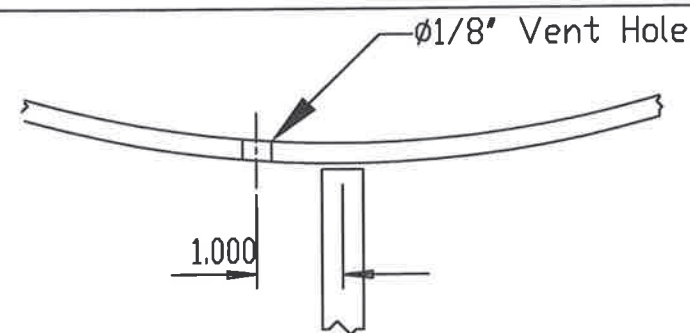

Front View

Vent Hole Detail (Not to Scale)

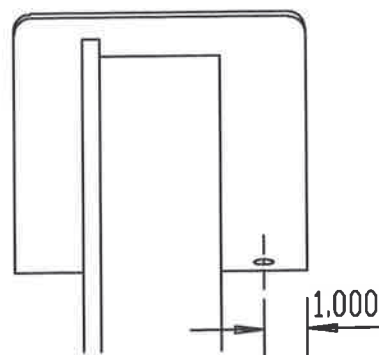

Side View

Notes:
All Dimensions In Inches

Company: DCR Construction, Inc.
Location: Bunge-Ergon
Evaporator Condenser
Item No: E-4504
Date: May 5, 2007 Job No: 7793


DCR Construction, Inc.
Lakeland, Florida

Scale: NTS

Rev	Date	Description	Dwg	Ckd	Appd
1	08-22-07	ISSUED FOR CONSTRUCTION	KFF	DGB	PW
2	01-09-08	CERTIFIED AS-BUILT	AGB	DGB	PW

ASME VIII-1 2004 A06
TEMA Type: NEM
Size: 71-264
TEMA Class: C

SS2,SS3,SS4 Slip Support Det.
Dwg No: E-4504 19B
Rev: 2

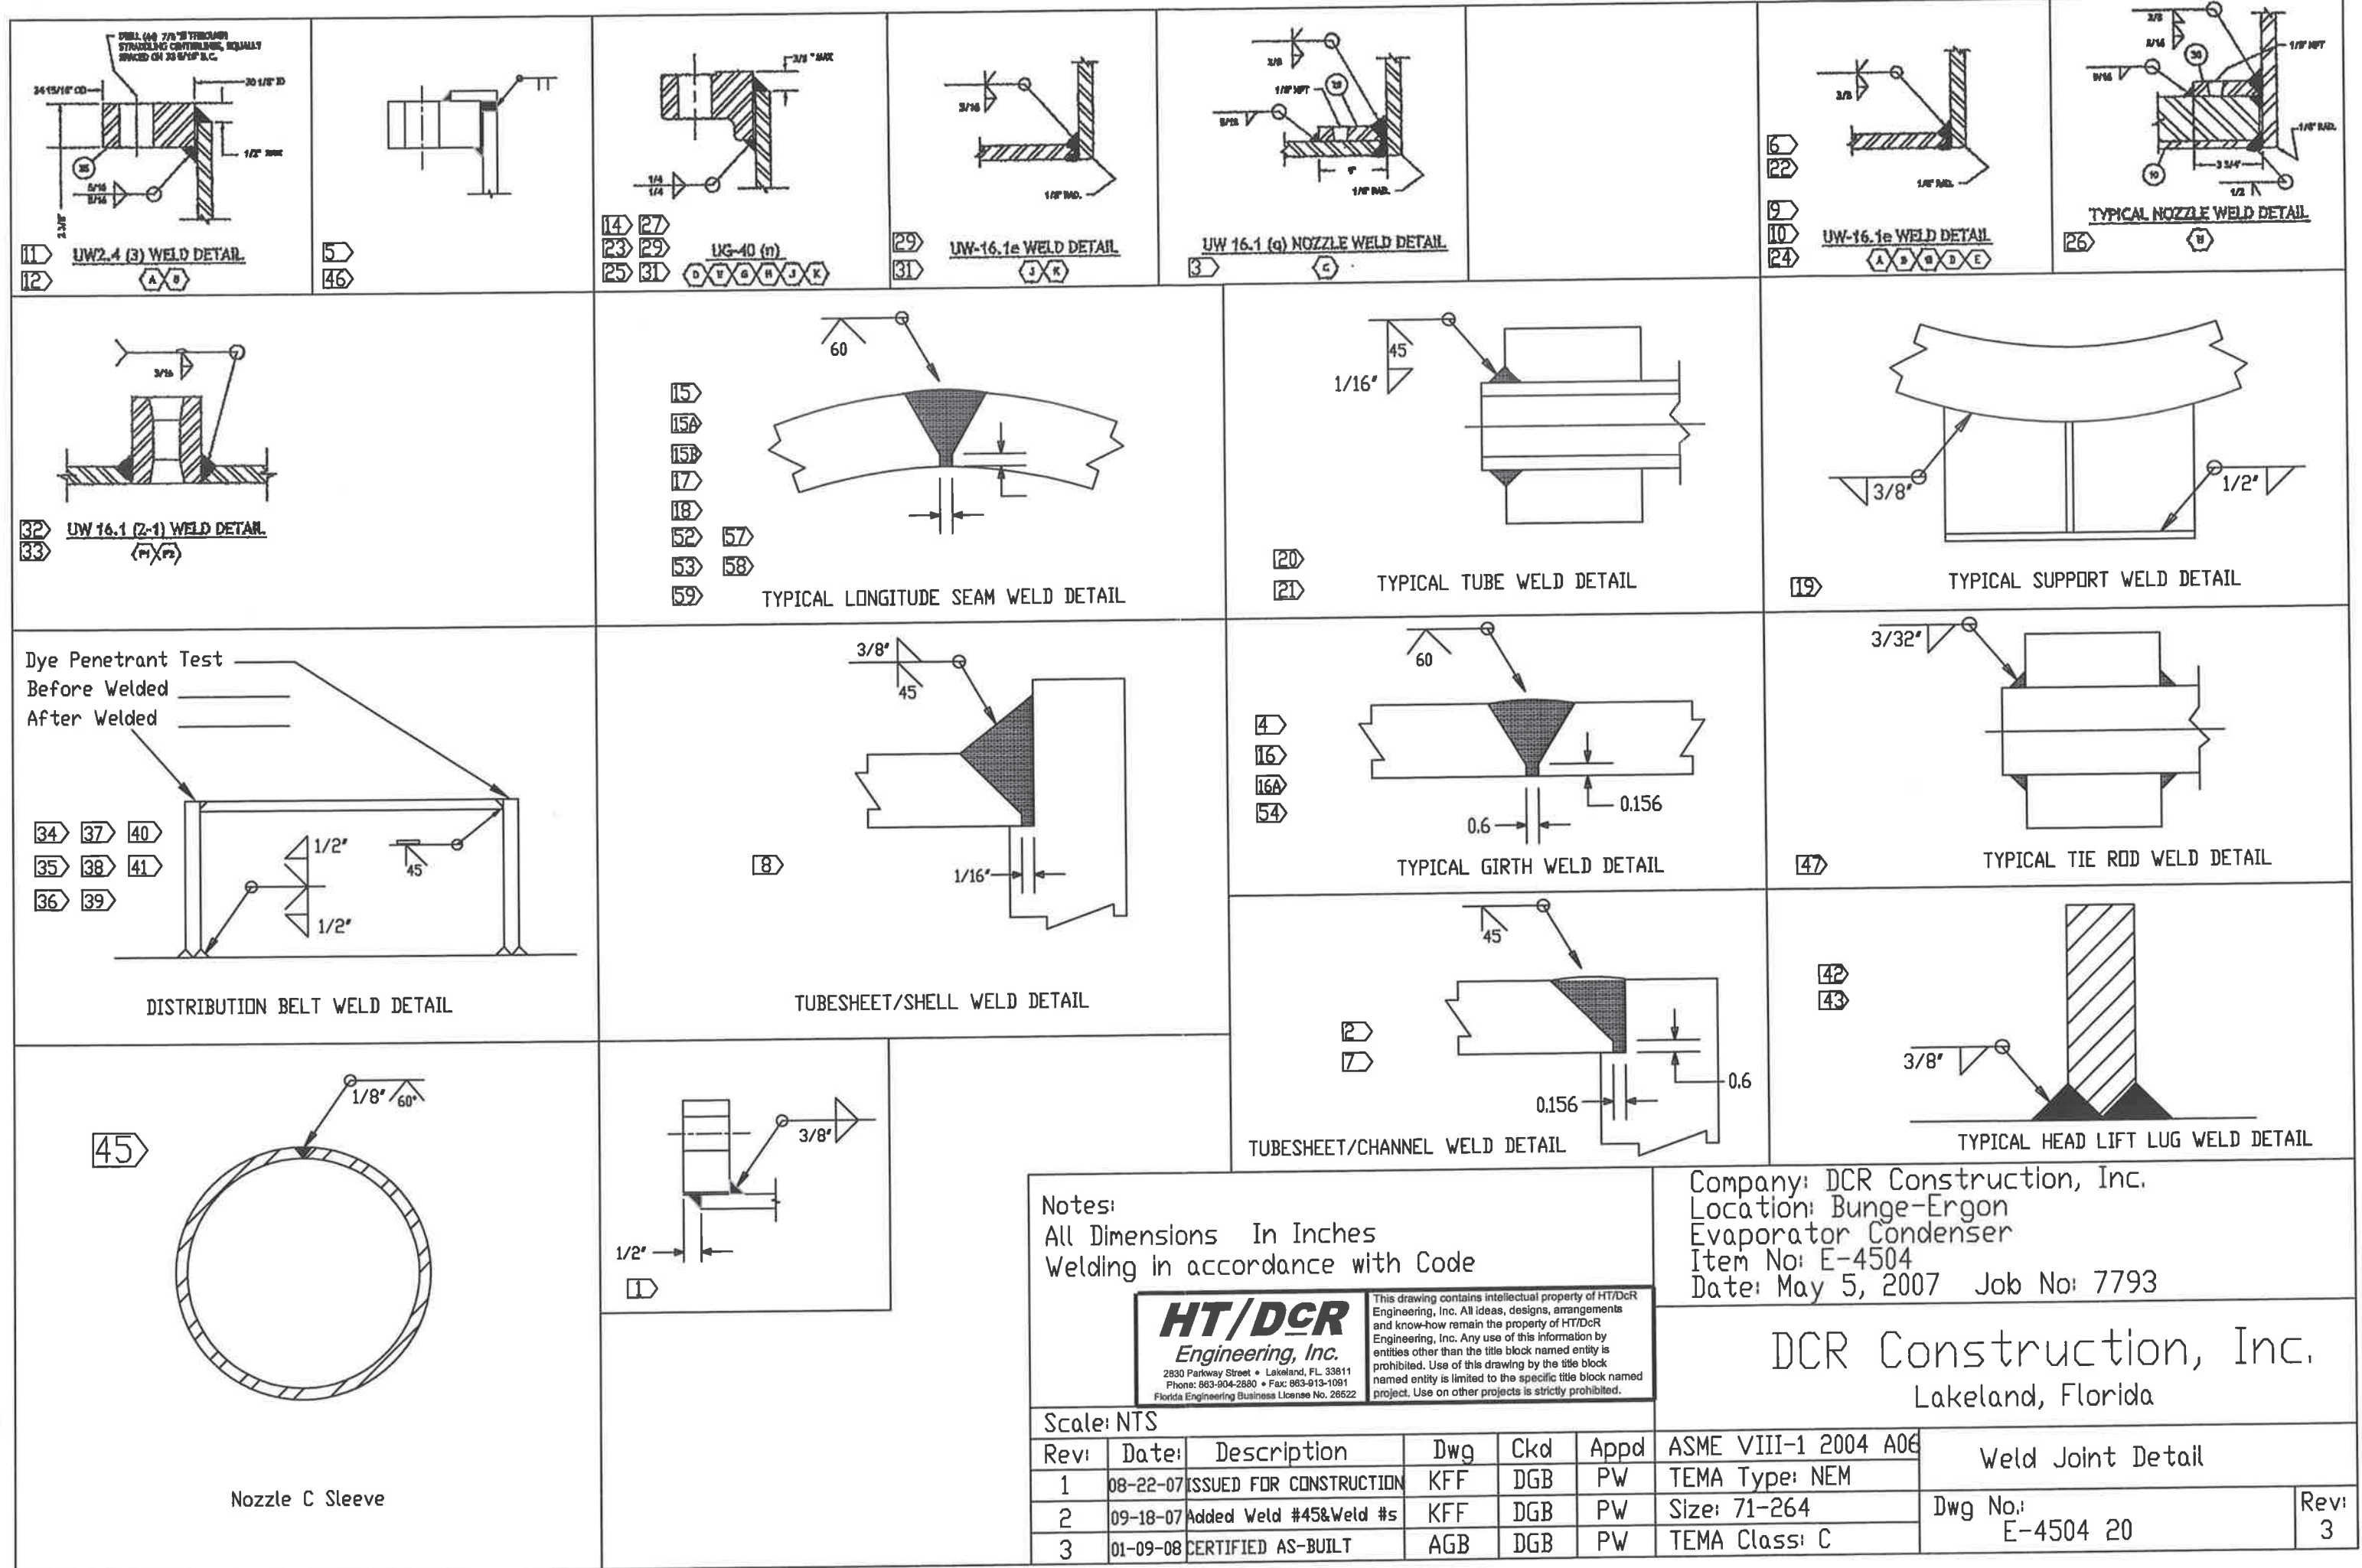

Notes:
All Dimensions In Inches
Welding in accordance with Code




HT/DCR
Engineering, Inc.
2830 Parkway Street • Lakeland, FL 33811
Phone: 863-904-2880 • Fax: 863-913-1091
Florida Engineering Business License No. 26522

This drawing contains intellectual property of HT/DCR Engineering, Inc. All ideas, designs, arrangements and know-how remain the property of HT/DCR Engineering, Inc. Any use of this information by entities other than the title block named entity is prohibited. Use of this drawing by the title block named entity is limited to the specific title block named project. Use on other projects is strictly prohibited.

Company: DCR Construction, Inc.
Location: Bunge-Ergon
Evaporator Condenser
Item No: E-4504
Date: May 5, 2007 Job No: 7793

DCR Construction, Inc. Lakeland, Florida			
Weld Joint Detail			
ASME VIII-1 2004 A06		Tema Type: NEM	
Size: 71-264		Dwg No: E-4504 20	
Tema Class: C		Rev: 3	

Scale: NTS			
Rev:	Date:	Description	Dwg Ckd Appd
1	08-22-07	ISSUED FOR CONSTRUCTION	KFF DGB PW
2	09-18-07	Added Weld #45&Weld #5	KFF DGB PW
3	01-09-08	CERTIFIED AS-BUILT	AGB DGB PW

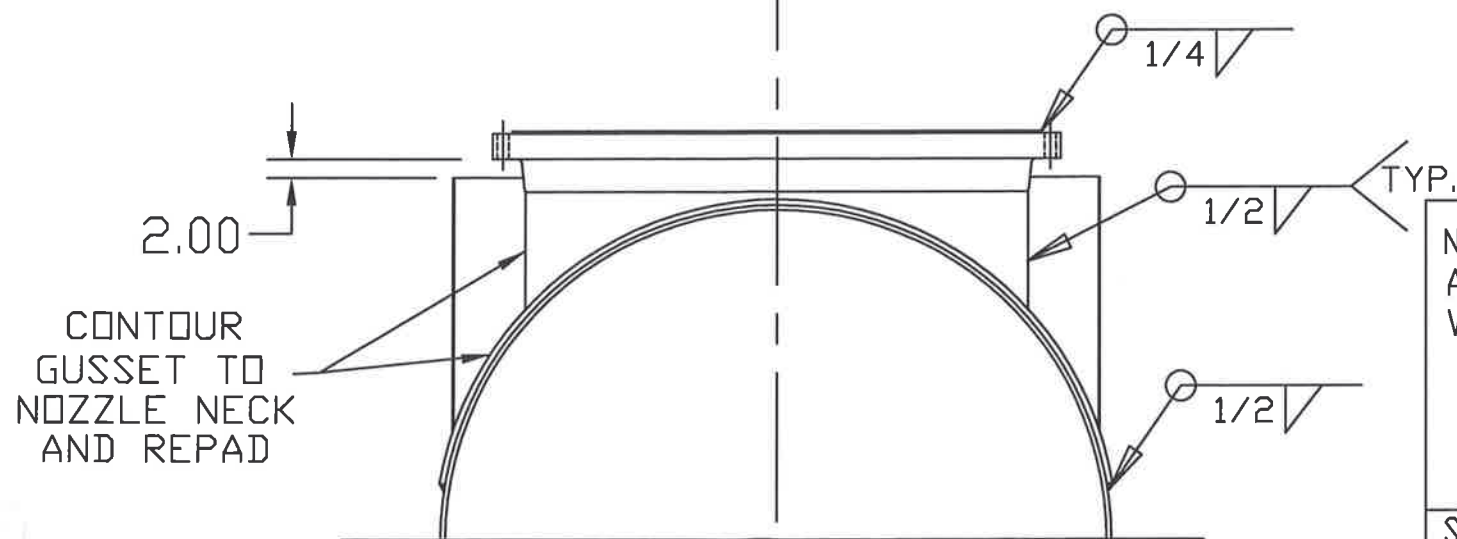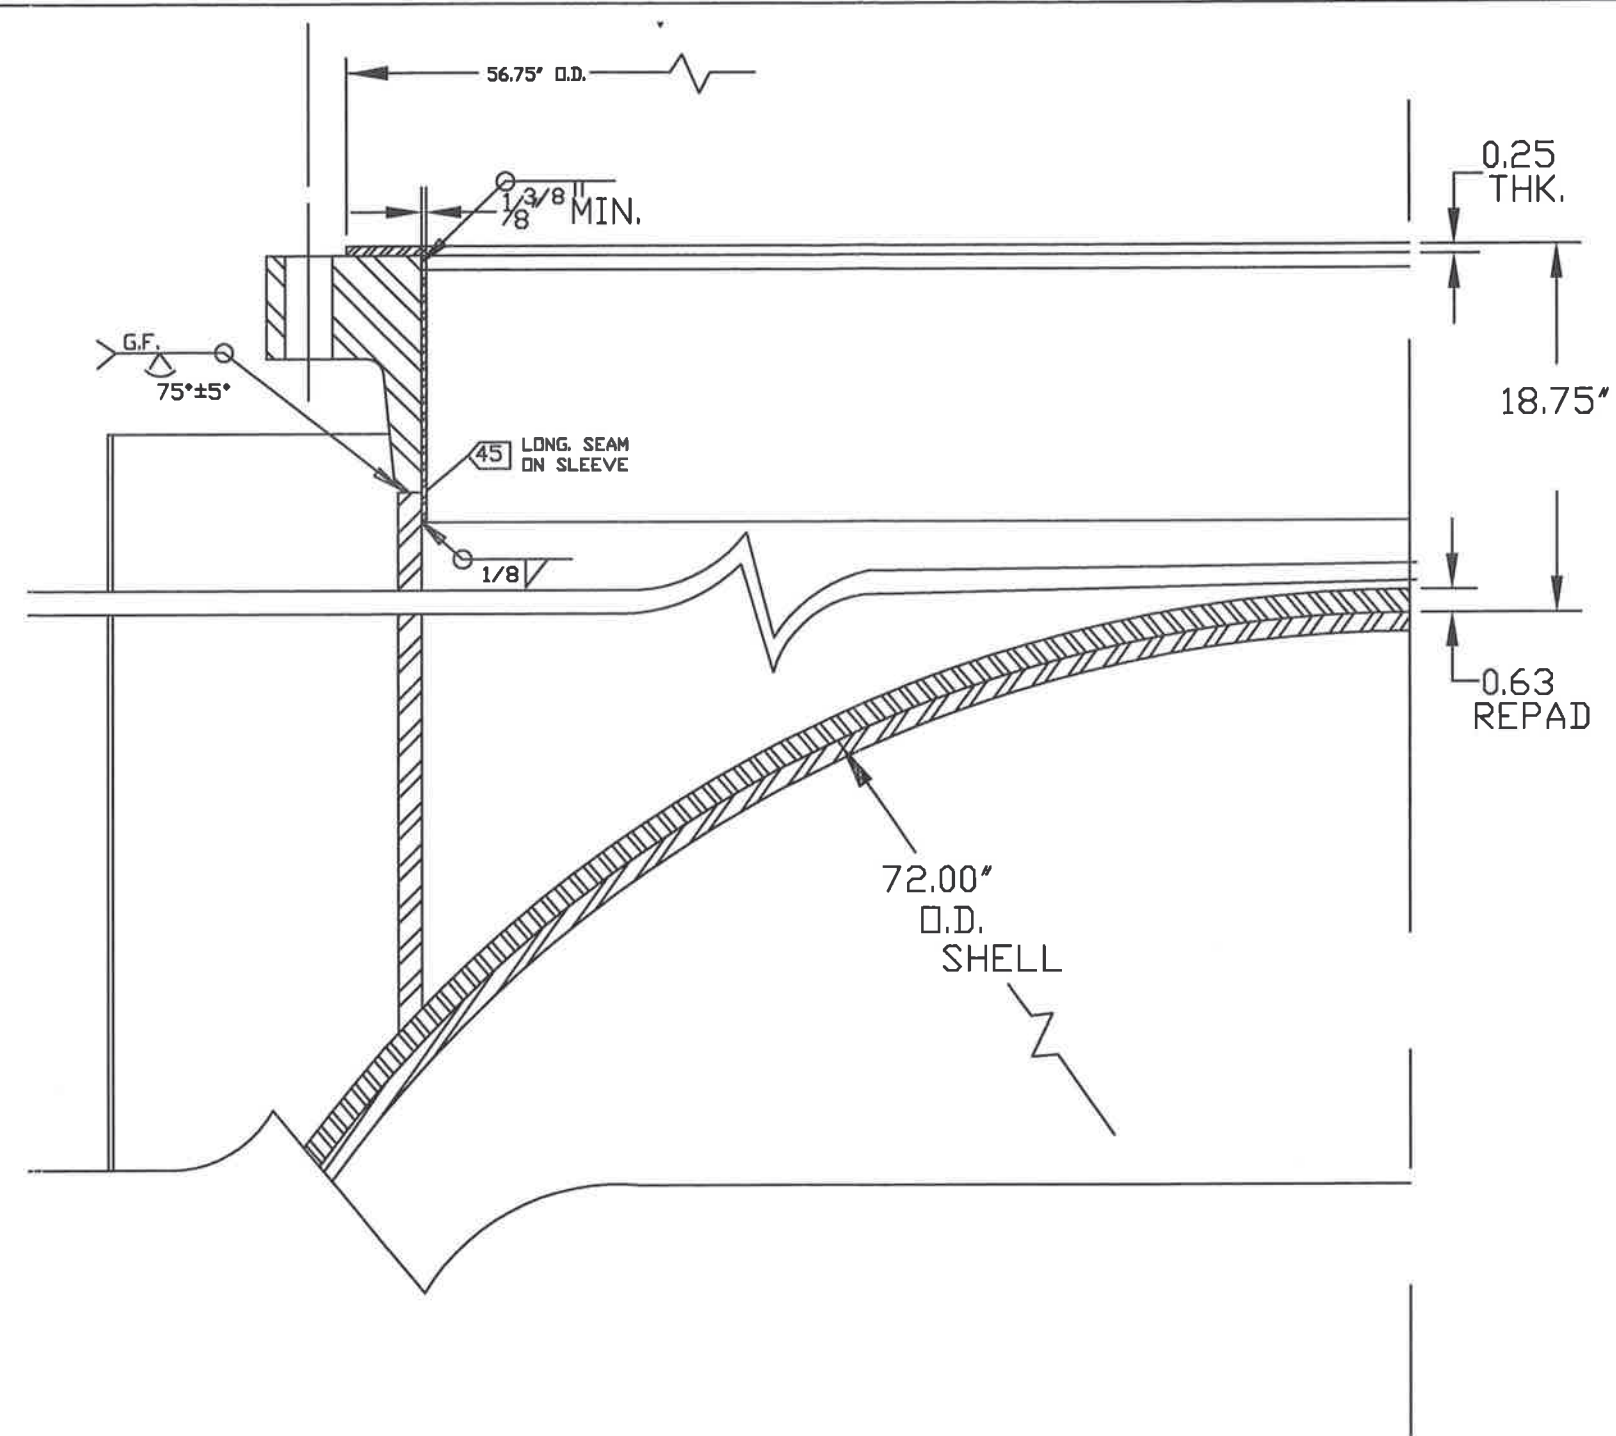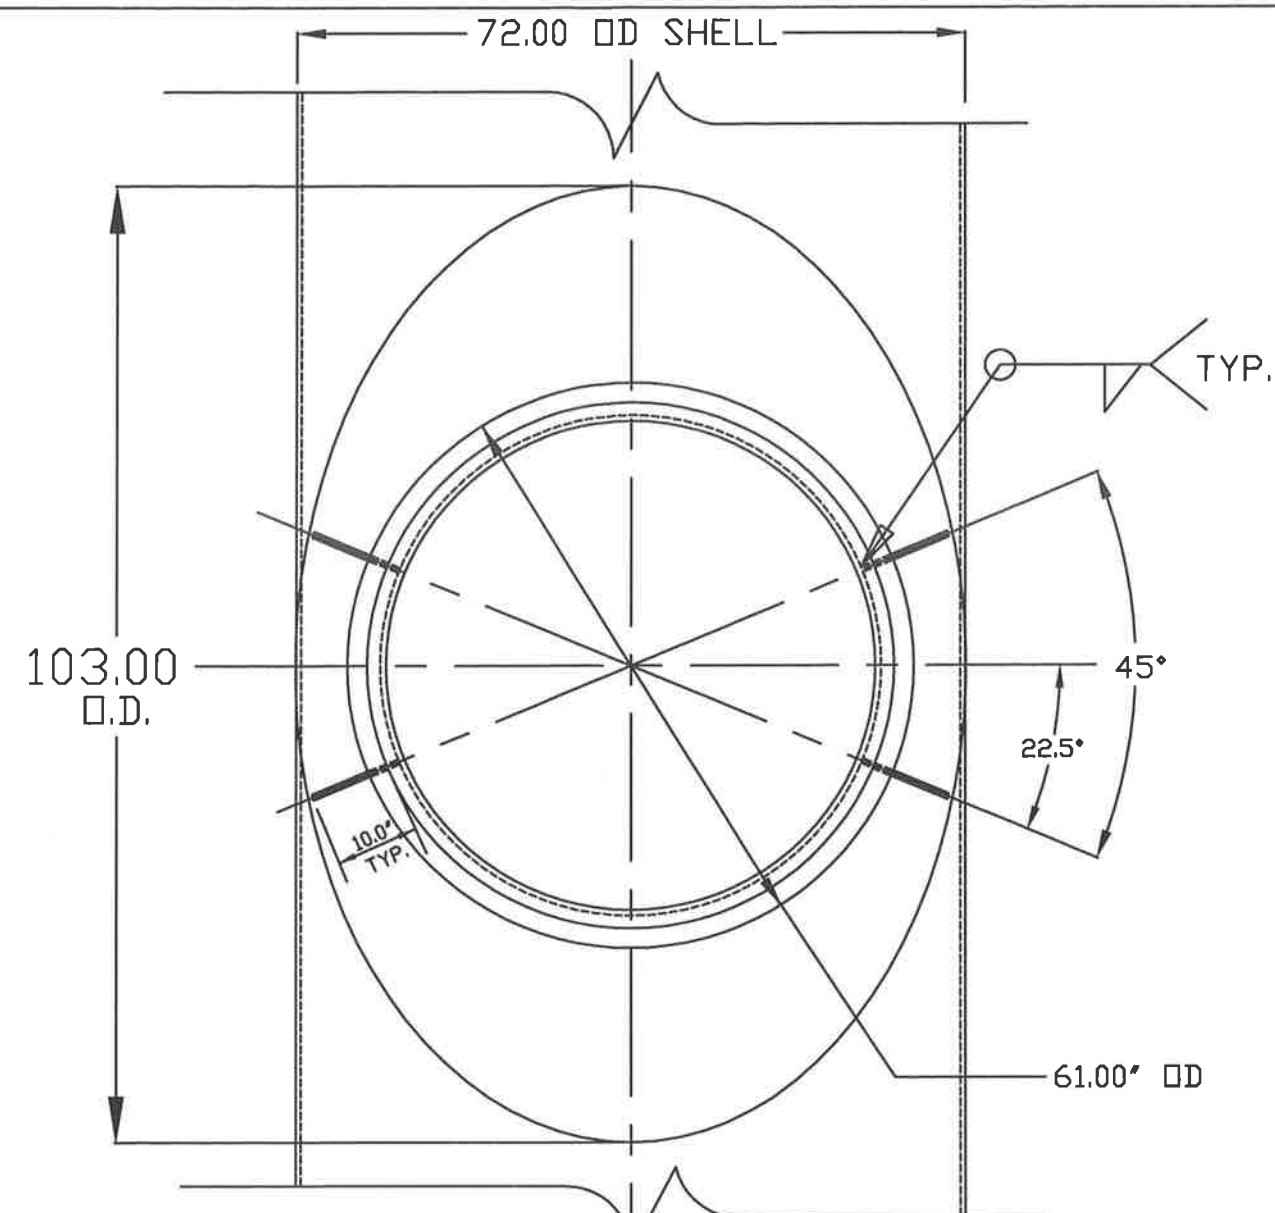

Notes:
All Dimensions In Inches
Welding in accordance with Code

HT/DCR
Engineering, Inc.

2830 Parkway Street • Lakeland, FL 33811
Phone: 863-904-2880 • Fax: 863-913-1091
Florida Engineering Business License No. 26522


This drawing contains intellectual property of HT/DCR Engineering, Inc. All ideas, designs, arrangements and know-how remain the property of HT/DCR Engineering, Inc. Any use of this information by entities other than the title block named entity is prohibited. Use of this drawing by the title block named entity is limited to the specific title block named project. Use on other projects is strictly prohibited.

Company: DCR Construction, Inc.
Location: Bunge-Ergon
Evaporator Condenser
Item No: E-4504
Date: May 5, 2007 Job No: 7793

DCR Construction, Inc.
Lakeland, Florida

Scale: NTS

Rev:	Date:	Description	Dwg	Ckd	Appd	ASME VIII-1 2004 A06	NOZZLE 'C' WELD DETAIL	
0	09-18-07	ISSUED FOR CONSTRUCTION	KFF	DGB	PW	TEMA Type: NEM	Dwg No: E-4504 20A	Rev: 1
1	01-09-08	CERTIFIED AS-BUILT	AGB	DGB	PW	Size: 71-264		
						TEMA Class: C		

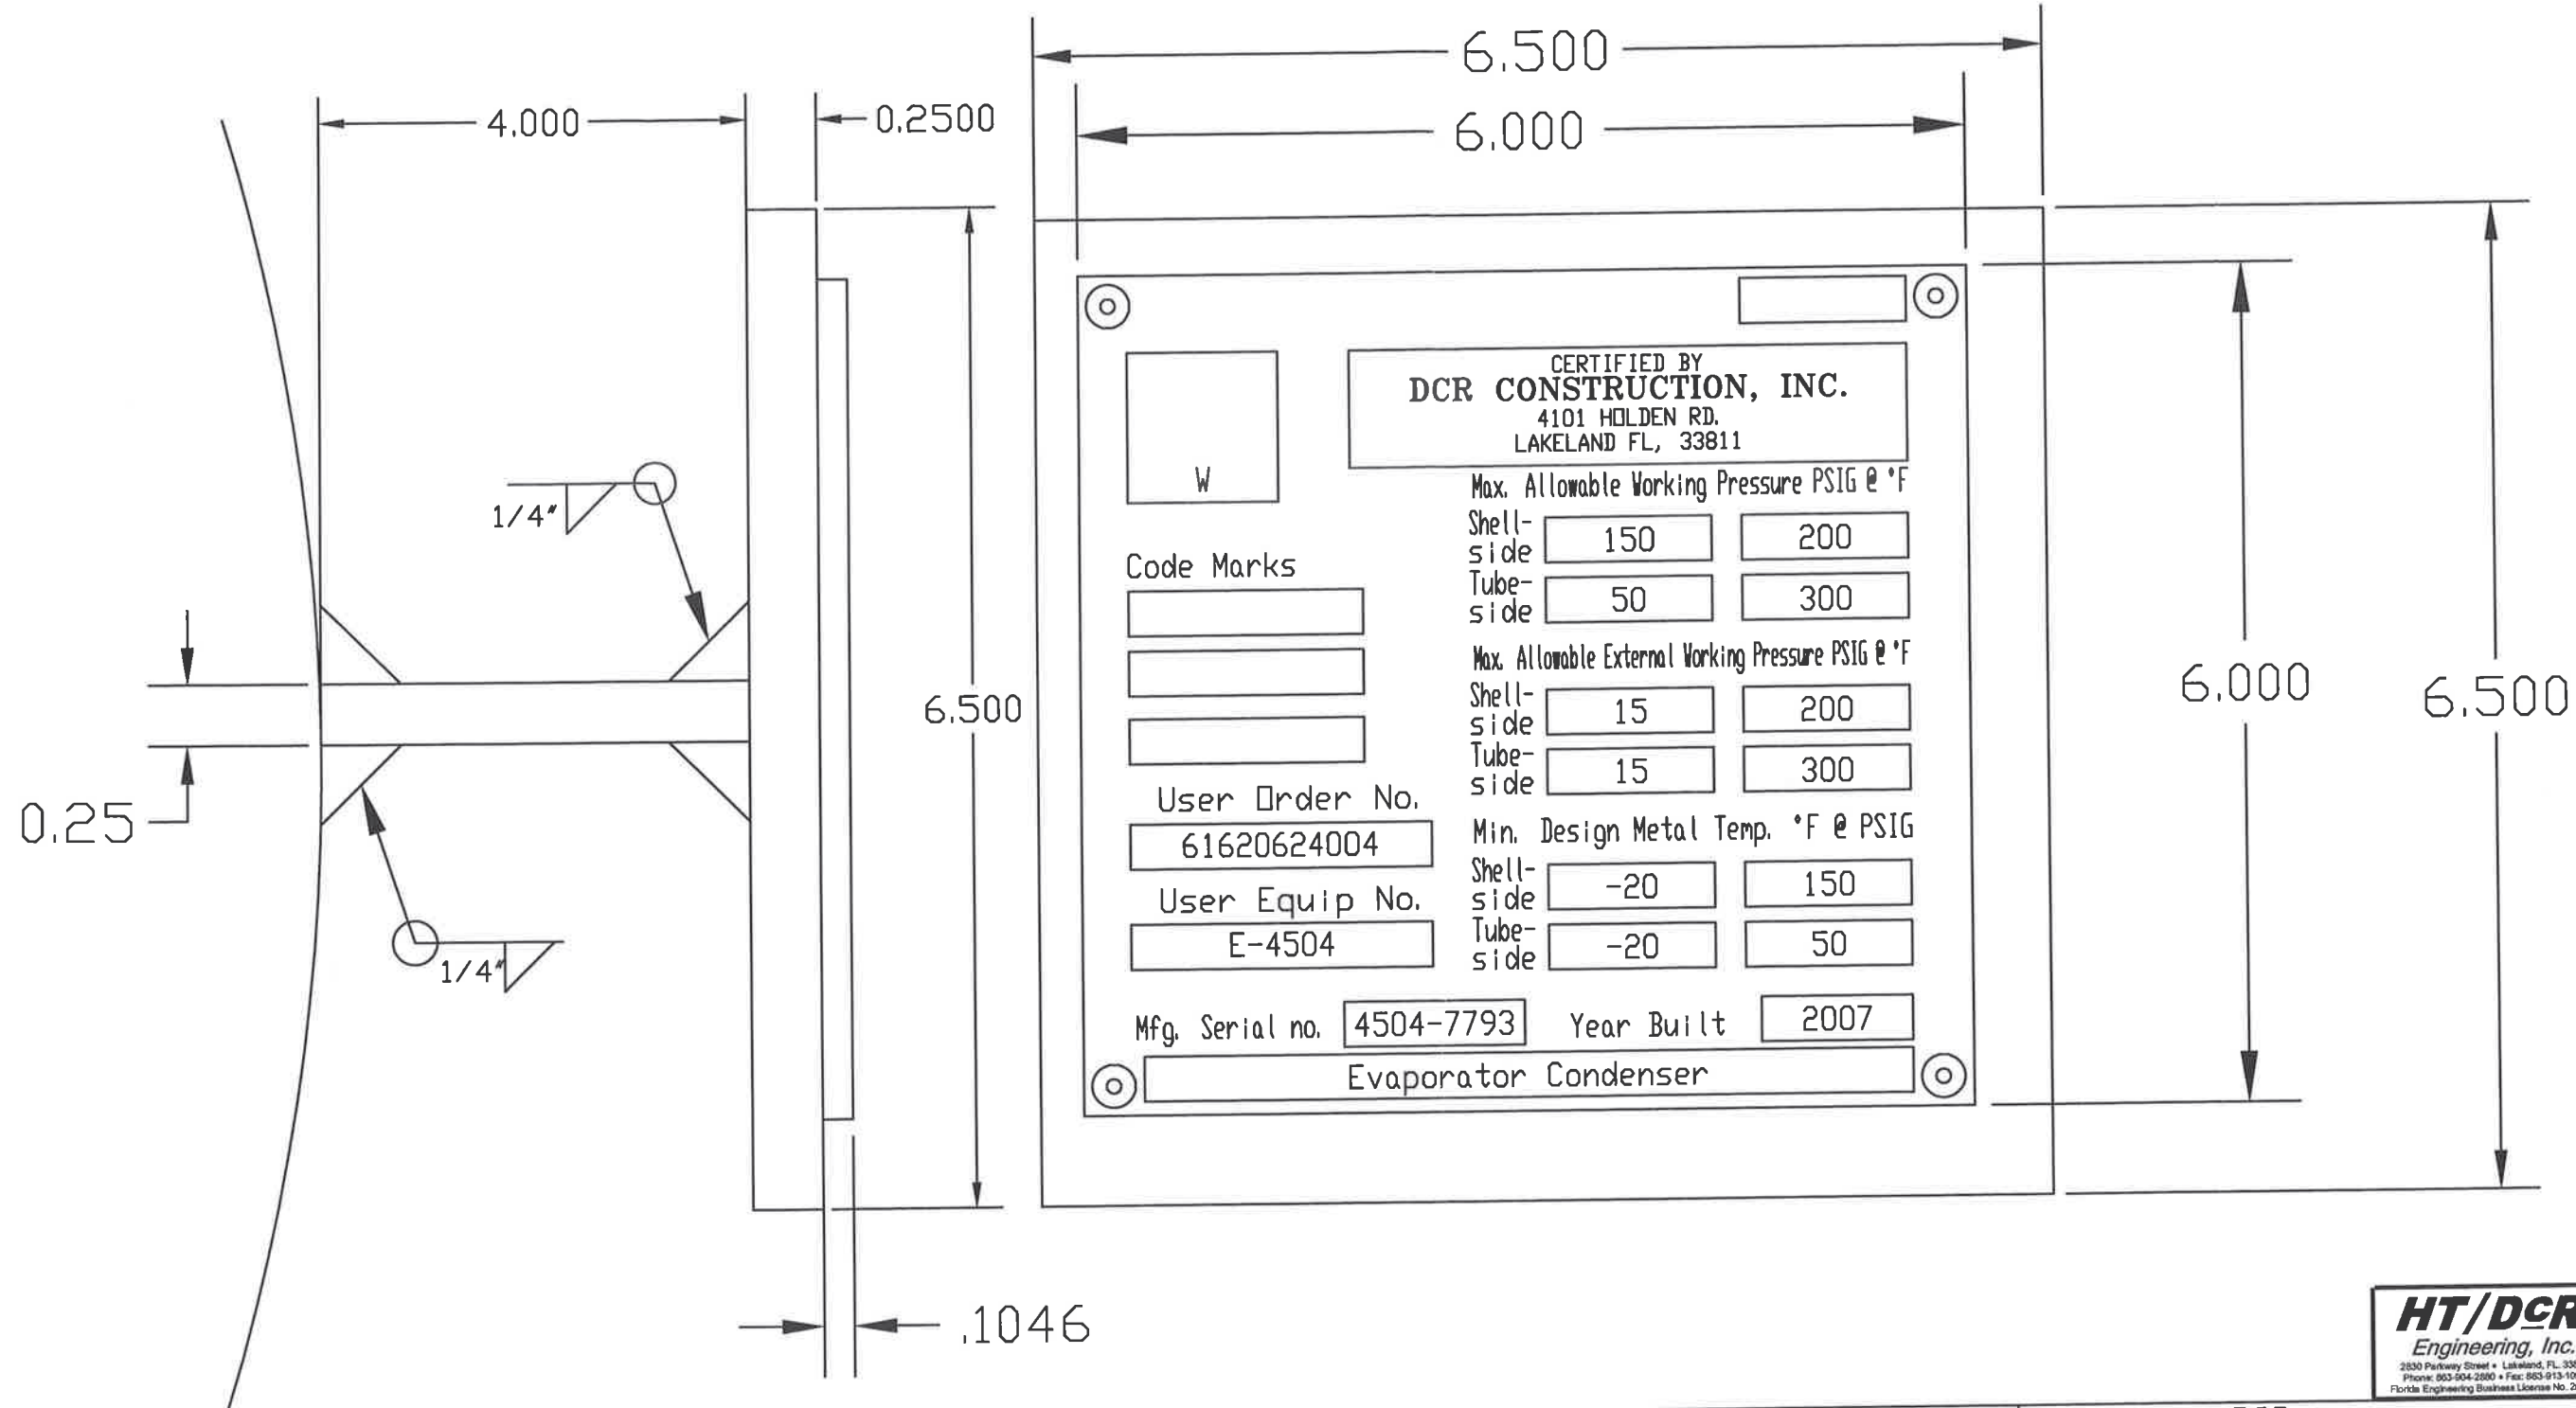

HT/DCR
 Engineering, Inc.
 2830 Parkway Street • Lakeland, FL 33811
 Phone: 863-904-2800 • Fax: 863-913-1091
 Florida Engineering Business License No. 26322

This drawing contains intellectual property of HT/DCR Engineering, Inc. All ideas, designs, arrangements and know-how remain the property of HT/DCR Engineering, Inc. Any use of this information by entities other than the title block named entity is prohibited. Use of this drawing by the title block named entity is limited to the specific title block named project. Use on other projects is strictly prohibited.

Notes:
 All Dimensions In Inches

Company: DCR
 Location: Bunge-Ergon
 Evaporator Condenser
 Item No: E-4504
 Date: February 17, 2007 Job No: 7793


DCR Construction, Inc
 Lakeland, FL

Scale: NTS

Rev:	Date:	Description	Dwg	Ckd	Appd	ASME VIII-1 2004 A06	Code Data Plate	
1	08-22-07	ISSUED FOR CONSTRUCTION	KFF	DGB	PW	TEMA Type: NEM		
2	01-09-08	CERTIFIED AS-BUILT	AGB	DGB	PW	Size: 71-264		
						TEMA Class: C		

Dwg No: E-4504 22

Rev: 2

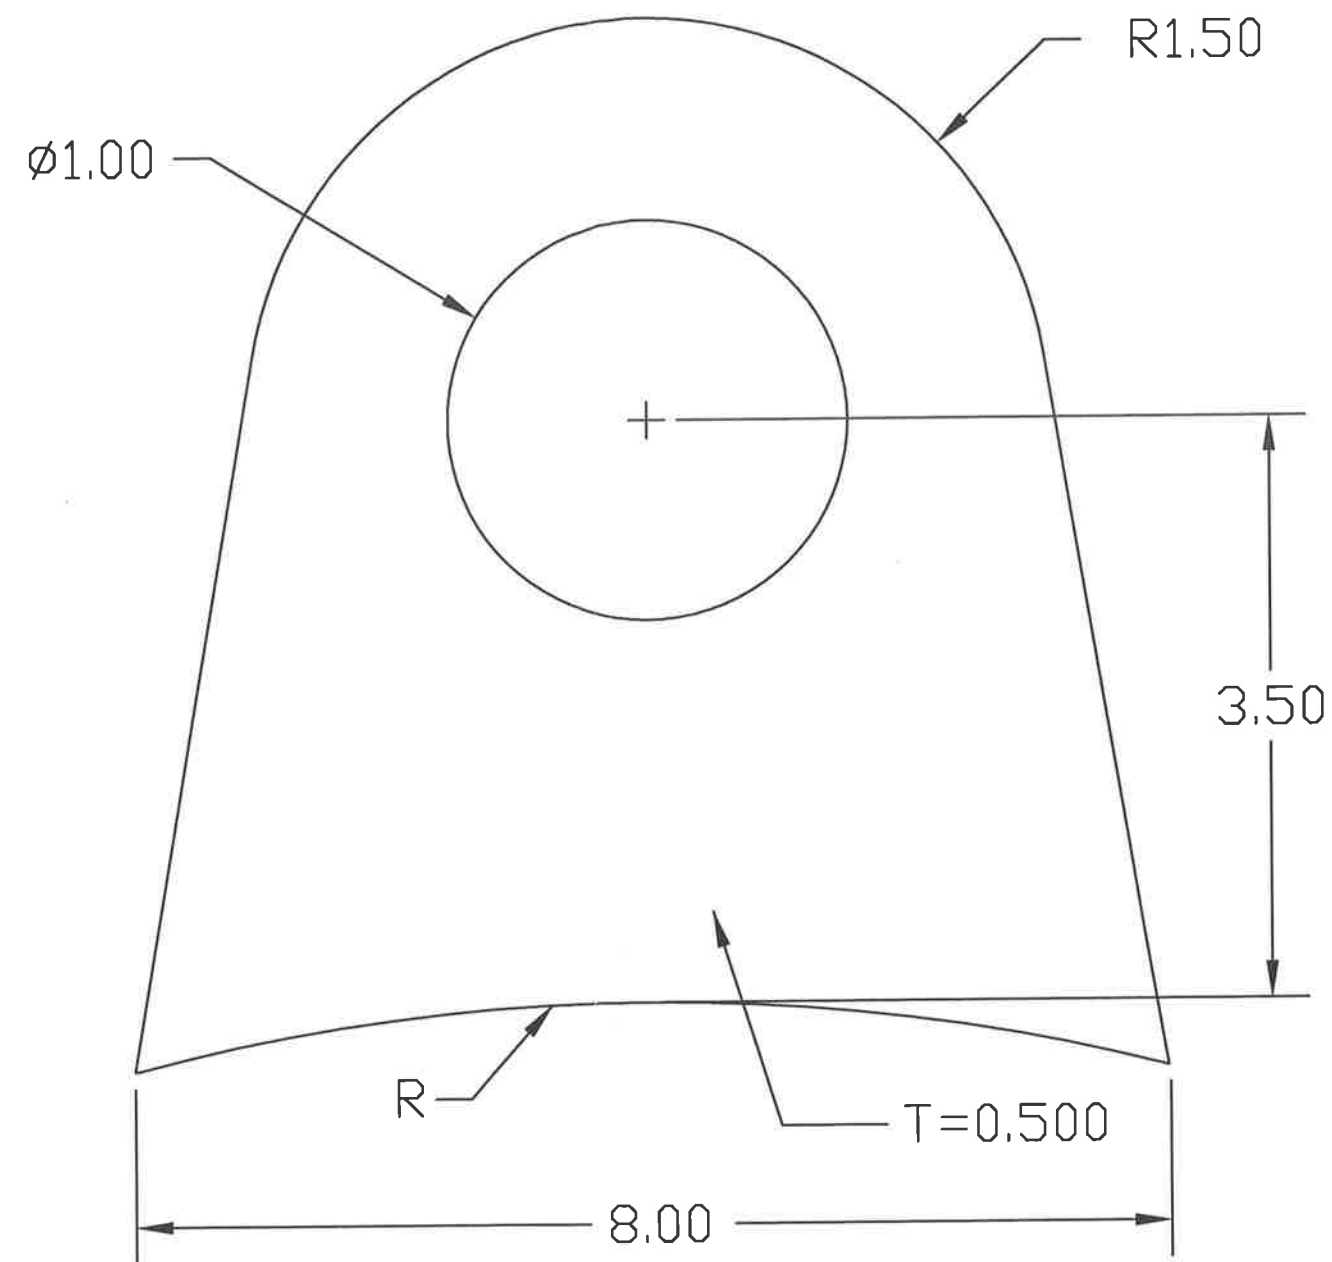

LUG	R
FLAT COVER	37.81"
REAR HEAD	37.75"

FLAT COVER AND HEAD
LIFTING LUG
2 REQUIRED-(1) FLAT COVER
(1) REAR HEAD

Notes:
All Dimensions In Inches

HT/DCR
Engineering, Inc.

2830 Parkway Street • Lakeland, FL 33811
Phone: 863-904-2880 • Fax: 863-913-1061
Florida Engineering Business License No. 26522

This drawing contains intellectual property of HT/DCR Engineering, Inc. All ideas, designs, arrangements and know-how remain the property of HT/DCR Engineering, Inc. Any use of this information by entities other than the title block named entity is prohibited. Use of this drawing by the title block named entity is limited to the specific title block named project. Use on other projects is strictly prohibited.

Company: DCR
Location: Bunge-Ergon
Evaporator Condenser
Item No: E-4504
Date: March 24, 2007 Job No: 7793


DCR Construction, Inc
Lakeland, FL

Scale: NTS

Rev:	Date:	Description	Dwg	Ckd	Appd	ASME VIII-1 2004 A06	Lifting Lug Detail	
1	08-22-07	ISSUED FOR CONSTRUCTION	KFF	DGB	PW	TEMA Type: NEM	Dwg No.: E-4504 23	Rev: 2
2	01-09-08	CERTIFIED AS-BUILT	AGB	DGB	PW	Size: 71-264 TEMA Class: C		

ID	Task Name	Start	Finish	% Complete	July 2007												August 2007												September 2007	
					9	12	15	18	21	24	27	30	3	6	9	12	15	18	21	24	27	30	2	5	8	11	14	17	20	23	26	29	1	4	7	10	13	16	19	22	
1	Bunge-Ergon #4500142848 (DCR in KY)	Mon 6/25/07	Wed 9/19/07	58%																																																																																																																																																																																																																																																																																																																																																																																																																																																																																																																																																																																																																																																																																																																																																																																																																																																																																																																																																																																																																																																																																																																																																																																																																																																																																																																																																																		</

Heat Exchanger Specification Sheet

1	Company: DELTA-T CORPORATION		Phone: (757) 220-2955	
2	Location: WILLIAMSBURG, VIRGINIA		Fax: (757) 229-1705	
3	Service of Unit: EVAPORATOR CONDENSER		L2357 REV C	
4	Item No.: E4504-L	Your Reference: 50MM GPY	Job No.: 61310 Bunge-Ergon Vicksburg, LLC	
5	Date: 6 February 2007	Prepared by: RS	Checked by: AC	
6	Size 71 / 264 in	Type NEM	hor	Connected in 1 parallel 1 series
7	Surf/unit(eff.) 12595.5 ft2	Shells/unit 1	Surf/shell (eff.) 12595.5	ft2
8	PERFORMANCE OF ONE UNIT			
9	Fluid allocation	Shell Side		Tube Side
10	Fluid name	COOLING WATER		EVAPORATOR COND.
11	Fluid quantity, Total lb/h	3532100		67574
12	Vapor (In/Out) lb/h			67481 104
13	Liquid lb/h	3532100	3532100	67377
14	Noncondensable lb/h			93
15				
16	Temperature (In/Out) F	88	108	130.7 105
17	Dew / Bubble point F			124.63
18	Density lb/ft3	62.241	62.031	0.005 62.021
19	Viscosity cp	0.781	0.628	0.011 0.655
20	Molecular wt, Vap			18.02 21.95
21	Molecular wt, NC			28.96
22	Specific heat BTU/(lb*F)	1.0007	1.0001	0.4596 1.0003
23	Thermal conductivity BTU/(ft*h*F)	0.352	0.36	0.012 0.358
24	Latent heat BTU/lb			1025.5 1034.9
25	Pressure psi	60		1.9
26	Velocity ft/s		3.93	268.82
27	Pressure drop, allow./calc. psi	15	10.196	0.2 0.163
28	Fouling resist. (min) ft2*h*F/BTU		0.001	0.0005
29	Heat exchanged 70667330 BTU/h	MTD corrected 20.62		F
30	Transfer rate, Service 272.1	Dirty 278.18	Clean 487.27	BTU/(h*ft2*F)
31	CONSTRUCTION OF ONE SHELL		Sketch	
32		Shell Side	Tube Side	
33	Design/Test pressure psi	150 / Code	50 / Code	
34	Design temperature F	200	300	
35	Number passes per shell	1	1	
36	Corrosion allowance in	0.0625		
37	Connections In	30 / 150 ANSI	54 / 150 ANSI	
38	Size/rating Out	30 / 150 ANSI	6 / 150 ANSI	
39	in Intermediate	/ 150 ANSI	/ 150 ANSI	
40	Tube No. 1785	OD 1.25	0.049 in	Length 22 ft Pitch 1.5625 in
41	Tube type Plain	Material SS304	Tube pattern 30	
42	Shell CS	ID OD 72 in	Shell cover	
43	Channel or bonnet SS304	Channel cover		
44	Tubesheet-stationary SS304	Tubesheet-floating		
45	Floating head cover	Impingement protection None		
46	Baffle-crossing CS	Type double seg Cut(%d) 30	vert Spacing: c/c 17.875	in
47	Baffle-long	Seal type	Inlet 40	in
48	Supports-tube	U-bend	Type	
49	Bypass seal	Tube-tubesheet joint	strength weld	
50	Expansion joint	Type		
51	RhoV2-Inlet nozzle 711	Bundle entrance 861	Bundle exit 864	lb/(ft*s2)
52	Gaskets - Shell side	Tube Side		
53	Floating head			
54	Code requirements ASME Code Sec VIII Div 1	TEMA class C		
55	Weight/Shell 54108.1	Filled with water 109888.7	Bundle 36768.9	lb
56	Remarks Design basis is 120% of nominal capacity.			
57	Test run cooling water inlet temp at 88°F. Require 122.8% larger surface area than the standard unit.			
58				

FORM U-1 MANUFACTURER'S DATA REPORT FOR PRESSURE VESSELS
As Required by the Provisions of the ASME Code Rules, Section VIII, Division 1

Manufactured and certified by: DCR Construction, Inc. 4101 Holden Rd. Lakeland, FL 33811
2. Manufactured for: Delta-T Corporation 133 Waller Mill Rd. Williamsburg, VA 23185
3. Location of installation: Bunge Ergon Vicksburg, LLC 1833 Haining Rd. Vicksburg, MS 39183
4. Type: Horizontal Condenser 4504-7793
5. ASME Code Section VIII Div 1 Edition 2004, Addenda 2006

Items 6-11 incl. to be completed for single wall vessels, jackets of jacketed vessels, shell of heat exchangers, or chamber of multi-chamber vessels.

6. Shell (a) No. of course (s):	3	(b) Overall Length (ft & in.):	21' 9 5/16"										
Course(s)			Material	Thickness		Long. Joint (Cat. A)			Circum. Joint (Cat. A, B, & C)			Heat Treatment	
No.	Diameter	Length (ft & in.)	Spec./Grade or Type	Nom.	Corr.	Type	Full, Spot, None	Eff.	Type	Full, Spot, None	Eff.	Temp.	Time
2	72" OD	5' 9 1/2"	SA-516 GR70	0.500"	0.0625"	1	None	0.70	1	None	0.70		
1	72" OD	10' 2 5/16"	SA-516 GR70	0.500"	0.0625"	1	None	0.70	1	None	0.70		

7. Heads: (a) (b)
(Matl. Spec. No., Grade or Type) (H.T. - Time & Temp) (Matl. Spec. No., Grade or Type) (H.T. - Time & Temp)

	Location (Top, Bottom, Ends)	Thickness		Radius		Elliptical Ratio	Conical Apex Angle	Hemispherical Radius	Flat Diameter	Side to Pressure		Category A	
		Min.	Corr.	Crown	Knuckle					Convex	Concave	Type	Full, Spot, None
(a)													
(b)													

If removable, bolts used (describe other fastenings)
8. Type of jacket Jacket closure
9. MAWP 150 psig 15 psig at max temp. 200 °F 200 °F Min. design metal temp. -20 °F at 150 psig
10. Impact Test No Per UG-20(f) at test temperature of N/A °F
11. Hydro., Pneu., or comb. test press. 195 psig Proof Test N/A

Items 12 and 13 to be completed for tube sections.

12. Tubesheet SA-240 GR304 72" 1.5" 0 Welded
13. Tubes SA-249 TP304 Wld Tube 1.25" 0.049" 1785 Straight

Items 14-18 incl. To be completed for inner chambers of jacketed vessels or channels of heat exchangers.

14. Shell (a) No. of course (s): 3 (b) Overall Length (ft & in.): 12' 8 1/2"

Courses	Material	Thickness	Long. Joint (Cat. A)	Circum. Joint (Cat. A, B, & C)	Heat Treatment
No. Diameter Length (ft & in.) Spec./Grade or Type Nom. Corr. Type Full, Spot, None Eff. Type Full, Spot, None Eff. Temp. Time					
1 72" OD 8' 5" SA-240 GR304 0.500" 0 1 None 0.70 1 None 0.70					
1 72" OD 2' SA-240 GR304 0.500" 0 1 None 0.70 1 None 0.70					
1 72" OD 27 1/2" SA-240 GR304 0.500" 0 1 None 0.70 1 None 0.70					

15. Heads: (a) SA-516 GR 70 SA-240-304 Clad (b) SA-240 GR304
(Matl. Spec. No., Grade or Type) (H.T. - Time & Temp) (Matl. Spec. No., Grade or Type) (H.T. - Time & Temp)

	Location (Top, Bottom, Ends)	Thickness		Radius		Elliptical Ratio	Conical Apex Angle	Hemispherical Radius	Flat Diameter	Side to Pressure		Category A	
		Min.	Corr.	Crown	Knuckle					Convex	Concave	Type	Full, Spot, None
(a)	Front	2.1049	0						75 5/8"		Flat		
	Rear	0.1358	0			80:10					X		0.85

If removable, bolts used (describe other fastenings) SA-193 GRB7 7/8" (228)

Form U-1 (Back)

16. MAWP 50 psig (Internal) 15 psig at max temp. 300 °F (Internal) 300 °F (external) Min. design metal temp. -20 °F at 50 psig

Impact Test No Per UHA-51 at test temperature of N/A °F

Indicate yes or no and the component(s) impact tested

18. Hydro., pneu., or comb. test press. 65 psig Proof Test N/A

19. Nozzles, inspection, and safety valve openings:

Purpose (Inlet, Outlet, Drain, etc)	No.	Diameter or Size	Flange Type	Material		Nozzle Thickness		Reinforcement Material	How Attached		Location (Insp. Open.)
				Nozzle	Flange	Nom.	Corr.		Nozzle	Flange	
CW Inlet/Outlet	2	30"	RFSO	SA-516 GR70	SA-105	0.500"	0.0625"	Inherent	UW-16.1	Welded	Vapor Belt
Vapor Inlet	1	54"	FFWN	SA-240 304	SA-105	0.0625"	0.0625"	SA-240 GR304 0.375	UW-16.1	Welded	Front Channel
Vapor Outlet	1	6"	RFSO	SA-312 304	SA-182 304	0.280"	0	Inherent	UW-16.1	Welded	Rear Channel
Non. Cond. Outlet	1	6"	RFSO	SA-312 304	SA-182 304	0.280"	0	Inherent	UW-16.1	Welded	Rear Channel
Tubeside Inlet	1	4"	RFSO	SA-312 304	SA-182 304	0.337"	0	Inherent	UW-16.1	Welded	Rear Channel
Tubeside Inlet	1	3"	RFSO	SA-312 304	SA-182 304	0.300"	0	SA-516 GR70 0.750	UW-16.1	Welded	Front Cover
Spare Port	2	2"	RFSO	SA-53B	SA-105	0.344"	0.0625"	Inherent	UW-16.1	Welded	Shell
Coupling	2	0.5" NPT	CPLG	SA-182	N/A	3000#	0	Inherent	UW-16.1	Welded	Channels

20. Supports: Skirt Lugs Legs Others Attached Welded, Bottom

(Yes or No) (No.) (No.) (Describe) (Where and How)

21. Manufacturer's Partial Data Reports properly identified and signed by Commissioned Inspectors have been furnished for the following items of the report: (List the name of part, item number, mfr's name and identifying number)

22. Remarks 4504-01A Rev 4 4504-01B Rev 4 4504-02 Rev 4 4504-03 Rev 4 4504-04 Rev 3 4504-05 Rev 2 4504-06 Rev 5 4504-07 Rev 4 4504-08 Rev 5 4504-09 Rev 3 4504-11 Rev 3 4504-12 Rev 2 4504-13 Rev 3 4504-14 Rev 2 4504-15 Rev 2 4504-17A Rev 2 4504-17B Rev 2 4504-18A Rev 2 4504-18B Rev 3 4504-19A Rev 2 4504-19B Rev 2 4504-20 Rev 3 4504-20A Rev 1 4504-22 Rev 2 4504-23 Rev 2

CERTIFICATE OF SHOP COMPLIANCE

We certify that the statements in this report are correct and that all details of design, material, construction and workmanship of this vessel conform to the ASME Code for Pressure Vessels, Section VIII, Division 1.

U Certificate of Authorization No. 35010 Expires 3/17/08

Date 1/11/08 Name DCR Construction, Inc. Signed D. O. Cel

(Manufacturer) (Representative)

CERTIFICATE OF SHOP INSPECTION

I, the undersigned, holding a valid commission issued by the National Board of Boiler and Pressure Vessel Inspectors and/or the State or Province of Florida and employed by ARISE, Inc of Brecksville, OH have inspected the pressure vessel described in this Manufacturer's Data Report on 1-11-2008 and state that, to the best of my knowledge and belief, the Manufacturer has constructed this pressure vessel in accordance with ASME Code, Section VIII, Division 1. By signing this certificate neither the Inspector nor his employer makes any warranty, expressed or implied, concerning the pressure vessel described in this Manufacturer's Data Report. Furthermore, neither the inspector nor his employer shall be liable in any manner for any personal injury or property damage or a loss of any kind arising from or connected with this inspection.

Date 1-11-2008 Signed Raymond A. Taylor Commissions 5789 AB PL 442

(Authorized Inspector) (Nat'l Board incl endorsements State, Province and No)

CERTIFICATE OF FIELD ASSEMBLY COMPLIANCE

We certify that the statements on this report are correct and that the field assembly construction of all parts of this vessel conforms with the requirements of ASME Code Section VIII, Division 1. U Certificate of Authorization No. Expires

Date Name Signed

(Assembler) (Representative)

CERTIFICATE OF FIELD ASSEMBLY INSPECTION

I, the undersigned, holding a valid commission issued by the National Board of Boiler and Pressure Vessel Inspectors and/or the State or Province of and employed by , have compared the statements in this Manufacturer's Data Report with the described pressure vessel and state that parts referred to as data items , not included in the certificate of shop inspection, have been inspected by me and to the best of my knowledge and belief, the Manufacturer has constructed this pressure vessel in accordance with ASME Code, Section VIII, Division 1. The described vessel was inspected and subjected to a hydrostatic test of psi By signing this certificate neither the inspector nor his employer makes any warranty, expressed or implied, concerning the pressure vessel described in this Manufacturer's Data Report. Furthermore, neither the inspector nor his employer shall be liable in any manner for any personal injury or property damage or a loss of any kind arising from or connected with this inspection.

Date Signed Commissions

(Authorized Inspector) (Nat'l Board incl endorsements State, Province and No)

1. Manufactured and certified by	DCR Construction, Inc. 4101 Holden Rd. Lakeland, FL 33811 (Name and address of Manufacturer)		
2. Manufactured for	Delta-T Corporation 133 Waller Mill Rd. Williamsburg, VA 23185 (Name and address of Purchaser)		
3. Location of installation	Bunge Ergon Vicksburg, LLC 1833 Haining Rd. Vicksburg, MS 39183 (Name and address)		
4. Type	Horizontal (Horiz., vert., or sphere)	Condenser (Tank, separator, heat exh., etc.)	4504-7793 (Mfg's serial No.)
	N/A (CRN)	4504-01 to 4504-23 (Drawing No.)	238 (Nat'l Bd No.)
			2008 (Year built)

Remarks

#6

(2) Partial Vapor Belt sections diameter 89.5", length 47", material SA-516 GR70 Thickness .750"
Long. Joint Cat. A Type 1, none, 0.70 circumference joint Cat. A, B, & C, type 1 & 2*, none, 0.70
Includes closing ring material SA 516 GR70 Thickness 1.00" Joint UW 31.1C located at top of shell, each end.

#12

Tubesheet SA-240 GR304 75.5" 1.5" 0 Welded

Date 1/11/08 Name DCR Construction, Inc. Signed D. J. Ch
(Manufacturer) (Representative)
Date 1-11-2008 Name Ramona Snyder Commission 5789 H B FL #44
(Authorized Inspector) (Nat'l Board incl. Enforcement, State, Province and No.)

EXHIBIT 11

PRESSURE TEST REPORT

Utility/Plant 7793-4504 Tube Side Job No. 7793
Material Specification SA-249, Gr. 304
Pipe Size Range 1.25" Diameter Wall Thickness Range 0.049"
Design Pressure 50 psig PSI Test Pressure 65 psig

* Tubesheets = (Front)@ 72" x 1.5", (Rear)@ 75.5" x 1.5", SA-240, Gr. 304

Decrease the test pressure to the design pressure during examination unless the procedure requires a lower pressure.

Pressure Gauges Serial No. 3901-14 Max. Range 0-200 PSI ☆ Calibration Date 11/26/07

Pressure Gauges Serial No. _____ Max. Range _____ PSI ☆ Calibration Date _____

☆ The calibration date must be less than twelve (12) months prior to the test date.

Testing Medium ☒ Plant Water ☐ Condensate ☐ Treated Water
☐ Demineralized Water ☐ Other _____

Duration at Test Pressure _____ Hours 0 Minutes 15

Remarks _____

Test Results Acceptable

Position Horizontal

Project Manager/Superintendent

Daniel Lake

Date 1-11-08

Q.C. Inspector

[Signature]

Date 1/11/08

Authorized Inspector

[Signature]

Date 1-11-08

Customer Inspector

Date _____

EXHIBIT 11

PRESSURE TEST REPORT

Utility/Plant 7793-4504 Shell Side Job No. 7793

Material Specification SA-516 Grd. 70

Pipe Size Range 72" Diameter (O.D.) Wall Thickness Range .500"

Design Pressure 150 psig PSI Test Pressure 195 psig

Decrease the test pressure to the design pressure during examination unless the procedure requires a lower pressure.

Pressure Gauges Serial No. W508-08 Max. Range 0-300 PSI ☆ Calibration Date 7/11/07

Pressure Gauges Serial No. _____ Max. Range _____ PSI ☆ Calibration Date _____

☆ The calibration date must be less than twelve (12) months prior to the test date.

Testing Medium ☒ Plant Water ☐ Condensate ☐ Treated Water

☐ Demineralized Water ☐ Other _____

Duration at Test Pressure _____ Hours _____ Minutes 15

Remarks _____

Test Results Acceptable

Position Horizontal

Project Manager/Superintendent Daniel Lake Date 1-11-08

Q.C. Inspector [Signature] Date 1/11/08

Authorized Inspector [Signature] Date 1-11-08

Customer Inspector _____ Date _____

Code Symbol



CERTIFIED BY
DCR CONSTRUCTION, INC.
4101 HOLDEN RD
LAKELAND, FL 33811

Max. Allowable Working Pressure
PSIG @ °F

Code Marks

Shell
Side

150

200

Tube
Side

50

300

Max. Allowable External Working Pressure
PSIG @ °F

Shell
Side

15

200

Tube
Side

15

300

User Order No.

61620624004

Min. Design Metal Temp.
°F @ PSIG

User Equip No.

E-4504

Shell
Side

-20

150

Tube
Side

-20

50

Mfg. Serial No. 4504-7793

Year Built

2008

EVAPORATOR CONDENSER

Design Specifications				
TEMA Class		Shell Side	Tube Side	Tubesheets
Design pressure	psi	150	50	
Vacuum design pressre	psi	15	15	
Test pressure	psi	195	65	
Design temperature	F	200	300	300
Average metal temperature	F	94	105	105
Corrosion allowance	in	0.0625		
Front tubesheet corrosion allow	in			
Rear tubesheet corrosion allow	in			
Radiographing		None	None	
Number of passes		1	1	
Nozzle flange rating		150	150	
Post weld heat treatment		No	No	
Code		ASME Section VIII Div.1 2004 A06		TEMA Eighth Edition 1999
Weights		Empty:63547	Full:122848	Bundle:30877 lbf

Cylinders/Covers									
		Front Head		Shell	Rear Head		Shell Cover		Tubes
		Cover	Cyl.	Cyl.	Cyl.	Cover	Cyl.	Cover	
Head type		Flat bolted			Ellipsoidal				
Outside diameter	in	75.625	72	72	72	72			1.25
Calculated thk.	in	2.4301	0.1358	0.4466	0.1358	0.1118			0.0032
TEMA minimum thk.	in		0.3125	0.5	0.3125	0.3125			
Actual thickness	in	2.8125	0.375	0.5	0.3125	0.3125			0.049
X-ray			None	None	None	None			
Joint efficiency			None	None	None	None			
Corrosion allowance	in			0.0625					
External pressure	psi		15	15	15	15			165
Length Ext.Press.	in		127.3125	215.1	27.75				264
Maximum Ext.Press.	psi		25.7	23.887	43.903	29.99			463.726
Minimum thk. Ext.Press.	in		0.303	0.429	0.161	0.196			0.027
Max.length Ext.Press.	in		212.5	332	137.5				800

Nozzles								
Nozzle designator		A	B	C	D	E	G	H
Vessel side		Shell	Shell	Tube	Tube	Tube	Tube	Tube
Outside diameter	in	30	30	54	6.625	6.625	4	3.5
Calculated thickness	in	0.2225	0.2225	0.114	0.0471	0.0471	0.0494	0.0439
Code minimum thk	in	0.3906	0.3906	0.114	0.1301	0.1301	0.1373	0.2265
Actual thickness	in	0.5	0.5	0.375	0.28	0.28	0.337	0.3
Reinf.pad OD	in			76				8
Reinf.pad thickness	in			0.375				0.1875
Corrosion allowance	in	0.0625	0.0625					
External pressure	psi	15	15	15	15	15	15	15
Length ext. press.	in	10	10	17.75	6	6	6	6
Maximum ext. press.	psi	337.032	337.032	91.809	582.329	582.329	1197.307	1209.205

Nozzle Flanges								
----------------	--	--	--	--	--	--	--	--

Nozzle designator		A	B	C	D	E	G	H
Flange type		Slip on	Slip on	Slip on	Slip on	Slip on	Slip on	Slip on
Flange rating		150	150	150	150	150	150	150
Flange OD	in	38.75	38.75	66.25	11	11	8.5	7.5
Bolt circle	in	36	36	62.75	9.5	9.5	7	6
Bolt diameter	in	1.25	1.25	1.75	0.75	0.75	0.625	0.625
Bolt number	in	28	28	44	8	8	8	4
Gasket OD	in	33.75	33.75	59.5	8.5	8.5	5.5	5
Gasket width	in				0.94	0.94	0.75	0.75
Gasket thickness	in	0.125	0.125	0.125	0.125	0.125	0.125	0.125
Flange calc. thk.	in							
Flange actual thk.	in	2.12	2.12	4.75	1	1	0.94	0.94
Lap jnt ring OD	in							
Hub length	in							
Hub slope	in							
Weld height	in							

Body Flanges

		Front Head		Shell		Rear Head		Shell
		Cover	at TbSh	Front	Rear	at TbSh	Cover	
Flange type		Ring				Ring with overlay		
Flange OD	in	75.625				75.5		
Bolt circle	in	74.375				74.25		
Bolt diameter	in	0.5				0.5		
Bolt number		72				72		
Gasket OD	in	73.375				73.25		
Gasket width	in	0.5				0.5		
Gasket thk.	in	0.125				0.125		
Flange calc. thk.	in	2.125				2.6875		
Flange overlay	in					0.25		
Recess	in							
Flange act. thk.	in	2.125				2.9375		
Lap jnt ring OD	in							
Hub length	in							
Hub slope	in							
Weld height	in	0.5625				0.5		

Tubesheets

		Front	Rear
Tubesheet diameter	in	72	75.5
TEMA minimum thickness	in	0.875	0.875
TEMA bending thickness	in	1.9892	1.9892
TEMA shear thickness	in	0.2128	0.2128
TEMA flange extension thk	in		0.6304
TEMA effective thickness	in	2	2
Code thickness	in	1.5	1.5
Corrosion allowance - shell	in		
Corrosion allowance - tube	in		
Recess	in		
Actual thickness	in	1.5	1.5
Clad thickness (not included above)	in		

Tube Details

Tube type		Plain
Tube OD	in	1.25
Tube wall thickness	in	0.049
Number of tubes		1785
Tube length	in	264
Tube pitch	in	1.5625
Tube pattern		30
Outer tube limit diameter	in	70.375

Materials of Construction

Component	Material
Shell Cylinder	SA-516 K02700 Grd 70 Plate
Front Head Cylinder	SA-240 S30400 Grd 304 Plate(G5)
Rear Head Cylinder	SA-240 S30400 Grd 304 Plate(G5)
Front Head Cover	SA-516 K02700 Grd 70 Plate
Rear Head Cover	SA-240 S30400 Grd 304 Plate(G5)
Front Head Lifting Lugs	SA-285 K02801 Grd C Plate
Shell Lifting Lugs	SA-285 K02801 Grd C Plate
Front Tubesheet	SA-240 S30400 Grd 304 Plate
Rear Tubesheet	SA-240 S30400 Grd 304 Plate
Rear Head Fling At TS	SA-516 K02700 Grd 70 Plate
Front Head Fling At Cov	SA-516 K02700 Grd 70 Plate
Rear Head Gasket At TS	Solid Teflon 1/8in Thickness
Front Head Gasket At Cov	Solid Teflon 1/8in Thickness
Tubes	SA-249 S30400 Grd TP304 Wld. tube
Baffles	SA-36 K02600 Plate
Tie Rods	SA-36 Bar
Spacers	SA-214 K01807 Wld. tube
Shell Support A	SA-516 K02700 Grd 70 Plate
Shell Support B	SA-516 K02700 Grd 70 Plate
Coupling	SA-182 S30403 Grd F304L Forgings(<= 5)
Coupling	SA-182 S30403 Grd F304L Forgings(<= 5)
Nozzle A	SA-516 K02700 Grd 70 Plate
Nozzle B	SA-516 K02700 Grd 70 Plate
Nozzle C	SA-240 S30400 Grd 304 Plate(G5)
Nozzle D	SA-312 S30400 Grd TP304 Wld. pipe(G5)
Nozzle E	SA-312 S30400 Grd TP304 Wld. pipe(G5)
Nozzle G	SA-312 S30400 Grd TP304 Wld. pipe(G5)
Nozzle H	SA-312 S30400 Grd TP304 Wld. pipe(G5)
Nozzle J	SA-53 K03005 Grd E/B Wld. pipe
Nozzle K	SA-53 K03005 Grd E/B Wld. pipe
Nozzle Fling A	SA-105 K03504 Forgings
Nozzle Fling B	SA-105 K03504 Forgings
Nozzle Fling C	SA-105 K03504 Forgings
Nozzle Fling D	SA-182 S30403 Grd F304L Forgings(<= 5)
Nozzle Fling E	SA-182 S30403 Grd F304L Forgings(<= 5)
Nozzle Fling G	SA-182 S30403 Grd F304L Forgings(<= 5)
Nozzle Fling H	SA-182 S30403 Grd F304L Forgings(<= 5)
Nozzle Fling J	SA-105 K03504 Forgings
Nozzle Fling K	SA-105 K03504 Forgings
Nozzle Reinforcement C	SA-240 S30400 Grd 304 Plate(G5)
Nozzle Reinforcement H	SA-516 K02700 Grd 70 Plate
Rear Hd Bolting At TS	SA-193 G41400 Grd B7 Bolt(<= 2 1/2)
Front Hd Bolting At Cov	SA-193 G41400 Grd B7 Bolt(<= 2 1/2)
Distributor Belt A	SA-516 K02700 Grd 70 Plate

Distributor Belt B	SA-516 K02700 Grd 70 Plate
Front Head Cover Liner	SA-240 S30400 Grd 304 Plate(G5)
Nozzle Flng Bolting A	SA-193 G41400 Grd B7 Bolt(<= 2 1/2)
Nozzle Flng Bolting B	SA-193 G41400 Grd B7 Bolt(<= 2 1/2)
Nozzle Flng Bolting C	SA-193 G41400 Grd B7 Bolt(<= 2 1/2)

Part #	Component Name	Material	Qty	Dim1		Dim2	Thks	Wght	Cost/Unit	Mat Cost	
				in		in	in	lbf	Dollar(US)	Dollar(US)	
1	Shell Cylinder	SA-516 K02700 Grd 70 Plate	2	225	ci	120	lg	0.5	8414	0.45	3774
1	Shell Cylinder	SA-516 K02700 Grd 70 Plate	1	225	ci	24	lg	0.5	0	0.45	0
2	Fr Hd Cylinder	SA-240 S30400 Grd 304 Plate(G5	1	225.5	ci	120	lg	0.375	3095	2.55	7903
2	Fr Hd Cylinder	SA-240 S30400 Grd 304 Plate(G5	1	225.5	ci	7.5	lg	0.375	0	2.55	0
3	Re Hd Cylinder	SA-240 S30400 Grd 304 Plate(G5	1	225.5	ci	28	lg	0.3125	566	2.55	1446
5	Fr Hd Cover Bolted	SA-516 K02700 Grd 70 Plate	1	76.375	lg	76.375	wi	3.25	5371	0.45	2409
6	Re Hd Cover Ellip.	SA-240 S30400 Grd 304 Plate(G5	1	90.875	lg	90.875	wi	0.375	889	2.55	3783
8	Fr Hd Lift Lugs	SA-285 K02801 Grd C Plate	1	6.375	od	0		1.4375	21	0.4	8
9	Shell Lift Lugs	SA-285 K02801 Grd C Plate	2	6.375	od	0		3.5625	51	0.4	21
11	Front TubSh	SA-240 S30400 Grd 304 Plate	1	72.75	od	0		1.75	2088	2.55	5332
12	Rear TubSh	SA-240 S30400 Grd 304 Plate	1	76.25	od	0		1.75	2294	2.55	5857
18	Re Hd Fling TubSh	SA-516 K02700 Grd 70 Plate	1	76.25	lg	76.25	wi	3.25	5353	0.45	2401
19	Fr Hd Fling Cover	SA-516 K02700 Grd 70 Plate	1	76.375	lg	76.375	wi	2.5	4131	0.45	1853
32	Re Hd Gskt TubSh	Solid Teflon 1/8in Thickness	1	74	od	74	id	0.125	54	23	1252
33	Fr Hd Gskt Cover	Solid Teflon 1/8in Thickness	1	74.125	od	74.125	id	0.125	55	23	1256
38	Tubes (min wall)	SA-249 S30400 Grd TP304 Wld. t	1785	1.25	od	264	lg	0.049	26926	5.75	225639
39	Baffles	SA-36 K02600 Plate	11	71.375	lg	71.375	wi	0.5	7938	0.37	2921
40	Tie Rods	SA-36 Bar	7	0.625	od	218.75	lg	0	220	0.37	81
40	Tie Rods	SA-36 Bar	5	0.625	od	200.88	lg	0	0	0.37	0
41	Spacers	SA-214 K01807 Wld. tube	85	0.875	od	35.75	lg	0.109	291	0.8	232
41	Spacers	SA-214 K01807 Wld. tube	22	0.875	od	17.875	lg	0.109	0	0.8	0
47	Shell Support A	SA-516 K02700 Grd 70 Plate	1	0		0		0	1240	0.45	556
48	Shell Support B	SA-516 K02700 Grd 70 Plate	1	0		0		0	1240	0.45	556
51	Coupling A	SA-182 S30403 Grd F304L Forgin	1	0.5	od	0		0	0	11.47	4
52	Coupling B	SA-182 S30403 Grd F304L Forgin	1	0.5	od	0		0	0	11.47	4
182	TS Nozzle Cplgs	SA-182 S30403 Grd F304L Forgin	1	0		0		0	0	11.47	0
61	Nozzle A	SA-516 K02700 Grd 70 Plate	1	92.6742	ci	10	lg	0.5	131	0.45	59
62	Nozzle B	SA-516 K02700 Grd 70 Plate	1	92.6742	ci	10	lg	0.5	131	0.45	59
63	Nozzle C	SA-240 S30400 Grd 304 Plate(G5	1	168.463	ci	17.75	lg	0.375	322	2.55	822
64	Nozzle D	SA-312 S30400 Grd TP304 Wld. p	1	6.625	od	6	lg	0.28	10	4	38
65	Nozzle E	SA-312 S30400 Grd TP304 Wld. p	1	6.625	od	6	lg	0.28	10	4	38
66	Nozzle G	SA-312 S30400 Grd TP304 Wld. p	1	4	od	6	lg	0.337	7	4	27
67	Nozzle H	SA-312 S30400 Grd TP304 Wld. p	1	3.5	od	6	lg	0.3	5	4	21
68	Nozzle J	SA-53 K03005 Grd E/B Wld. pipe	1	2.375	od	6	lg	0.344	4	0.7	3
69	Nozzle K	SA-53 K03005 Grd E/B Wld. pipe	1	2.375	od	6	lg	0.344	4	0.7	3
93	Nozzle Reinf. C	SA-240 S30400 Grd 304 Plate(G5	1	76.875	lg	76.875	wi	0.375	636	2.55	1624
97	Nozzle Reinf. H	SA-516 K02700 Grd 70 Plate	1	8.75	lg	8.75	wi	0.1875	4	0.45	2
81	Nozzle Fling A Slip On	SA-105 K03504 Forgings	1	150	AN	30	di	0	277	1.58	436
82	Nozzle Fling B Slip On	SA-105 K03504 Forgings	1	150	AN	30	di	0	277	1.58	436
83	Nozzle Fling C Slip On	SA-105 K03504 Forgings	1	150	AN	54	di	0	4639	1.58	7308
84	Nozzle Fling D Slip On	SA-182 S30403 Grd F304L Forgin	1	150	AN	6.625	di	0	17	11.47	196
85	Nozzle Fling E Slip On	SA-182 S30403 Grd F304L Forgin	1	150	AN	6.625	di	0	17	11.47	196
86	Nozzle Fling G Slip On	SA-182 S30403 Grd F304L Forgin	1	150	AN	4	di	0	12	11.47	135
87	Nozzle Fling H Slip On	SA-182 S30403 Grd F304L Forgin	1	150	AN	3.5	di	0	9	11.47	106
88	Nozzle Fling J Slip On	SA-105 K03504 Forgings	1	150	AN	2.375	di	0	5	1.58	8
89	Nozzle Fling K Slip On	SA-105 K03504 Forgings	1	150	AN	2.375	di	0	5	1.58	8
102	Re Hd Blts TubSh	SA-193 G41400 Grd B7 Bolt(<= 2	72	0.5	od	6.5	lg	0	26	2.48	65

Heat Exchanger Mechanical Design

Teams 20.0

E-4504 FINAL 7793 Date: 9/25/2007 Time: 11:56:40 AM

103	Fr Hd Blts Cover	SA-193 G41400 Grd B7 Bolt(<= 2	72	0.5od	7.5	lg	0	30	2.48	75
115	Distrib. Belt A	SA-516 K02700 Grd 70 Plate	1	281.17lg	45	wi	0.75	7240	0.45	3247
116	Distrib. Belt B	SA-516 K02700 Grd 70 Plate	1	281.17lg	45	wi	0.75	7240	0.45	3247
118	Fr Hd Cover Liner	SA-240 S30400 Grd 304 Plate(G5	1	76.375od	0		0.5	658	2.55	1679
122	Dist.Belt An.Rng	SA-516 K02700 Grd 70 Plate	4	89.5	0		1	0	0	0
184	Small Cyl Reinf	SA-516 K02700 Grd 70 Plate	1	1.25lg	1.25	wi	0.0625	0	0.45	0

Teams 20.0

[illegible]



Aspen Technology, Inc.
Boulder, Colorado
© Aspen Technology, Inc. 2007

Component: Shell Cylinder
ASME Section VIII-1 2004 A06 UG-27 Thickness of Shells under Int. Pressure
--- Calculations --- Cylinder Internal Pressure
Material: SA-516 K02700 Grd 70 Plate
Design pressure P = 150 psi Design temperature T = 200 F
Radiography = None Joint eff.circ str. E = 0.7
Design stress S = 20000 psi Joint eff.long str. E = 0.7
Design stress, long S = 20000 psi (circum. butt welds)
Inside corr.allow. CAI = 0.0625 in Outside corr. all. CAO = 0.0 in
Material tolerance Tol = 0.0 in TEMA min. thickness tm = 0.5 in
Outside diameter OD = 72.0 in Corroded radius OR = 36.0 in
Required wall thickness of the cylinder , greater of:
Circumferential stress
t = (P*OR / (S*E+0.4*P))+cai+cao+tol = 0.4466 in APP.1-1(A)
Longitudinal stress
t = (P*IR / (2*S*E+0.4*P))+cai+cao+tol = 0.2526 in UG-27(c) (2)
Actual wall thickness of cylinder: tnom = 0.5 in
(Required wall tks. for nozzle attachments, E=1 , tri = 0.2692 in)
ASME Section VIII-1 2004 A06 UG-28 Thickness of Shells under Ext. Pressure
--- Calculations --- Cylinder External Pressure
Material: SA-516 K02700 Grd 70 Plate
Design pressure PE = 15 psi Design temperature T = 200 F
Inside corr. allow. CAI = 0.0625 in Corrosion allow. CAO = 0 in
Radiography = None Material tol. Tol = 0 in
Cyl. outside dia. Do = 72 in Cylinder length EP L = 215.1 in
Nominal thickness tnom = 0.5 in (tnom-CAI-CAO-Tol) t = 0.4375 in
L/Do ratio Ldo = 2.9875 Do/t Dot = 164.5714
(2*S) or (0.9*yield) SE = - Mod. of elasticity ME = 28600000 psi
A factor SII-D-FigG A = 0.000205 B factor CS-2 B = 2948
Max allowed external pressure: Pa = 4*B / (3*Dot) = 23.89 psi
Actual external design pressure: PE = 15 psi
(Required cyl. tks. for nozzle attachments at PE, tre = 0.3665 in)

Component: Front Head Cylinder

ASME Section VIII-1 2004 A06 UG-27 Thickness of Shells under Int. Pressure

--- Calculations --- Cylinder Internal Pressure

Material: SA-240 S30400 Grd 304 Plate(G5)

Design pressure	P = 50 psi	Design temperature	T = 300 F
Radiography	= None	Joint eff.circ str.	E = 0.7
Design stress	S = 18900 psi	Joint eff.long str.	E = 0.7
Design stress, long	S = 18900 psi	(circum. butt welds)	
Inside corr.allow.	CAI = 0.0 in	Outside corr. all.	CAO = 0.0 in
Material tolerance	Tol = 0.0 in	TEMA min. thickness	tm = 0.3125 in
Outside diameter	OD = 72.0 in	Corroded radius	OR = 36.0 in

Required wall thickness of the cylinder , greater of:

Circumferential stress

$$t = (P \cdot OR / (S \cdot E + 0.4 \cdot P)) + cai + cao + tol = 0.1358 \text{ in} \quad \text{APP.1-1(A)}$$

Longitudinal stress

$$t = (P \cdot IR / (2 \cdot S \cdot E + 0.4 \cdot P)) + cai + cao + tol = 0.0673 \text{ in} \quad \text{UG-27(c)(2)}$$

Actual wall thickness of cylinder: tnom = 0.375 in

(Required wall tks. for nozzle attachments, E=1 , tri = 0.0951 in)

ASME Section VIII-1 2004 A06 UG-28 Thickness of Shells under Ext. Pressure

--- Calculations --- Cylinder External Pressure

Material: SA-240 S30400 Grd 304 Plate(G5)

Design pressure	PE = 15 psi	Design temperature	T = 300 F
Inside corr. allow.	CAI = 0 in	Corrosion allow.	CAO = 0 in
Radiography	= None	Material tol.	Tol = 0 in
Cyl. outside dia.	Do = 72 in	Cylinder length EP	L = 127.3125 in
Nominal thickness	tnom = 0.375 in	(tnom-CAI-CAO-Tol)	t = 0.375 in
L/Do ratio	Ldo = 1.7682	Do/t	Dot = 192.0
(2*S) or (0.9*yield)	SE = -	Mod. of elasticity	ME = 27000000 psi
A factor SII-D-FigG	A = 0.000281	B factor HA-1	B = 3701

Max allowed external pressure: Pa = 4*B / (3*Dot) = 25.7 psi

Actual external design pressure: PE = 15 psi

(Required cyl. tks. for nozzle attachments at PE, tre = 0.303 in)

Component: Rear Head Cylinder

ASME Section VIII-1 2004 A06 UG-27 Thickness of Shells under Int. Pressure

--- Calculations --- Cylinder Internal Pressure

Material: SA-240 S30400 Grd 304 Plate(G5)

Design pressure	P = 50 psi	Design temperature	T = 300 F
Radiography	= None	Joint eff.circ str.	E = 0.7
Design stress	S = 18900 psi	Joint eff.long str.	E = 0.7
Design stress, long	S = 18900 psi	(circum. butt welds)	
Inside corr.allow.	CAI = 0.0 in	Outside corr. all.	CAO = 0.0 in
Material tolerance	Tol = 0.0 in	TEMA min. thickness	tm = 0.3125 in
Outside diameter	OD = 72.0 in	Corroded radius	OR = 36.0 in

Required wall thickness of the cylinder , greater of:

Circumferential stress

$t = (P \cdot OR / (S \cdot E + 0.4 \cdot P)) + cai + cao + tol = 0.1358 \text{ in}$ APP.1-1(A)

Longitudinal stress

$t = (P \cdot IR / (2 \cdot S \cdot E + 0.4 \cdot P)) + cai + cao + tol = 0.0674 \text{ in}$ UG-27(c) (2)

Actual wall thickness of cylinder: tnom = 0.3125 in

(Required wall tks. for nozzle attachments, E=1 , tri = 0.0951 in)

ASME Section VIII-1 2004 A06 UG-28 Thickness of Shells under Ext. Pressure

--- Calculations --- Cylinder External Pressure

Material: SA-240 S30400 Grd 304 Plate(G5)

Design pressure	PE = 15 psi	Design temperature	T = 300 F
Inside corr. allow.	CAI = 0 in	Corrosion allow.	CAO = 0 in
Radiography	= None	Material tol.	Tol = 0 in
Cyl. outside dia.	Do = 72 in	Cylinder length EP	L = 27.75 in
Nominal thickness	tnom = 0.3125 in	(tnom-CAI-CAO-Tol)	t = 0.3125 in
L/Do ratio	Ldo = 0.3854	Do/t	Dot = 230.4
(2*S) or (0.9*yield)	SE = -	Mod. of elasticity	ME = 270000000 psi
A factor SII-D-FigG	A = 0.001067	B factor HA-1	B = 7586
Max allowed external pressure:	Pa = 4*B / (3*Dot)		= 43.9 psi
Actual external design pressure:		PE = 15 psi	

(Required cyl. tks. for nozzle attachments at PE, tre = 0.161 in)

Component: Rear Head Cover

ASME Section VIII-1 2004 A06 UG-32 Formed Heads, and Sections,
Pressure on Concave Side

--- Calculations --- Ellipsoidal Cover Internal Pressure with t/L >= 0.002

Material: SA-240 S30400 Grd 304 Plate(G5)

Design pressure	P = 50 psi	Design temperature	T = 300 F
Radiography	= None	Joint efficiency	E = 0.85
Design stress	S = 18900 psi	TEMA min. thk	tm = 0.3125 in
Inside corr.all.	CAI = 0.0 in	Outside corr.all.	CAO = 0.0 in
Major/minor rat.	D/2h = 2.0	Forming tolerance	Tol = 0.0 in
Corroded min. thk	t = 0.095 in	Equiv.dish radius	L = 64.2375 in
Ratio t/L	= 0.00486	Material tol.	Tol = 0.0 in
Outside diameter	OD = 72.0 in	Corroded diameter	OD = 72.0 in
Proportion factor	K = 0.1667*(2+(D/2h)**2)		= 1.0002

Required wall thickness of the cover:

t = (P*OD*K / (2*S*E+2*P*(K-0.1)))+cai+cao+tol = 0.1118 in App. 1-4(c)

Actual wall thickness of cover: tnom = 0.3125 in

(Required wall tks. for nozzle attachments, E=1 , tri = 0.095 in)

(If opening & reinf. are within 80% of head diameter, tri = 0.0856 in)

ASME Section VIII-1 2004 A06 UG-33 Formed Heads, Pressure on Convex Side

--- Calculations --- Ellipsoidal Cover External Pressure

Material: SA-240 S30400 Grd 304 Plate(G5)

Design pressure	PE = 15 psi	Design temperature	T = 300 F
Inside corr. allow.	CAI = 0 in	Outside corr. all.	CAO = 0 in
Radiography	= None	Forming tolerance	Tol = 0 in
		Material tolerance	Tol = 0 in
Cover outside dia.	Do = 72 in	Outside sph.radius	Ro = 64.8 in
Nominal thickness	tnom = 0.3125 in	tnom-CAI-CAO-Tol	t = 0.3125 in
Ko factor (UG-33.1)	Ko = 0.9	Ro/t ratio	Rot = 207.36
UG-33(a)	165.35/1.67 = 99.01 psi	Mod. of elasticity	ME = 27000000 psi
A factor = 0.125/Rot	= 0.000603	B factor HA-1	B = 6219
Maximum allowed external pressure:	Pa = B / Rot		= 29.99 psi
Actual external design pressure:		PE = 15 psi	

(Required cov. tks. for nozzle attachments at PE, tre = 0.196 in)

Component: Distributor Belt A
ASME Section VIII Div.1 2004 A06, Appendix 9 - Jacketed Vessels
--- Calculations --- Closure Member per Type 1 Figure 9-2.
OD of dist. belt OD = 89.5 in ID of dist. belt ID = 88.0 in
Corroded jacket space j = 8.0625 in Min. fillet weld Y = 0.52 in
Corrosion allowance c = 0.0625 in Min. thk.outer wall trj = 0.0 in
Required minimum thickness of closure member, trc
Figure 9-5 type: (b-2)
trc = <= trj trc = 0.5399 in
Actual thickness, tc tc = 1.0 in

Component: Distributor Belt A
ASME Section VIII-1 2004 A06 UG-27 Thickness of Shells under Int. Pressure
--- Calculations --- Cylinder Internal Pressure
Material: SA-516 K02700 Grd 70 Plate
Design pressure P = 150 psi Design temperature T = 200 F
Radiography = None Joint eff.circ str. E = 0.7
Design stress S = 20000 psi Joint eff.long str. E = 0.7
Design stress, long S = 20000 psi (circum. butt welds)
Inside corr.allow. CAI = 0.0625 in Outside corr. all. CAO = 0.0 in
Material tolerance Tol = 0.0 in TEMA min. thickness tm = 0.0 in
Outside diameter OD = 89.5 in Corroded radius OR = 44.75 in
Required wall thickness of the cylinder , greater of:
Circumferential stress
t = (P*OR / (S*E+0.4*P))+cai+cao+tol = 0.5399 in APP.1-1(A)
Longitudinal stress
t = (P*IR / (2*S*E+0.4*P))+cai+cao+tol = 0.298 in UG-27(c) (2)
Actual wall thickness of cylinder: tnom = 0.75 in
(Required wall tks. for nozzle attachments, E=1 , tri = 0.3346 in)
ASME Section VIII-1 2004 A06 UG-28 Thickness of Shells under Ext. Pressure
--- Calculations --- Cylinder External Pressure
Material: SA-516 K02700 Grd 70 Plate
Design pressure PE = 15 psi Design temperature T = 200 F
Inside corr. allow. CAI = 0.0625 in Corrosion allow. CAO = 0 in
Radiography = None Material tol. Tol = 0 in
Cyl. outside dia. Do = 89.5 in Cylinder length EP L = 45 in
Nominal thickness tnom = 0.75 in (tnom-CAI-CAO-Tol) t = 0.6875 in
L/Do ratio Ldo = 0.5028 Do/t Dot = 130.1818
(2*S) or (0.9*yield) SE = - Mod. of elasticity ME = 28600000 psi
A factor SII-D-FigG A = 0.001901 B factor CS-2 B = 14783
Max allowed external pressure: Pa = 4*B / (3*Dot) = 151.4 psi
Actual external design pressure: PE = 15 psi
(Required cyl. tks. for nozzle attachments at PE, tre = 0.2185 in)

Component: Distributor Belt B
ASME Section VIII Div.1 2004 A06, Appendix 9 - Jacketed Vessels
--- Calculations --- Closure Member per Type 1 Figure 9-2.
OD of dist. belt OD = 89.5 in ID of dist. belt ID = 88.0 in
Corroded jacket space j = 8.0625 in Min. fillet weld Y = 0.52 in
Corrosion allowance c = 0.0625 in Min. thk.outer wall trj = 0.0 in
Required minimum thickness of closure member, trc
Figure 9-5 type: (b-2) trc = 0.5399 in
trc = <= trj tc = 1.0 in
Actual thickness, tc

Component: Distributor Belt B
ASME Section VIII-1 2004 A06 UG-27 Thickness of Shells under Int. Pressure
--- Calculations --- Cylinder Internal Pressure
Material: SA-516 K02700 Grd 70 Plate
Design pressure P = 150 psi Design temperature T = 200 F
Radiography = None Joint eff.circ str. E = 0.7
Design stress S = 20000 psi Joint eff.long str. E = 0.7
Design stress, long S = 20000 psi (circum. butt welds)
Inside corr.allow. CAI = 0.0625 in Outside corr. all. CAO = 0.0 in
Material tolerance Tol = 0.0 in TEMA min. thickness tm = 0.0 in
Outside diameter OD = 89.5 in Corroded radius OR = 44.75 in
Required wall thickness of the cylinder , greater of:
Circumferential stress
t = (P*OR / (S*E+0.4*P))+cai+cao+tol = 0.5399 in APP.1-1(A)
Longitudinal stress
t = (P*IR / (2*S*E+0.4*P))+cai+cao+tol = 0.298 in UG-27(c) (2)
Actual wall thickness of cylinder: tnom = 0.75 in
(Required wall tks. for nozzle attachments, E=1 , tri = 0.3346 in)
ASME Section VIII-1 2004 A06 UG-28 Thickness of Shells under Ext. Pressure
--- Calculations --- Cylinder External Pressure
Material: SA-516 K02700 Grd 70 Plate
Design pressure PE = 15 psi Design temperature T = 200 F
Inside corr. allow. CAI = 0.0625 in Corrosion allow. CAO = 0 in
Radiography = None Material tol. Tol = 0 in
Cyl. outside dia. Do = 89.5 in Cylinder length EP L = 45 in
Nominal thickness tnom = 0.75 in (tnom-CAI-CAO-Tol) t = 0.6875 in
L/Do ratio Ldo = 0.5028 Do/t Dot = 130.1818
(2*S) or (0.9*yield) SE = - Mod. of elasticity ME = 28600000 psi
A factor SII-D-FigG A = 0.001901 B factor CS-2 B = 14783
Max allowed external pressure: Pa = 4*B / (3*Dot) = 151.4 psi
Actual external design pressure: PE = 15 psi
(Required cyl. tks. for nozzle attachments at PE, tre = 0.2185 in)

Component: Tubes

ASME Section VIII-1 2004 A06 UG-27 Thickness of Shells under Int. Pressure

--- Calculations --- Cylinder Internal Pressure

Material: SA-249 S30400 Grd TP304 Wld. tube

Design pressure P = 65 psi Design temperature T = 300 F

Radiography = - Joint eff.circ str. E = 1

Design stress S = 12700 psi Joint eff.long str. E = -

Design stress, long S = - (circum. butt welds)

Inside corr.allow. CAI = 0.0 in Outside corr. all. CAO = 0.0 in

Material tolerance Tol = 0.0 in TEMA min. thickness tm = 0.0 in

Outside diameter OD = 1.25 in Corroded radius OR = 0.625 in

Required wall thickness of the cylinder , greater of:

Circumferential stress

$$t = (P \cdot OR / (S \cdot E + 0.4 \cdot P)) + cai + cao + tol = 0.0032 \text{ in} \quad \text{APP.1-1(A)}$$

Longitudinal stress

$$t = (P \cdot IR / (2 \cdot S \cdot E + 0.4 \cdot P)) + cai + cao + tol = - \quad \text{UG-27(c) (2)}$$

Actual wall thickness of cylinder: tnom = 0.049 in

(Required wall tks. for nozzle attachments, E=- , tri = -)

ASME Section VIII-1 2004 A06 UG-28 Thickness of Shells under Ext. Pressure

--- Calculations --- Cylinder External Pressure

Material: SA-249 S30400 Grd TP304 Wld. tube

Design pressure PE = 165 psi Design temperature T = 300 F

Inside corr. allow. CAI = 0 in Corrosion allow. CAO = 0 in

Radiography = Full Material tol. Tol = 0 in

Cyl. outside dia. Do = 1.25 in Cylinder length EP L = 264 in

Nominal thickness tnom = 0.049 in (tnom-CAI-CAO-Tol) t = 0.049 in

L/Do ratio Ldo = 211.2 Do/t Dot = 25.5102

(2*S) or (0.9*yield) SE = - Mod. of elasticity ME = 27000000 psi

A factor SII-D-FigG A = 0.001705 B factor HA-1 B = 8872

Max allowed external pressure: Pa = 4*B / (3*Dot) = 463.73 psi

Actual external design pressure: PE = 165 psi

(Required cyl. tks. for nozzle attachments at PE, tre = 0.027 in)

Component: Tube-to-Tubesheet Welds

ASME Section VIII Div.1 2004 A06 UW-20 Tube-To-Tubesheet Welds
--- Calculations --- Fig UW-20.1 Sketch (a) Full Strength
Tubesheet material: SA-240 S30400 Grd 304 Plate
Tubesheet clad mtl: -
Tubes material: SA-249 S30400 Grd TP304 Wld. tube
Allowable stress TubS St = 15000 psi All. stress tubes Sa = 14941 psi
Allowable stress weld Sw = 14941 psi Tube OD do = 1.25 in
Tube thickness t = 0.049 in
Design temperature TubSh = 300 F Design temp. tubes = 300 F
Fille weld leg af = 0.0833 in Groove weld leg ag = 0.0 in
Minimum length ac acmin = 0.0821 in Total length ac = af+ag = 0.0833 in
Fillet weld strength = Ff = 0.55*Pi*af*(do+0.67*af)*Sw Ff = 2808 lbf
Groove weld strength = Fg = 0.85*Pi*ag*(do+0.67*ag)*Sw Fg = 0 lbf
Tube strength Ft = Pi * t * (do - t) * Sa Ft = 2762 lbf
Design Strength Fd = 2762 lbf
Fillet weld strength, Ff = min (Ff, Ft) Ff = 2762 lbf
Groove weld strength, Fg = min (Fg, Ft) Fg = 0 lbf
Weld strength factor fw = Sa / Sw fw = 1
Ratio fd = Fd / Ft fd = 1
Ratio ff = 1 - Fg / (fd * Ft) ff = 1
Minimum required length of the weld leg(s), ar
ar = SQRT((0.75*do)**2 + 2.73*t*(do-t)*fw*fd) - 0.75*do ar = 0.0821 in
UW-18(d) - Allowable load on fillet/groove welds Weld Leg = 0.0833 in
Allowable Load = PI * do * Weld Leg * Sw * 0.55 = 2688 lbf
Maximum Allowable Axial Loads, Lmax
Pressure only = LmaxP = Ft LmaxP = 2762 lbf
Other loads = LmaxO = 2*Ft LmaxO = 5525 lbf
Total weld throat dimension = 0.059 in

Component: Front Head Fling At Cov

ASME Section VIII-1 2004 A06 App. 2 Bolted Flange With Ring Type Gaskets
Flange type: Optional type ring - code fig.2-4(8)
Flange material: SA-240 S30400 Grd 304 Plate

Int. design pressure	PI = 50 psi	Design temperature	T = 300 F
Ext. design pressure	PE = 15 psi	B1 = B+g1 or B+go	B1 = -
Inside corr. allow	CAI = 0.0 in	Outside corr. all.	CAO = 0.0 in
Stress (operating)	SFO = 15000 psi	Stress (atmos.)	SFA = 20000 psi
Outside diameter	A = 75.625 in	Inside spherical rad.	L = -
Inside diameter	B = 71.25 in	Hub thickness	g1 = 0.9375 in
Bolt circle diameter	C = 74.375 in	Hub tks. at attach.	go = 0.375 in
Mean gasket diameter	G = 72.875 in	Weld leg/hub length	h = 0.5625 in
Hub to bolt circle	R = 0.625 in	Bolt circle to OD	E = 0.625 in
Flange thickness	t = 2.125 in		

Note: Optional Type Flanges use the smaller of integral or loose calculation.
Gasket material: Solid Teflon 1/8in Thickness

Gasket outside dia.	ODG = 73.375 in	Gasket width	Wth = 0.5 in
Gasket thickness	tk = 0.125 in	Gasket factor	m = 2.0
Gasket seating stress	y = 1600 psi	Gasket eff. width	b = 0.25 in
Gasket rib length	Rib = 0.0 in	Seating width	bo = 0.25 in
Gasket rib eff width	Br = 0.0 in	(Table 2-5.2 facing 1a/1b Col. II)	

Bolt material: SA-193 G41400 Grd B7 Bolt(<= 2 1/2)
Bolt diameter Dia = 0.5 in No. of bolts No. = 72
Bolt root area Area = 0.126 in2

Stress (operating)	SB = 25000 psi	Stress (atmos.)	SA = 25000 psi
Joint-contact compr. load	HP = 6.2832*b*G*PI*m+2*Br*m*PI*RIB		= 11447 lbf
Hydrostatic end force	H = 0.7854*G*G*PI		= 208554 lbf
Hydrostatic end force	He = 0.7854*G*G*PE		= 62566 lbf

Operating conditions:

Min. calc. bolt load	WM1 = HP+H		= 220001 lbf
Min. used bolt load	WM1 = max of 2 mating flanges		= 220001 lbf

Bolting up conditions:

Minimum bolt load	WM2 = b*3.1416*G*Y+Br*Y*RIB		= 91577 lbf
Min. used bolt load	WM2 = max of 2 mating flanges		= 91577 lbf
Required bolt area	AM = WM2/SA or WM1/SB		= 8.8 in2
Available bolt area	AB = No.Bolt*Area		= 9.07 in2
Design bolt load	W = 0.5*(AM+AB)*SA		= 223400 lbf
Minimum gasket width	NMIN = AB*SA/(6.283*y*G)		= 0.3096 in
Gasket compression stress	Gcst = AB*SA/(Pi*G*Wth)		= 1981 psi

Loads:		Integral Flange Calculations	
Operating conditions:			
Hydrostatic end load	HD = 0.785*B*B*PI	=	199357 lbf
Hydrostatic end load	HDe= 0.785*B*B*PE	=	59807 lbf
Gasket load	HG = WM1-H	=	11447 lbf
Result. hydrostatic force	HT = H-HD	=	9197 lbf
Result. hydrostatic force	HTe= He-HDe	=	2759 lbf
Bolting up conditions:			
Gasket load	HG = W	=	223400 lbf
Operating conditions:			
Hydrostatic lever arm	hd = R+0.5*g1	=	1.0938 in
Gasket load lever arm	hg = (C-G) /2	=	0.75 in
Result. hydro. lever arm	ht = (R+g1+hg)/2.0	=	1.1563 in
Bolting up conditions:			
Gasket load lever arm	hg = (C-G) /2	=	0.75 in
Operating conditions:			
Hydrostatic moment	MD = HD*hd	=	218046 lbf*in
Gasket moment	MG = HG*hg	=	8585 lbf*in
Result. hydro. moment	MT = HT*ht	=	10634 lbf*in
Total operating moment	MOP = MD+MG+MT	=	237266 lbf*in
Total operating mom. MOPe=	HDe(hd-hg)+HTe(ht-hg)	=	21680 lbf*in
Bolting up conditions:			
Bolt up moment	MATM = W*hg	=	167550 lbf*in
Effective bolt moment	MB = MATM*SFO/SFA	=	125663 lbf*in
Total moment	MO = MOP or MB	=	237266 lbf*in
Bolt spacing correction	M = MO*Cf	=	237266 lbf*in
(TEMA 1999 RCB-11.23) Cf= 1			
Flange shape constants:			
K = A/B	= 1.0614	ho = SQ(B*G0)	= 5.169
TF = Fig.2-7.1	= 1.8907	h/ho = h/ho	= 0.1088
Z = Fig.2-7.1	= 16.8006	F = Fig.2-7.2	= 0.9037
Y = Fig.2-7.1	= 32.3321	V = Fig.2-7.3	= 0.4157
U = Fig.2-7.1	= 35.5297	f = Fig.2-7.6	= 5.0418
G1/G0 = G1/Go	= 2.5	e = F/ho	= 0.1748
t =	= 2.125 in		
D = U*ho*g0*g0/V	= 62.1218	Alpha = t*e+1.0	= 1.3715
Beta = 1.333*t*e+1.0	= 1.4952	Gamma = Alpha/TF	= 0.7254
Delta = t*t*t/D	= 0.1545	Lambda = Gamma+Delta	= 0.8799
Stress calculations:		Allowable stress:	
Long. hub	SH = (f*M) / (Lambda*g1**2*B)	= 21711 psi	1.5*SFO = 22500 psi
Radial	SR = Beta*M/ (Lambda*t***2*B)	= 1253 psi	SFO = 15000 psi
Tangential	ST1 = M*Y/ (t**2*B) - (Z*SR)	= 2789 psi	SFO = 15000 psi
(greater)	ST2 = (SH+SR)/2 or (SH+ST1)/2	= 12250 psi	SFO = 15000 psi

Loads:

Operating conditions:

Hydrostatic end load

Hydrostatic end load

Gasket load

Result. hydrostatic force

Result. hydrostatic force

Bolting up conditions:

Gasket load

Operating conditions:

Hydrostatic lever arm

Gasket load lever arm

Result. hydro. lever arm

Bolting up conditions:

Gasket load lever arm

Operating conditions:

Hydrostatic moment

Gasket moment

Result. hydro. moment

Total operating moment

Total operating mom. MOPe=

Bolting up conditions:

Bolt up moment

Effective bolt moment

Total moment

Bolt spacing correction

(TEMA 1999 RCB-11.23) Cf= 1

Flange shape constants:

B =

K = A/B

Y = Fig.2-7.1

Flange calculated thickness:

Flange nominal thickness:

Stress calculations:

Tangential, ST = MO*Cf*Y/(B*tnom**2) = 14545 psi

Loose Flange Calculations

HD = 0.785*B*B*PI = 204283 lbf

HDe= 0.785*B*B*PE = 61285 lbf

HG = WM1-H = 11447 lbf

HT = H-HD = 4271 lbf

HTe= He-HDe = 1281 lbf

HG = W = 223400 lbf

hd = (C-B)/2.0 = 1.125 in

hg = (C-G)/2 = 0.75 in

ht = (hd+hg)/2.0 = 0.9375 in

hg = (C-G)/2 = 0.75 in

MD = HD*hd = 229819 lbf*in

MG = HG*hg = 8585 lbf*in

MT = HT*ht = 4004 lbf*in

MOP = MD+MG+MT = 242408 lbf*in

HDe(hd-hg)+HTe(ht-hg) = 23222 lbf*in

MATM = W*hg = 167550 lbf*in

MB = MATM*SFO/SFA = 125663 lbf*in

MO = MOP or MB = 242408 lbf*in

M = MO*Cf = 242408 lbf*in

= 72.125 in

= 1.0485

= 40.5881

t = (M*Y/SFO*B)**0.5 = 3.0157 in

tnom = 2.125 in

Allowable stress:

SFO = 15000 psi

Component: Channel Cover

ASME Section VIII-1 2004 A06 UG-34 Unstayed Flat Heads and Covers
--- Calculations --- Channel Cover Internal Pressure
Material: SA-516 K02700 Grd 70 Plate
Design pressure P = 50 psi Design temperature T = 300 F
Stress (operating) SO = 20000 psi Stress (atmos.) SA = 20000 psi
Corr. allowance CAI = 0.0 in
Outside diameter OD = 75.625 in
Bolt circle diameter C = 74.375 in
Mean gasket diameter G = 72.875 in
Mod. of elasticity ME = -
Required thickness t = 2.4301 in Nominal thickness tn = 2.8125 in
Gasket load lever arm hg = (C-G)/2 = 0.75 in
ASME Section VIII-1 2004 A06 UG-34 Unstayed Flat Heads and Covers
--- Calculations --- Channel Cover Internal Pressure
Operating bolt load Wo = 220001 lbf Factor 'C' C = 0.3
Gasket seating load Wb = 223400 lbf Joint efficiency E = 0.7
Available bolt area Ab = 9.072 in2 Factor x per UG-39(d) (2) = 1
Bolt stress (oper.) Sb = 25000 psi Nominal diameter ND = 71 in
Code required cover thickness:
Operating: $t = G \cdot \sqrt{x \cdot (C \cdot P / SO \cdot E + 1.9 \cdot W_o \cdot h_g / (SO \cdot G^3))}$ = 2.4301 in
Bolting: $t = G \cdot \sqrt{x \cdot (1.9 \cdot W_b \cdot h_g / (SA \cdot E \cdot G^3))}$ = 0.5586 in
TEMA 1999 RCB-9.21 (cover deflection)
 $Y = G \cdot (0.0435 \cdot G^3 \cdot P + 0.5 \cdot S_b \cdot A_b \cdot h_g) / (ME \cdot t^3)$ = -
Ymax = 0.03 in. (0.076 mm) or ND/800 or User specified = -
 $t = (G \cdot (0.0435 \cdot G^3 \cdot P + 0.5 \cdot S_b \cdot A_b \cdot h_g) / (ME \cdot Y_{max}))^{.333}$ = -
Thicknesses do NOT include corrosion or recesses.

Component: Front Head Flng At Cov
ASME Section VIII Div.1 2004 A06, Appendix 2, 2-14 Flange Rigidity
--- Calculations ---
Operating moment, Mo = 237266 lbf*in Gasket seat. moment Ma = 167550 lbf*in
Factor V V = 0.416 Factor L L = 0.8799
Mod. elast.design T Ed = 27000000 psi Mod.elast.atm. temp Ea = 28300000 psi
Thickness g0 g0 = 0.375 in Factor h0 h0 = 5.169 in
Factor KI KI = 0.3 Factor KL KL = 0.2
Corrosion allowance ca = 0.0 in Factor K K = 1.0614
Thickness, T T = 2.125 in
Rigidity index, J, loose flange type
Gasket seating $J = 109.4 * Ma / (E * T ** 3 * Ln(K) * KL) = -$
Operating $J = 109.4 * Mo / (E * T ** 3 * Ln(K) * KL) = -$
Rigidity index, J, integral flange type
Gasket seating $J = 52.14 * Ma * V / (L * E * G0 ** 2 * ho * KI) = 0.6689$
Operating $J = 52.14 * Mo * V / (L * E * G0 ** 2 * ho * KI) = 0.9928$

Component: Rear Head Flng At TS

ASME Section VIII-1 2004 A06 App. 2 Bolted Flange With Ring Type Gaskets

Flange type: Ring

Flange material: SA-516 K02700 Grd 70 Plate

Int. design pressure	PI = 50 psi	Design temperature	T = 300 F
Ext. design pressure	PE = 15 psi	B1 = B+g1 or B+go	B1 = -
Inside corr. allow	CAI = 0.0 in	Outside corr. all.	CAO = 0.0 in
Stress (operating)	SFO = 20000 psi	Stress (atmos.)	SFA = 20000 psi
Outside diameter	A = 75.5 in	Inside spherical rad.	L = -
Inside diameter	B = 71.375 in	Hub thickness	g1 = 0.8125 in
Bolt circle diameter	C = 74.25 in	Hub tks. at attach.	go = 0.3125 in
Mean gasket diameter	G = 72.75 in	Weld leg/hub length	h = 0.5 in
Hub to bolt circle	R = 0.625 in	Bolt circle to OD	E = 0.625 in
Flange thickness	t = 2.6875 in		

Note: Optional Type Flanges use the smaller of integral or loose calculation.

Gasket material: Solid Teflon 1/8in Thickness

Gasket outside dia.	ODG = 73.25 in	Gasket width	Wth = 0.5 in
Gasket thickness	tk = 0.125 in	Gasket factor	m = 2.0
Gasket seating stress	y = 1600 psi	Gasket eff. width	b = 0.25 in
Gasket rib length	Rib = 0.0 in	Seating width	bo = 0.25 in
Gasket rib eff width	Br = 0.0 in	(Table 2-5.2 facing 1a/1b Col. II)	

Bolt material: SA-193 G41400 Grd B7 Bolt(<= 2 1/2)

Bolt diameter	Dia = 0.5 in	No. of bolts	No. = 72
Bolt root area	Area = 0.126 in2		

Stress (operating)	SB = 25000 psi	Stress (atmos.)	SA = 25000 psi
Joint-contact compr. load	HP = 6.2832*b*G*PI*m+2*Br*m*PI*RIB	=	11428 lbf
Hydrostatic end force	H = 0.7854*G*G*PI	=	207839 lbf
Hydrostatic end force	He= 0.7854*G*G*PE	=	62352 lbf

Operating conditions:

Min. calc. bolt load	WM1 = HP+H	=	219266 lbf
Min. used bolt load	WM1 = max of 2 mating flanges	=	219266 lbf

Bolting up conditions:

Minimum bolt load	WM2 = b*3.1416*G*Y+Br*Y*RIB	=	91420 lbf
Min. used bolt load	WM2 = max of 2 mating flanges	=	91420 lbf
Required bolt area	AM = WM2/SA or WM1/SB	=	8.77 in2
Available bolt area	AB = No.Bolt*Area	=	9.07 in2
Design bolt load	W = 0.5*(AM+AB)*SA	=	223033 lbf
Minimum gasket width	NMIN = AB*SA/(6.283*y*G)	=	0.3101 in
Gasket compression stress	Gcst = AB*SA/(Pi*G*Wth)	=	1985 psi

Loads:	Integral Flange Calculations			
Operating conditions:				
Hydrostatic end load	HD = 0.785*B*B*PI	=	200057	lbf
Hydrostatic end load	HDe= 0.785*B*B*PE	=	60017	lbf
Gasket load	HG = WM1-H	=	11428	lbf
Result. hydrostatic force	HT = H-HD	=	7782	lbf
Result. hydrostatic force	HTe= He-HDe	=	2335	lbf
Bolting up conditions:				
Gasket load	HG = W	=	223033	lbf
Operating conditions:				
Hydrostatic lever arm	hd = R+0.5*g1	=	1.0313	in
Gasket load lever arm	hg = (C-G)/2	=	0.75	in
Result. hydro. lever arm	ht = (R+g1+hg)/2.0	=	1.0938	in
Bolting up conditions:				
Gasket load lever arm	hg = (C-G)/2	=	0.75	in
Operating conditions:				
Hydrostatic moment	MD = HD*hd	=	206308	lbf*in
Gasket moment	MG = HG*hg	=	8571	lbf*in
Result. hydro. moment	MT = HT*ht	=	8512	lbf*in
Total operating moment	MOP = MD+MG+MT	=	223391	lbf*in
Total operating mom. MOPe=	HDe(hd-hg)+HTe(ht-hg)	=	17682	lbf*in
Bolting up conditions:				
Bolt up moment	MATM = W*hg	=	167275	lbf*in
Effective bolt moment	MB = MATM*SFO/SFA	=	167275	lbf*in
Total moment	MO = MOP or MB	=	223391	lbf*in
Bolt spacing correction	M = MO*Cf	=	223391	lbf*in
(TEMA 1999 RCB-11.23) Cf= 1				
Flange shape constants:				
K = A/B	= 1.0578	ho = SQ(B*G0)	= 4.7228	
TF = Fig.2-7.1	= 1.8919	h/ho = h/ho	= 0.1059	
Z = Fig.2-7.1	= 17.8171	F = Fig.2-7.2	= 0.9043	
Y = Fig.2-7.1	= 34.2758	V = Fig.2-7.3	= 0.4162	
U = Fig.2-7.1	= 37.6656	f = Fig.2-7.6	= 5.4874	
G1/G0 = G1/Go	= 2.6	e = F/ho	= 0.1915	
t =	= 2.6875 in			
D = U*ho*g0*g0/V	= 41.7374	Alpha = t*e+1.0	= 1.5146	
Beta = 1.333*t*e+1.0	= 1.6859	Gamma = Alpha/TF	= 0.8006	
Delta = t*t*t/D	= 0.4651	Lambda = Gamma+Delta	= 1.2656	
Stress calculations:	Allowable stress:			
Long. hub	SH = (f*M)/(Lambda*g1**2*B)	= 20556 psi	1.5*SFO =	28350 psi
Radial	SR = Beta*M/(Lambda*t**2*B)	= 577 psi	SFO =	20000 psi
Tangential	ST1 = M*Y/(t**2*B)-(Z*SR)	= 4568 psi	SFO =	20000 psi
(greater)	ST2 = (SH+SR)/2 or (SH+ST1)/2	= 12562 psi	SFO =	20000 psi

Loads:

Loose Flange Calculations

Operating conditions:

Hydrostatic end load

Hydrostatic end load

Gasket load

Result. hydrostatic force

Result. hydrostatic force

Bolting up conditions:

Gasket load

Operating conditions:

Hydrostatic lever arm

Gasket load lever arm

Result. hydro. lever arm

Bolting up conditions:

Gasket load lever arm

Operating conditions:

Hydrostatic moment

Gasket moment

Result. hydro. moment

Total operating moment

Total operating mom. MOPe=

Bolting up conditions:

Bolt up moment

Effective bolt moment

Total moment

Bolt spacing correction

(TEMA 1999 RCB-11.23) Cf= 1

Flange shape constants:

B =

K = A/B

Y = Fig.2-7.1

Flange calculated thickness:

Flange nominal thickness:

Stress calculations:

Tangential, ST = MO*Cf*Y/(B*tnom**2) = 18471 psi

HD = 0.785*B*B*PI = 204283 lbf

HDe= 0.785*B*B*PE = 61285 lbf

HG = WM1-H = 11428 lbf

HT = H-HD = 3556 lbf

HTe= He-HDe = 1067 lbf

HG = W = 223033 lbf

hd = (C-B)/2.0 = 1.0625 in

hg = (C-G)/2 = 0.75 in

ht = (hd+hg)/2.0 = 0.9063 in

hg = (C-G)/2 = 0.75 in

MD = HD*hd = 217051 lbf*in

MG = HG*hg = 8571 lbf*in

MT = HT*ht = 3222 lbf*in

MOP = MD+MG+MT = 228844 lbf*in

HDe(hd-hg)+HTe(ht-hg) = 19318 lbf*in

MATM = W*hg = 167275 lbf*in

MB = MATM*SFO/SFA = 167275 lbf*in

MO = MOP or MB = 228844 lbf*in

M = MO*Cf = 228844 lbf*in

t = (M*Y/SFO*B)**0.5 = 2.5827 in

tnom = 2.6875 in

Allowable stess:

SFO = 20000 psi

Component: Rear Head Flng At TS
ASME Section VIII Div.1 2004 A06, Appendix 2, 2-14 Flange Rigidity
--- Calculations ---
Operating moment, Mo = 223391 lbf*in Gasket seat. moment Ma = 167275 lbf*in
Factor V V = 0.416 Factor L L = 1.2656
Mod. elast.design T Ed = 28100000 psi Mod.elast.atm. temp Ea = 29300000 psi
Thickness g0 g0 = 0.3125 in Factor h0 h0 = 4.7228 in
Factor KI KI = 0.3 Factor KL KL = 0.2
Corrosion allowance ca = 0.0 in Factor K K = 1.0578
Thickness, T T = 2.6875 in
Rigidity index, J, loose flange type
Gasket seating J = 109.4 * Ma / (E * T ** 3 * Ln(K) * KL) = -
Operating J = 109.4 * Mo / (E * T ** 3 * Ln(K) * KL) = -
Rigidity index, J, integral flange type
Gasket seating J = 52.14 * Ma * V / (L * E * G0 ** 2 * ho * KI) = 0.7075
Operating J = 52.14 * Mo * V / (L * E * G0 ** 2 * ho * KI) = 0.9852

Component: Front Tubesheet Rules for the Design of Fixed Tubesheets
ASME VIII-1 2004 A06 UHX-13 Fig.UHX-13.1(a) Controlling Case: UHX-13.4(a) (2)

*** Tubesheet material: SA-240 S30400 Grd 304 Plate
Design temp. tubesheet T = 300 F TubSh metal tmp at rim T'= 105 F
TubSh allowable stress S = 15000 psi *TubSh th.ex.coe. alpha = 9.2
TubSh mod.elasticity E = 27000000 psi *TubSh th.ex.coe. alpha' = 8.62
Poisson's rat. tubSh v = 0.3 *(th.exp.coef * 10**6)

*** Shell material: SA-516 K02700 Grd 70 Plate
Design temp. shell Ts = 200 F Shell metal tmp/TubS T's = 94 F
Shell allowable str. Ss = 20000 psi *Shell th.ex.coe.alpha's = 6.48
Shell mod.elasticity Es = 28600000 psi Shell mean metal tmp Tsm = 94 F
Poisson's ratio shell vs = 0.3 *Shell th.ex.coe.alphasm = 6.48

*** Tube material: SA-249 S30400 Grd TP304 Wld. tube
Design temp. tubes Tt = 300 F Tubes mean metal tmp Ttm = 105 F
Tube allow.Str. at Tt St = 14941.2 psi Tube allow.Str. at T Stt = 14941.2 psi
Tube mod.elas. at Tt Et = 27000000 psi Tube mod.elas. at T Ett = 27000000 psi
Poisson's rat. tubes vt = 0.3 *Tube th.ex.coe.alphatm = 8.62
Tube yield stress Syt = 22400 psi *(th.exp.coef * 10**6)

*** Channel material: SA-240 S30400 Grd 304 Plate(G5)
Design temp. channel Tc = 300 F Channel metal tmp TS T'c = 105 F
Channel all. stress Sc = 18900 psi *Chan.th.ex.coe.alpha'c = 8.62
Channel mod.elast. Ec = 27000000 psi *(th.exp.coef * 10**6)
Poisson's rat.channel vc = 0.3

*** Adjacent shell matl: -
Adj Shell all. str. Ss,1 = - *Shell th.ex.coe.alpha's1= 0.0
*Shell th.ex.coe.alpha'sm1=0.0

Tubesheet thickness h = 1.5 in Actual tubesheet thk ha = 1.5 in
Shell side corr allow c = 0.0625 in Tube side cor.allow. c = 0.0 in
SS TubSh corr allow cs = 0.0 in TS TubSh corr allow ct = 0.0 in

	Corroded case	Uncorroded case
Shell diameter, Ds	71.125 in	71.0 in
Channel diameter, Dc	71.25 in	71.25 in
Shell thickness, ts	0.4375 in	0.5 in
Adjacent shell thk ts,1	0.0 in	0.0 in
Channel thickness, tc	0.375 in	0.375 in
Minimum TubSh thk, hmin	1.1614 in	1.2271 in
Thickness h used	1.5 in	1.5 in
Tubesheet OD	A = 72.0 in	Bolt circle diam. C = -

Shell gasket diam. Gs = -

Channel gasket diam. Gc = -

Gasket reaction diam. G = -

Gasket reaction diam. G1 = -

Number of tubes Nt = 1785

Flange load W = 0 lbf

Pass partition groove hg = 0.0 in

Eff.tube side groove h'g = 0.0 in

Tube outside diam. dt = 1.25 in

Tube thickness tt = 0.049 in

Tube pitch p = 1.5625 in

Center-to-center dis UL = 0.0 in

Tube projection tpr = 0.125 in

Tube corrosion allow. c = -

Tube length L L = 260.75 in

Tube length Lt Lt = 263.75 in

Tube expanded depth ltx = 1.375 in

Tube exp.depth ratio rho = 0.917

Tube buckling factor k = 0.8

Unsupported tube span l = 59.875 in

Outermost tube rad. ro = 34.5625 in

Unsupp.length lt=k*1 lt = 47.9 in

Shell radius as = 35.5625 in

Channel radius ac = 35.625 in

Shell design pressure Ps = 165 psi

Tube design pressure Pt = 0 psi

Exp.joint spring rate kj = -

EJ diameter Dj = -

Component: Front Tubesheet

Fig.UHX-13.1(a) Controlling Case: UHX-13.4(a) (2)

UHX-13.5.1 Step 1. Determine Do, Mu, Mu* and h'g from UHX-11.5.1.

Do = 2 * ro + dt Do = 70.375 in

mu = (p - dt) / p mu = 0.2

d* = MAX(dt-2*tt*(Ett/E)*(Stt/S)*Rho), (dt-2*tt)) d* = 1.1605 in

Pass lane area limit 4*Do*p = 439.84 in2

Actual pass lane area, AL AL = 0 in2

Effective pitch = p/SQRT(1-(4*MIN[AL,4*Do*p]/Pi*Do**2)) p* = 1.5625 in

mu* = (p* - d*) / p* mu* = 0.2573

h'g = MAX[(hg-ct), (0)] h'g = 0.0 in

Calculate ao, rhos, rhoc, xs and xt

ao = radius of the perforated region = Do / 2 ao = 35.1875 in

rhos = as/ao rhos = 1.0107

rhoc = ac/ao rhoc = 1.0124

xs = 1 - Nt(dt/(2*ao))**2 xs = 0.4369

xt = 1 - Nt((dt-2*tt)/(2*ao))**2 xt = 0.5217

UHX-13.5.2 Step 2. Calculate the shell axial stiffness Ks, tube axial

stiffness Kt, and stiffness factors Ks,t and J
Shell axial stiffness, $K_s = \frac{\pi t_s (D_s + t_s) E_s}{L}$ $K_s = 10788353 \text{ lbf/in}$
 $K_s^* = \frac{\pi (D_s + t_s)}{(L - 2t_l) / (E_s t_s) + (2t_l / (E_s t_s, 1))}$ $K_s^* = -$
Tube axial stiffness, $K_t = \frac{\pi t_t (d_t - t_t) E_t}{L}$ $K_t = 19144 \text{ lbf/in}$
Factor $K_{s,t} = K_s / (N_t K_t)$ or $K_{s,t} = K_s / (N_t K_t)$ $K_{s,t} = 0.3157$
 $J = 1 / (1 + (K_s / K_t))$ $J = 1.0$
Calculate shell coefficients betas, ks, lambdas and deltas
 $\text{betas} = (12 * (1 - \nu_s^2))^{0.25} / ((D_s + t_s) t_s)^{0.5}$ $\text{betas} = 0.3249$
 $\text{ks} = \text{betas} * (E_s t_s^3) / (6 * (1 - \nu_s^2))$ $\text{ks} = 142505$
 $\text{lambdas} = (6 * D_s / h^3) * \text{ks} * (1 + h * \text{betas} + (h^2 * \text{betas}^2) / 2)$ $\text{lambdas} = 28939662$
 $\text{deltas} = (D_s^2 / (4 * E_s t_s)) * (1 - \nu_s / 2)$ $\text{deltas} = 0.0000859$
Calculate channel coefficients betac, kc, lambdac and deltac
 $\text{betac} = (12 * (1 - \nu_c^2))^{0.25} / ((D_c + t_c) t_c)^{0.5}$ $\text{betac} = 0.3508$
 $\text{kc} = \text{betac} * (E_c t_c^3) / (6 * (1 - \nu_c^2))$ $\text{kc} = 91469$
 $\text{lambdac} = (6 * D_c / h^3) * \text{kc} * (1 + h * \text{betac} + (h^2 * \text{betac}^2) / 2)$ $\text{lambdac} = 19285510$
 $\text{deltac} = (D_c^2 / (4 * E_c t_c)) * (1 - \nu_c / 2)$ $\text{deltac} = 0.0001065$
NOTE: If the effect of plasticity used, Es or Ec will be Es* or Ec*

Component: Front Tubesheet

Fig.UHX-13.1(a) Controlling Case: UHX-13.4(a) (2)
UHX-13.5.3 Step 3. Calculate h/p. If rho changes, recalculate d* and mu*
from UHX-11.5.1. Determine E*/E and v* relative to h/p from UHX-11.5.2
Layout: Triangular Tubesheet thickness $h = 1.5 \text{ in}$
From fig. UHX-11.2 or UHX-11.3 - $E^*/E = 0.2613$ $\nu^* = 0.3418$
 $h/p = 0.96$ $\mu^* = 0.2573$
Effective Tubesheet Mod.Elasticity $E^* = 7055350 \text{ psi}$
Parameter $X_a = (24 * (1 - \nu^*)^2) * N_t * (E_t t_t^3 (d_t - t_t) * a_o^2) / ((E^*) * L * h^3)^{0.25}$ $X_a = 10.464$

UHX-13.5.4 Step 4. Calculate diameter ratio K and coefficient F.

$K = A / D_o$ $K = 1.023$
 $F = ((1 - \nu^*) / E^*) * (\text{lambdas} + \text{lambdac} + E * \ln(K))$ $F = 4.556$

Parameters Zd, Zv and Zm from Table UHX-13.1

$\text{Psi1}(Xa) = \text{bei}(Xa) + (1 - v^*) / Xa * \text{ber}'(Xa)$	$\text{Psi1}(Xa) = 133.5542$
$\text{Psi2}(Xa) = \text{ber}(Xa) - (1 - v^*) / Xa * \text{bei}'(Xa)$	$\text{Psi2}(Xa) = 141.2525$
$Za = \text{bei}'(Xa) * \text{Psi2}(Xa) - \text{ber}'(Xa) * \text{Psi1}(Xa)$	$Za = 26823.4707$
$Zd = (\text{ber}(Xa) * \text{Psi2}(Xa) + \text{bei}(Xa) * \text{Psi1}(Xa)) / (Xa^{**3} * Za)$	$Zd = 0.0013$
$Zv = (\text{ber}'(Xa) * \text{Psi2}(Xa) + \text{bei}'(Xa) * \text{Psi1}(Xa)) / (Xa^{**2} * Za)$	$Zv = 0.0093$
$Zm = (\text{ber}'(Xa)^{**2} + \text{bei}'(Xa)^{**2}) / (Xa * Za)$	$Zm = 0.1376$

Calculate Q1, Qz1, Qz2 and U

$\text{Phi} = (1 + v^*) * F$	$\text{Phi} = 6.1138$
$Q1 = (\text{rhos} - 1 - \text{Phi} * Zv) / (1 + \text{Phi} * Zm)$	$Q1 = -0.025$
$Qz1 = ((Zd + Q1 * Zv) * Xa^{**4}) / 2$	$Qz1 = 6.3132$
$Qz2 = ((Zv + Q1 * Zm) * Xa^{**4}) / 2$	$Qz2 = 34.9301$
$U = ((Zv + (\text{rhos} - 1) * Zm) * Xa^{**4}) / (1 + \text{Phi} * Zm)$	$U = 69.8602$

UHX-13.5.5 Step 5.

UHX-13.5.5(a) Calculate gamma

$\text{gamma} = (\text{alpmatm} * (\text{Ttm} - \text{Tamb}) - \text{alphasm} * (\text{Tsm} - \text{Tamb})) * L$ (=0 for load cases 1, 2, 3)	$\text{gamma} = 0.0 \text{ in}$
---	---------------------------------

UHX-13.5.5(b) Calculate omegas, omegas*, omegac, omegac*

$\text{omegas} = \text{rhos} * \text{ks} * \text{betas} * \text{deltas} * (1 + h * \text{betas})$	$\text{omegas} = 5.9789$
$\text{omegas}^* = \text{ao}^{**2} * ((\text{rhos}^{**2} - 1) * (\text{rhos} - 1)) / 4 - \text{omegas}$	$\text{omegas}^* = -5.9082$
$\text{omegac} = \text{rhoc} * \text{kc} * \text{betac} * \text{deltac} * (1 + h * \text{betac})$	$\text{omegac} = 5.2817$
$\text{omegac}^* = \text{ao}^{**2} * ((\text{rhoc}^{**2} + 1) * (\text{rhoc} - 1)) / 4 -$ $(\text{rhos} - 1) / 2 - \text{omegac}$	$\text{omegac}^* = -4.0858$

UHX-13.5.5(c) Calculate gammab

$\text{gammab} = 0$	$\text{gammab} = 0.0$
---------------------	-----------------------

Component: Front Tubesheet

Fig.UHX-13.1(a) Controlling Case: UHX-13.4(a)(2)
UHX-13.5.6 Step 6. For each loading case calculate Ps', Pt', Pgamma, Pw, Prim, and effective pressure Pe.

$$Ps' = (xs+2*(1-xs)*vt+(2/Kst)*(Ds/Do)**2*vs-(Rhos**2-1)/(J*Kst)-((1-J)/(2*J*Kst))* (DJ**2-(2*as)**2)/Do**2) * Ps$$

$$Ps' = 436.93 \text{ psi}$$

$$Pt' = (xt+2*(1-xt)*vt+1/(J*Kst))*Pt$$

$$Pt' = 0 \text{ psi}$$

$$Pgamma = (Nt*Kt/(Pi*ao**2))*gamma$$

$$Pgamma = 0 \text{ psi}$$

$$PW = -(U/ao**2)*(gammab/(2*Pi))*W$$

$$PW = 0 \text{ psi}$$

$$Prim = -(U/ao**2)*((omegas)*(Ps)-(omegac)*(Pt))$$

$$Prim = 55 \text{ psi}$$

$$Pe = (J*Kst/(1+J*Kst*(Qz1+(rhos-1)Qz2)) * (Ps'-Pt'+Pgamma+PW+Prim)$$

$$Pe = 49.93 \text{ psi}$$

UHX-13.5.7 Step 7. For each loading case calculate Q2 and Q3.

$$Q2 = ((omegas)*Ps-(omegac)*Pt)-((omegas*(Ps*)-omegac*(Pc*))+(gammab/(2*Pi))*W)/(1+Phi*Zm)$$

$$Q2 = -529.3972$$

$$Q3 = Q1 + 2*Q2 / Pe*ao**2$$

$$Q3 = -0.0421$$

Using Xa and Q3, determine coefficient Fm for each loading case from either Table UHX-13.1 or Figs. UHX-13.3.-1 and UHX-13.3.-2.

$$\text{Controlling } x = 10.4638 \text{ in}$$

Calculate functions Psi1 and Psi2 relative to x

$$Psi1(x) = bei(x) + (1-v*)/x * ber'(x)$$

$$Psi1(x) = 133.5543$$

$$Psi2(x) = ber(x) - (1-v*)/x * bei'(x)$$

$$Psi2(x) = 141.2525$$

Calculate functions Qm, Qv and Fm relative to x

$$Qm(x) = (bei'(Xa)*Psi2(x)-ber'(Xa)*Psi1(x))/Za$$

$$Qm(x) = 1.0$$

$$Qv(x) = (Psi1(Xa)*Psi2(x)-Psi2(Xa)*Psi1(x))/(Xa*Za)$$

$$Qv(x) = -0.0$$

Controlling Fm relative to x

$$F_m(x) = (Q_v(x) + Q_3 * Q_m(x)) / 2$$

$$F_m = \text{MAX}|F_m(x)|$$

For each loading case, calculate the bending stress in the tubesheet

$$\sigma = (1.5 * F_m / \mu) * (2 * a_o / (h - h'g))^{**2} * P_e$$

$$F_m(x) = -0.021$$

$$F_m = 0.021$$

$$\sigma = 13488 \text{ psi}$$

$$|\sigma| \leq 1.5 * S$$

$$13488 \text{ psi} \leq 22500 \text{ psi}$$

UHX-13.5.8 Step 8. For each loading case, calculate the average shear stress in the tubesheet at the outer edge of the perforated region

Area enclosed by perimeter

$$A_L = 3573.2 \text{ in}^2$$

Perimeter of the tube layout

$$C_L = 307.476 \text{ in}$$

Shear diameter $D_L = 4 * A_L / C_L$ or D_o

$$D_o = 70.375 \text{ in}$$

Ligament efficiency, μ

$$\mu = (p - d_t) / p = 0.2$$

Shear stress, $\tau = (1 / (4 * \mu)) * (D_o / h) * P_e$

$$\tau = 2928 \text{ psi}$$

$$|\tau| \leq 0.8 * S$$

$$2928 \text{ psi} \leq 12000 \text{ psi}$$

UHX-13.5.9 Step 9. Perform this step for each loading case.

UHX-13.5.9(a) Calculate coefficient F_q and the axial tube stress $\sigma_{t,a}$ in the outermost tube row

$$\text{Factor } F_q = (Z_d + Q_3 * Z_v) * X_a^{**4/2} = 5.3621$$

$$\sigma_{t,a} = ((P_s * x_s - P_{t,t}) - P_e * F_q) / (x_t - x_s) = -2306 \text{ psi}$$

$$\sigma_{t,a} \leq S_t$$

$$-2306 \text{ psi} \leq 14941 \text{ psi}$$

UHX-13.5.9(b) Check the tubes for buckling.

$$C_t = \text{SQRT}(2 * \pi^{**2} * (E_t / S_y t))$$

$$C_t = 154.2491$$

$$r_t = \text{SQRT}(d_t^{**2} + (d_t - 2 * t_t)^{**2}) / 4$$

$$r_t = 0.425 \text{ in}$$

$$F_t = 1 t / r_t$$

$$F_t = 112.7136$$

$$F_s = \text{MAX}((1.25, (3.25 - 0.5 * F_q), 2))$$

$$F_s = 1.25$$

$$\text{For } C_t \leq F_t \quad S_{t,b} = \text{MIN}[(1 / F_s) * (\pi^{**2} * E_t / (F_t^{**2}), S_t]$$

$$S_{t,b} = -$$

$$\text{For } C_t > F_t \quad S_{t,b} = \text{MIN}[(S_y t / F_s) * (1 - (F_t / 2 * C_t)), S_t]$$

$$S_{t,b} = -11373 \text{ psi}$$

$$\sigma_{t,a} \leq S_{t,b}$$

$$-2306 \text{ psi} \leq -11373 \text{ psi}$$

UHX-Tube stresses at the interior of the bundle.

Maximum tube compressive stress at the interior of the bundle

$$F_t(x) = Zdx + Q3 * Zwx * (Xa^{**4} / 2)$$

$$F_i = f_t(x)$$

$$\text{sigmati} = ((Ps * xs - Pt * xt) - Pe * F_i) / (xt - xs)$$

$$F_i = 5.3621$$

$$\text{sigmati} = -2306 \text{ psi}$$

$$\text{sigmati} \leq S_{tb}$$

$$-2306 \text{ psi} \leq -11373 \text{ psi}$$

UHX-13.5.10 Step 10. For each loading case, calculate the stresses in the shell and /or channel integral with the tubesheet.

Calculate the axial membrane stress sigmasm , axial bending stress sigmasb and total axial stress sigmas in the shell at its junction to the tubesheet

$$\text{sigmasm} = a_o^{**2} / t_s * (2 * a_s + t_s) * [Pe + (r_{hos}^{**2} - 1) * (Ps - Pt)] + a_s^{**2} / t_s * (2 * a_s + t_s) * Pt$$

$$\text{sigmasm} = 2114 \text{ psi}$$

$$sb1 = (6 / t_s^{**2}) * k_s$$

$$sb2 = \beta_s * (\Delta t_s * Ps - v_s * (a_s / E_s) * \text{sigmasm})$$

$$sb3 = 6 * (1 - \nu_s^{**2}) / (E_s) * (a_o^{**3} / h^{**3}) * (1 + (h * \beta_s / 2))$$

$$sb4 = Pe * (Z_v + Z_m * Q1) + (2 / a_o^{**2}) * Z_m * Q2$$

$$\text{sigmasb} = sb1 * (sb2 + sb3 * sb4)$$

$$\text{sigmasb} = 28760 \text{ psi}$$

$$\text{sigmas} = |\text{sigmasm}| + |\text{sigmasb}|$$

$$\text{sigmas} = 30875 \text{ psi}$$

$$\text{sigmas} \leq 2 * S_y$$

$$30875 \text{ psi} \leq 69600 \text{ psi}$$

Calculate the axial membrane stress σ_{macm} , axial bending stress σ_{macb} and total axial stress σ_{mac} in the channel at its junction to the tubesheet

$$\sigma_{macm} = \frac{ac^2}{tc(2ac+tc)}Pt \qquad \sigma_{macm} = 0 \text{ psi}$$
$$\sigma_{macb} = \frac{6}{tc^2}kc[\beta_{tac}\delta_{tac}Pt - 6(1-\nu)^2]/(E) * (ao^3/h^3)*(1+h\beta_{tac}/2)* [Pe(Zv+ZmQ1)+2/ao^2ZmQ2]]$$
$$\sigma_{macb} = -8280 \text{ psi}$$
$$\sigma_{mac} = |\sigma_{macm}| + |\sigma_{macb}| \qquad \sigma_{mac} = 8280 \text{ psi}$$
$$\sigma_{mac} \leq 1.5S$$
$$8280 \text{ psi} \leq 30000 \text{ psi}$$

ASME VIII-1 2004 A06 UHX-13 - Rules for the Design of Fixed Tubesheets

ASME Fig.UHX-13.1(a) All Load Cases

Controlling case:

Load case:	1	2	3	4	5	6	7
Tube-side press, Pt	65	0	65	0	65	0	65
Shell-side press, Ps	0	165	165	0	0	165	165
Axial diff.Th.Exp	0.0	0.0	0.0	0.0381	0.0381	0.0381	0.0381
TubSh Bending stress	-5942	13488	7546	7128	2397	20340	13990
Max TubSh Bending st	22500	22500	22500	59505	59505	59505	59505
Min TubSh thk	0.7708	1.1614	0.8687	0.5192	0.301	0.877	0.7273
TubSh Shear stress	-1628	2928	1301	2046	415	4977	3345
Max TubSh Shear str	12000	12000	12000	15868	15868	15868	15868
Min TubSh thk	0.2034	0.366	0.1626	0.1934	0.0392	0.4705	0.3162
Tubesheet thickness	1.5	1.5	1.5	1.5	1.5	1.5	1.5

Elastic-Plastic analysis results:

Load case:	1	2	3
TubSh Bending stress	-5942	13488	7546
Max TubSh Bending st	22500	22500	22500

Component: Front Tubesheet

ASME Fig.UHX-13.1(a)	All Load Cases						
Controlling case:							
Load case:	1	2	3	4	5	6	7
Tubes stress	1513	-2306	-793	-2624	-1086	-4964	-3426
Max Tubes stress	14941	14941	14941	39671	39671	39671	39671
Max buckling stress	-	-11373	-11373	-11373	-11373	-11373	-11373
Total shell stress	9254	30875	24567	11556	5270	42324	36038
Max shell stress	30000	30000	30000	69600	69600	69600	69600
Max shell stress EP	69600	69600	69600				
Total channel stress	18748	8280	10468	9893	8962	18249	5535
Max channel stress	28350	28350	28350	60000	60000	60000	60000
Max channel str. EP	56700	56700	56700				
EP factor - Facts(*)	1.0	1.0694	1.0	(*) <= 1 used in calculations			
EP factor - Factc(*)	1.0	1.0	1.0				
Tube compressive stresses at the interior of the bundle							
Load case:	1	2	3	4	5	6	7
Tubes stress	-527	-2306	-793	-2624	-1086	-4964	-3426
Max buckling stress	-11373	-11373	-11373	-11373	-11373	-11373	-11373

ASME VIII-1 2004 A06 UHX-13 - Rules for the Design of Fixed Tubesheets

ASME UHX-13.7 Design Formulas and Calculation Procedure for Effect of Plasticity at Tubesheet/Channel or Shell Joint

The elastic-plastic procedure is only used for pressure loading cases (cases 1, 2 and 3) when $\sigma_{s,s} \leq S_{ps,s}$ and/or $\sigma_{c,c} \leq S_{ps,c}$ UG-23(e)

Shell yield strength $S_{y,s} = 34800$ psi Channel yield str. $S_{y,c} = 22400$ psi
Shell allowable stress $S_s = 20000$ psi Channel all. stress $S_c = 18900$ psi
Shell allow. str. $S_{ps,s} = 69600$ psi Channel all. str. $S_{ps,c} = 56700$ psi
 $S_s^* = \min((S_{y,s})(S_{ps,s}/2)) = 34800$ psi $S_c^* = \min((S_{y,c})(S_{ps,c}/2)) = 22400$ psi
 $facts = \min[1.4 - 0.4|\sigma_{s,b}|/S_s^*, 1] = \min[1.0694, 1]$ facts = 1.0
 $factc = \min[1.4 - 0.4|\sigma_{c,b}|/S_c^*, 1] = \min[1.0, 1]$ factc = 1.0

Reduced Modulus of Elasticity

$E_s = E_s(facts)$ $E_s = 28600000$ psi
 $E_c = E_c(factc)$ $E_c = 27000000$ psi

ASME VIII-1 2004 A06 UHX-13 - Fixed Tubesheets - All Cases

Load case	Ps psi	Pt psi	Gamma in	Ps* psi	Pc* psi		
- 1 -	0	65	0	0	0		
- 2 -	165	0	0	0	0		
- 3 -	165	65	0	0	0		
- 4 -	0	0	0.0381	0	0		
- 5 -	0	65	0.0381	0	0		
- 6 -	165	0	0.0381	0	0		
- 7 -	165	65	0.0381	0	0		

Load case	P's psi	P't psi	Pgamma psi	Pomega psi	Pw psi	Prim psi	Pe psi
- 1 -	0	258.4	0	0	0	-15	-27.8
- 2 -	436.9	0	0	0	0	55	49.9
- 3 -	436.9	258.4	0	0	0	40	22.2
- 4 -	0	0	348.6	0	0	0	34.9
- 5 -	0	262.7	348.6	0	0	-15.3	7.1
- 6 -	443.4	0	348.6	0	0	56	84.9
- 7 -	443.4	262.7	348.6	0	0	40.7	57

Load case	Q2	Q3	Fm	Sigma	Sigma All	Tau	Tau All	
				psi	psi	psi	psi	
- 1 -	144.2	-0.0334	0.0167	-5942	22500	-1628	12000	
- 2 -	-529.4	-0.0421	0.021	13488	22500	2928	12000	
- 3 -	-385.2	-0.053	0.0265	7546	22500	1301	12000	
- 4 -	0	-0.0252	0.015	7128	59505	2046	15868	
- 5 -	141.6	0.0072	0.0248	2397	59505	415	15868	
- 6 -	-519.9	-0.0351	0.0175	20340	59505	4977	15868	
- 7 -	-378.2	-0.0359	0.0179	13990	59505	3345	15868	
ASME VIII-1 2004 A06 UHX-13 - Fixed Tubesheets - All Cases								
Load case	Fq	Fs	Sigto	Sigto All	Stb			
			psi	psi	psi			
- 1 -	5.847	1.25	1513	14941	-11373			
- 2 -	5.3621	1.25	-2306	14941	-11373			
- 3 -	4.7552	1.25	-793	14941	-11373			
- 4 -	6.3804	1.25	-2624	39671	-11373			
- 5 -	8.2389	1.25	-1086	39671	-11373			
- 6 -	5.8121	1.25	-4964	39671	-11373			
- 7 -	5.7652	1.25	-3426	39671	-11373			
Load case	Sigsm	Sigsb	Sigs	Sigsall	Sigcm	Sigcb	Sigc	Sigcall
	psi	psi	psi	psi	psi	psi	psi	psi
- 1 -	1473	-7781	9254	30000	3071	15677	18748	28350
- 2 -	2114	28760	30875	69600	0	-8280	8280	28350
- 3 -	3587	20979	24567	30000	3071	7396	10468	28350
- 4 -	1380	10176	11556	69600	0	-9893	9893	60000
- 5 -	2850	2420	5270	69600	3071	5891	8962	60000
- 6 -	3496	38828	42324	69600	0	-18249	18249	60000
- 7 -	4966	31072	36038	69600	3071	-2464	5535	60000

Elastic-Pl.	facts	factc	Es,ep	Ec,ep	ks,ep	kc,ep	lambs,ep
Load case			psi	psi			
- 1 -	1	1	28600000	27000000	142505	91469	28939662
- 2 -	1.07	1	28600000	27000000	142505	91469	28939662
- 3 -	1	1	28600000	27000000	142505	91469	28939662
Elastic-Pl.	lambc,ep	F,ep	Phi,ep	Q1,ep	Qz1,ep	Qz2,ep	U,ep
Load case							
- 1 -	19285510	4.5564	6.1138	-0.025	6.3132	34.9301	69.8602
- 2 -	19285510	4.5564	6.1138	-0.025	6.3132	34.9301	69.8602
- 3 -	19285510	4.5564	6.1138	-0.025	6.3132	34.9301	69.8602
Elastic-Pl.	Pw,ep	Prim,ep	Pe,ep	Q2,ep	Q3,ep	Fm,ep	sig,ep
Load case			psi	psi	psi		psi
- 1 -	0	-15	-27.8	144	-0.0334	0.0167	-5942
- 2 -	0	55	49.9	-529	-0.0421	0.021	13488
- 3 -	0	40	22.2	-385	-0.053	0.0265	7546
Type of tube-to-TS joint: expanded & strength welded							
Load case:		1	2	3	4	5	6
Tube-to-TS Load, lbf		280	426	147	485	201	918
Allowable no-test		2210	2210	2210	4420	4420	4420
Allowable test		2762	2762	2762	5525	5525	5525
Allowable Loads per ASME Section VIII Div. 1 2004 A06 Appendix A							
				No Test		Test	
Type	Joint description			fr	Lmax	fr	Lmax
a	Strength welded only			0.8	2210	1	2762
b	Seal welded only			0.55	1519	0.7	1934
e	Strength welded and expanded			0.8	2210	1	2762
f	Seal welded and exp.with 2 grooves			0.75	2072	0.95	2624
g	Seal welded and exp.with 1 groove			0.65	1796	0.85	2348
h	Seal welded and exp.with no grooves			0.5	1381	0.7	1934
i	Expanded with 2 grooves			0.7	1934	0.9	2486
j	Expanded with 1 groove			0.65	1796	0.8	2210
k	Expanded with no grooves			0.5	1381	0.6	1657
* = Load calculated exceeds code allowable for this joint type.							
For joints types a,b,b-1,c,d,e :				Lmax = At*Sa*fr			
For joints types f,g,h,				Lmax = At*Sa*fe*fr*fy			
For joints types i,j,k				Lmax = At*Sa*fe*fr*fy,ft			
Cross-sectional area		At = 0.1849 in2		Tube allowable stress		Sa = 14941 psi	
Factor fe (1/do or 1)		fe = 1		Ratio fy		fy = 1	
ft = (Po+Pt)/Po		ft = 1		Min Yield Str		SigmaM = 30000 psi	
(ft = 1 if max exceeded)							
Tube OD		do = 1.25 in		Tube thickness		tt = 0.049 in	
Tubes yield str(min)		st = 30000 psi		TubSh mean metal tmp		T = 105 F	
Tubes Mod.Elasticity		EtT = 28111538 psi		TubSh Mod.Elast.		EsT = 28111538 psi	
Tubes Coef.Th.Exp.		at = 0.0000086		TubSh Coef.Th.Exp.		as = 0.0000086	
Po = (4*(do*t-t**2)*st)/do**2						Po = 4520 psi	
Pt = ((T-Tamb)*(at-as)*(EtT*EsT)/(EtT+EsT)						Pt = -	
For joint types i, j, k:						Po + Pt <= 0.58*SigmaM	
						4520 psi <= 17400 psi	

39 of 102

Shell gasket diam. Gs = -

Channel gasket diam. Gc = 72.75 in

Gasket reaction diam. G = 72.75 in

Gasket reaction diam. G1 = 72.75 in

Number of tubes Nt = 1785

Flange load W = 223033 lbf

Pass partition groove hg = 0.0 in

Eff.tube side groove h'g = 0.0 in

Tube outside diam. dt = 1.25 in

Tube thickness tt = 0.049 in

Tube pitch p = 1.5625 in

Center-to-center dis UL = 0.0 in

Tube projection tpr = 0.125 in

Tube corrosion allow. c = -

Tube length L L = 260.75 in

Tube length Lt Lt = 263.75 in

Tube expanded depth ltx = 1.375 in

Tube exp.depth ratio rho = 0.917

Tube buckling factor k = 0.8

Unsupported tube span l = 59.875 in

Outermost tube rad. ro = 34.5625 in

Unsupp.length lt=k*1 lt = 47.9 in

Shell radius as = 35.5625 in

Channel radius ac = 36.375 in

Shell design pressure Ps = 165 psi

Tube design pressure Pt = 65 psi

Exp.joint spring rate kj = -

EJ diameter Dj = -

Component: Rear Tubesheet

Fig.UHX-13.1(b) Controlling Case: UHX-13.4(a)(3)

UHX-13.5.1 Step 1. Determine Do, Mu, Mu* and h'g from UHX-11.5.1.

Do = 2 * ro + dt

Do = 70.375 in

mu = (p - dt) / p

mu = 0.2

d* = MAX(dt-2*tt*(Ett/E)*(Stt/S)*Rho), (dt-2*tt))

d* = 1.1605 in

Pass lane area limit

4*Do*p = 439.84 in2

Actual pass lane area, AL

AL = 0 in2

Effective pitch = p/SQRT(1-(4*MIN[AL, 4*Do*p]/Pi*Do**2))

p* = 1.5625 in

mu* = (p* - d*) / p*

mu* = 0.2573

h'g = MAX[(hg-ct), (0)]

h'g = 0.0 in

Calculate ao, rhos, rhoc, xs and xt

ao = radius of the perforated region = Do / 2

ao = 35.1875 in

rhos = as/ao

rhos = 1.0107

rhoc = ac/ao

rhoc = 1.0337

xs = 1 - Nt(dt/(2*ao))**2

xs = 0.4369

xt = 1 - Nt((dt-2*tt)/(2*ao))**2

xt = 0.5217

UHX-13.5.2 Step 2. Calculate the shell axial stiffness K_s , tube axial

stiffness K_t , and stiffness factors $K_{s,t}$ and J
Shell axial stiffness, $K_s = \frac{\pi t_s (D_s + t_s) E_s}{L}$ $K_s = 10788353 \text{ lbf/in}$
 $K_s^* = \frac{\pi (D_s + t_s)}{(L - 2t_l) / (E_s t_s) + (2t_l / (E_s t_s, 1))}$ $K_s^* = -$
Tube axial stiffness, $K_t = \frac{\pi t_t (d_t - t_t) E_t}{L}$ $K_t = 19144 \text{ lbf/in}$
Factor $K_{s,t} = K_s / (N_t K_t)$ or $K_{s,t} = K_s^* / (N_t K_t)$ $K_{s,t} = 0.3157$
 $J = 1 / (1 + (K_s / K_t))$ $J = 1.0$

Calculate shell coefficients β_s , k_s , λ_{sd} and δ_s
 $\beta_s = (12(1 - \nu_s^2))^{0.25} / ((D_s + t_s) t_s)^{0.5}$ $\beta_s = 0.3249$
 $k_s = \beta_s (E_s t_s^3) / (6(1 - \nu_s^2))$ $k_s = 142505$
 $\lambda_{sd} = (6 D_s / h^3) k_s (1 + h \beta_s + (h^2 \beta_s^2) / 2)$ $\lambda_{sd} = 28939662$
 $\delta_s = (D_s^2 / (4 E_s t_s)) (1 - \nu_s / 2)$ $\delta_s = 0.0000859$
Calculate channel coefficients β_c , k_c , λ_{cd} and δ_c
 $\beta_c = (12(1 - \nu_c^2))^{0.25} / ((D_c + t_c) t_c)^{0.5}$ $\beta_c = 0$
 $k_c = \beta_c (E_c t_c^3) / (6(1 - \nu_c^2))$ $k_c = 0$
 $\lambda_{cd} = (6 D_c / h^3) k_c (1 + h \beta_c + (h^2 \beta_c^2) / 2)$ $\lambda_{cd} = 0$
 $\delta_c = (D_c^2 / (4 E_c t_c)) (1 - \nu_c / 2)$ $\delta_c = 0$
NOTE: If the effect of plasticity used, E_s or E_c will be E_s^* or E_c^*

Component: Rear Tubesheet

Fig. UHX-13.1(b) Controlling Case: UHX-13.4(a)(3)

UHX-13.5.3 Step 3. Calculate h/p . If ρ changes, recalculate d^* and μ^*
from UHX-11.5.1. Determine E^*/E and ν^* relative to h/p from UHX-11.5.2
Layout: Triangular Tubesheet thickness $h = 1.5 \text{ in}$
From fig. UHX-11.2 or UHX-11.3 - $E^*/E = 0.2613$ $\nu^* = 0.3418$
 $h/p = 0.96$ $\mu^* = 0.2573$

Effective Tubesheet Mod. Elasticity $E^* = 7055350 \text{ psi}$

Parameter $X_a = (24(1 - \nu^*(^2)) N_t (E_t t_t (d_t - t_t) a_o^2) / ((E^*) L h^3))^{0.25}$

$X_a = 10.464$

UHX-13.5.4 Step 4. Calculate diameter ratio K and coefficient F .

$K = A / D_o$ $K = 1.073$

$F = ((1 - \nu^*) / E^*) (\lambda_{sd} + \lambda_{cd} + E^* \ln(K))$ $F = 2.877$

Parameters Zd, Zv and Zm from Table UHX-13.1

```
Psi1(Xa)=bei(Xa)+(1-v*)/Xa*ber'(Xa)      Psi1(Xa) = 133.5542
Psi2(Xa)=ber(Xa)-(1-v*)/Xa*bei'(Xa)      Psi2(Xa) = 141.2525
Za = bei'(Xa)*Psi2(Xa)-ber'(Xa)*Psi1(Xa)  Za = 26823.4707
Zd = (ber(Xa)*Psi2(Xa)+ bei(Xa)*Psi1(Xa))/(Xa**3*Za)  Zd = 0.0013
Zv = (ber'(Xa)*Psi2(Xa)+ bei'(Xa)*Psi1(Xa))/(Xa**2*Za)  Zv = 0.0093
Zm = (ber'(Xa)**2+bei'(Xa)**2)/(Xa*Za)      Zm = 0.1376
Calculate Q1, Qz1, Qz2 and U
Phi = (1+v*) * F                          Phi = 3.8601
Q1 = (rhos-1-Phi*Zv)/(1+Phi*Zm)           Q1 = -0.0164
Qz1 = ((Zd+Q1*Zv)*Xa**4)/2               Qz1 = 6.7894
Qz2 = ((Zv+Q1*Zm)*Xa**4)/2               Qz2 = 42.0055
U = ((Zv+(rhos-1)*Zm)*Xa**4)/(1+Phi*Zm)   U = 84.011
```

UHX-13.5.5 Step 5.

UHX-13.5.5(a) Calculate gamma

```
gamma = (alphatm*(Ttm-Tamb)-alphasm*(Tsm-Tamb))*L  gamma = 0.0 in
(=0 for load cases 1, 2, 3)
```

UHX-13.5.5(b) Calculate omegas, omegas*, omegac, omegac*

```
omegas = rhos*ks*betas*deltas*(1+h*betas)         omegas = 5.9789
omegas* = ao**2*((rhos**2-1)*(rhos-1))/4-omegas    omegas* = -5.9082
omegac = rhoc*kc*betac*deltac*(1+h*betac)         omegac = 0.0
omegac* = ao**2*((rhoc**2+1)*(rhoc-1))/4-          omegac* = 15.0119
(rhos-1)/2-omegac
```

UHX-13.5.5(c) Calculate gammab

```
gammab = (Gc-C)/Do                             gammab = -0.0213
```

Component: Rear Tubesheet

Fig.UHX-13.1(b) Controlling Case: UHX-13.4(a)(3)
UHX-13.5.6 Step 6. For each loading case calculate Ps', Pt', Pgamma, Pw, Prim, and effective pressure Pe.

$$Ps' = (xs+2*(1-xs)*vt+(2/Kst)*(Ds/Do)**2*vs-(Rhos**2-1)/(J*Kst)-((1-J)/(2*J*Kst))* (DJ**2-(2*as)**2)/Do**2) * Ps$$

$$Pt' = (xt+2*(1-xt)*vt+1/(J*Kst))*Pt$$

$$Pgamma = (Nt*Kt/(Pi*ao**2))*gamma$$

$$PW = -(U/ao**2)*(gammab/(2*Pi))*W$$

$$Prim = -(U/ao**2)*((omegas*(Ps)-(omegac)*(Pt))$$

$$Pe = (J*Kst/(1+J*Kst(Qz1+(rhos-1)Qz2)) * (Ps'-Pt'+Pgamma+PW+Prim)$$

Ps' = 436.93 psi

Pt' = 258.45 psi

Pgamma = 0 psi

PW = 51.34 psi

Prim = 132.35 psi

Pe = 34.81 psi

UHX-13.5.7 Step 7. For each loading case calculate Q2 and Q3.

$$Q2 = ((omegas*(Ps)-(omegac)*(Pt))-((omegas*(Ps*)-omegac*(Pc*))+ (gammab/(2*Pi))*W)/(1+Phi*Zm)$$

$$Q3 = Q1 + 2*Q2 / Pe*ao**2$$

Q2 = -1767.954

Q3 = -0.0984

Using Xa and Q3, determine coefficient Fm for each loading case from either Table UHX-13.1 or Figs. UHX-13.3.-1 and UHX-13.3.-2.

Controlling x = 10.4638 in

Calculate functions Psi1 and Psi2 relative to x

$$Psi1(x) = bei(x) + (1-v*)/x * ber'(x)$$

$$Psi2(x) = ber(x) - (1-v*)/x * bei'(x)$$

Psi1(x) = 133.5543

Psi2(x) = 141.2525

Calculate functions Qm, Qv and Fm relative to x

$$Qm(x) = (bei'(Xa)*Psi2(x)-ber'(Xa)*Psi1(x))/Za$$

$$Qv(x) = (Psi1(Xa)*Psi2(x)-Psi2(Xa)*Psi1(x))/(Xa*Za)$$

Qm(x) = 1.0

Qv(x) = -0.0

43 of 102

Controlling F_m relative to x

$$F_m(x) = (Q_v(x) + Q_3 * Q_m(x)) / 2$$

$$F_m = \text{MAX}|F_m(x)|$$

For each loading case, calculate the bending stress in the tubesheet

$$\sigma = (1.5 * F_m / \mu) * (2 * a_o / (h - h'g))^{**2} * P_e$$

$$F_m(x) = -0.0492$$

$$F_m = 0.0492$$

$$\sigma = 21987 \text{ psi}$$

$$|\sigma| \leq 1.5 * S$$

$$21987 \text{ psi} \leq 22500 \text{ psi}$$

UHX-13.5.8 Step 8. For each loading case, calculate the average shear stress in the tubesheet at the outer edge of the perforated region

Area enclosed by perimeter

$$A_L = 3573.2 \text{ in}^2$$

Perimeter of the tube layout

$$C_L = 307.476 \text{ in}$$

Shear diameter $D_L = 4 * A_L / C_L$ or D_o

$$D_o = 70.375 \text{ in}$$

Ligament efficiency, μ

$$\mu = (p - dt) / p = 0.2$$

Shear stress, $\tau = (1 / (4 * \mu)) * (D_o / h) * P_e$

$$\tau = 2041 \text{ psi}$$

$$|\tau| \leq 0.8 * S$$

$$2041 \text{ psi} \leq 12000 \text{ psi}$$

UHX-13.5.9 Step 9. Perform this step for each loading case.

UHX-13.5.9(a) Calculate coefficient F_q and the axial tube stress $\sigma_{t,a}$ in the outermost tube row

$$\text{Factor } F_q = (Z_d + Q_3 * Z_v) * X_a^{**4} / 2 = 2.2337$$

$$\sigma_{t,a} = ((P_s * x_s - P_{t,t}) - P_e * F_q) / (x_t - x_s) = -467 \text{ psi}$$

$$\sigma_{t,a} \leq S_t$$

$$-467 \text{ psi} \leq 14941 \text{ psi}$$

UHX-13.5.9(b) Check the tubes for buckling.

$$C_t = \text{SQRT}(2 * \pi^{**2} * (E_t / S_y t))$$

$$C_t = 154.2491$$

$$r_t = \text{SQRT}(dt^{**2} + (dt - 2 * tt)^{**2}) / 4$$

$$r_t = 0.425 \text{ in}$$

$$F_t = l_t / r_t$$

$$F_t = 112.7136$$

$$F_s = \text{MAX}(1.25, (3.25 - 0.5 * F_q), 2)$$

$$F_s = 2.0$$

$$\text{For } C_t \leq F_t \quad S_{t,b} = \text{MIN}[(1 / F_s) * (\pi^{**2} * E_t / (F_t^{**2}), S_t]$$

$$S_{t,b} = -$$

$$\text{For } C_t > F_t \quad S_{t,b} = \text{MIN}[(S_y t / F_s) * (1 - (F_t / 2 * C_t)), S_t]$$

$$S_{t,b} = -7108 \text{ psi}$$

$$\sigma_{t,a} \leq S_{t,b}$$

$$-467 \text{ psi} \leq -7108 \text{ psi}$$

UHX-Tube stresses at the interior of the bundle.

Maximum tube compressive stress at the interior of the bundle

$$F_t(x) = Z_{dx} + Q_3 * Z_{wx} * (X_a^{**4} / 2)$$

$$F_i = f_t(x)$$

$$\text{sigmati} = ((P_s * x_s - P_{txt}) - P_e * F_i) / (x_t - x_s)$$

$$F_i = 2.9132$$

$$\text{sigmati} = -745 \text{ psi}$$

$$\text{sigmati} \leq S_{tb}$$

$$-745 \text{ psi} \leq -7108 \text{ psi}$$

UHX-13.5.10 Step 10. For each loading case, calculate the stresses in the shell and /or channel integral with the tubesheet.

Calculate the axial membrane stress sigmasm , axial bending stress sigmasb and total axial stress sigmas in the shell at its junction to the tubesheet

$$\text{sigmasm} = a_o^{**2} / t_s * (2 * a_s + t_s) * [P_e + (\rho_{hos}^{**2} - 1) * (P_s - P_t)] + a_s^{**2} / t_s * (2 * a_s + t_s) * P_t$$

$$\text{sigmasm} = 4087 \text{ psi}$$

$$sb1 = (6 / t_s^{**2}) * k_s$$

$$sb2 = \text{betas} * (\text{deltas} * P_s - v_s * (a_s / E_s) * \text{sigmasm})$$

$$sb3 = 6 * (1 - (\nu^*)^{**2}) / (E^*) * (a_o^{**3} / h^{**3}) * (1 + (h * \text{betas} / 2))$$

$$sb4 = P_e * (Z_v + Z_m * Q_1) + (2 / a_o^{**2}) * Z_m * Q_2$$

$$\text{sigmasb} = sb1 * (sb2 + sb3 * sb4)$$

$$\text{sigmasb} = 10329 \text{ psi}$$

$$\text{sigmas} = |\text{sigmasm}| + |\text{sigmasb}|$$

$$\text{sigmas} = 14416 \text{ psi}$$

$$\text{sigmas} \leq 1.5 * S$$

$$14416 \text{ psi} \leq 30000 \text{ psi}$$

ASME VIII-1 2004 A06 UHX-13 - Rules for the Design of Fixed Tubesheets

ASME Fig.UHX-13.1(b)	All Load Cases						
Controlling case:	***						
Load case:	1	2	3	4	5	6	7
Tube-side press, Pt	65	0	65	0	65	0	65
Shell-side press, Ps	0	165	165	0	0	165	165
Axial diff.Th.Exp	0.0	0.0	0.0	0.0381	0.0381	0.0381	0.0381
TubSh Bending stress	-12400	17326	21987	9685	14555	22102	26972
Max TubSh Bending st	22500	22500	22500	59505	59505	59505	59505
Min TubSh thk	1.1135	1.3163	1.4828	0.6052	0.7419	0.9142	1.0099
TubSh Shear stress	-794	3125	2041	2227	1145	5063	3982
Max TubSh Shear str	12000	12000	12000	15868	15868	15868	15868
Min TubSh thk	0.0993	0.3906	0.2552	0.2105	0.1083	0.4786	0.3764
Tubesheet thickness	1.5	1.5	1.5	1.5	1.5	1.5	1.5
Component: Rear Tubesheet							
ASME Fig.UHX-13.1(b)	All Load Cases						
Controlling case:	***						
Load case:	1	2	3	4	5	6	7
Tubes stress	1880	-2219	-467	-2543	-759	-4925	-3142
Max Tubes stress	14941	14941	14941	39671	39671	39671	39671
Max buckling stress	-	-11373	-7108	-11373	-7108	-11373	-11373
Total shell stress	21796	28177	14416	9048	11564	41124	27197
Max shell stress	30000	30000	30000	69600	69600	69600	69600
Max shell stress EP	69600	69600	69600				
Total channel stress	3767	0	3767	0	3767	0	3767
Max channel stress	28350	28350	28350	60000	60000	60000	60000
Max channel str. EP	56700	56700	56700				
EP factor - Facts(*)	1.0	1.0	1.0				
EP factor - Factc(*)	1.0	1.0	1.0	(*) <= 1 used in calculations			

Tube compressive stresses at the interior of the bundle							
Load case:	1	2	3	4	5	6	7
Tubes stress	-724	-2219	-745	-2543	-1046	-4925	-3142
Max buckling stress	-11373	-11373	-7108	-11373	-7108	-11373	-11373
ASME VIII-1 2004 A06 UHX-13 - Fixed Tubesheets - All Cases							
Load case	Ps	Pt	Gamma	Ps*	Pc*		
	psi	psi	in	psi	psi		
- 1 -	0	65	0	0	0		
- 2 -	165	0	0	0	0		
- 3 -	165	65	0	0	0		
- 4 -	0	0	0.0381	0	0		
- 5 -	0	65	0.0381	0	0		
- 6 -	165	0	0.0381	0	0		
- 7 -	165	65	0.0381	0	0		
Load case	P's	P't	Pgamma	Pomega	Pw	Prim	Pe
	psi	psi	psi	psi	psi	psi	psi
- 1 -	0	258.4	0	0	51.3	66.2	-13.5
- 2 -	436.9	0	0	0	51.3	66.1	53.3
- 3 -	436.9	258.4	0	0	51.3	132.4	34.8
- 4 -	0	0	348.6	0	52.6	0	38
- 5 -	0	262.7	348.6	0	52.6	67.9	19.5
- 6 -	443.4	0	348.6	0	52.6	67.8	86.3
- 7 -	443.4	262.7	348.6	0	52.6	135.7	67.9

Load case	Q2	Q3	Fm	Sigma	Sigma All	Tau	Tau All	
				psi	psi	psi	psi	
- 1 -	-1131.3	0.1185	0.0713	-12400	22500	-794	12000	
- 2 -	-1130.7	-0.0507	0.0253	17326	22500	3125	12000	
- 3 -	-1768	-0.0984	0.0492	21987	22500	2041	12000	
- 4 -	-488.5	-0.0373	0.0187	9685	59505	2227	15868	
- 5 -	-1118.6	-0.1091	0.0545	14555	59505	1145	15868	
- 6 -	-1118	-0.0375	0.0187	22102	59505	5063	15868	
- 7 -	-1748.1	-0.0581	0.0291	26972	59505	3982	15868	
ASME VIII-1 2004 A06 UHX-13 - Fixed Tubesheets - All Cases								
Load case	Fq	Fs	Sigto	Sigto All	Stb			
			psi	psi	psi			
- 1 -	14.2826	1.25	1880	14941	-11373			
- 2 -	4.886	1.25	-2219	14941	-11373			
- 3 -	2.2337	2	-467	14941	-7108			
- 4 -	5.6825	1.25	-2543	39671	-11373			
- 5 -	1.5626	2	-759	39671	-7108			
- 6 -	5.6749	1.25	-4925	39671	-11373			
- 7 -	4.4877	1.25	-3142	39671	-11373			
Load case	Sigsm	Sigsb	Sigs	Sigsall	Sigcm	Sigcb	Sigc	Sigcall
	psi	psi	psi	psi	psi	psi	psi	psi
- 1 -	2035	-19761	21796	30000	3767	0	3767	28350
- 2 -	2247	25930	28177	30000	0	0	0	28350
- 3 -	4087	10329	14416	30000	3767	0	3767	28350
- 4 -	1502	7547	9048	69600	0	0	0	60000
- 5 -	3343	-8221	11564	69600	3767	0	3767	60000
- 6 -	3554	37570	41124	69600	0	0	0	60000
- 7 -	5396	21802	27197	69600	3767	0	3767	60000

Type of tube-to-TS joint: expanded & strength welded

Load case:	1	2	3	4	5	6	7
Tube-to-TS Load, lbf	348	410	86	470	140	911	581
Allowable no-test	2210	2210	2210	4420	4420	4420	4420
Allowable test	2762	2762	2762	5525	5525	5525	5525

Allowable Loads per ASME Section VIII Div. 1 2004 A06 Appendix A

Type	Joint description	No Test		Test	
		fr	Lmax	fr	Lmax
a	Strength welded only	0.8	2210	1	2762
b	Seal welded only	0.55	1519	0.7	1934
e	Strength welded and expanded	0.8	2210	1	2762
f	Seal welded and exp.with 2 grooves	0.75	2072	0.95	2624
g	Seal welded and exp.with 1 groove	0.65	1796	0.85	2348
h	Seal welded and exp.with no grooves	0.5	1381	0.7	1934
i	Expanded with 2 grooves	0.7	1934	0.9	2486
j	Expanded with 1 groove	0.65	1796	0.8	2210
k	Expanded with no grooves	0.5	1381	0.6	1657

* = Load calculated exceeds code allowable for this joint type.

For joints types a,b,b-1,c,d,e : $L_{max} = A_t * S_a * f_r$

For joints types f,g,h, : $L_{max} = A_t * S_a * f_e * f_r * f_y$

For joints types i,j,k : $L_{max} = A_t * S_a * f_e * f_r * f_y, ft$

Cross-sectional area $A_t = 0.1849 \text{ in}^2$ Tube allowable stress $S_a = 14941 \text{ psi}$

Factor f_e (1/do or 1) $f_e = 1$ Ratio f_y $f_y = 1$

$f_t = (P_o + P_t) / P_o$ $f_t = 1$ Min Yield Str $\sigma_{M} = 30000 \text{ psi}$

($f_t = 1$ if max exceeded)

Tube OD $d_o = 1.25 \text{ in}$ Tube thickness $t_t = 0.049 \text{ in}$

Tubes yield str(min) $s_t = 30000 \text{ psi}$ TubSh mean metal tmp $T = 105 \text{ F}$

Tubes Mod.Elasticity $E_t T = 28111538 \text{ psi}$ TubSh Mod.Elast. $E_s T = 28111538 \text{ psi}$

Tubes Coef.Th.Exp. $a_t = 0.0000086$ TubSh Coef.Th.Exp. $a_s = 0.0000086$

$P_o = (4 * (d_o * t - t^2) * s_t) / (d_o^2)$ $P_o = 4520 \text{ psi}$

$P_t = ((T - T_{amb}) * (a_t - a_s) * (E_t T * E_s T)) / (E_t T + E_s T)$ $P_t = -$

For joint types i, j, k: $P_o + P_t \leq 0.58 * \sigma_{M}$

4520 psi \leq 17400 psi

UHX-9 Tubesheet Flanged Extension

G = diameter of gasket load reaction $G = 72.75 \text{ in}$

hG = gasket moment arm $hG = 0.75 \text{ in}$

S_a = allowable stress for tubesheet extension at ambient temperature $S_a = 20000 \text{ psi}$

S_d = allowable stress for tubesheet extension at design temperature $S_d = 15000 \text{ psi}$

T_a = ambient temperature $T_a = 70 \text{ F}$

T_d = design temperature $T_d = 300 \text{ F}$

W_o = flange design bolt load, opeating conditions $W_o = 219266 \text{ lbf}$

W_g = flange design bolt load, gasket seating $W_g = 223033 \text{ lbf}$

Minimum required thickness of the tubesheet flanged extension

$h_{ro} = \text{SQRT}(1.9 * W_o * hG) / (S_d * G)$ $h_{ro} = 0.5351 \text{ in}$

$h_{rg} = \text{SQRT}(1.9 * W_g * hG) / (S_a * G)$ $h_{rg} = 0.4674 \text{ in}$

$h_r = \text{MAX}[h_{ro}, h_{rg}]$ $h_r = 0.5351 \text{ in}$

Component: Nozzle A

ASME VIII-1 2004 A06 UG-27 Thickness of Cylinders under Internal Pressure

--- Calculations --- Cylinder Internal Pressure

Material: SA-516 K02700 Grd 70 Plate

Design pressure	P = 150 psi	Design temperature	T = 200 F
Radiography	= None	Joint efficiency	E = 0.7
Design stress	S = 20000 psi		
Inside corr.allow. cai	= 0.0625 in	Outside corr. all. cao	= 0.0 in
Material tolerance tol	= 0.0 in	Minimum thickness tmin	= 0.3906 in
Outside diameter OD	= 30.0 in	Corroded radius OR	= 15.0 in

- Min. thk. not less than UG-45(a), UG-16(b), UG-45(b):

- UG-45(a) Internal pressure:
 $t = (P \cdot OR / (S \cdot E + 0.4 \cdot P)) + cai + cao + tol = 0.2225 \text{ in}$ APP.1-1(A)
- UG-45(a) external pressure+cai+cao+tol $t = 0.124 \text{ in}$
- UG-16(b) minimum thickness+cai+cao+tol $t = 0.1563 \text{ in}$
- UG-45(b) Smaller of: $t = 0.3906 \text{ in}$
- UG-45(b) (4) std pipe*0.875+cai+cao+tol = 0.3906 in
- UG-45(b) Greater of: $t = 0.3971 \text{ in}$
- UG-45(b) (1)+cai+cao+tol = 0.3971 in
- UG-45(b) (2)+cai+cao+tol = 0 in

Minimum thickness:	tmin = 0.3906 in
Nominal thickness:	tnom = 0.5 in

ASME Section VIII-1 2004 A06 UG-28 Thickness of Shells under Ext. Pressure

--- Calculations --- Cylinder External Pressure

Material: SA-516 K02700 Grd 70 Plate

Design pressure	PE = 15 psi	Design temperature	T = 200 F
Inside corr. allow. CAI	= 0.0625 in	Corrosion allow. CAO	= 0 in
Radiography	= None	Material tol.	Tol = 0 in
Cyl. outside dia. Do	= 30 in	Cylinder length EP	L = 10 in
Nominal thickness tnom	= 0.5 in	(tnom-CAI-CAO-Tol) t	= 0.4375 in
L/Do ratio Ldo	= 0.3333	Do/t	Dot = 68.5714
(2*S) or (0.9*yield) SE	= -	Mod. of elasticity ME	= 28600000 psi
A factor SII-D-FigG A	= 0.008576	B factor CS-2 B	= 17333
Max allowed external pressure: Pa	= 4*B / (3*Dot)		= 337.03 psi
Actual external design pressure:		PE	= 15 psi

(Required cyl. tks. for nozzle attachments at PE, tre = 0.0615 in)

Component: Reinforcement Nozzle A
ASME Section VIII-1 2004 A06 UG-37 Reinforcement Required for Openings in Shells and Formed Heads

--- Design Conditions:

Int. design pressure PI = 150 psi	Ext. design press. PE = 15 psi
Design temperature T = 200 F	Fig.UW-16.1 Sketch (q)
Vessel material: SA-516 K02700 Grd 70 Plate	
Inside corr. allow. CAI = 0.0625 in	Outside corr.allow.CAO = 0.0 in
Vessel design stress Sv = 20000 psi	Joint efficiency E = 1
Vessel outside dia Do = 89.5 in	Corroded radius OR = 44.75 in
Nominal thickness tnom = 0.75 in	Reinforcement limit lp = 29.125 in
Req. tks. int.pres. tr = 0.3346 in	Req. tks.ext.pres. tre = 0.2185 in
Corroded thickness t = 0.6875 in	Reinf. efficiency E1 = 1.0
Attachment Material: SA-516 K02700 Grd 70 Plate	
Inside corr. allow. CAI = 0.0625 in	Outside corr.allow.CAO = 0.0 in
Nozzle design stress Sn = 20000 psi	Joint efficiency E = 0.7
Nozzle outside dia. Don = 30.0 in	Corroded radius OR = 15.0 in
Nominal thickness tnom = 0.5 in	Reinforcement limit ln = 1.0938 in
Req.tks. int.pres. trn = 0.16 in	Req.tks.ext.pres. trne = 0.0615 in
Corroded thickness tn = 0.4375 in	Nozzle Projection h = 0.0 in
Reinforcement element material:	
Limit of reinf. Dp = 0.0 in	Nominal thickness te = 0.0 in
Outside diameter = 0.0 in	Design stress Se = 0 psi
Minimum weld size tmin = 0.4375 in	Leg size(1/2*tmin) (Act)= 0.0 in
1/2 * tmin (minimum) = 0.0 in	1/2 * tmin (actual) = 0.0 in
Weld tw (minimum) = 0.0 in	Weld tw (actual) = 0.0 in
Weld tc (minimum) = 0.0 in	Weld tc (actual) = 0.0 in
smaller 0.25 in	Leg size tw (actual) = 0.0 in
tc of 0.7 * tmin	Leg size tc (actual) = 0.0 in
Outward nozzle weld L1 = 0.0 in	fr1 = Sn/Sv = 1.0
Outer element weld L2 = 0.0 in	fr2 = Sn/Sv = 1.0
Inward nozzle weld L3 = 0.0 in	fr3 = Sn/Sv or Se/Sv = 1.0
Inward nozzle weld new = 0.0 in	fr4 = Se/Sv = 1.0
Corroded int.proj.thk ti = 0.0 in	

Corroded inside diameter

d = 29.125 in

Vessel wall length available for reinforcement 2*Lp-d = 29.125 in

Plane correction factor (Fig.UG-37) F = 1.0

Offset distance from centerline doff = 0.0 in

Reinforcement areas (internal pressure condition) ASME 2004 UG-37

A1 = Vessel wall. Larger of:

| (2*Lp-d)*(E1*t-F*tr)-2*tn*(E1*t-F*tr)*(1-fr1)| = 10.2776 in2

| 2*(t+tn)*(E1*t-F*tr)-2*tn*(E1*t-F*tr)*(1-fr1)| = 0.794 in2

A1 = 10.2776 in2

A2 = Nozzle wall outward | 5*(tn-trn)*fr2*t | = 0.9538 in2

Smaller of: | 5*(tn-trn)*fr2*tn | = 0.607 in2

A2 = 0.607 in2

A3 = Nozzle wall inward | 5*t*ti*fr2 | = 0.0 in2

Smallest of: | 5*ti*ti*fr2 | = 0.0 in2

| 2*h*ti*fr2 | = 0.0 in2

A3 = 0.0 in2

A41 = Outward nozzle weld = (L1**2)*fr3 = 0.0 in2

A42 = Outer element weld = (L2**2)*fr4 = 0.0 in2

A43 = Inward nozzle weld = (L3**2)*fr2 = 0.0 in2

A4 = 0.0 in2

A5 = Reinforcement pad Area = (Dp-d-2*tn)*te*fr4

Aa = Area Available = A1+A2+A3+A4+A5

A = Area required = (d*tr*F)+2*tn*tr*F*(1-f1)

ASME VIII-1 2004 A06 Reinforcement areas (external pressure) UG-37(d)

A1 = Vessel wall. Larger of:

| (2*Lp-d)*(E1*t-F*tre)-2*tn*(E1*t-F*tre)*(1-fr1)| = 13.6596 in2

| 2*(t+tn)*(E1*t-F*tre)-2*tn*(E1*t-F*tre)*(1-fr1)| = 1.0552 in2

A1 = 13.6596 in2

A2 = Nozzle wall outward | 5*(tn-trne)*fr2*t | = 1.2925 in2

Smaller of: | 5*(tn-trne)*fr2*tn | = 0.8225 in2

A2 = 0.8225 in2

A3 = Nozzle wall inward | 5*t*ti*fr2 | = 0.0 in2

Smallest of: | 5*ti*ti*fr2 | = 0.0 in2

| 2*h*ti*fr2 | = 0.0 in2

A3 = 0.0 in2

A41 = Outward nozzle weld = (L1**2)*fr3 = 0.0 in2

A42 = Outer element weld = (L2**2)*fr4 = 0.0 in2

A43 = Inward nozzle weld = (L3**2)*fr2 = 0.0 in2

A4 = 0.0 in2

A5 = Reinforcement pad Area = (Dp-d-2*tn)*te*fr4

Aa = Area Available = A1+A2+A3+A4+A5

A = Area required = 0.5*(d*tre*F+2*tn*tre*F*(1-fr1))

A5 = 0.0 in2

Aa = 14.4821 in2

A = 3.1819 in2

Nozzle attachment weld loads - UG-41 - Strength of reinforcement

ASME - Weld strength calculations not required per UW-15(b).

Total weld load (UG-41(b)(2))

$W = (A-A1+2*tn*fr1(E1*t-F*tr))*Sv$ W = -

Weld load for strength path 1-1 (UG-41(b)(1))

$W(1-1) = (A2+A5+A41+A42)*Sv$ W(1-1) = 12139 lbf

Weld load for strength path 2-2 (UG-41(b)(1))

$W(2-2) = (A2+A3+A41+A43+2*tn*t*fr1)*Sv$ W(2-2) = 24171 lbf

Weld load for strength path 3-3 (UG-41(b)(1))

$W(3-3) = (A2+A3+A5+A41+A42+A43+2*tn*t*fr1)*Sv$ W(3-3) = -

Reinforcing element strength = $A5 * Se$ = -

Nozzle attachment weld loads - ASME 2004 UG-41 - Strength of reinforcement

Unit stresses - UW15(c) and UG-45(c)

Inner fillet weld shear = 9800 psi

Outer fillet weld shear = -

Groove weld tension = 14800 psi

Groove weld shear = -

Nozzle wall shear = 14000 psi

Strength of connection elements

Inner fillet weld shear = 0 lbf

Nozzle wall shear = 284281 lbf

Groove weld tension = -

Outer fillet weld shear = -

Possible paths of failure

1-1 284281 + 0 = 284281 lbf

2-2 0 + 0 = -0 lbf

3-3 - + - = -

Welds strong enough if path greater than the smaller of W or W(path)

Path 1-1 > W or W11

284281 lbf > 12139 lbf OK

Path 2-2 > W or W22

-0 lbf > 24171 lbf

Path 3-3 > W or W33

- > -

Component: Nozzle B

ASME VIII-1 2004 A06 UG-27 Thickness of Cylinders under Internal Pressure

--- Calculations --- Cylinder Internal Pressure

Material: SA-516 K02700 Grd 70 Plate

Design pressure	P = 150 psi	Design temperature	T = 200 F
Radiography	= None	Joint efficiency	E = 0.7
Design stress	S = 20000 psi		
Inside corr.allow.	cai = 0.0625 in	Outside corr. all.	cao = 0.0 in
Material tolerance	tol = 0.0 in	Minimum thickness	tmin = 0.3906 in
Outside diameter	OD = 30.0 in	Corroded radius	OR = 15.0 in

- Min. thk. not less than UG-45(a), UG-16(b), UG-45(b):

- UG-45(a) Internal pressure:
 $t = (P \cdot OR / (S \cdot E + 0.4 \cdot P)) + cai + cao + tol = 0.2225 \text{ in}$ APP.1-1(A)
- UG-45(a) external pressure+cai+cao+tol $t = 0.124 \text{ in}$
- UG-16(b) minimum thickness+cai+cao+tol $t = 0.1563 \text{ in}$
- UG-45(b) Smaller of: $t = 0.3906 \text{ in}$
- UG-45(b) (4) std pipe*0.875+cai+cao+tol = 0.3906 in
- UG-45(b) Greater of: $t = 0.3971 \text{ in}$
- UG-45(b) (1)+cai+cao+tol = 0.3971 in
- UG-45(b) (2)+cai+cao+tol = 0 in

Minimum thickness:	tmin = 0.3906 in
Nominal thickness:	tnom = 0.5 in

ASME Section VIII-1 2004 A06 UG-28 Thickness of Shells under Ext. Pressure

--- Calculations --- Cylinder External Pressure

Material: SA-516 K02700 Grd 70 Plate

Design pressure	PE = 15 psi	Design temperature	T = 200 F
Inside corr. allow.	CAI = 0.0625 in	Corrosion allow.	CAO = 0 in
Radiography	= None	Material tol.	Tol = 0 in
Cyl. outside dia.	Do = 30 in	Cylinder length EP	L = 10 in
Nominal thickness	tnom = 0.5 in	(tnom-CAI-CAO-Tol)	t = 0.4375 in
L/Do ratio	Ldo = 0.3333	Do/t	Dot = 68.5714
(2*S) or (0.9*yield)	SE = -	Mod. of elasticity	ME = 28600000 psi
A factor SII-D-FigG	A = 0.008576	B factor CS-2	B = 17333
Max allowed external pressure:	Pa = 4*B / (3*Dot)		= 337.03 psi
Actual external design pressure:		PE = 15 psi	

(Required cyl. tks. for nozzle attachments at PE, tre = 0.0615 in)

Component: Reinforcement Nozzle B

ASME Section VIII-1 2004 A06 UG-37 Reinforcement Required for Openings in Shells and Formed Heads

--- Design Conditions:

Int. design pressure	PI = 150 psi	Ext. design press.	PE = 15 psi
Design temperature	T = 200 F	Fig.	UW-16.1 Sketch (q)
Vessel material: SA-516 K02700 Grd 70 Plate			
Inside corr. allow.	CAI = 0.0625 in	Outside corr.allow.	CAO = 0.0 in
Vessel design stress	Sv = 20000 psi	Joint efficiency	E = 1
Vessel outside dia	Do = 89.5 in	Corroded radius	OR = 44.75 in
Nominal thickness	tnom = 0.75 in	Reinforcement limit	lp = 29.125 in
Req. tks. int.pres.	tr = 0.3346 in	Req. tks.ext.pres.	tre = 0.2185 in
Corroded thickness	t = 0.6875 in	Reinf. efficiency	E1 = 1.0
Attachment Material: SA-516 K02700 Grd 70 Plate			
Inside corr. allow.	CAI = 0.0625 in	Outside corr.allow.	CAO = 0.0 in
Nozzle design stress	Sn = 20000 psi	Joint efficiency	E = 0.7
Nozzle outside dia.	Don = 30.0 in	Corroded radius	OR = 15.0 in
Nominal thickness	tnom = 0.5 in	Reinforcement limit	ln = 1.0938 in
Req.tks. int.pres.	trn = 0.16 in	Req.tks.ext.pres.	trne = 0.0615 in
Corroded thickness	tn = 0.4375 in	Nozzle Projection	h = 0.0 in
Reinforcement element material:			
Limit of reinf.	Dp = 0.0 in	Nominal thickness	te = 0.0 in
Outside diameter	= 0.0 in	Design stress	Se = 0 psi
Minimum weld size	tmin = 0.4375 in	Leg size(1/2*tmin) (Act)	= 0.0 in
1/2 * tmin (minimum)	= 0.0 in	1/2 * tmin (actual)	= 0.0 in
Weld tw (minimum)	= 0.0 in	Weld tw (actual)	= 0.0 in
Weld tc (minimum)	= 0.0 in	Weld tc (actual)	= 0.0 in
smaller 0.25 in		Leg size tw (actual)	= 0.0 in
tc of 0.7 * tmin		Leg size tc (actual)	= 0.0 in
Outward nozzle weld	L1 = 0.0 in	fr1 = Sn/Sv	= 1.0
Outer element weld	L2 = 0.0 in	fr2 = Sn/Sv	= 1.0
Inward nozzle weld	L3 = 0.0 in	fr3 = Sn/Sv or Se/Sv	= 1.0
Inward nozzle weld new	= 0.0 in	fr4 = Se/Sv	= 1.0
Corroded int.proj.thk	ti = 0.0 in		

Corroded inside diameter

d = 29.125 in

Vessel wall length available for reinforcement 2*Lp-d = 29.125 in

Plane correction factor (Fig.UG-37) F = 1.0

Offset distance from centerline doff = 0.0 in

Reinforcement areas (internal pressure condition) ASME 2004 UG-37

A1 = Vessel wall. Larger of:

| (2*Lp-d)*(E1*t-F*tr)-2*tn*(E1*t-F*tr)*(1-fr1)| = 10.2776 in2

| 2*(t+tn)*(E1*t-F*tr)-2*tn*(E1*t-F*tr)*(1-fr1)| = 0.794 in2

A1 = 10.2776 in2

A2 = Nozzle wall outward | 5*(tn-trn)*fr2*t | = 0.9538 in2

Smaller of: | 5*(tn-trn)*fr2*tn | = 0.607 in2

A2 = 0.607 in2

A3 = Nozzle wall inward | 5*t*ti*fr2 | = 0.0 in2

Smallest of: | 5*ti*ti*fr2 | = 0.0 in2

| 2*h*ti*fr2 | = 0.0 in2

A3 = 0.0 in2

A41 = Outward nozzle weld = (L1**2)*fr3 = 0.0 in2

A42 = Outer element weld = (L2**2)*fr4 = 0.0 in2

A43 = Inward nozzle weld = (L3**2)*fr2 = 0.0 in2

A4 = 0.0 in2

A5 = Reinforcement pad Area = (Dp-d-2*tn)*te*fr4

Aa = Area Available = A1+A2+A3+A4+A5

A = Area required = (d*tr*F)+2*tn*tr*F*(1-fl)

ASME VIII-1 2004 A06 Reinforcement areas (external pressure) UG-37(d)

A = 9.7458 in2

A1 = Vessel wall. Larger of:

| (2*Lp-d)*(E1*t-F*tre)-2*tn*(E1*t-F*tre)*(1-fr1)| = 13.6596 in2

| 2*(t+tn)*(E1*t-F*tre)-2*tn*(E1*t-F*tre)*(1-fr1)| = 1.0552 in2

A1 = 13.6596 in2

A2 = Nozzle wall outward | 5*(tn-trne)*fr2*t | = 1.2925 in2

Smaller of: | 5*(tn-trne)*fr2*tn | = 0.8225 in2

A2 = 0.8225 in2

A3 = Nozzle wall inward | 5*t*ti*fr2 | = 0.0 in2

Smallest of: | 5*ti*ti*fr2 | = 0.0 in2

| 2*h*ti*fr2 | = 0.0 in2

A3 = 0.0 in2

A41 = Outward nozzle weld = (L1**2)*fr3 = 0.0 in2

A42 = Outer element weld = (L2**2)*fr4 = 0.0 in2

A43 = Inward nozzle weld = (L3**2)*fr2 = 0.0 in2

A4 = 0.0 in2

A5 = Reinforcement pad Area = (Dp-d-2*tn)*te*fr4

Aa = Area Available = A1+A2+A3+A4+A5

A = Area required = 0.5*(d*tre*F+2*tn*tre*F*(1-fr1))

Aa = 14.4821 in2

A = 3.1819 in2

Nozzle attachment weld loads - UG-41 - Strength of reinforcement

ASME - Weld strength calculations not required per UW-15(b).

Total weld load (UG-41(b)(2))

$W = (A-A1+2*tn*fr1(E1*t-F*tr))*Sv$ W = -

Weld load for strength path 1-1 (UG-41(b)(1))

$W(1-1) = (A2+A5+A41+A42)*Sv$ W(1-1) = 12139 lbf

Weld load for strength path 2-2 (UG-41(b)(1))

$W(2-2) = (A2+A3+A41+A43+2*tn*t*fr1)*Sv$ W(2-2) = 24171 lbf

Weld load for strength path 3-3 (UG-41(b)(1))

$W(3-3) = (A2+A3+A5+A41+A42+A43+2*tn*t*fr1)*Sv$ W(3-3) = -

Reinforcing element strength = $A5 * Se$ = -

Nozzle attachment weld loads - ASME 2004 UG-41 - Strength of reinforcement

Unit stresses - UW15(c)and UG-45(c)

Inner fillet weld shear = 9800 psi

Outer fillet weld shear = -

Groove weld tension = 14800 psi

Groove weld shear = -

Nozzle wall shear = 14000 psi

Strength of connection elements

Inner fillet weld shear = 0 lbf

Nozzle wall shear = 284281 lbf

Groove weld tension = -

Outer fillet weld shear = -

Possible paths of failure

1-1 284281 + 0 = 284281 lbf

2-2 0 + 0 = -0 lbf

3-3 - + - = -

Welds strong enough if path greater than the smaller of W or W(path)

Path 1-1 > W or W11

284281 lbf > 12139 lbf OK

Path 2-2 > W or W22

-0 lbf > 24171 lbf

Path 3-3 > W or W33

- > -

Component: Nozzle C

ASME VIII-1 2004 A06 UG-27 Thickness of Cylinders under Internal Pressure

--- Calculations --- Cylinder Internal Pressure

Material: SA-240 S30400 Grd 304 Plate(G5)

Design pressure P = 50 psi Design temperature T = 300 F

Radiography = None Joint efficiency E = 0.7

Design stress S = 18900 psi

Inside corr.allow. cai = 0.0 in Outside corr. all. cao = 0.0 in

Material tolerance tol = 0.0 in Minimum thickness tmin = 0.114 in

Outside diameter OD = 54.0 in Corroded radius OR = 27.0 in

- Min. thk. not less than UG-45(a), UG-16(b), UG-45(b):

- UG-45(a) Internal pressure:

$$t = (P \cdot OR / (S \cdot E + 0.4 \cdot P)) + cai + cao + tol = 0.1019 \text{ in} \quad \text{APP.1-1 (A)}$$

- UG-45(a) external pressure+cai+cao+tol t = 0.114 in

- UG-16(b) minimum thickness+cai+cao+tol t = 0.0938 in

UG-45(b) Smaller of: t = 0.0951 in

UG-45(b) (4) std pipe*0.875+cai+cao+tol = 0.3281 in

- UG-45(b) Greater of: t = 0.0951 in

- UG-45(b) (1)+cai+cao+tol = 0.0951 in

- UG-45(b) (2)+cai+cao+tol = 0.0286 in

Minimum thickness: tmin = 0.114 in

Nominal thickness: tnom = 0.375 in

ASME Section VIII-1 2004 A06 UG-28 Thickness of Shells under Ext. Pressure

--- Calculations --- Cylinder External Pressure

Material: SA-240 S30400 Grd 304 Plate(G5)

Design pressure PE = 15 psi Design temperature T = 300 F

Inside corr. allow. CAI = 0 in Corrosion allow. CAO = 0 in

Radiography = None Material tol. Tol = 0 in

Cyl. outside dia. Do = 54 in Cylinder length EP L = 17.75 in

Nominal thickness tnom = 0.375 in (tnom-CAI-CAO-Tol) t = 0.375 in

L/Do ratio Ldo = 0.3287 Do/t Dot = 144.0

(2*S) or (0.9*yield) SE = - Mod. of elasticity ME = 27000000 psi

A factor SII-D-FigG A = 0.002624 B factor HA-1 B = 9915

Max allowed external pressure: Pa = 4*B / (3*Dot) = 91.81 psi

Actual external design pressure: PE = 15 psi

(Required cyl. tks. for nozzle attachments at PE, tre = 0.114 in)

Component: Reinforcement Nozzle C
ASME Section VIII-1 2004 A06 UG-37 Reinforcement Required for Openings in Shells and Formed Heads

--- Design Conditions:

Int. design pressure	PI = 50 psi	Ext. design press.	PE = 15 psi
Design temperature	T = 300 F	Fig.UW-16.1 Sketch	(q)
Vessel material:	SA-240 S30400 Grd 304 Plate(G5)		
Inside corr. allow.	CAI = 0.0 in	Outside corr.allow.CAO	= 0.0 in
Vessel design stress	Sv = 18900 psi	Joint efficiency	E = 1
Vessel outside dia	Do = 72.0 in	Corroded radius	OR = 36.0 in
Nominal thickness	tnom = 0.375 in	Reinforcement limit lp	= 53.25 in
Req. tks. int.pres.	tr = 0.0951 in	Req. tks.ext.pres. tre	= 0.303 in
Corroded thickness	t = 0.375 in	Reinf. efficiency	E1 = 1.0
Attachment Material:	SA-240 S30400 Grd 304 Plate(G5)		
Inside corr. allow.	CAI = 0.0 in	Outside corr.allow.CAO	= 0.0 in
Nozzle design stress	Sn = 18900 psi	Joint efficiency	E = 0.7
Nozzle outside dia.	Don = 54.0 in	Corroded radius	OR = 27.0 in
Nominal thickness	tnom = 0.375 in	Reinforcement limit ln	= 0.9375 in
Req.tks. int.pres.	trn = 0.1019 in	Req.tks.ext.pres. trne	= 0.114 in
Corroded thickness	tn = 0.375 in	Nozzle Projection	h = 0.0 in
Reinforcement element material:	SA-240 S30400 Grd 304 Plate(G5)		
Limit of reinf.	Dp = 76.0 in	Nominal thickness	te = 0.375 in
Outside diameter	= 76.0 in	Design stress	Se = 18900 psi
Minimum weld size tmin	= 0.375 in	Leg size(1/2*tmin) (Act)	= 0.2679 in
1/2 * tmin (minimum)	= 0.1875 in	1/2 * tmin (actual)	= 0.1875 in
Weld tw (minimum)	= 0.2625 in	Weld tw (actual)	= 0.3571 in
Weld tc (minimum)	= 0.25 in	Weld tc (actual)	= 0.25 in
smaller 0.25 in		Leg size tw (actual)	= 0.3571 in
tc of 0.7 * tmin		Leg size tc (actual)	= 0.3571 in
Outward nozzle weld	L1 = 0.3571 in	fr1 = Sn/Sv	= 1.0
Outer element weld	L2 = 0.2679 in	fr2 = Sn/Sv	= 1.0
Inward nozzle weld	L3 = 0.0 in	fr3 = Sn/Sv or Se/Sv	= 1.0
Inward nozzel weld new	= 0.0 in	fr4 = Se/Sv	= 1.0
Corroded int.proj.thk ti	= 0.0 in		

Corroded inside diameter **d = 53.25 in**
Vessel wall length available for reinforcement $2 \cdot Lp - d = 53.25 \text{ in}$
Plane correction factor (Fig.UG-37) $F = 1.0$
Offset distance from centerline $doff = 0.0 \text{ in}$
Reinforcement areas (internal pressure condition) ASME 2004 UG-37
A1 = Vessel wall. Larger of:
 $| (2 \cdot Lp - d) \cdot (E1 \cdot t - F \cdot tr) - 2 \cdot tn \cdot (E1 \cdot t - F \cdot tr) \cdot (1 - fr1) | = 14.9027 \text{ in}^2$
 $| 2 \cdot (t + tn) \cdot (E1 \cdot t - F \cdot tr) - 2 \cdot tn \cdot (E1 \cdot t - F \cdot tr) \cdot (1 - fr1) | = 0.4198 \text{ in}^2$
A1 = 14.9027 in2
A2 = Nozzle wall outward $| 5 \cdot (tn - trn) \cdot fr2 \cdot t | = 0.5121 \text{ in}^2$
Smaller of: $| 2 \cdot (tn - trn) \cdot (2.5 \cdot tn + te) \cdot fr2 | = 0.7169 \text{ in}^2$
A2 = 0.5121 in2
A3 = Nozzle wall inward $| 5 \cdot t \cdot ti \cdot fr2 | = 0.0 \text{ in}^2$
Smallest of: $| 5 \cdot ti \cdot ti \cdot fr2 | = 0.0 \text{ in}^2$
 $| 2 \cdot h \cdot ti \cdot fr2 | = 0.0 \text{ in}^2$
A3 = 0.0 in2
A41 = Outward nozzle weld = $(L1 \cdot \cdot 2) \cdot fr3 = 0.1276 \text{ in}^2$
A42 = Outer element weld = $(L2 \cdot \cdot 2) \cdot fr4 = 0.0717 \text{ in}^2$
A43 = Inward nozzle weld = $(L3 \cdot \cdot 2) \cdot fr2 = 0.0 \text{ in}^2$
A4 = 0.1993 in2
A5 = Reinforcement pad Area = $(Dp - d - 2 \cdot tn) \cdot te \cdot fr4$ **A5 = 8.25 in2**
Aa = Area Available = $A1 + A2 + A3 + A4 + A5$ **Aa = 23.8641 in2**
A = Area required = $(d \cdot tr \cdot F) + 2 \cdot tn \cdot tr \cdot F \cdot (1 - f1)$ **A = 5.0661 in2**
For large nozzles per 1-7:
Reinforcement limit $Dp2 = \text{MIN}(Dp, 1 - 7(a)(1))$ **Dp2 = 76.0 in**
A52 = Reinforcement pad Area = $(Dp2 - d - 2 \cdot tn) \cdot te \cdot fr4$ **A52 = 8.25 in2**
A12 = Vessel wall. Larger of:
 $| (1.5 \cdot Lp - d) \cdot (E1 \cdot t - F \cdot tr) - 2 \cdot tn \cdot (E1 \cdot t - F \cdot tr) \cdot (1 - fr1) | = 7.4513 \text{ in}^2$
 $| 2 \cdot (t + tn) \cdot (E1 \cdot t - F \cdot tr) - 2 \cdot tn \cdot (E1 \cdot t - F \cdot tr) \cdot (1 - fr1) | = 0.4198 \text{ in}^2$
Aa2 = Area Available = $A12 + A2 + A3 + A4 + A52$ **Aa2 = 16.4127 in2**
A = $(2/3) \cdot \text{Area required} = (2/3) \cdot ((d \cdot tr \cdot F) + 2 \cdot tn \cdot tr \cdot F \cdot (1 - f1))$ **A = 3.3774 in2**
Note: Parallel and normal limits per 1-7(a)(1) and 1-7(a)(2). Calculations per 1-7(b) only shown if required (see 1-7(b)(1)(a),(b),(c)).
ASME VIII-1 2004 A06 Reinforcement areas (external pressure) UG-37(d)
A1 = Vessel wall. Larger of:
 $| (2 \cdot Lp - d) \cdot (E1 \cdot t - F \cdot tre) - 2 \cdot tn \cdot (E1 \cdot t - F \cdot tre) \cdot (1 - fr1) | = 3.834 \text{ in}^2$
 $| 2 \cdot (t + tn) \cdot (E1 \cdot t - F \cdot tre) - 2 \cdot tn \cdot (E1 \cdot t - F \cdot tre) \cdot (1 - fr1) | = 0.108 \text{ in}^2$
A1 = 3.834 in2
A2 = Nozzle wall outward $| 5 \cdot (tn - trne) \cdot fr2 \cdot t | = 0.4894 \text{ in}^2$
Smaller of: $| 2 \cdot (tn - trne) \cdot (2.5 \cdot tn + te) \cdot fr2 | = 0.6851 \text{ in}^2$
A2 = 0.4894 in2
A3 = Nozzle wall inward $| 5 \cdot t \cdot ti \cdot fr2 | = 0.0 \text{ in}^2$
Smallest of: $| 5 \cdot ti \cdot ti \cdot fr2 | = 0.0 \text{ in}^2$
 $| 2 \cdot h \cdot ti \cdot fr2 | = 0.0 \text{ in}^2$
A3 = 0.0 in2
A41 = Outward nozzle weld = $(L1 \cdot \cdot 2) \cdot fr3 = 0.1276 \text{ in}^2$
A42 = Outer element weld = $(L2 \cdot \cdot 2) \cdot fr4 = 0.0717 \text{ in}^2$
A43 = Inward nozzle weld = $(L3 \cdot \cdot 2) \cdot fr2 = 0.0 \text{ in}^2$
A4 = 0.1993 in2
A5 = Reinforcement pad Area = $(Dp - d - 2 \cdot tn) \cdot te \cdot fr4$ **A5 = 8.25 in2**
Aa = Area Available = $A1 + A2 + A3 + A4 + A5$ **Aa = 12.7727 in2**
A = Area required = $0.5 \cdot (d \cdot tre \cdot F + 2 \cdot tn \cdot tre \cdot F \cdot (1 - fr1))$ **A = 8.0674 in2**

Nozzle attachment weld loads - UG-41 - Strength of reinforcement

Total weld load (UG-41(b)(2))
W = (A-A1+2*tn*frl(E1*t-F*tr))*Sv W = -
Weld load for strength path 1-1 (UG-41(b)(1))
W(1-1) = (A2+A5+A41+A42)*Sv W(1-1) = 169370 lbf
Weld load for strength path 2-2 (UG-41(b)(1))
W(2-2) = (A2+A3+A41+A43+2*tn*t*frl)*Sv W(2-2) = 17405 lbf
Weld load for strength path 3-3 (UG-41(b)(1))
W(3-3) = (A2+A3+A5+A41+A42+A43+2*tn*t*frl)*Sv W(3-3) = 174686 lbf
Reinforcing element strength = A5 * Se = 155925 lbf
Nozzle attachment weld loads - ASME 2004 UG-41 - Strength of reinforcement
Unit stresses - UW15(c)and UG-45(c)
Inner fillet weld shear = 9261 psi
Outer fillet weld shear = 9261 psi
Groove weld tension = 13986 psi
Groove weld shear = 11340 psi
Nozzle wall shear = 13230 psi
Strength of connection elements
Inner fillet weld shear = 280410 lbf
Nozzle wall shear = 417694 lbf
Groove weld tension = 423477 lbf
Outer fillet weld shear = 295989 lbf
Possible paths of failure
1-1 417694 + 295989 = 713683 lbf
2-2 280410 + 846954 = 1127364 lbf
3-3 423477 + 295989 = 719466 lbf
Welds strong enough if path greater than the smaller of W or W(path)
Path 1-1 > W or W11
713683 lbf > 169370 lbf OK
Path 2-2 > W or W22
1127364 lbf > 17405 lbf OK
Path 3-3 > W or W33
719466 lbf > 0 lbf

Component: Reinforcement Nozzle C

Appendix 1-7 - Large Openings in Cylindrical Shells
Paragraph 1-7(b) - All dimensions in their corroded state
Radius R R = 35.625 in Radius Rn Rn = 26.625 in
Ratio Rn / R Rn / R = 0.7474 Method applicable for Rn / R <= 0.7
Mean cylinder radius Rm = 35.8125 in Mean nozzle radius Rnm = 26.8125 in
Cylinder thickness t = 0.375 in Nozzle thickness tn = 0.375 in
Pad thickness te = 0.375 in
Nozzle ID 2*Rn = 53.25 in Factor 3.4*sqrt(R*t) = 12.4272 in
Shell area available A = 1.37 in2 Nozzle area avail. An = 2.53 in2
Pad area available Ap = 2.25 in2 Total area As=A+An+Ap = 6.16 in2
Limit (Rm*t)**0.5 = 3.6647 in Limit te+(Rnm*tn)**0.5 = 3.5459 in
Limit 16*t = 6.0 in Limit te+16*tn = 6.375 in
(Larger limit used)
Dimension a a = 1.6353 in Dimension e e = 1.4478 in
Component: Reinforcement Nozzle C
Appendix 1-7 - Large Openings in Cylindrical Shells
Paragraph 1-7(b) - All dimensions in their corroded state
M = ((Rn**3/6)+R*Rn*e)*P = 225950 lbf/in Moment of Inertia I = 22.7947
Membrane stress, Sm and Bending stress, Sb
Sm = P * (R*(Rn+tn+(Rm*t)**.5)+Rn(t+te+(Rnm*tn)**.5)) / As Sm = 9722 psi
Sb = M * a / I Sb = 16210 psi
Acceptance criteria: Sm <= S Sm + SB <= 1.5 * S
9722 psi <= 18900 psi 25932 psi <= 28350 psi

Component: Nozzle D

ASME VIII-1 2004 A06 UG-27 Thickness of Cylinders under Internal Pressure
--- Calculations --- Cylinder Internal Pressure

Material: SA-312 S30400 Grd TP304 Wld. pipe(G5)
Design pressure P = 50 psi Design temperature T = 300 F
Radiography = None Joint efficiency E = 0.85
Design stress S = 16100 psi
Inside corr.allow. cai = 0.0 in Outside corr. all. cao = 0.0 in
Material tolerance tol = 0.035 in Minimum thickness tmin = 0.1301 in
Outside diameter OD = 6.625 in Corroded radius OR = 3.3125 in
- Min. thk. not less than UG-45(a), UG-16(b), UG-45(b):

- UG-45(a) Internal pressure:
t = (P*OR / (S*E+0.4*P))+cai+cao+tol = 0.0471 in APP.1-1(A)
- UG-45(a) external pressure+cai+cao+tol t = 0.057 in
- UG-16(b) minimum thickness+cai+cao+tol t = 0.1287 in
UG-45(b) Smaller of: t = 0.1301 in
UG-45(b) (4) std pipe*0.875+cai+cao+tol = 0.28 in
- UG-45(b) Greater of: t = 0.1301 in
- UG-45(b) (1)+cai+cao+tol = 0.1301 in
- UG-45(b) (2)+cai+cao+tol = 0.0636 in

Minimum thickness: tmin = 0.1301 in
Nominal thickness: tnom = 0.28 in

ASME Section VIII-1 2004 A06 UG-28 Thickness of Shells under Ext. Pressure
--- Calculations --- Cylinder External Pressure

Material: SA-312 S30400 Grd TP304 Wld. pipe(G5)
Design pressure PE = 15 psi Design temperature T = 300 F
Inside corr. allow. CAI = 0 in Corrosion allow. CAO = 0 in
Radiography = None Material tol. Tol = 0 in
Cyl. outside dia. Do = 6.625 in Cylinder length EP L = 6 in
Nominal thickness tnom = 0.28 in (tnom-CAI-CAO-Tol) t = 0.245 in
L/Do ratio Ldo = 0.9057 Do/t Dot = 27.0408
(2*S) or (0.9*yield) SE = - Mod. of elasticity ME = 27000000 psi
A factor SII-D-FigG A = 0.01118 B factor HA-1 B = 11810
Max allowed external pressure: Pa = 4*B / (3*Dot) = 582.33 psi
Actual external design pressure: PE = 15 psi
(Required cyl. tks. for nozzle attachments at PE, tre = 0.022 in)

Component: Reinforcement Nozzle D
ASME Section VIII-1 2004 A06 UG-37 Reinforcement Required for Openings in Shells and Formed Heads

--- Design Conditions:

Int. design pressure	PI = 50 psi	Ext. design press.	PE = 15 psi
Design temperature	T = 300 F	Fig.UW-16.1 Sketch	(q)
Vessel material:	SA-240 S30400 Grd 304	Plate	(G5)
Inside corr. allow.	CAI = 0.0 in	Outside corr.allow.	CAO = 0.0 in
Vessel design stress	Sv = 18900 psi	Joint efficiency	E = 1
Vessel outside dia	Do = 72.0 in	Corroded radius	OR = 36.0 in
Nominal thickness	tnom = 0.3125 in	Reinforcement limit	lp = 6.065 in
Req. tks. int.pres.	tr = 0.0951 in	Req. tks.ext.pres.	tre = 0.161 in
Corroded thickness	t = 0.3125 in	Reinf. efficiency	E1 = 1.0
Attachment Material:	SA-312 S30400 Grd TP304	Wld. pipe	(G5)
Inside corr. allow.	CAI = 0.0 in	Outside corr.allow.	CAO = 0.0 in
Nozzle design stress	Sn = 16100 psi	Joint efficiency	E = 0.85
Nozzle outside dia.	Don = 6.625 in	Corroded radius	OR = 3.3125 in
Nominal thickness	tnom = 0.28 in	Reinforcement limit	ln = 0.7 in
Req.tks. int.pres.	trn = 0.0121 in	Req.tks.ext.pres.	trne = 0.022 in
Corroded thickness	tn = 0.28 in	Nozzle Projection	h = 0.0 in
Reinforcement element material:			
Limit of reinf.	Dp = 0.0 in	Nominal thickness	te = 0.0 in
Outside diameter	= 0.0 in	Design stress	Se = 0 psi
Minimum weld size	tmin = 0.28 in	Leg size(1/2*tmin) (Act)	= 0.0 in
1/2 * tmin (minimum)	= 0.0 in	1/2 * tmin (actual)	= 0.0 in
Weld tw (minimum)	= 0.196 in	Weld tw (actual)	= 0.0 in
Weld tc (minimum)	= 0.196 in	Weld tc (actual)	= 0.196 in
smaller 0.25 in		Leg size tw (actual)	= 0.0 in
tc of 0.7 * tmin		Leg size tc (actual)	= 0.28 in
Outward nozzle weld	L1 = 0.28 in	fr1 = Sn/Sv	= 0.8519
Outer element weld	L2 = 0.0 in	fr2 = Sn/Sv	= 0.8519
Inward nozzle weld	L3 = 0.0 in	fr3 = Sn/Sv or Se/Sv	= 0.8519
Inward nozzle weld new	= 0.0 in	fr4 = Se/Sv	= 1.0
Corroded int.proj.thk	ti = 0.0 in		

Corroded inside diameter

d = 6.065 in

Vessel wall length available for reinforcement2*Lp-d = 6.065 in

Plane correction factor (Fig.UG-37)F = 1.0

Offset distance from centerline doff = 0.0 in

Reinforcement areas (internal pressure condition) ASME 2004 UG-37

A1 = Vessel wall. Larger of:

| (2*Lp-d)*(E1*t-F*tr)-2*tn*(E1*t-F*tr)*(1-fr1)| = 1.3003 in2

| 2*(t+tn)*(E1*t-F*tr)-2*tn*(E1*t-F*tr)*(1-fr1)| = 0.2395 in2

A1 = 1.3003 in2

A2 = Nozzle wall outward | 5*(tn-trn)*fr2*t | = 0.3566 in2

Smaller of: | 5*(tn-trn)*fr2*tn | = 0.3195 in2

A2 = 0.3195 in2

A3 = Nozzle wall inward | 5*t*ti*fr2 | = 0.0 in2

Smallest of: | 5*ti*ti*fr2 | = 0.0 in2

| 2*h*ti*fr2 | = 0.0 in2

A3 = 0.0 in2

A41 = Outward nozzle weld = (L1**2)*fr3 = 0.0668 in2

A42 = Outer element weld = (L2**2)*fr4 = 0.0 in2

A43 = Inward nozzle weld = (L3**2)*fr2 = 0.0 in2

A4 = 0.0668 in2

A5 = Reinforcement pad Area = (Dp-d-2*tn)*te*fr4

A5 = 0.0 in2

Aa = Area Available = A1+A2+A3+A4+A5

Aa = 1.6866 in2

A = Area required = (d*tr*F)+2*tn*tr*F*(1-fl)

A = 0.5849 in2

ASME VIII-1 2004 A06 Reinforcement areas (external pressure) UG-37(d)

A1 = Vessel wall. Larger of:

| (2*Lp-d)*(E1*t-F*tre)-2*tn*(E1*t-F*tre)*(1-fr1)| = 0.9063 in2

| 2*(t+tn)*(E1*t-F*tre)-2*tn*(E1*t-F*tre)*(1-fr1)| = 0.167 in2

A1 = 0.9063 in2

A2 = Nozzle wall outward | 5*(tn-trne)*fr2*t | = 0.3434 in2

Smaller of: | 5*(tn-trne)*fr2*tn | = 0.3077 in2

A2 = 0.3077 in2

A3 = Nozzle wall inward | 5*t*ti*fr2 | = 0.0 in2

Smallest of: | 5*ti*ti*fr2 | = 0.0 in2

| 2*h*ti*fr2 | = 0.0 in2

A3 = 0.0 in2

A41 = Outward nozzle weld = (L1**2)*fr3 = 0.0668 in2

A42 = Outer element weld = (L2**2)*fr4 = 0.0 in2

A43 = Inward nozzle weld = (L3**2)*fr2 = 0.0 in2

A4 = 0.0668 in2

A5 = Reinforcement pad Area = (Dp-d-2*tn)*te*fr4

A5 = 0.0 in2

Aa = Area Available = A1+A2+A3+A4+A5

Aa = 1.2808 in2

A = Area required = 0.5*(d*tre*F+2*tn*tre*F*(1-fr1))

A = 0.4949 in2

Nozzle attachment weld loads - UG-41 - Strength of reinforcement

ASME - Weld strength calculations not required per UW-15(b).

Total weld load (UG-41(b)(2))

$W = (A-A1+2*tn*fr1(E1*t-F*tr))*Sv$ W = -

Weld load for strength path 1-1 (UG-41(b)(1))

$W(1-1) = (A2+A5+A41+A42)*Sv$ W(1-1) = 7301 lbf

Weld load for strength path 2-2 (UG-41(b)(1))

$W(2-2) = (A2+A3+A41+A43+2*tn*t*fr1)*Sv$ W(2-2) = 10119 lbf

Weld load for strength path 3-3 (UG-41(b)(1))

$W(3-3) = (A2+A3+A5+A41+A42+A43+2*tn*t*fr1)*Sv$ W(3-3) = -

Reinforcing element strength = $A5 * Se$ = -

Nozzle attachment weld loads - ASME 2004 UG-41 - Strength of reinforcement

Unit stresses - UW15(c) and UG-45(c)

Inner fillet weld shear = 7889 psi

Outer fillet weld shear = -

Groove weld tension = 11914 psi

Groove weld shear = 11340 psi

Nozzle wall shear = 11270 psi

Strength of connection elements

Inner fillet weld shear = 22976 lbf

Nozzle wall shear = 31435 lbf

Groove weld tension = 34698 lbf

Outer fillet weld shear = -

Possible paths of failure

1-1 31435 + 22976 = 54411 lbf

2-2 22976 + 69396 = 57674 lbf

3-3 - + - = -

Welds strong enough if path greater than the smaller of W or W(path)

Path 1-1 > W or W11

54411 lbf > 7301 lbf OK

Path 2-2 > W or W22

57674 lbf > 10119 lbf OK

Path 3-3 > W or W33

- > -

Component: Nozzle E

ASME VIII-1 2004 A06 UG-27 Thickness of Cylinders under Internal Pressure

--- Calculations --- Cylinder Internal Pressure

Material: SA-312 S30400 Grd TP304 Wld. pipe(G5)

Design pressure P = 50 psi Design temperature T = 300 F

Radiography = None Joint efficiency E = 0.85

Design stress S = 16100 psi

Inside corr.allow. cai = 0.0 in Outside corr. all. cao = 0.0 in

Material tolerance tol = 0.035 in Minimum thickness tmin = 0.1301 in

Outside diameter OD = 6.625 in Corroded radius OR = 3.3125 in

- Min. thk. not less than UG-45(a), UG-16(b), UG-45(b):

- UG-45(a) Internal pressure:

t = (P*OR / (S*E+0.4*P))+cai+cao+tol = 0.0471 in APP.1-1(A)

- UG-45(a) external pressure+cai+cao+tol t = 0.057 in

- UG-16(b) minimum thickness+cai+cao+tol t = 0.1287 in

UG-45(b) Smaller of: t = 0.1301 in

UG-45(b) (4) std pipe*0.875+cai+cao+tol = 0.28 in

- UG-45(b) Greater of: t = 0.1301 in

- UG-45(b) (1)+cai+cao+tol = 0.1301 in

- UG-45(b) (2)+cai+cao+tol = 0.0636 in

Minimum thickness: tmin = 0.1301 in

Nominal thickness: tnom = 0.28 in

ASME Section VIII-1 2004 A06 UG-28 Thickness of Shells under Ext. Pressure

--- Calculations --- Cylinder External Pressure

Material: SA-312 S30400 Grd TP304 Wld. pipe(G5)

Design pressure PE = 15 psi Design temperature T = 300 F

Inside corr. allow. CAI = 0 in Corrosion allow. CAO = 0 in

Radiography = None Material tol. Tol = 0 in

Cyl. outside dia. Do = 6.625 in Cylinder length EP L = 6 in

Nominal thickness tnom = 0.28 in (tnom-CAI-CAO-Tol) t = 0.245 in

L/Do ratio Ldo = 0.9057 Do/t Dot = 27.0408

(2*S) or (0.9*yield) SE = - Mod. of elasticity ME = 27000000 psi

A factor SII-D-FigG A = 0.01118 B factor HA-1 B = 11810

Max allowed external pressure: Pa = 4*B / (3*Dot) = 582.33 psi

Actual external design pressure: PE = 15 psi

(Required cyl. tks. for nozzle attachments at PE, tre = 0.022 in)

Component: Reinforcement Nozzle E
ASME Section VIII-1 2004 A06 UG-37 Reinforcement Required for Openings in Shells and Formed Heads

--- Design Conditions:

Int. design pressure	PI = 50 psi	Ext. design press.	PE = 15 psi
Design temperature	T = 300 F	Fig.UW-16.1 Sketch (q)	
Vessel material: SA-240 S30400 Grd 304 Plate(G5)			
Inside corr. allow.	CAI = 0.0 in	Outside corr.allow.	CAO = 0.0 in
Vessel design stress	Sv = 18900 psi	Joint efficiency	E = 1
Vessel outside dia	Do = 72.0 in	Corroded radius	OR = 36.0 in
Nominal thickness	tnom = 0.3125 in	Reinforcement limit	lp = 6.065 in
Req. tks. int.pres.	tr = 0.0951 in	Req. tks.ext.pres.	tre = 0.161 in
Corroded thickness	t = 0.3125 in	Reinf. efficiency	E1 = 1.0
Attachment Material: SA-312 S30400 Grd TP304 Wld. pipe(G5)			
Inside corr. allow.	CAI = 0.0 in	Outside corr.allow.	CAO = 0.0 in
Nozzle design stress	Sn = 16100 psi	Joint efficiency	E = 0.85
Nozzle outside dia.	Don = 6.625 in	Corroded radius	OR = 3.3125 in
Nominal thickness	tnom = 0.28 in	Reinforcement limit	ln = 0.7 in
Req.tks. int.pres.	trn = 0.0121 in	Req.tks.ext.pres.	trne = 0.022 in
Corroded thickness	tn = 0.28 in	Nozzle Projection	h = 0.0 in
Reinforcement element material:			
Limit of reinf.	Dp = 0.0 in	Nominal thickness	te = 0.0 in
Outside diameter	= 0.0 in	Design stress	Se = 0 psi
Minimum weld size	tmin = 0.28 in	Leg size(1/2*tmin) (Act)	= 0.0 in
1/2 * tmin (minimum)	= 0.0 in	1/2 * tmin (actual)	= 0.0 in
Weld tw (minimum)	= 0.196 in	Weld tw (actual)	= 0.0 in
Weld tc (minimum)	= 0.196 in	Weld tc (actual)	= 0.196 in
smaller 0.25 in		Leg size tw (actual)	= 0.0 in
tc of 0.7 * tmin		Leg size tc (actual)	= 0.28 in
Outward nozzle weld	L1 = 0.28 in	fr1 = Sn/Sv	= 0.8519
Outer element weld	L2 = 0.0 in	fr2 = Sn/Sv	= 0.8519
Inward nozzle weld	L3 = 0.0 in	fr3 = Sn/Sv or Se/Sv	= 0.8519
Inward nozzel weld new	= 0.0 in	fr4 = Se/Sv	= 1.0
Corroded int.proj.thk	ti = 0.0 in		

Corroded inside diameter **d = 6.065 in**
Vessel wall length available for reinforcement $2*lp-d = 6.065$ in
Plane correction factor (Fig.UG-37) $F = 1.0$
Offset distance from centerline $doff = 0.0$ in
Reinforcement areas (internal pressure condition) ASME 2004 UG-37
A1 = Vessel wall. Larger of:
| $(2*lp-d)*(E1*t-F*tr)-2*tn*(E1*t-F*tr)*(1-fr1)$ | = 1.3003 in2
| $2*(t+tn)*(E1*t-F*tr)-2*tn*(E1*t-F*tr)*(1-fr1)$ | = 0.2395 in2
A1 = 1.3003 in2
A2 = Nozzle wall outward | $5*(tn-trn)*fr2*t$ | = 0.3566 in2
Smaller of: | $5*(tn-trn)*fr2*tn$ | = 0.3195 in2
A2 = 0.3195 in2
A3 = Nozzle wall inward | $5*t*ti*fr2$ | = 0.0 in2
Smallest of: | $5*ti*ti*fr2$ | = 0.0 in2
| $2*h*ti*fr2$ | = 0.0 in2
A3 = 0.0 in2
A41 = Outward nozzle weld = $(L1**2)*fr3 = 0.0668$ in2
A42 = Outer element weld = $(L2**2)*fr4 = 0.0$ in2
A43 = Inward nozzle weld = $(L3**2)*fr2 = 0.0$ in2
A4 = 0.0668 in2
A5 = Reinforcement pad Area = $(Dp-d-2*tn)*te*fr4$ A5 = 0.0 in2
Aa = Area Available = $A1+A2+A3+A4+A5$ Aa = 1.6866 in2
A = Area required = $(d*tr*F)+2*tn*tr*F*(1-fl)$ A = 0.5849 in2
ASME VIII-1 2004 A06 Reinforcement areas (external pressure) UG-37(d)
A1 = Vessel wall. Larger of:
| $(2*lp-d)*(E1*t-F*tre)-2*tn*(E1*t-F*tre)*(1-fr1)$ | = 0.9063 in2
| $2*(t+tn)*(E1*t-F*tre)-2*tn*(E1*t-F*tre)*(1-fr1)$ | = 0.167 in2
A1 = 0.9063 in2
A2 = Nozzle wall outward | $5*(tn-trne)*fr2*t$ | = 0.3434 in2
Smaller of: | $5*(tn-trne)*fr2*tn$ | = 0.3077 in2
A2 = 0.3077 in2
A3 = Nozzle wall inward | $5*t*ti*fr2$ | = 0.0 in2
Smallest of: | $5*ti*ti*fr2$ | = 0.0 in2
| $2*h*ti*fr2$ | = 0.0 in2
A3 = 0.0 in2
A41 = Outward nozzle weld = $(L1**2)*fr3 = 0.0668$ in2
A42 = Outer element weld = $(L2**2)*fr4 = 0.0$ in2
A43 = Inward nozzle weld = $(L3**2)*fr2 = 0.0$ in2
A4 = 0.0668 in2
A5 = Reinforcement pad Area = $(Dp-d-2*tn)*te*fr4$ A5 = 0.0 in2
Aa = Area Available = $A1+A2+A3+A4+A5$ Aa = 1.2808 in2
A = Area required = $0.5*(d*tre*F+2*tn*tre*F*(1-fr1))$ A = 0.4949 in2

Total weld load (UG-41(b)(2))

$$W = (A - A1 + 2 * t_n * f_{r1} (E1 * t - F * t_r)) * S_v$$

$$W = -$$

Weld load for strength path 1-1 (UG-41(b) (1))

$$W(1-1) = (A2+A5+A41+A42) * Sv$$

W(1-1) = 7301 lbf

Weld load for strength path 2-2 (UG-41(b) (1))

$$W(2-2) = (A2+A3+A41+A43+2*tn*t*fr1)*Sv$$

W(2-2) = 10119 lbf

Weld load for strength path 3-3 (UG-41(b) (1))

$$W(3-3) = (A2+A3+A5+A41+A42+A43+2*tn*t*fr1)*Sv$$

$$W(3-3) = -$$

Reinforcing element strength = $A_5 * S_e$

— — — — —

Nozzle attachment weld loads - ASME 2004 UG-41 - Strength of reinforcement

Unit stresses - UW15(c) and UG-45(c)

Inner fillet weld shear = 7889 psi

Outer fillet weld shear = -

Groove weld tension = 11914 psi

Groove weld shear = 11340 psi

Nozzle wall shear = 11270 psi

Strength of connection elements

Inner fillet weld shear = 22976 lbf

Nozzle wall shear = 31435 lbf

Groove weld tension = 34698 lbf

Outer fillet weld shear = -

Possible paths of failure

1-1 31435 + 22976 = 54411 lbf

$$2-2 \quad 22976 + 69396 = 57674 \text{ lbf}$$

$$3-3 \quad - \quad + \quad - \quad = \quad -$$

Welds strong enough if path greater than the smaller of W or W(path)

Path 1-1 > W or W11

54411 lbf > 7301 lbf

OK

Path 2-2 > W or W22

57674 lbf > 10119 lbf

OK

Path 3-3 > W or W33


Component: Nozzle G

ASME VIII-1 2004 A06 UG-27 Thickness of Cylinders under Internal Pressure

--- Calculations --- Cylinder Internal Pressure

Material: SA-312 S30400 Grd TP304 Wld. pipe(G5)

Design pressure P = 50 psi Design temperature T = 300 F

Radiography = None Joint efficiency E = 0.85

Design stress S = 16100 psi

Inside corr.allow. cai = 0.0 in Outside corr. all. cao = 0.0 in

Material tolerance tol = 0.0421 in Minimum thickness tmin = 0.1373 in

Outside diameter OD = 4.0 in Corroded radius OR = 2.0 in

- Min. thk. not less than UG-45(a), UG-16(b), UG-45(b):

- UG-45(a) Internal pressure:

t = (P*OR / (S*E+0.4*P))+cai+cao+tol = 0.0494 in APP.1-1(A)

- UG-45(a) external pressure+cai+cao+tol t = 0.058 in

- UG-16(b) minimum thickness+cai+cao+tol t = 0.1359 in

UG-45(b) Smaller of: t = 0.1373 in

UG-45(b) (4) std pipe*0.875+cai+cao+tol = 0.2399 in

- UG-45(b) Greater of: t = 0.1373 in

- UG-45(b) (1)+cai+cao+tol = 0.1373 in

- UG-45(b) (2)+cai+cao+tol = 0.0707 in

Minimum thickness: tmin = 0.1373 in

Nominal thickness: tnom = 0.337 in

ASME Section VIII-1 2004 A06 UG-28 Thickness of Shells under Ext. Pressure

--- Calculations --- Cylinder External Pressure

Material: SA-312 S30400 Grd TP304 Wld. pipe(G5)

Design pressure PE = 15 psi Design temperature T = 300 F

Inside corr. allow. CAI = 0 in Corrosion allow. CAO = 0 in

Radiography = None Material tol. Tol = 0 in

Cyl. outside dia. Do = 4 in Cylinder length EP L = 6 in

Nominal thickness tnom = 0.337 in (tnom-CAI-CAO-Tol) t = 0.2949 in

L/Do ratio Ldo = 1.5 Do/t Dot = 13.5651

(2*S) or (0.9*yield) SE = - Mod. of elasticity ME = 27000000 psi

A factor SII-D-FigG A = 0.018993 B factor HA-1 B = 12181

Max allowed external pressure: Pa = 4*B / (3*Dot) = 1197.31 psi

Actual external design pressure: PE = 15 psi

(Required cyl. tks. for nozzle attachments at PE, tre = 0.0159 in)

Component: Reinforcement Nozzle G

ASME Section VIII-1 2004 A06 UG-37 Reinforcement Required for Openings in Shells and Formed Heads

--- Design Conditions:

Int. design pressure	PI = 50 psi	Ext. design press.	PE = 15 psi
Design temperature	T = 300 F	Fig.UW-16.1 Sketch	(e)
Vessel material:	SA-240 S30400 Grd 304	Plate	(G5)
Inside corr. allow.	CAI = 0.0 in	Outside corr.allow.	CAO = 0.0 in
Vessel design stress	Sv = 18900 psi	Joint efficiency	E = 1
Vessel outside dia	Do = 72.0 in	Corroded radius	OR = 36.0 in
Nominal thickness	tnom = 0.375 in	Reinforcement limit	lp = 3.326 in
Req. tks. int.pres.	tr = 0.0951 in	Req. tks.ext.pres.	tre = 0.303 in
Corroded thickness	t = 0.375 in	Reinf. efficiency	E1 = 1.0
Attachment Material:	SA-312 S30400 Grd	TP304 Wld. pipe	(G5)
Inside corr. allow.	CAI = 0.0 in	Outside corr.allow.	CAO = 0.0 in
Nozzle design stress	Sn = 16100 psi	Joint efficiency	E = 0.85
Nozzle outside dia.	Don = 4.0 in	Corroded radius	OR = 2.0 in
Nominal thickness	tnom = 0.337 in	Reinforcement limit	ln = 0.8425 in
Req.tks. int.pres.	trn = 0.0073 in	Req.tks.ext.pres.	trne = 0.0159 in
Corroded thickness	tn = 0.337 in	Nozzle Projection	h = 0.0 in
Reinforcement element material:			
Limit of reinf.	Dp = 0.0 in	Nominal thickness	te = 0.0 in
Outside diameter	= 0.0 in	Design stress	Se = 0 psi
Minimum weld size	tmin = 0.337 in	Leg size(1/2*tmin) (Act)	= 0.0 in
1/2 * tmin (minimum)	= 0.0 in	1/2 * tmin (actual)	= 0.0 in
Weld tw (minimum)	= 0.2359 in	Weld tw (actual)	= 0.0 in
Weld tc (minimum)	= 0.2359 in	Weld tc (actual)	= 0.2359 in
smaller 0.25 in		Leg size tw (actual)	= 0.0 in
tc of 0.7 * tmin		Leg size tc (actual)	= 0.337 in
Outward nozzle weld	L1 = 0.337 in	fr1 = Sn/Sv	= 0.8519
Outer element weld	L2 = 0.0 in	fr2 = Sn/Sv	= 0.8519
Inward nozzle weld	L3 = 0.0 in	fr3 = Sn/Sv or Se/Sv	= 0.8519
Inward nozzel weld new	= 0.0 in	fr4 = Se/Sv	= 1.0
Corroded int.proj.thk	ti = 0.0 in		

Corroded inside diameter d = 3.326 in
Vessel wall length available for reinforcement $2 * Lp - d = 3.326 \text{ in}$
Plane correction factor (Fig.UG-37) $F = 1.0$
Offset distance from centerline $doff = 0.0 \text{ in}$
Reinforcement areas (internal pressure condition) ASME 2004 UG-37
A1 = Vessel wall. Larger of:
 $| (2 * Lp - d) * (E1 * t - F * tr) - 2 * tn * (E1 * t - F * tr) * (1 - fr1) | = 0.9029 \text{ in}^2$
 $| 2 * (t + tn) * (E1 * t - F * tr) - 2 * tn * (E1 * t - F * tr) * (1 - fr1) | = 0.3706 \text{ in}^2$
A1 = 0.9029 in2
A2 = Nozzle wall outward $| 5 * (tn - trn) * fr2 * t | = 0.5266 \text{ in}^2$
Smaller of: $| 5 * (tn - trn) * fr2 * tn | = 0.4732 \text{ in}^2$
A2 = 0.4732 in2
A3 = Nozzle wall inward $| 5 * t * ti * fr2 | = 0.0 \text{ in}^2$
Smallest of: $| 5 * ti * ti * fr2 | = 0.0 \text{ in}^2$
 $| 2 * h * ti * fr2 | = 0.0 \text{ in}^2$
A3 = 0.0 in2
A41 = Outward nozzle weld $= (L1 ** 2) * fr3 = 0.0967 \text{ in}^2$
A42 = Outer element weld $= (L2 ** 2) * fr4 = 0.0 \text{ in}^2$
A43 = Inward nozzle weld $= (L3 ** 2) * fr2 = 0.0 \text{ in}^2$
A4 = 0.0967 in2
A5 = Reinforcement pad Area $= (Dp - d - 2 * tn) * te * fr4$
A5 = 0.0 in2
Aa = Area Available $= A1 + A2 + A3 + A4 + A5$
Aa = 1.4729 in2
A = Area required $= (d * tr * F) + 2 * tn * tr * F * (1 - fl)$
A = 0.3259 in2
Per UG-36(c) (3) (a), this opening does NOT required additional reinforcement
other than the inherent in the construction.
ASME VIII-1 2004 A06 Reinforcement areas (external pressure) UG-37(d)
A1 = Vessel wall. Larger of:
 $| (2 * Lp - d) * (E1 * t - F * tre) - 2 * tn * (E1 * t - F * tre) * (1 - fr1) | = 0.2323 \text{ in}^2$
 $| 2 * (t + tn) * (E1 * t - F * tre) - 2 * tn * (E1 * t - F * tre) * (1 - fr1) | = 0.0953 \text{ in}^2$
A1 = 0.2323 in2
A2 = Nozzle wall outward $| 5 * (tn - trne) * fr2 * t | = 0.5129 \text{ in}^2$
Smaller of: $| 5 * (tn - trne) * fr2 * tn | = 0.4609 \text{ in}^2$
A2 = 0.4609 in2
A3 = Nozzle wall inward $| 5 * t * ti * fr2 | = 0.0 \text{ in}^2$
Smallest of: $| 5 * ti * ti * fr2 | = 0.0 \text{ in}^2$
 $| 2 * h * ti * fr2 | = 0.0 \text{ in}^2$
A3 = 0.0 in2
A41 = Outward nozzle weld $= (L1 ** 2) * fr3 = 0.0967 \text{ in}^2$
A42 = Outer element weld $= (L2 ** 2) * fr4 = 0.0 \text{ in}^2$
A43 = Inward nozzle weld $= (L3 ** 2) * fr2 = 0.0 \text{ in}^2$
A4 = 0.0967 in2
A5 = Reinforcement pad Area $= (Dp - d - 2 * tn) * te * fr4$
A5 = 0.0 in2
Aa = Area Available $= A1 + A2 + A3 + A4 + A5$
Aa = 0.79 in2
A = Area required $= 0.5 * (d * tre * F + 2 * tn * tre * F * (1 - fr1))$
A = 0.519 in2








Component: Nozzle H

ASME VIII-1 2004 A06 UG-27 Thickness of Cylinders under Internal Pressure

--- Calculations --- Cylinder Internal Pressure

Material: SA-312 S30400 Grd TP304 Wld. pipe(G5)

Design pressure P = 50 psi Design temperature T = 300 F

Radiography = None Joint efficiency E = 0.85

Design stress S = 16100 psi

Inside corr.allow. cai = 0.0 in Outside cori. all. cao = 0.0 in

Material tolerance tol = 0.0375 in Minimum thickness tmin = 0.2265 in

Outside diameter OD = 3.5 in Corroded radius OR = 1.75 in

- Min. thk. not less than UG-45(a), UG-16(b), UG-45(b):

- UG-45(a) Internal pressure:

$$t = (P \cdot OR / (S \cdot E + 0.4 \cdot P)) + cai + cao + tol = 0.0439 \text{ in} \quad \text{APP.1-1(A)}$$

- UG-45(a) external pressure+cai+cao+tol t = 0.053 in

- UG-16(b) minimum thickness+cai+cao+tol t = 0.1312 in

UG-45(b) Smaller of: t = 0.2265 in

UG-45(b) (4) std pipe*0.875+cai+cao+tol = 0.2265 in

- UG-45(b) Greater of: t = 2.4676 in

- UG-45(b) (1)+cai+cao+tol = 2.4676 in

- UG-45(b) (2)+cai+cao+tol = 1.0375 in

Minimum thickness: tmin = 0.2265 in

Nominal thickness: tnom = 0.3 in

ASME Section VIII-1 2004 A06 UG-28 Thickness of Shells under Ext. Pressure

--- Calculations --- Cylinder External Pressure

Material: SA-312 S30400 Grd TP304 Wld. pipe(G5)

Design pressure PE = 15 psi Design temperature T = 300 F

Inside corr. allow. CAI = 0 in Corrosion allow. CAO = 0 in

Radiography = None Material tol. Tol = 0 in

Cyl. outside dia. Do = 3.5 in Cylinder length EP L = 6 in

Nominal thickness tnom = 0.3 in (tnom-CAI-CAO-Tol) t = 0.2625 in

L/Do ratio Ldo = 1.7143 Do/t Dot = 13.3333

(2*S) or (0.9*yield) SE = - Mod. of elasticity ME = 27000000 psi

A factor SII-D-FigG A = 0.016749 B factor HA-1 B = 12092

Max allowed external pressure: Pa = 4*B / (3*Dot) = 1209.21 psi

Actual external design pressure: PE = 15 psi

(Required cyl. tks. for nozzle attachments at PE, tre = 0.0155 in)

Component: Reinforcement Nozzle H
ASME Section VIII-1 2004 A06 UG-37 Reinforcement Required for Openings in Shells and Formed Heads

--- Design Conditions:

Int. design pressure PI = 50 psi	Ext. design press. PE = 0 psi
Design temperature T = 300 F	Fig.UW-16.1 Sketch (q)
Vessel material: SA-516 K02700 Grd 70 Plate	
Inside corr. allow. CAI = 0.0 in	Outside corr.allow.CAO = 0.0 in
Vessel design stress Sv = 20000 psi	Joint efficiency E = 1
Vessel outside dia Do = 75.625 in	Corroded radius IR = 35.625 in
Nominal thickness tnom = 2.8125 in	Reinforcement limit lp = 4.5625 in
Req. tks. int.pres. tr = 2.4301 in	Req. tks.ext.pres. tre = 0.0 in
Corroded thickness t = 2.8125 in	Reinf. efficiency E1 = 1.0
Attachment Material: SA-312 S30400 Grd TP304 Wld. pipe(G5)	
Inside corr. allow. CAI = 0.0 in	Outside corr.allow.CAO = 0.0 in
Nozzle design stress Sn = 16100 psi	Joint efficiency E = 0.85
Nozzle outside dia. Don = 3.5 in	Corroded radius OR = 1.75 in
Nominal thickness tnom = 0.3 in	Reinforcement limit ln = 0.9375 in
Req.tks. int.pres. trn = 0.0064 in	Req.tks.ext.pres. trne = 0.0155 in
Corroded thickness tn = 0.3 in	Nozzle Projection h = 0.0 in
Reinforcement element material: SA-516 K02700 Grd 70 Plate	
Limit of reinf. Dp = 8.0 in	Nominal thickness te = 0.1875 in
Outside diameter = 8.0 in	Design stress Se = 20000 psi
Minimum weld size tmin = 0.1875 in	Leg size(1/2*tmin) (Act)= 0.1464 in
1/2 * tmin (minimum) = 0.0938 in	1/2 * tmin (actual) = 0.1024 in
Weld tw (minimum) = 0.1312 in	Weld tw (actual) = 0.1875 in
Weld tc (minimum) = 0.21 in	Weld tc (actual) = 0.21 in
smaller 0.25 in	Leg size tw (actual) = 0.1875 in
tc of 0.7 * tmin	Leg size tc (actual) = 0.3 in
Outward nozzle weld L1 = 0.1875 in	fr1 = Sn/Sv = 0.805
Outer element weld L2 = 0.1464 in	fr2 = Sn/Sv = 0.805
Inward nozzle weld L3 = 0.0 in	fr3 = Sn/Sv or Se/Sv = 0.805
Inward nozzel weld new = 0.0 in	fr4 = Se/Sv = 1.0
Corroded int.proj.thk ti = 0.0 in	

Corroded inside diameter

d = 2.9 in

Vessel wall length available for reinforcement2*Lp-d = 4.5625 in

Plane correction factor (Fig.UG-37)F = 1.0

Offset distance from centerline doff = 0.0 in

Reinforcement areas (internal pressure condition) ASME 2004 UG-37

A1 = Vessel wall. Larger of:

| (2*Lp-d)*(E1*t-F*tr)-2*tn*(E1*t-F*tr)*(1-fr1)| = 1.7001 in2

| 2*(t+tn)*(E1*t-F*tr)-2*tn*(E1*t-F*tr)*(1-fr1)| = 2.3359 in2

A1 = 2.3359 in2

A2 = Nozzle wall outward | 5*(tn-trn)*fr2*t | = 3.3238 in2

Smaller of: | 2*(tn-trn)*(2.5*tn+te)*fr2 | = 0.4432 in2

A2 = 0.4432 in2

A3 = Nozzle wall inward | 5*t*ti*fr2 | = 0.0 in2

Smallest of: | 5*ti*ti*fr2 | = 0.0 in2

| 2*h*ti*fr2 | = 0.0 in2

A3 = 0.0 in2

A41 = Outward nozzle weld = (L1**2)*fr3 = 0.0283 in2

A42 = Outer element weld = (L2**2)*fr4 = 0.0214 in2

A43 = Inward nozzle weld = (L3**2)*fr2 = 0.0 in2

A4 = 0.0497 in2

A5 = Reinforcement pad Area = (Dp-d-2*tn)*te*fr4

A5 = 0.8438 in2

Aa = Area Available = A1+A2+A3+A4+A5

Aa = 3.6726 in2

A = Area required = 0.5*d*t + t*tn*(1-f1)

A = 3.6657 in2

Nozzle attachment weld loads - UG-41 - Strength of reinforcement

Total weld load (UG-41(b)(2))
W = (A-A1+2*tn*fr1(E1*t-F*tr))*Sv W = 30291 lbf
Weld load for strength path 1-1 (UG-41(b)(1))
W(1-1) = (A2+A5+A41+A42)*Sv W(1-1) = 26733 lbf
Weld load for strength path 2-2 (UG-41(b)(1))
W(2-2) = (A2+A3+A41+A43+2*tn*t*fr1)*Sv W(2-2) = 36598 lbf
Weld load for strength path 3-3 (UG-41(b)(1))
W(3-3) = (A2+A3+A5+A41+A42+2*tn*t*fr1)*Sv W(3-3) = 53902 lbf
Reinforcing element strength = A5 * Se = 16875 lbf
Nozzle attachment weld loads - ASME 2004 UG-41 - Strength of reinforcement
Unit stresses - UW15(c) and UG-45(c)
Inner fillet weld shear = 7889 psi
Outer fillet weld shear = 9800 psi
Groove weld tension = 11914 psi
Groove weld shear = 9660 psi
Nozzle wall shear = 11270 psi
Strength of connection elements
Inner fillet weld shear = 8129 lbf
Nozzle wall shear = 16987 lbf
Groove weld tension = 12276 lbf
Outer fillet weld shear = 18015 lbf
Possible paths of failure
1-1 16987 + 18015 = 35002 lbf
2-2 8129 + 24552 = 32681 lbf
3-3 12276 + 18015 = 30291 lbf
Welds strong enough if path greater than the smaller of W or W(path)
Path 1-1 > W or W11
35002 lbf > 26733 lbf OK
Path 2-2 > W or W22
32681 lbf > 30291 lbf OK
Path 3-3 > W or W33
30291 lbf > 30291 lbf OK

Component: Nozzle J

ASME VIII-1 2004 A06 UG-27 Thickness of Cylinders under Internal Pressure

--- Calculations --- Cylinder Internal Pressure

Material: SA-53 K03005 Grd E/B Wld. pipe

Design pressure P = 150 psi Design temperature T = 200 F

Radiography = None Joint efficiency E = 0.85

Design stress S = 14600 psi

Inside corr.allow. cai = 0.0625 in Outside corr. all. cao = 0.0 in

Material tolerance tol = 0.043 in Minimum thickness tmin = 0.2403 in

Outside diameter OD = 2.375 in Corroded radius OR = 1.1875 in

- Min. thk. not less than UG-45(a), UG-16(b), UG-45(b):

- UG-45(a) Internal pressure:

$$t = (P \cdot OR / (S \cdot E + 0.4 \cdot P)) + cai + cao + tol = 0.1198 \text{ in} \quad \text{APP.1-1(A)}$$

- UG-45(a) external pressure+cai+cao+tol t = 0.117 in

- UG-16(b) minimum thickness+cai+cao+tol t = 0.1992 in

UG-45(b) Smaller of: t = 0.2403 in

UG-45(b) (4) std pipe*0.875+cai+cao+tol = 0.2403 in

- UG-45(b) Greater of: t = 1.043 in

- UG-45(b) (1)+cai+cao+tol = 0.4401 in

- UG-45(b) (2)+cai+cao+tol = 1.043 in

Minimum thickness: tmin = 0.2403 in

Nominal thickness: tnom = 0.344 in

ASME Section VIII-1 2004 A06 UG-28 Thickness of Shells under Ext. Pressure

--- Calculations --- Cylinder External Pressure

Material: SA-53 K03005 Grd E/B Wld. pipe

Design pressure PE = 15 psi Design temperature T = 200 F

Inside corr. allow. CAI = 0.0625 in Corrosion allow. CAO = 0 in

Radiography = None Material tol. Tol = 0 in

Cyl. outside dia. Do = 2.375 in Cylinder length EP L = 6 in

Nominal thickness tnom = 0.344 in (tnom-CAI-CAO-Tol) t = 0.2385 in

L/Do ratio Ldo = 2.5263 Do/t Dot = 9.9581

(2*S) or (0.9*yield) SE = 31680 psi Mod. of elasticity ME = 28600000 psi

A factor SII-D-FigG A = 0.016022 B factor CS-2 B = 17489

Max allowed external pressure: Pa = B*((2.167/Dot)-0.0833) = 2348.92 psi

Actual external design pressure: PE = 15 psi

(Required cyl. tks. for nozzle attachments at PE, tre = 0.0115 in)

Component: Reinforcement Nozzle J
ASME Section VIII-1 2004 A06 UG-37 Reinforcement Required for Openings in Shells and Formed Heads

--- Design Conditions:

Int. design pressure PI = 150 psi	Ext. design press. PE = 15 psi
Design temperature T = 200 F	Fig.UW-16.1 Sketch (e)
Vessel material: SA-516 K02700 Grd 70 Plate	
Inside corr. allow. CAI = 0.0625 in	Outside corr.allow.CAO = 0.0 in
Vessel design stress Sv = 20000 psi	Joint efficiency E = 1
Vessel outside dia Do = 89.5 in	Corroded radius OR = 44.75 in
Nominal thickness tnom = 0.75 in	Reinforcement limit lp = 1.875 in
Req. tks. int.pres. tr = 0.3346 in	Req. tks.ext.pres. tre = 0.2185 in
Corroded thickness t = 0.6875 in	Reinf. efficiency El = 1.0
Attachment Material: SA-53 K03005 Grd E/B Wld. pipe	
Inside corr. allow. CAI = 0.0625 in	Outside corr.allow.CAO = 0.0 in
Nozzle design stress Sn = 14600 psi	Joint efficiency E = 0.85
Nozzle outside dia. Don = 2.375 in	Corroded radius OR = 1.1875 in
Nominal thickness tnom = 0.344 in	Reinforcement limit ln = 0.7038 in
Req.tks. int.pres. trn = 0.0143 in	Req.tks.ext.pres. trne = 0.0115 in
Corroded thickness tn = 0.2815 in	Nozzle Projection h = 0.0 in
Reinforcement element material:	
Limit of reinf. Dp = 0.0 in	Nominal thickness te = 0.0 in
Outside diameter = 0.0 in	Design stress Se = 0 psi
Minimum weld size tmin = 0.2815 in	Leg size(1/2*tmin) (Act)= 0.0 in
1/2 * tmin (minimum) = 0.0 in	1/2 * tmin (actual) = 0.0 in
Weld tw (minimum) = 0.1971 in	Weld tw (actual) = 0.0 in
Weld tc (minimum) = 0.1971 in	Weld tc (actual) = 0.1971 in
smaller 0.25 in	Leg size tw (actual) = 0.0 in
tc of 0.7 * tmin	Leg size tc (actual) = 0.2815 in
Outward nozzle weld L1 = 0.2815 in	fr1 = Sn/Sv = 0.73
Outer element weld L2 = 0.0 in	fr2 = Sn/Sv = 0.73
Inward nozzle weld L3 = 0.0 in	fr3 = Sn/Sv or Se/Sv = 0.73
Inward nozzel weld new = 0.0 in	fr4 = Se/Sv = 1.0
Corroded int.proj.thk ti = 0.0 in	

Corroded inside diameter

d = 1.812 in

Vessel wall length available for reinforcement 2*Lp-d = 1.875 in

Plane correction factor (Fig.UG-37) F = 1.0

Offset distance from centerline doff = 0.0 in

Reinforcement areas (internal pressure condition) ASME 2004 UG-37

A1 = Vessel wall. Larger of:

| (2*Lp-d)*(E1*t-F*tr)-2*tn*(E1*t-F*tr)*(1-fr1)| = 0.608 in2

| 2*(t+tn)*(E1*t-F*tr)-2*tn*(E1*t-F*tr)*(1-fr1)| = 0.6302 in2

A1 = 0.6302 in2

A2 = Nozzle wall outward | 5*(tn-trn)*fr2*t | = 0.6705 in2

Smaller of: | 5*(tn-trn)*fr2*tn | = 0.2746 in2

A2 = 0.2746 in2

A3 = Nozzle wall inward | 5*t*ti*fr2 | = 0.0 in2

Smallest of: | 5*ti*ti*fr2 | = 0.0 in2

| 2*h*ti*fr2 | = 0.0 in2

A3 = 0.0 in2

A41 = Outward nozzle weld = (L1**2)*fr3 = 0.0578 in2

A42 = Outer element weld = (L2**2)*fr4 = 0.0 in2

A43 = Inward nozzle weld = (L3**2)*fr2 = 0.0 in2

A4 = 0.0578 in2

A5 = Reinforcement pad Area = (Dp-d-2*tn)*te*fr4

Aa = Area Available = A1+A2+A3+A4+A5

A = Area required = (d*tr*F)+2*tn*tr*F*(1-fl)

A = 0.6572 in2

Per UG-36(c) (3) (a), this opening does NOT required additional reinforcement other than the inherent in the construction.

ASME VIII-1 2004 A06 Reinforcement areas (external pressure) UG-37(d)

A1 = Vessel wall. Larger of:

| (2*Lp-d)*(E1*t-F*tre)-2*tn*(E1*t-F*tre)*(1-fr1)| = 0.8081 in2

| 2*(t+tn)*(E1*t-F*tre)-2*tn*(E1*t-F*tre)*(1-fr1)| = 0.8376 in2

A1 = 0.8376 in2

A2 = Nozzle wall outward | 5*(tn-trne)*fr2*t | = 0.6775 in2

Smaller of: | 5*(tn-trne)*fr2*tn | = 0.2774 in2

A2 = 0.2774 in2

A3 = Nozzle wall inward | 5*t*ti*fr2 | = 0.0 in2

Smallest of: | 5*ti*ti*fr2 | = 0.0 in2

| 2*h*ti*fr2 | = 0.0 in2

A3 = 0.0 in2

A41 = Outward nozzle weld = (L1**2)*fr3 = 0.0578 in2

A42 = Outer element weld = (L2**2)*fr4 = 0.0 in2

A43 = Inward nozzle weld = (L3**2)*fr2 = 0.0 in2

A4 = 0.0578 in2

A5 = Reinforcement pad Area = (Dp-d-2*tn)*te*fr4

Aa = Area Available = A1+A2+A3+A4+A5

A = Area required = 0.5*(d*tre*F+2*tn*tre*F*(1-fr1))

A = 0.2146 in2

Nozzle attachment weld loads - UG-41 - Strength of reinforcement

ASME - Weld strength calculations not required per UW-15(b).

Total weld load (UG-41(b)(2))
W = (A-A1+2*tn*frl(E1*t-F*tr))*Sv W = 3440 lbf

Weld load for strength path 1-1 (UG-41(b)(1))
W(1-1) = (A2+A5+A41+A42)*Sv W(1-1) = 6648 lbf

Weld load for strength path 2-2 (UG-41(b)(1))
W(2-2) = (A2+A3+A41+A43+2*tn*t*frl)*Sv W(2-2) = 12299 lbf

Weld load for strength path 3-3 (UG-41(b)(1))
W(3-3) = (A2+A3+A5+A41+A42+A43+2*tn*t*frl)*Sv W(3-3) = -

Reinforcing element strength = A5 * Se = -

Nozzle attachment weld loads - ASME 2004 UG-41 - Strength of reinforcement

Unit stresses - UW15(c) and UG-45(c)

Inner fillet weld shear	=	7154 psi
Outer fillet weld shear	=	-
Groove weld tension	=	10804 psi
Groove weld shear	=	9660 psi
Nozzle wall shear	=	10220 psi

Strength of connection elements

Inner fillet weld shear	=	7510 lbf
Nozzle wall shear	=	9456 lbf
Groove weld tension	=	11341 lbf
Outer fillet weld shear	=	-

Possible paths of failure

1-1	9456 + 7510	=	16966 lbf
2-2	7510 + 11341	=	18851 lbf
3-3	- + -	=	-

Welds strong enough if path greater than the smaller of W or W(path)

Path 1-1 > W or W11	
16966 lbf > 3440 lbf	OK
Path 2-2 > W or W22	
18851 lbf > 3440 lbf	OK
Path 3-3 > W or W33	
- > -	

Component: Nozzle K

ASME VIII-1 2004 A06 UG-27 Thickness of Cylinders under Internal Pressure

--- Calculations --- Cylinder Internal Pressure

Material: SA-53 K03005 Grd E/B Wld. pipe

Design pressure P = 150 psi Design temperature T = 200 F

Radiography = None Joint efficiency E = 0.85

Design stress S = 14600 psi

Inside corr.allow. cai = 0.0625 in Outside corr. all. cao = 0.0 in

Material tolerance tol = 0.043 in Minimum thickness tmin = 0.2403 in

Outside diameter OD = 2.375 in Corroded radius OR = 1.1875 in

- Min. thk. not less than UG-45(a), UG-16(b), UG-45(b):

- UG-45(a) Internal pressure:

$$t = (P \cdot OR / (S \cdot E + 0.4 \cdot P)) + cai + cao + tol = 0.1198 \text{ in} \quad \text{APP.1-1(A)}$$

- UG-45(a) external pressure+cai+cao+tol t = 0.117 in

- UG-16(b) minimum thickness+cai+cao+tol t = 0.1992 in

UG-45(b) Smaller of: t = 0.2403 in

UG-45(b) (4) std pipe*0.875+cai+cao+tol = 0.2403 in

- UG-45(b) Greater of: t = 1.043 in

- UG-45(b) (1)+cai+cao+tol = 0.4401 in

- UG-45(b) (2)+cai+cao+tol = 1.043 in

Minimum thickness: tmin = 0.2403 in

Nominal thickness: tnom = 0.344 in

ASME Section VIII-1 2004 A06 UG-28 Thickness of Shells under Ext. Pressure

--- Calculations --- Cylinder External Pressure

Material: SA-53 K03005 Grd E/B Wld. pipe

Design pressure PE = 15 psi Design temperature T = 200 F

Inside corr. allow. CAI = 0.0625 in Corrosion allow. CAO = 0 in

Radiography = None Material tol. Tol = 0 in

Cyl. outside dia. Do = 2.375 in Cylinder length EP L = 6 in

Nominal thickness tnom = 0.344 in (tnom-CAI-CAO-Tol) t = 0.2385 in

L/Do ratio Ldo = 2.5263 Do/t Dot = 9.9581

(2*S) or (0.9*yield) SE = 31680 psi Mod. of elasticity ME = 28600000 psi

A factor SII-D-FigG A = 0.016022 B factor CS-2 B = 17489

Max allowed external pressure: Pa = B*((2.167/Dot)-0.0833) = 2348.92 psi

Actual external design pressure: PE = 15 psi

(Required cyl. tks. for nozzle attachments at PE, tre = 0.0115 in)

Component: Reinforcement Nozzle K

ASME Section VIII-1 2004 A06 UG-37 Reinforcement Required for Openings in Shells and Formed Heads

--- Design Conditions:

Int. design pressure	PI = 150 psi	Ext. design press.	PE = 15 psi
Design temperature	T = 200 F	Fig.UW-16.1 Sketch (e)	
Vessel material:	SA-516 K02700 Grd 70 Plate		
Inside corr. allow.	CAI = 0.0625 in	Outside corr.allow.	CAO = 0.0 in
Vessel design stress	Sv = 20000 psi	Joint efficiency	E = 1
Vessel outside dia	Do = 89.5 in	Corroded radius	OR = 44.75 in
Nominal thickness	tnom = 0.75 in	Reinforcement limit	lp = 1.875 in
Req. tks. int.pres.	tr = 0.3346 in	Req. tks.ext.pres.	tre = 0.2185 in
Corroded thickness	t = 0.6875 in	Reinf. efficiency	E1 = 1.0
Attachment Material:	SA-53 K03005 Grd E/B Wld. pipe		
Inside corr. allow.	CAI = 0.0625 in	Outside corr.allow.	CAO = 0.0 in
Nozzle design stress	Sn = 14600 psi	Joint efficiency	E = 0.85
Nozzle outside dia.	Don = 2.375 in	Corroded radius	OR = 1.1875 in
Nominal thickness	tnom = 0.344 in	Reinforcement limit	ln = 0.7038 in
Req.tks. int.pres.	trn = 0.0143 in	Req.tks.ext.pres.	trne = 0.0115 in
Corroded thickness	tn = 0.2815 in	Nozzle Projection	h = 0.0 in
Reinforcement element material:			
Limit of reinf.	Dp = 0.0 in	Nominal thickness	te = 0.0 in
Outside diameter	= 0.0 in	Design stress	Se = 0 psi
Minimum weld size	tmin = 0.2815 in	Leg size(1/2*tmin) (Act)	= 0.0 in
1/2 * tmin (minimum)	= 0.0 in	1/2 * tmin (actual)	= 0.0 in
Weld tw (minimum)	= 0.1971 in	Weld tw (actual)	= 0.0 in
Weld tc (minimum)	= 0.1971 in	Weld tc (actual)	= 0.1971 in
smaller 0.25 in		Leg size tw (actual)	= 0.0 in
tc of 0.7 * tmin		Leg size tc (actual)	= 0.2815 in
Outward nozzle weld	L1 = 0.2815 in	fr1 = Sn/Sv	= 0.73
Outer element weld	L2 = 0.0 in	fr2 = Sn/Sv	= 0.73
Inward nozzle weld	L3 = 0.0 in	fr3 = Sn/Sv or Se/Sv	= 0.73
Inward nozzle weld new	= 0.0 in	fr4 = Se/Sv	= 1.0
Corroded int.proj.thk	ti = 0.0 in		

Corroded inside diameter d = 1.812 in
Vessel wall length available for reinforcement 2*Lp-d = 1.875 in
Plane correction factor (Fig.UG-37) F = 1.0
Offset distance from centerline doff = 0.0 in
Reinforcement areas (internal pressure condition) ASME 2004 UG-37
A1 = Vessel wall. Larger of:
| (2*Lp-d)*(E1*t-F*tr)-2*tn*(E1*t-F*tr)*(1-fr1)| = 0.608 in2
| 2*(t+tn)*(E1*t-F*tr)-2*tn*(E1*t-F*tr)*(1-fr1)| = 0.6302 in2
A1 = 0.6302 in2
A2 = Nozzle wall outward | 5*(tn-trn)*fr2*t | = 0.6705 in2
Smaller of: | 5*(tn-trn)*fr2*tn | = 0.2746 in2
A2 = 0.2746 in2
A3 = Nozzle wall inward | 5*t*ti*fr2 | = 0.0 in2
Smallest of: | 5*ti*ti*fr2 | = 0.0 in2
| 2*h*ti*fr2 | = 0.0 in2
A3 = 0.0 in2
A41 = Outward nozzle weld = (L1**2)*fr3 = 0.0578 in2
A42 = Outer element weld = (L2**2)*fr4 = 0.0 in2
A43 = Inward nozzle weld = (L3**2)*fr2 = 0.0 in2
A4 = 0.0578 in2
A5 = Reinforcement pad Area = (Dp-d-2*tn)*te*fr4 A5 = 0.0 in2
Aa = Area Available = A1+A2+A3+A4+A5 Aa = 0.9626 in2
A = Area required = (d*tr*F)+2*tn*tr*F*(1-fl) A = 0.6572 in2
Per UG-36(c) (3) (a), this opening does NOT required additional reinforcement
other than the inherent in the construction.
ASME VIII-1 2004 A06 Reinforcement areas (external pressure) UG-37(d)
A1 = Vessel wall. Larger of:
| (2*Lp-d)*(E1*t-F*tre)-2*tn*(E1*t-F*tre)*(1-fr1)| = 0.8081 in2
| 2*(t+tn)*(E1*t-F*tre)-2*tn*(E1*t-F*tre)*(1-fr1)| = 0.8376 in2
A1 = 0.8376 in2
A2 = Nozzle wall outward | 5*(tn-trne)*fr2*t | = 0.6775 in2
Smaller of: | 5*(tn-trne)*fr2*tn | = 0.2774 in2
A2 = 0.2774 in2
A3 = Nozzle wall inward | 5*t*ti*fr2 | = 0.0 in2
Smallest of: | 5*ti*ti*fr2 | = 0.0 in2
| 2*h*ti*fr2 | = 0.0 in2
A3 = 0.0 in2
A41 = Outward nozzle weld = (L1**2)*fr3 = 0.0578 in2
A42 = Outer element weld = (L2**2)*fr4 = 0.0 in2
A43 = Inward nozzle weld = (L3**2)*fr2 = 0.0 in2
A4 = 0.0578 in2
A5 = Reinforcement pad Area = (Dp-d-2*tn)*te*fr4 A5 = 0.0 in2
Aa = Area Available = A1+A2+A3+A4+A5 Aa = 1.1729 in2
A = Area required = 0.5*(d*tre*F+2*tn*tre*F*(1-fr1)) A = 0.2146 in2

Nozzle attachment weld loads - UG-41 - Strength of reinforcement

ASME - Weld strength calculations not required per UW-15(b).
Total weld load (UG-41(b)(2))
 $W = (A-A1+2*tn*fr1(E1*t-F*tr))*Sv$ $W = 3440 \text{ lbf}$
Weld load for strength path 1-1 (UG-41(b)(1))
 $W(1-1) = (A2+A5+A41+A42)*Sv$ $W(1-1) = 6648 \text{ lbf}$
Weld load for strength path 2-2 (UG-41(b)(1))
 $W(2-2) = (A2+A3+A41+A43+2*tn*t*fr1)*Sv$ $W(2-2) = 12299 \text{ lbf}$
Weld load for strength path 3-3 (UG-41(b)(1))
 $W(3-3) = (A2+A3+A5+A41+A42+A43+2*tn*t*fr1)*Sv$ $W(3-3) = -$
Reinforcing element strength = $A5 * Se$ $= -$
Nozzle attachment weld loads - ASME 2004 UG-41 - Strength of reinforcement

Unit stresses - UW15(c) and UG-45(c)
Inner fillet weld shear $= 7154 \text{ psi}$
Outer fillet weld shear $= -$
Groove weld tension $= 10804 \text{ psi}$
Groove weld shear $= 9660 \text{ psi}$
Nozzle wall shear $= 10220 \text{ psi}$
Strength of connection elements
Inner fillet weld shear $= 7510 \text{ lbf}$
Nozzle wall shear $= 9456 \text{ lbf}$
Groove weld tension $= 11341 \text{ lbf}$
Outer fillet weld shear $= -$
Possible paths of failure
1-1 $9456 + 7510 = 16966 \text{ lbf}$
2-2 $7510 + 11341 = 18851 \text{ lbf}$
3-3 $- + - = -$
Welds strong enough if path greater than the smaller of W or W(path)
Path 1-1 $> W$ or $W11$
 $16966 \text{ lbf} > 3440 \text{ lbf}$ OK
Path 2-2 $> W$ or $W22$
 $18851 \text{ lbf} > 3440 \text{ lbf}$ OK
Path 3-3 $> W$ or $W33$
 $- > -$

Component: Nozzle C

Method: Local Stresses in Cylindrical Shell Due to External Loadings per
Heat Exchange Institute (HEI 'Std For Power Plant Hx', First Edition)

Vessel: Front Head Cylinder SA-240 S30400 Grd 304 Plate(G5)

Design pressure Pr = 50 psi Design temperature T = 300 F

Joint efficiency E = 1.00

Vessel design stress S = 18900 psi Vessel yield stress Sy = 22400 psi

Inside corr. allow. CAI = 0.0 in Outside corr. all. CAO = 0.0 in

Vessel outside dia. OD = 72.0 in Vessel mean radius Rm = 35.8125 in

Vessel thickness tnom = 0.375 in

Nozzle:

Nozzle outside dia. ODn = 54.0 in Nozzle outside rad. ro = 27.0 in

Reinf. pad:

Pad thickness Prtk = 0.375 in Vessel + pad tks. T = 0.75 in

Shape factors and Coefficients:

Gamma = Rm/T = 47.75 Beta = 0.875*ro/Rm = 0.6597

Alpha = 114.25 Sigma = 868.48 Delta = 129.84

Conversion factor Cf = 1

Maximum load & moment

S = 2*pr*(Rm-T/2)/t = 4725 psi

Sa = shell allowable stress = 18900 psi

Sig = minimum of S & Sa = 4725 psi


Frrf = Rm*Rm*(sy-sig)/alpha = 198408 lbf

Mrcm = Rm*Rm*ro*sy*cf/sigma = 893139 lbf*in

Mrlm = Rm*Rm*ro*(sy-sig)*cf/delta = 4713804 lbf*in

Frf = maximum resultant force = 198408 lbf

Mrm = maximum resultant moment = 893139 lbf*in

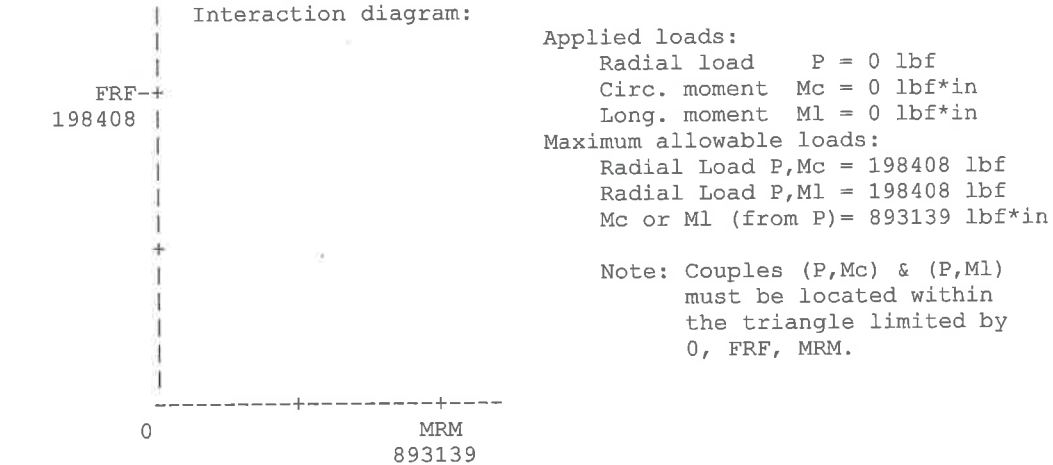

Component: Nozzle D


Method: Local Stresses in Cylindrical Shell Due to External Loadings per
Heat Exchange Institute (HEI 'Std For Power Plant Hx', First Edition)

Vessel: Rear Head Cylinder SA-240 S30400 Grd 304 Plate(G5)
Design pressure Pr = 50 psi Design temperature T = 300 F
Joint efficiency E = 1.00
Vessel design stress S = 18900 psi Vessel yield stress Sy = 22400 psi
Inside corr. allow. CAI = 0.0 in Outside corr. all. CAO = 0.0 in
Vessel outside dia. OD = 72.0 in Vessel mean radius Rm = 35.8438 in
Vessel thickness tnom = 0.3125 in

Nozzle:
Nozzle outside dia. ODn = 6.625 in Nozzle outside rad. ro = 3.3125 in
Reinf. pad:
Pad thickness Prtk = 0.0 in Vessel + pad tks. T = 0.3125 in

Shape factors and Coefficients:
Gamma = Rm/T = 114.7 Beta = 0.875*ro/Rm = 0.0809
Alpha = 8546.78 Sigma = 7376.00 Delta = 4368.71
Conversion factor Cf = 1

Maximum load & moment
S = 2*pr*(Rm-T/2)/t = 11420 psi
Sa = shell allowable stress = 18900 psi
Sig = minimum of S & Sa = 11420 psi
Frrf = Rm*Rm*(sy-sig)/alpha = 1651 lbf
Mrcm = Rm*Rm*ro*sy*cf/sigma = 12924 lbf*in
Mrlm = Rm*Rm*ro*(sy-sig)*cf/delta = 10696 lbf*in
Frf = maximum resultant force = 1651 lbf
Mrm = maximum resultant moment = 10696 lbf*in

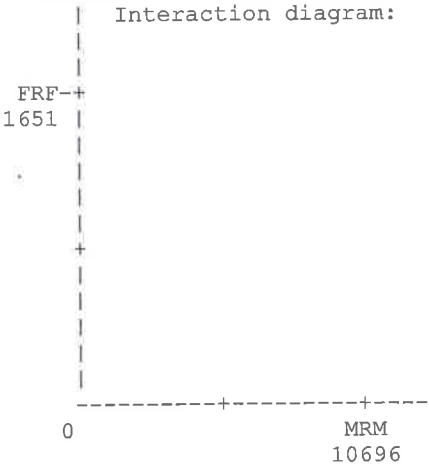

Applied loads:
Radial load P = 0 lbf
Circ. moment Mc = 0 lbf*in
Long. moment Ml = 0 lbf*in
Maximum allowable loads:
Radial Load P,Mc = 1651 lbf
Radial Load P,Ml = 1651 lbf
Mc or Ml (from P)= 10696 lbf*in

Note: Couples (P,Mc) & (P,Ml)
must be located within
the triangle limited by
0, FRF, MRM.

Teams 20.0

Component: Nozzle E

Vessel: Rear Head Cylinder	SA-240 S30400 Grd 304 Plate(G5)
Design pressure Pr = 50 psi	Design temperature T = 300 F
Joint efficiency E = 1.00	
Vessel design stress S = 18900 psi	Vessel yield stress Sy = 22400 psi
Inside corr. allow. CAI = 0.0 in	Outside corr. all. CAO = 0.0 in
Vessel outside dia. OD = 72.0 in	Vessel mean radius Rm = 35.8438 in
Vessel thickness tnom = 0.3125 in	

Pad thickness Prtk = 0.0 in Vessel + pad tks. T = 0.3125 in
Shape factors and Coefficients:

Conversion factor $C_f = 1$

```
Maximum load & moment
S      = 2*pr*(Rm-T/2)/t      = 11420 psi
Sa     = shell allowable stress = 18900 psi
Sig    = minimum of S & Sa    = 11420 psi
Frrf   = Rm*Rm*(sy-sig)/alpha = 1651 lbf
Mrcm   = Rm*Rm*ro*sy*cf/sigma = 12924 lbf*in
Mrlm   = Rm*Rm*ro*(sy-sig)*cf/delta = 10696 lbf*in
Frf    = maximum resultant force = 1651 lbf
Mrm    = maximum resultant moment = 10696 lbf*in
```


Applied loads:

Radial load $P = 0 \text{ lbf}$
Circ. moment $M_c = 0 \text{ lbf}\cdot\text{in}$
Long. moment $M_l = 0 \text{ lbf}\cdot\text{in}$

Maximum allowable loads:

Radial Load P, Mc = 1651 lbf
Radial Load P, Ml = 1651 lbf
Mc or Ml (from P) = 10696 lbf*in

Note: Couples (P,Mc) & (P,Ml)
must be located within
the triangle limited by
0, FRF, MRM.

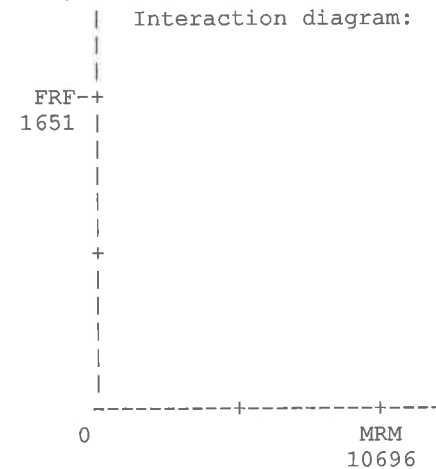

Component: Nozzle G

Method: Local Stresses in Cylindrical Shell Due to External Loadings per
Heat Exchange Institute (HEI 'Std For Power Plant Hx', First Edition)

Vessel: Front Head Cylinder SA-240 S30400 Grd 304 Plate(G5)

Design pressure Pr = 50 psi Design temperature T = 300 F

Joint efficiency E = 1.00

Vessel design stress S = 18900 psi Vessel yield stress Sy = 22400 psi

Inside corr. allow. CAI = 0.0 in Outside corr. all. CAO = 0.0 in

Vessel outside dia. OD = 72.0 in Vessel mean radius Rm = 35.8125 in

Vessel thickness tnom = 0.375 in

Nozzle:

Nozzle outside dia. ODn = 4.0 in Nozzle outside rad. ro = 2.0 in

Reinf. pad:

Pad thickness Prtk = 0.0 in Vessel + pad tks. T = 0.375 in

Shape factors and Coefficients:

Gamma = Rm/T = 95.5 Beta = 0.875*ro/Rm = 0.0489

Alpha = 9845.13 Sigma = 6237.27 Delta = 4057.68

Conversion factor Cf = 1

Maximum load & moment

S = 2*pr*(Rm-T/2)/t = 9500 psi

Sa = shell allowable stress = 18900 psi

Sig = minimum of S & Sa = 9500 psi


Frrf = Rm*Rm*(sy-sig)/alpha = 1680 lbf

Mrcm = Rm*Rm*ro*sy*cf/sigma = 9212 lbf*in

Mrlm = Rm*Rm*ro*(sy-sig)*cf/delta = 8155 lbf*in

Frf = maximum resultant force = 1680 lbf

Mrm = maximum resultant moment = 8155 lbf*in

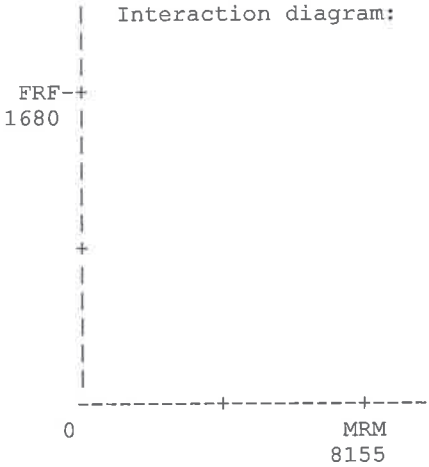

Applied loads:

Radial load P = 0 lbf

Circ. moment Mc = 0 lbf*in

Long. moment Ml = 0 lbf*in

Maximum allowable loads:

Radial Load P,Mc = 1680 lbf

Radial Load P,Ml = 1680 lbf

Mc or Ml (from P)= 8155 lbf*in

Note: Couples (P,Mc) & (P,Ml)
must be located within
the triangle limited by
0, FRF, MRM.

Component: Nozzle Flange Details

Flange, Gasket and Bolting Details
Dimensional data in

Nozzle	Flg		Flg	Rating	Neck tks	Flg tks	Bolt Cir.	Gaskets		Bolts	
	Type	Dia. (*)						O.D.	Width	No	Dia.
A	ANSI SO	30.0	150		0.5	2.12	36.0	33.75	0.0	28	1.25
B	ANSI SO	30.0	150		0.5	2.12	36.0	33.75	0.0	28	1.25
C	ANSI SO	54.0	150		0.375	4.75	62.75	59.5	0.0	44	1.75
D	ANSI SO	6.625	150		0.28	1.0	9.5	8.5	0.94	8	0.75
E	ANSI SO	6.625	150		0.28	1.0	9.5	8.5	0.94	8	0.75
G	ANSI SO	4.0	150		0.337	0.94	7.0	5.5	0.75	8	0.625
H	ANSI SO	3.5	150		0.3	0.94	6.0	5.0	0.75	4	0.625
J	ANSI SO	2.375	150		0.344	0.75	4.75	3.62	0.62	4	0.625
K	ANSI SO	2.375	150		0.344	0.75	4.75	3.62	0.62	4	0.625

* Dia. = Nozzle O.D. if standard flange
= Flange O.D. if non-standard flange

Horizontal Vessels on Saddles

Saddle material: SA-516 K02700 Grd 70 Plate
Wear plate mtl: SA-516 K02700 Grd 70 Plate

Shell radius	R = 35.5625 in	Total force	Q = 122848 lbf
Shell length	L = 263.75 in	Angle alpha	Alpha = 1.5752 rad
Angle beta	Beta = 95 deg.	Angle delta	Delta = 1.7599 rad
Vessel thickness	TS = 0.5 in	Wear plate tks.	w = 0.5 in
Vessel corr.allowance	CA = 0.0625 in	Angle theta	Theta = 170 deg
Wear plate width	b = 12.1875 in	*Vessel thk TS+w-CA	tsw = 0.4375 in
Pressure	P = 150 psi	Inside diameter	ID = 71.125 in
Joint efficiency	JE = 0.7	Head joint eff.	JEH = 0.85
Front head thickness	TH = 2.8125 in	Rear head thickness	TH = 0.3125 in
Head diameter	D = ---	Head corr.allowance	CAH = 0.0 in

Saddles		Saddle A	Saddle B
Loads on saddles	Q =	86127	36721 lbf
Distance from ref. point	A =	38.5	41.25 in
Head length	H =	---	---
Ratio A/R		1.0826	1.1599
Bending moment factor	K7 =	0.0208	0.0208

* w included in tsw only if A / R < 0.5

Shell pressure stress PS = P*ID/(4*JE*(TS-CA)) = 8709 psi
Fr. head press. stress P*D+0.2*P*(TH-CAH)/(2*JEH*(TH-CAH)) = ---
Re. head press. stress P*D+0.2*P*(TH-CAH)/(2*JEH*(TH-CAH)) = ---
Alpha = Pi-(Pi/180)*(Theta/2+Beta/20) Delta = (Pi/180)*(5*Theta/12+30)
S11 = (3*Q*L/(Pi*(TS-CA)*R**2)) S12 = 1-(1-A/L+(R**2-H**2)/2*A*L)/(1+4*H/3*L)
S13 = Pi*(Sin(Delta)/Delta-Cos(Delta))
S14 = Delta+Sin(Delta)*Cos(Delta)-2*Sin(Delta)**2/Delta

Stresses in psi	** Saddles **		
Bending stress at saddle + pressure	A	B	Allowable
S1 = S11*(4*A/L)*S12*S13/S14 + PS	9490	9128	14000
Bending stress at midspan + pressure			
S21 = (1+2*(R**2-H**2)/L**2)/(1+4*H/3*L)			
S2 = S11*(S21-4*A/L) + PS	10187	9281	14000
Tangential shear in shell (unstiffened)			
S41 = Sin(Alpha)/ (Pi-Alpha+Sin(Alpha)*Cos(Alpha))			
S42 = L-H-2*A/(L+H)			
S4 = (Q/R*(TS-CA))*S42*S41	2509	1038	16000

Component: Shell Cylinder

Horizontal vessels on saddles
Tangential shear stress in shell (stiffened), psi

	** Saddles **		
	A	B	Allowable
S61 = Sin(Alpha)*Cos(Alpha)			
S62 = Sin(Alpha)/(Pi-Alpha+S61)			
S6 = (Q/R*(TS-CA))*(L-H-2*A/(L+H))*S62)	---	---	---
Circumferential stress at horn, psi			
S71 = 12 * Q * K7 * R/(L *tsw**2)			
S72 = 4*tsw*(b+1.56*(R*tsw)**0.5)			
S7 = -Q/S72 - S71	-23165	-9876	-25000
Ring compression in shell over saddle, psi			
S91 = 1+Cos(Alpha)/			
(Pi-Alpha+Sin(Alpha)*Cos(Alpha))			
S92 = (TS-CA)*(B+1.56*(R*(TS-CA))**0.5)			
S9 = (Q/S92) * S91	2707	1154	17400
Tangential shear stresses in head, psi			
S51 = Sin(Alpha) * Cos(Alpha)			
S52 = (Sin(Alpha)/Pi)*(Alpha-S51)/			
(Pi-Alpha+S51)			
S5 = (Q/(12*R*(TH-CAH)))*S52	---	---	---
Head stresses, psi			
S81 = 3*Q/(8*12*R*(TH-CAH))			
S82 = (Sin(Alpha))**2			
S83 = Pi-Alpha+Sin(Alpha)*Cos(Alpha)			
S8 = S81*(S82/S83)	---	---	---
Head stresses + pressure, psi			
S8 + PH	---	---	---

Saddle Geometry Verification

Saddle width A = 71.75 in Saddle depth F = 6.0 in
Rib thickness J = 0.5 in Web thickness tw = 0.5 in
Base plate thk tb = 0.625 in Wear plate thk tra = 0.5 in
Min saddle height h = 24.0 in Corr.Shell thk ts = 0.4375 in
Number of ribs n = 4 Vessel CL to base B = 60.0 in
Angle alpha,rad alpha = 1.5752 Angle beta, rad beta = 1.6581
Angle theta,rad theta = 2.9671 Rib depth G = 6.0 in
Yield saddle mtl fy = 34800 psi Inside radius R = 35.5625 in
Max. load/saddle Qm = 86127 lbf Friction factor mu = 0.1
Saddle to foundation surface type: Teflon to Teflon
Expansion load mu*Qm = FL1 = 8613 lbf
Max wind or seismic load = Fws = 0 lbf
Bundle pull load = Fbl = -
Maximum horizontal load = FL = MAX[FL1,Fws,Fbl] FL = 8613 lbf
Saddle coefficient K1 = (1+Cos(beta)-0.5*(Sin(beta))**2/
(Pi-Beta+Sin(Beta)*Cos(Beta))) K1 = 0.2983
Saddle splitting force, fh = K1*Qm fh = 25692 lbf
Cross sectional area of saddle, As As = 21.06 in2
Web tension stress, sigmaT = fh/As sigmaT = 1220 psi
Max web tension stress, sigmaTmax = 0.6*fy sigmaTmax = 20880 psi
Distance centroid of saddle to base plate, d
d = B - R*Sin(Theta)/Theta d = 57.9187 in
Web moment M = fh*d M = 1488043 lbf*in
Distance saddle centroid to vessel ID, C1 C1 = 15.9325 in
Saddle moment of inertia, I I = 2429.5
Web bending stress, fbweb = M*C1/I fbweb = 9758 psi
fbweb <= fbMax = 0.66*fy fbwebMax = 23200 psi
Base plate with center web
Base plate area, Ab = A*F Ab = 430.5 in2
Bearing pressure, Bp = Q/Ab Bp = 200 psi
Base plate moment, M = Q*F/8 M = 64595 lbf*in
Section modulus, Z = A*tb**2/6 Z = 4.67
Base plate bending stress, fbc = M/Z fbc = 13828 psi
fbc <= fbcMax = 0.66*fy fbcMax = 23200 psi
Base plate with offset web
Distance edge base plate to web, d2 d2 = 0.5 in
Weld leg size, base to web, ww ww = 0.5 in
Web length, Lw = A - 2*j Lw = 70.75 in
Ribs length, Lr = n*(G-tw) Lr = 22.0 in
Overall length, L = Lw + Lr L = 92.75 in
Unit load, fu = Q/L lbf/in fu = 928.59
Distance l1 = d2+tw+ww+tb l1 = 2.125 in
Distance l2 = F - l1 l2 = 3.875 in
Linear load, Omega = Fu/(l1+0.5*l2) Omega = 228.58 psi
Base plate linear moment, M = (omega*l2**2)/6 M = 572 lbf
Base plate bending stress, fbo = 6*M/tb**2 fbo = 8786 psi
fbo <= fboMax = 0.66*fy fboMax = 23200 psi
fb = MAX(fbweb,fbc.fbo) fb = 13828 psi
Minimum depth of saddle at top, Gtm
Gtm=SQRT((5.012*FL/(J*(n-1)*Fb)*(h+(A/1.96)*(1-Sin(Alpha)))) = 5.4562 in
Actual depth of saddle at top, Gt Gt = 6.0 in
Minimum wear plate width, H = Gt + 1.56*SQRT(R*ts) H = 12.1533 in
Actual wear plate width, Ha Ha = 12.1875 in
Minimum wear plate thickness, tr = (Ha-Gt)**2/(2.43*R) tr = 0.443 in
Actual wear plate thickness, tra tra = 0.5 in
Anchor bolts
Bolt material: SA-325 Carbon steel Bolt
Maximum longitudinal load, QL QL = 20475 lbf
Maximum load, Qm Qm = 86127 lbf
Bolt diameter, d d = 1.125 in
Number of bolts per saddle, N N = 2
If Qm>QL, no uplift occurs. Uplift load per bolt: QL-Qm/N = -
Shear load per bolt

ShearB = $\mu * FL / N$
Allowable bolt force, bf
Bolt transverse load
Maximum transverse load (seismic or wind), Ftr
Bolt transverse moment, MtransB = $Ftr * B$
Critical bolt distance, e = $MtransB / Q$
If e < A/6, no uplift occurs
Uplift bolt tension force = -

Inside ribs/web design
Saddle rib width Gb = 6.0 in
Pressure area F*e Ap = 143.5 in2
Area rib and web Ar = 14.96 in2
Mom.iner.J*Gb**3/12 I = 9
Compression dist. l2 = 25.8834 in
Unit force Fl/2*A fu = 60.02
Moment arm C2 C2 = 3.0 in
Max. comp.stress Fa = 16740 psi
K end connection coeff= 2
Combined stress (must be less than one) fa/Fa + fb/Fb = 0.65

Outside ribs/web design
Press.area 0.5F*e Ap = 71.75 in2
Area rib and web Ar = 8.98 in2
Compression dist. l1 = 59.375 in
Unit force Fl/2*A fu = 60.02
Moment arm C1 C1 = 3.0 in
Max. comp.stress Fa = 10280 psi
Combined stress (must be less than one) fa/Fa + fb/Fb = 0.77

Wind loads - ANSI/SEI/ASCE 7-02

Vessel outside diameter	OD	OD = 72 in
Vessel effective length	EL	EL = 444.5 in
Vessel effective diameter	EOD	EOD = 92.16 in
Effective wind area	Af	Af = EOD*EL = 284.48 ft2
Velocity pressure exposure	Kz	Kz = 0.85
Topographic factor	Kzt	Kzt = 1
Directionality factor	Kd	Kd = 1
Importance factor	I	I = 1
Wind speed, m/h	V	V = 100
Velocity pressure, qz, lbf/ft2		qz = 0.00256*Kz*Kzt*I*V**2 = 21.8
Gust response factor	G	G = 0.85
Force coefficient	Cf	Cf = 1
Wind force	F	F = qz*G*Cf*Af = 5261.7 lbf
Moment arm	L	L = 5 ft
Overturning moment, OM, ft-lbf		OM = F*L = 26309

Earthquake Loads - ANSI/SEI/ASCE 7-02

Equipment occupancy category - wind/seismic design		= II
Equipment seismic site class		= B
Equipment seismic use group		= I
Response modification factor	R	R = 3
Seismic importance factor	I	I = 1
Mapped maximum spectral response acceleration at short periods	Ss	Ss = 0.75
Mapped maximum spectral response acceleration at 1-sec period	S1	S1 = 0.2
Site coefficient Fa - Table 9.4.1.2.4a	Fa	Fa = 1
Site coefficient Fv - Table 9.4.1.2.4b	Fv	Fv = 1
Maximum spectral response acceleration short periods	Sms	Sms = Fa*Ss = 0.75
Maximum spectral response acceleration at 1-sec per.	Sm1	Sm1 = Fv*S1 = 0.2
Spectral response acceleration at short periods	Sds	Sds = (2/3)*Sms = 0.5
Spectral response acceleration at 1-sec period	Sd1	Sd1 = (2/3)*Sm1 = 0.13
Seismic response coefficient, Cs = Sds/(R/I)	Cs	Cs = 0.17
	CsMin	CsMin = 0.03
Seismic zone coefficient, Cv	Cv	Cv = 0.24
Weight of vessel, full	W	W = 122848 lbf
Total shear at the base, V = Cs * W	V	V = 20474.6 lbf
Maximum lateral force, F = V	F	F = 20474.6 lbf
Overturning moment, OM, ft-lbf		OM = 0.5*F*L = 51186

Wind and Seismic Loads - Effect on Saddles

Dist.between saddles		Ls = 15.3333 ft
Saddle width		E = 5.9792 ft
Longitudinal seismic force	F1=Cs*W	F1 = 20474.6 lbf
Projected area of vessel	Af=PI*EOD**2/4	Af = 46.32 ft2
Longitudinal wind force	F1=Af*Cf*G*qz	F1 = 856.8 lbf
Longitudinal seismic load/saddle	Q1=F1*L/Ls	Q1 = 6676.5 lbf
Longitudinal wind load/saddle	Q1=F1*L/Ls	Q1 = 279.4 lbf
Transverse seismic force	Ft=0.5*Cs*W	Ft = 10237.3 lbf
Projected area of vessel	Af=EOD*EL	Af = 284.48 ft2
Transversal wind force	Ft=0.5*Af*Cf*G*qz	Ft = 2630.9 lbf
Transverse seismic load/saddle	Qt=1.5*Ft*L/E	Qt = 12841.2 lbf
Transverse wind load per saddle	Qt=1.5*Ft*L/E	Qt = 3300 lbf
Maximum (seismic/wind) load per saddle	Q = max(Q1, Qt)	Q = 12841.2 lbf
Seismic and wind loads have NOT been applied to supports design.		

Weights, surface area, Insulation

Volume	ft3	Shell side	Tube side
Avg. fluid density	lb/ft3	275.65	674.96
Fluid weight	lb	0	0
Surface area	ft2	418.4	275.3
Surface Area		693.7	ft2
Insulation thickness		-	
Insulation type		-	
Insulation density		-	
Insulation weight		-	
Insulation seals and jackets		-	
Weight of Accessories		-	
Weight of piping attached SS nozzles		-	
Weight of piping attached TS nozzles		-	
Empty weight		63547	lb
Operating weight		122848	lb
Full weight		122848	lb

Maximum Allowable Working Pressures

* = Shell Side MAWP + = Tube Side MAWP

Component	Side	--Design conditions--			---- New and cold ----		
		Temp	Stress	MAWP	Temp	Stress	MAWP
		F	psi	psi	F	psi	psi
Shell Cylinder	S	200	20000	171	70	20000	195.5
Front Head Cylinder	T	300	18900	138.4	70	20000	146.4
Rear Head Cylinder	T	300	18900	115.2	70	20000	122
Front Head Cover	T	300	20000	94.2	70	20000	94.2
Rear Head Cover	T	300	18900	140.5	70	20000	148.7
Front Tubesheet	S	300	15000	195	70	20000	202.3
Front Tubesheet	T	300	15000	76.8	70	20000	79.7
Rear Tubesheet	S	300	15000	162.5	70	20000	166.9*
Rear Tubesheet	T	300	15000	64	70	20000	65.7
Rear Head Flng At TS	T	300	20000	50.6	70	20000	50.6
Front Head Flng At Cov	T	300	15000	50.3+	70	20000	50.3+
Tubes	T	300	12700	1027.9	70	17000	1375.9
Nozzle A	S	200	20000	196.3	70	20000	224.5
Nozzle B	S	200	20000	196.3	70	20000	224.5
Nozzle C	T	300	18900	184.8	70	20000	195.5
Nozzle D	T	300	16100	129	70	17000	136.5
Nozzle E	T	300	16100	129	70	17000	136.5
Nozzle G	T	300	16100	155.3	70	17000	164.4
Nozzle H	T	300	16100	2183.8	70	17000	2305.9
Nozzle J	S	200	14600	2710.2	70	14600	3500.5
Nozzle K	S	200	14600	2710.2	70	14600	3500.5
Nozzle Flng A	S	200	20000	260	70	20000	285
Nozzle Flng B	S	200	20000	260	70	20000	285
Nozzle Flng C	T	300	20000	230	70	20000	285
Nozzle Flng D	T	300	12800	175	70	16700	230
Nozzle Flng E	T	300	12800	175	70	16700	230
Nozzle Flng G	T	300	12800	175	70	16700	230
Nozzle Flng H	T	300	12800	175	70	16700	230
Nozzle Flng J	S	200	20000	260	70	20000	285
Nozzle Flng K	S	200	20000	260	70	20000	285
Nozzle Reinforcement A	S	200	-	158*	70	-	172
Nozzle Reinforcement B	S	200	-	158*	70	-	172
Nozzle Reinforcement C	T	300	18900	111	70	20000	116
Nozzle Reinforcement D	T	300	-	95	70	-	101
Nozzle Reinforcement E	T	300	-	95	70	-	101
Nozzle Reinforcement G	T	-	-	N/C	-	-	N/C
Nozzle Reinforcement H	T	-	-	N/C	-	-	N/C
Nozzle Reinforcement J	S	-	-	N/C	-	-	N/C
Nozzle Reinforcement K	S	-	-	N/C	-	-	N/C
Rear Hd Bolting At TS	T	300	25000	51.7	70	25000	51.7
Front Hd Bolting At Cov	T	300	25000	51.5	70	25000	51.5
Dist. Belt An.ring	S	-	-	N/C	-	-	N/C

Maximum Allowable Working Pressures

		* = Shell Side MAWP + = Tube Side MAWP					
Component	Side	--Design conditions--			---- New and cold ----		
		Temp	Stress	MAWP	Temp	Stress	MAWP
		F	psi	psi	F	psi	psi
Dist. Belt An.ring	S	-	-	N/C	-	-	N/C
Nozzle Flng Bolting A	S	200	25000	260	70	25000	285
Nozzle Flng Bolting B	S	200	25000	260	70	25000	285
Nozzle Flng Bolting C	T	300	25000	230	70	25000	285
Nozzle Flng Bolting D	T	300	25000	175	70	25000	230
Nozzle Flng Bolting E	T	300	25000	175	70	25000	230
Nozzle Flng Bolting G	T	300	25000	175	70	25000	230
Nozzle Flng Bolting H	T	300	25000	175	70	25000	230
Nozzle Flng Bolting J	S	200	25000	260	70	25000	285
Nozzle Flng Bolting K	S	200	25000	260	70	25000	285

Minimum Design Metal Temperature for Impact Test Exemption (UCS-66)

* Indicates the controlling components + Indicates compliance with UG-20(f)

Component	Curve	Temp		***** UCS-66.1 *****		
		F		Ratio	Reduction	Temperature
Shell Cylinder	B	-7	+	0.70	29	-36
Front Head Cover	D	-44		0.69	30	-74
Rear Head Flng At TS	D	-55		0.91	8	-63
Nozzle A	B	-7	+	0.29	140	-147
Nozzle B	B	-7	+	0.29	140	-147
Nozzle J	B	-20		0.05	140	-160
Nozzle K	B	-20		0.05	140	-160
Nozzle Flng A	-	-20		-	-	-
Nozzle Flng B	-	-20		-	-	-
Nozzle Flng C	-	-20		-	-	-
Nozzle Flng J	-	-20		-	-	-
Nozzle Flng K	-	-20		-	-	-
Nozzle Reinforcement H	B	-20		-	-	-
Rear Hd Bolting At TS	A	-55		-	-	-
Front Hd Bolting At Cov	A	-55		-	-	-
Distributor Belt A	B	15	+	-	-	- *
Distributor Belt B	B	15	+	-	-	- *
Nozzle Flng Bolting A	A	-55		-	-	-
Nozzle Flng Bolting B	A	-55		-	-	-
Nozzle Flng Bolting C	A	-55		-	-	-
Nozzle Flng Bolting D	A	-55		-	-	-
Nozzle Flng Bolting E	A	-55		-	-	-
Nozzle Flng Bolting G	A	-55		-	-	-
Nozzle Flng Bolting H	A	-55		-	-	-
Nozzle Flng Bolting J	A	-55		-	-	-
Nozzle Flng Bolting K	A	-55		-	-	-

Hydrostatic Test Pressure - ASME VIII-1 2004 A06 UG-99(b) Factor: 1.3

Shell Side: 195 psi Tube Side: 65 psi

Component	Material	Design		Side	Temp	Stress	Test	Stress	Ratio
		F	psi						
Shell Cylinder	SA-516 K02700 Grd 70 Plate S	200	20000				20000		1
Front Head Cylinder	SA-240 S30400 Grd 304 Plat T	300	18900				20000	1.0582	
Rear Head Cylinder	SA-240 S30400 Grd 304 Plat T	300	18900				20000	1.0582	
Front Head Cover	SA-516 K02700 Grd 70 Plate T	300	20000				20000		1
Rear Head Cover	SA-240 S30400 Grd 304 Plat T	300	18900				20000	1.0582	
Front Tubesheet	SA-240 S30400 Grd 304 Plat S	300	15000				20000	1.3333	
Rear Tubesheet	SA-240 S30400 Grd 304 Plat S	300	15000				20000	1.3333	
Rear Head Flng At TS	SA-516 K02700 Grd 70 Plate T	300	20000				20000		1
Front Head Flng At Cov	SA-240 S30400 Grd 304 Plat T	300	15000				20000	1.3333	
Tubes	SA-249 S30400 Grd TP304 Wl T	300	12700				17000	1.3386	
Nozzle A	SA-516 K02700 Grd 70 Plate S	200	20000				20000		1
Nozzle B	SA-516 K02700 Grd 70 Plate S	200	20000				20000		1
Nozzle C	SA-240 S30400 Grd 304 Plat T	300	18900				20000	1.0582	
Nozzle D	SA-312 S30400 Grd TP304 Wl T	300	16100				17000	1.0559	
Nozzle E	SA-312 S30400 Grd TP304 Wl T	300	16100				17000	1.0559	
Nozzle G	SA-312 S30400 Grd TP304 Wl T	300	16100				17000	1.0559	
Nozzle H	SA-312 S30400 Grd TP304 Wl T	300	16100				17000	1.0559	
Nozzle J	SA-53 K03005 Grd E/B Wld. S	200	14600				14600		1
Nozzle K	SA-53 K03005 Grd E/B Wld. S	200	14600				14600		1
Nozzle Flng A	SA-105 K03504 Forgings S	200	20000				20000		1
Nozzle Flng B	SA-105 K03504 Forgings S	200	20000				20000		1
Nozzle Flng C	SA-105 K03504 Forgings T	300	20000				20000		1
Nozzle Flng D	SA-182 S30403 Grd F304L Fo T	300	12800				16700	1.3047	
Nozzle Flng E	SA-182 S30403 Grd F304L Fo T	300	12800				16700	1.3047	
Nozzle Flng G	SA-182 S30403 Grd F304L Fo T	300	12800				16700	1.3047	
Nozzle Flng H	SA-182 S30403 Grd F304L Fo T	300	12800				16700	1.3047	
Nozzle Flng J	SA-105 K03504 Forgings S	200	20000				20000		1
Nozzle Flng K	SA-105 K03504 Forgings S	200	20000				20000		1
Nozzle Reinforcement C	SA-240 S30400 Grd 304 Plat T	300	18900				20000	1.0582	
Rear Hd Bolting At TS	SA-193 G41400 Grd B7 Bolt(T	300	25000				25000		1
Front Hd Bolting At Cov	SA-193 G41400 Grd B7 Bolt(T	300	25000				25000		1
Distributor Belt A	SA-516 K02700 Grd 70 Plate S	200	20000				20000		1
Distributor Belt B	SA-516 K02700 Grd 70 Plate S	200	20000				20000		1
Nozzle Flng Bolting A	SA-193 G41400 Grd B7 Bolt(S	200	25000				25000		1
Nozzle Flng Bolting B	SA-193 G41400 Grd B7 Bolt(S	200	25000				25000		1
Nozzle Flng Bolting C	SA-193 G41400 Grd B7 Bolt(T	300	25000				25000		1
Nozzle Flng Bolting D	SA-193 G41400 Grd B7 Bolt(T	300	25000				25000		1
Nozzle Flng Bolting E	SA-193 G41400 Grd B7 Bolt(T	300	25000				25000		1
Nozzle Flng Bolting G	SA-193 G41400 Grd B7 Bolt(T	300	25000				25000		1
Nozzle Flng Bolting H	SA-193 G41400 Grd B7 Bolt(T	300	25000				25000		1
Nozzle Flng Bolting J	SA-193 G41400 Grd B7 Bolt(S	200	25000				25000		1
Nozzle Flng Bolting K	SA-193 G41400 Grd B7 Bolt(S	200	25000				25000		1