
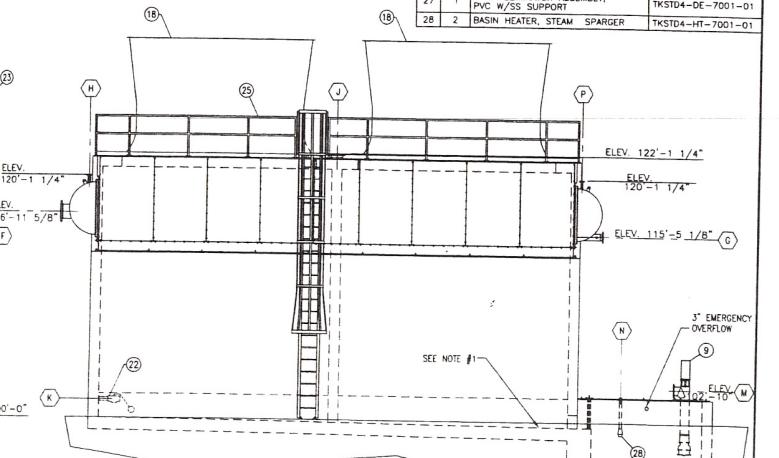
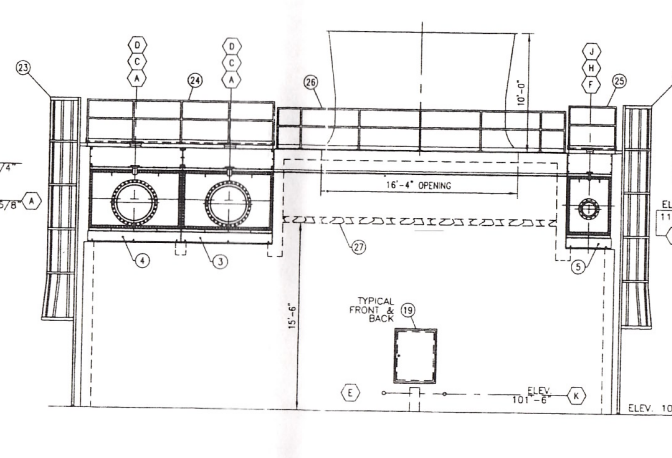


TUBE BUNDLE CONSTRUCTION DATA		PERFORMANCE DATA		BILL OF MATERIAL	
CODE: ASME SECT VIII-1, LASTEST ADDENDA DESIGN PRESSURE: 25 PSIG/FE DESIGN TEMP: 250°F MDMT: -20°F HEAT TREATMENT: NONE NDE PER CODE TUBE MATERIAL: 304, 304L SS TUBESHEET MATERIAL: 304, 304L SS DOME COVER ASSEMBLY: 304L SS BUNDLE SIDE PANEL: 304, 304L SS TUBE SUPPORT SHEETS: 304, 304L SS		CONDENSER DESIGN: MAIN FLOWRATE: 45,342 #/HR INLET PRESSURE: 1.79 PSIA INLET TEMP: 122°F NCG OUTLET TEMP: 111°F DUTY: 46,335.032 BTU/HR PRESSURE DROP: 0.15 PS AMBIENT WET BULB TEMP: 71°F CONDENSER DESIGN: REGEN FLOWRATE VARIES INLET PRESSURE: 2 = 25 PSIA INLET TEMP: 192°F = 110°F NCG OUTLET TEMP: VARIES DUTY: VARIES PRESSURE DROP: VARIES AMBIENT WET BULB TEMP: 71°F		<table border="1"> <thead> <tr> <th>ITEM No.</th> <th>QTY./UNIT</th> <th>DESCRIPTION</th> <th>TK DRAWING No.</th> </tr> </thead> <tbody> <tr> <td>1</td> <td>2</td> <td>TUBE BUNDLE, CLEANABLE, STRAIGHT TUBE, w/ REMOVABLE DOME COVERS (ALSO SEE CONSTRUCTION &amp; PERFORMANCE DATA)</td> <td>TKSTD2-BC-7001-01</td> </tr> <tr> <td>2</td> <td>1</td> <td>TUBE BUNDLE, CLEANABLE, STRAIGHT TUBE, w/ REMOVABLE DOME COVERS (ALSO SEE CONSTRUCTION &amp; PERFORMANCE DATA)</td> <td>TKSTD2-BC-7003-01</td> </tr> <tr> <td>3</td> <td>1</td> <td>ADAPTER BASE, INBOARD TUBE BUNDLE, STRUCTURAL STEEL, HDGAF</td> <td>TKSTD2-AB-1001-01</td> </tr> <tr> <td>4</td> <td>1</td> <td>ADAPTER BASE, RH OUTBOARD TUBE BUNDLE, STRUCTURAL STEEL, HDGAF</td> <td>TKSTD2-AB-1002-01</td> </tr> <tr> <td>5</td> <td>1</td> <td>ADAPTER BASE, LH OUTBOARD TUBE BUNDLE, STRUCTURAL STEEL, HDGAF</td> <td>TKSTD2-AB-1003-01</td> </tr> <tr> <td>6</td> <td>2</td> <td>ASSEMBLY, PVC PIPE w/ LARGE ORIFICE REMOVABLE ABS NOZZLES</td> <td>TKSTD2-SA-6001-01</td> </tr> <tr> <td>7</td> <td>1</td> <td>ASSEMBLY, PVC PIPE w/ LARGE ORIFICE REMOVABLE ABS NOZZLES</td> <td>TKSTD2-SA-6003-01</td> </tr> <tr> <td>8</td> <td>2</td> <td>SPRAY PUMP, VERTICAL MIXED FLOW w/ 40 HP TEFC, HOLLOW SHAFT MOTOR (ALSO SEE PERFORMANCE DATA)</td> <td>TKSTD3-SP-7002-01</td> </tr> <tr> <td>9</td> <td>2</td> <td>SPRAY PUMP, VERTICAL MIXED FLOW w/ 15 HP TEFC, HOLLOW SHAFT MOTOR (ALSO SEE PERFORMANCE DATA)</td> <td>TKSTD3-SP-7001-01</td> </tr> <tr> <td>10</td> <td>2</td> <td>FAN, PROPELLER, 14" FT. # w/ (6) BLADES MANUALLY ADJUSTABLE PITCH (ALSO SEE PERFORMANCE DATA)</td> <td>TKSTD3-FN-7001-01</td> </tr> <tr> <td>11</td> <td>2</td> <td>GEAR DRIVE, RIGHT ANGLE, SINGLE REDUCTION w/ 65:1 RATIO, LOW OIL CUT OUT SWITCH INCLUDED</td> <td>TKSTD3-GR-7001-01</td> </tr> <tr> <td>12</td> <td>2</td> <td>ADAPTER BASE, GEAR DRIVE, STEEL, HDGAF</td> <td>TKSTD2-GB-1001-01</td> </tr> <tr> <td>13</td> <td>2</td> <td>DRIVE SHAFT, COMPOSITE w/ FLEXIBLE COUPLINGS</td> <td>TKSTD3-DS-6001-01</td> </tr> <tr> <td>14</td> <td>2</td> <td>GUARD, COUPLING, STEEL, HDGAF</td> <td>TKSTD2-CG-2001-01</td> </tr> <tr> <td>15</td> <td>2</td> <td>FAN MOTOR, 75 HP, TEFC (ALSO SEE PERFORMANCE DATA)</td> <td>TKSTD3-FM-0001-01</td> </tr> <tr> <td>16</td> <td>2</td> <td>ADAPTER BASE, FAN MOTOR, STEEL, HDGAF</td> <td>TKSTD2-FB-1001-01</td> </tr> <tr> <td>17</td> <td>2</td> <td>GEAR DRIVE EXTENDED LUBE LINE PIPING ASSEMBLY w/ LEVEL GAUGE, FILL &amp; DRAIN CONNECTIONS</td> <td>TKSTD3-GB-1001-01</td> </tr> <tr> <td>18</td> <td>2</td> <td>FAN STACK VELOCITY RECOVERY, FRP w/ ACCESS DOOR &amp; SS HARDWARE</td> <td>TKSTD3-FS-6001-01</td> </tr> <tr> <td>19</td> <td>2</td> <td>3' x 4' ACCESS DOOR</td> <td>TKSTD4-AD-7001-01</td> </tr> <tr> <td>20</td> <td>2</td> <td>PUMP PIT COVER ASSEMBLY w/ REMOVABLE STRAINER</td> <td>TKSTD4-PA-1003-01</td> </tr> <tr> <td>21</td> <td>2</td> <td>PUMP PIT COVER ASSEMBLY w/ REMOVABLE STRAINER</td> <td>TKSTD4-PA-1002-01</td> </tr> <tr> <td>22</td> <td>2</td> <td>VALVE, FLOAT, WATER MAKE-UP, 2" FPT INLET</td> <td>TKSTD3-FV-5001-01</td> </tr> <tr> <td>23</td> <td>2</td> <td>ACCESS LADDER</td> <td>TKSTD4-LD-6001-01</td> </tr> <tr> <td>24</td> <td>1</td> <td>ACCESS CATWALK</td> <td>TKSTD4-CW-6001-01</td> </tr> <tr> <td>25</td> <td>1</td> <td>ACCESS CATWALK</td> <td>TKSTD4-CW-6002-01</td> </tr> <tr> <td>26</td> <td>1</td> <td>ACCESS DECK HANDRAILS</td> <td>TKSTD2-HR-6002-01</td> </tr> <tr> <td>27</td> <td>1</td> <td>DRIFT ELIMINATOR ASSEMBLY, PVC w/SS SUPPORT</td> <td>TKSTD4-DE-7001-01</td> </tr> <tr> <td>28</td> <td>2</td> <td>Basin Heater, Steam Sparger</td> <td>TKSTD4-HT-7001-01</td> </tr>

06018  
 CIE: ETHANOL  
 Canton, Illinois  
 03.27.07  
 File: 17.1 ET420  
 ET430

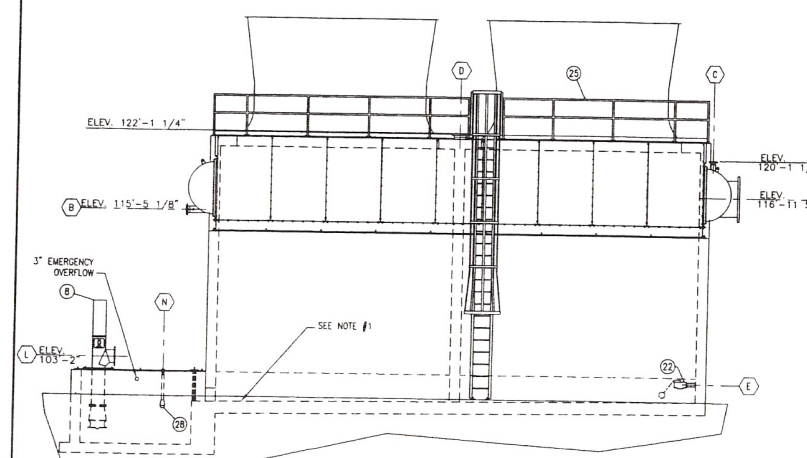

NOZZ. QTY.	SIZE	TYPE & RATING	PURPOSE
N	2	2" NPT	STEAM INLET
M	2	6" ASA/125#	MISCELLANEOUS CONNECTIONS DISCHARGE
L	2	12" ASA/125#	MISCELLANEOUS CONNECTIONS DISCHARGE
P	2	1.5" RFSO/150#	SPRAY PUMP CONNECTIONS Y-ENT
K	1	2" RFSO/150#	WATER MAKE UP
J	1	6" LAP JOINT/150#	SPRAY WATER INLET
H	1	2" LAP JOINT/150#	NCG OUTLET
G	1	6" LAP JOINT/150#	CONDENSATE OUTLET
F	1	14" LAP JOINT/150#	VAPOR INLET
E	1	2" RFSO/150#	BUNDLE ASSEMBLY NOZZLE SCHEDULE (REGEN ET-4301) WATER MAKE UP
D	2	10" LAP JOINT/150#	SPRAY WATER INLET
C	2	4" LAP JOINT/150#	NCG OUTLET
B	2	6" LAP JOINT/150#	CONDENSATE OUTLET
A	2	30" LAP JOINT/150#	VAPOR INLET

- NOTES
- 1) BASIN FLOOR TO FITCH 1/8"/FT TOWARDS PUMP PIT
  - 2) REFER TO CONCRETE BASIN DWG. No. 6018-SC-4302 THRU 4306 FOR ADDITIONAL DETAILS.
  - 3) FLANGE BOLTING TO STRADDLE NATURAL CENTERLINE.
  - 4) INSTALLATION OF COMPONENTS & INTERCONNECTING PIPING SHALL BE BY OTHERS. REFER TO PFD, P&ID AND INSTRUCTION MANUAL FOR ADDITIONAL DETAILS.

ISSUED FOR CONSTRUCTION

**CONFIDENTIAL**

DO NOT SCALE THIS DRAWING

**THERMAL KINETICS**  
 Engineering, PLLC & Systems, LLC  
 Evaporation/Distillation/Chemical Reaction/Process Design & Energy Conservation  
 667 Tift Street Buffalo, NY 14220

LPSI/CENTRAL ILLINOIS  
 CANTON, IL  
 ITEM ET-4204/ET-4301  
 TK MODEL 92/45-480-2/1-2F168

0	ISSUED FOR CONSTRUCTION	03/20/07	NCT	SCL	-
REV	REVISION	DATE	DESIGN	CHK	APP


SIZE: 73338  
 SCALE: 3/16" = 1'-0"  
 DRAWN BY: JC  
 CHECKED BY: SCL  
 DATE: 06/30/06  
 DATE: 08/30/06

THIS DRAWING IS DESIGN AND DETAIL. IT IS THE PROPERTY OF THERMAL KINETICS AND SHALL NOT BE USED FOR ANY PURPOSE OTHER THAN THAT FOR WHICH IT IS SPECIFICALLY FURNISHED. ALL RIGHTS OF DESIGN AND INVENTION ARE RESERVED. COPYRIGHT 2006


8/16/11  
 TK-0001  
 0

D-SIZE (24x36)

WHAT IS THIS FOR?  
 DWG. 73338-TK-0001 REA  
 SHOWS CORRECT ORIENTATIONS (I HOPE)  
*me*

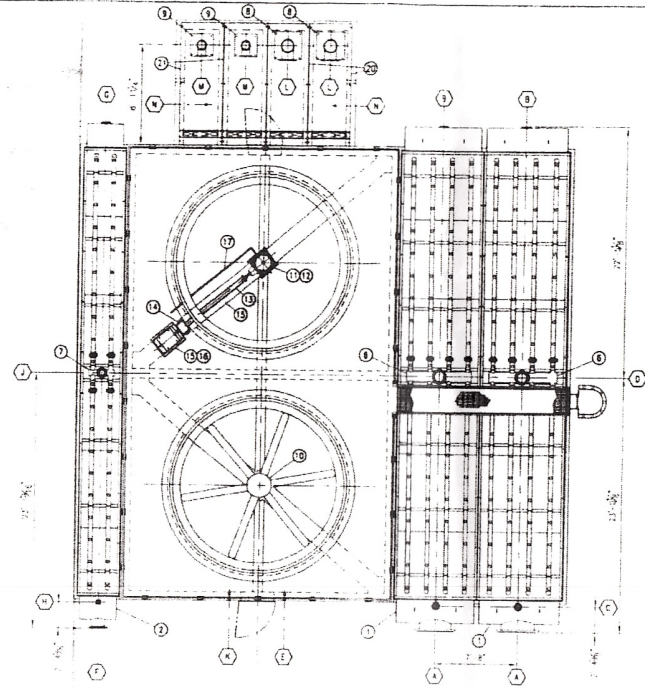

TUBE BUNDLE CONSTRUCTION DATA		PERFORMANCE DATA		BILL OF MATERIAL	


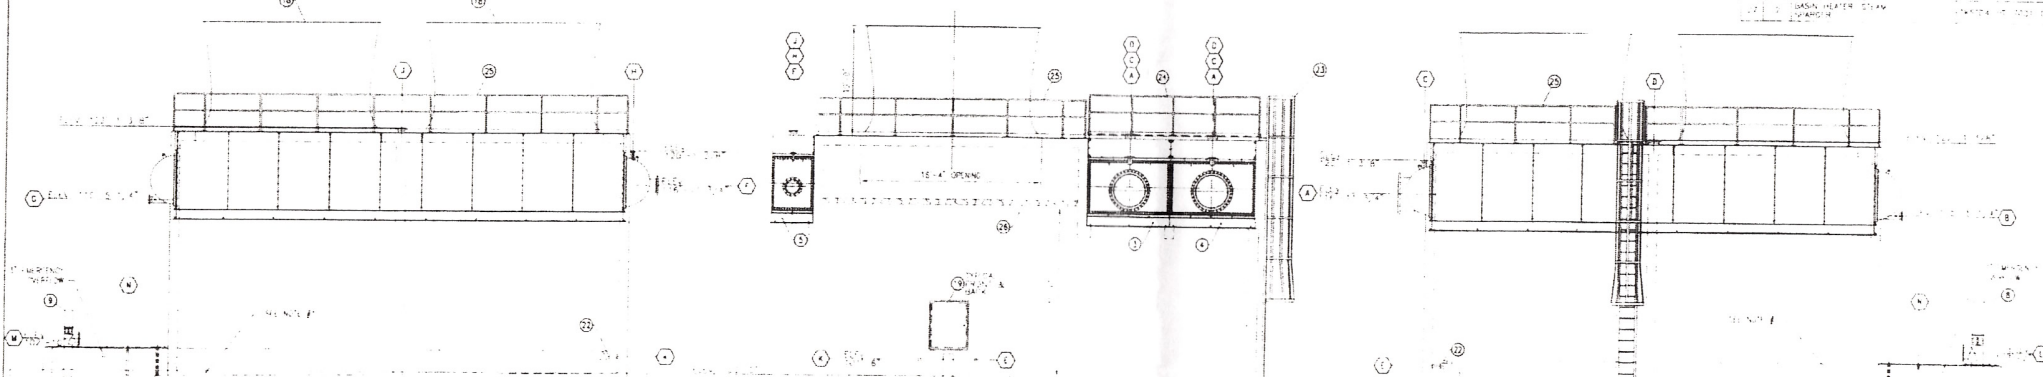

PRELIMINARY  
 NOT FOR CONSTRUCTION

**THERMAL KINETICS**  
 Engineering, Piping & Systems, Inc.  
 567 Tift Street  
 Buffalo, NY 14220

CONFIDENTIAL

06018  
 CIE: ETHANOL  
 Canton, Illinois  
 RECEIVED SEP 01 2006

17.1  
 File: ET-4204/  
 ET-4301  
 0180002056

