



ORIENTATION
VIEWED FROM LEFT END

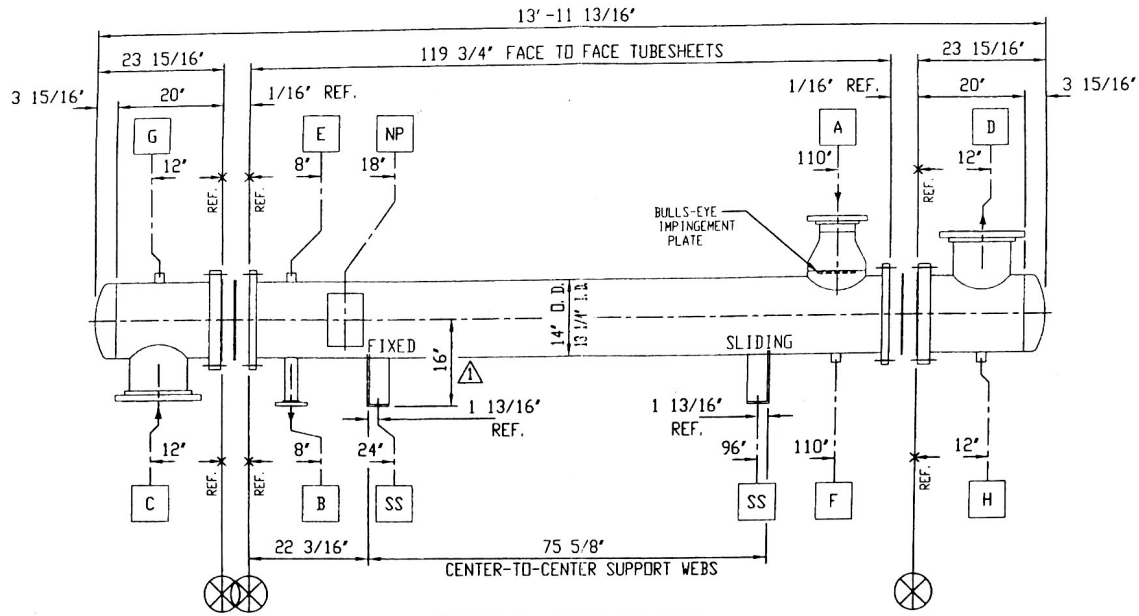

GENERAL ARRANGEMENT
NOT A TRUE ORIENTATION

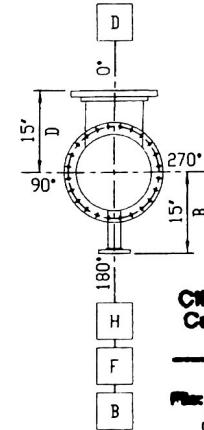

ORIENTATION
VIEWED FROM RIGHT END

06018
CIE: ETHANOL
Canton, Illinois
04.17.07
17.1.19.501
018002002

FOR FURTHER INFORMATION PLEASE CONTACT:
PROTHERM CORPORATION www.protherncorp.com
11108 SOUTH TOWNE SQUARE phone: 314-894-6720
ST. LOUIS, MO 63123 fax: 314-892-0107
PROTHERM FILE NO.: 206224

CONNECTION SCHEDULE				
MARK	SIZE	RATING	TYPE	SERVICE
A	6"	150	RFSO	SHELLSIDE - INLET
B	2"	150	RFSO	SHELLSIDE - OUTLET
C	10"	150	LJFX	TUBESIDE - INLET
D	10"	150	LJFX	TUBESIDE - OUTLET
E	3/4"	6000	FC	VENT
F	3/4"	6000	FC	DRAIN
G	3/4"	6000	FC	VENT
H	3/4"	6000	FC	DRAIN

GENERAL NOTES
1) ALL BOLT HOLES TO STRADDLE NATURAL CENTERLINES.
2) ALL NOZZLES TO HAVE PROTECTIVE COVERS FOR SHIPMENT.
3) ALL THREADED OPENINGS FURNISHED WITH PLUGS.

MATERIALS:	SHELL SIDE	TUBE SIDE
TUBES (145) 3/4" O.D. x 16BWG (0.065) AVG, SA-249-TP316 WLD		
TUBESHEET	SA-240-316	SA-240-316
SHELL	SA-106-B SMLS	SA-240-316
BODY FLANGE		SA-516-70*
HEAD		SA-240-316
NOZZLE NECK	SA-106-B SMLS	SA-312-TP316 WLD
NOZZLE FLANGE	SA-105	SA-105*
BOLTING		SA-193-B7/SA-194-2H
GASKETS		316 S.S. SPRL-WND, NONASB FILL

* = WITH 316 S/S FACING OR OVERLAY

CERTIFIED

AY 1/5/07

	DESIGN DATA			SHELL SIDE		TUBE SIDE	
	DESIGN PRESSURE - INTERNAL	150 PSI		150 PSI	125 PSI		
DESIGN PRESSURE - EXTERNAL	FV		FV	FV			
DESIGN TEMPERATURE	350°F		350°F	350°F			
HYDR TEST PRESSURE	195 PSI		195 PSI	163 PSI			
CORROSION ALLOWANCE	0.0625"		0.0625"	0.0"			
RADIOGRAPH	NONE		NONE	NONE			
STRESS RELIEF	NONE		NONE	NONE			
NO. OF PASSES	1		1	1			
MIN. DESIGN METAL TEMP	-20°F AT 150 PSI		-20°F AT 150 PSI	-20°F AT 125 PSI			
TUBE SURFACE (EXTERNAL)	285 SQ. FT.						
APPROX. WEIGHT EACH	EMPTY	FULL WATER	BUNDLE				
	1979 LBS.	3170 LBS.	904 LBS.				
DESIGN & CONSTRUCTION IN ACCORDANCE WITH: ASME SECTION VIII, DIV. 1 STAMPED 2004 ED 'A' 05 'U' T. E. M. A. CLASS							
NO.	DATE	DESCRIPTION	BY	CHK			
1-5		REVISED SADDLE PROJECTION PER CUSTOMER	D. L. L.				

CUSTOMER: CENTRAL ILLINOIS ENERGY / LURGI
ONE UNITS REQUIRED
TAG: H. T. S. NO. 12910
ITEM NO.: ET-9501
PO NO.: 70738
DIMENSIONAL OUTLINE
CIP HEATER
SIZE: 13 - 120 TYPE: BEM

HEAT TRANSFER SYSTEMS, INC
DESIGNER & MANUFACTURER
ST. LOUIS, MO 63111-3655
C: 12910. HEX

- △ SURFACE PREP
1) COMMERCIAL BLAST CLEAN, CARBON STEEL (SSPC-SP-6)
PAINT SPEC
1) PRIME WITH ONE (1) COAT INTERNATIONAL INTERZINC 22
INORGANIC ZINC-RICH SILICATE, COLOR: GREENISH-GRAY
(2-3 MILS DFT)

DR. BY: D. L. L.
DATE: 11-22-2006
HTS 12910
DWG. NO.
REV

1777



		150	350
		125	350
70738		-20	150
		-20	125
ET-9501			
12910	2007	14.7	350
		14.7	350

08018
 CIE: ETHANOL
 Canton, Illinois
04.17.07
 File: 17.1 ET9501
 0180020019

FIELD FILE

FORM U-1 MANUFACTURER'S DATA REPORT FOR PRESSURE VESSELS
As Required by the Provisions of the ASME Code Rules, Section VIII, Division 1

08013
CIE: ETHANOL
Carbon, Illinois

1. Manufactured and certified by HEAT TRANSFER SYSTEMS, INC., 8100 POLK, MO. 63111 (Name and address of Manufacturer) 04.17.07

2. Manufactured for PROTHERM CORPORATION, 11108 SOUTH TOWNE SQUARE, ST. LOUIS, MO. 63123 (Name and address of Purchaser) 17.1 51-9501

3. Location of installation UNKNOWN (Name and address) 018 0020020

4. Type HORIZ. HEAT EXCHANGER 12910 N/A B-012910-01 1777 2007
(Horiz., vert., or sphere) (Tank, separator, jkt. vessel, heat exch., etc.) (Mfg's serial No.) (CRN) (Drawing No.) (Nat'l Bd. No.) (Year Built)

5 ASME Code, Section VIII, Div. 1 2004 Ad / A 2005 N/A N/A
(Edition and Addenda (date)) (Code Case No.) (Special Service per UG-120(d))

Items 6 - 11 incl. to be completed for single wall vessels, jackets of jacketed vessels, shell of heat exchangers, or chamber of multi chamber vessels.

6. Shell (a) No. of course(s): 1 (b) Overall length (ft & in.): 9' - 9"

No.	Course(s)		Material Spec./Grade or Type	Thickness		Type	Long Joint (Cat A)			Circum Joint (Cat A B & C)			Heat Treatment		
	Diameter, in.	Length (ft & in.)		Nom.	Corr.		Full	Spot	None	Eff	Type	Full	Spot	None	Eff
1	14"	9' - 9"	SA-106-B SML	0.375"	0.0625"	S	NONE		85%	I	NONE		70%		

7. Heads: (a) _____ (b) _____
(Mat'l Spec. No., Grade or Type) H.T. - Time & Temp (Mat'l Spec. No., Grade or Type) H.T. - Time & Temp

	Location (Top, Bottom, Ends)	Thickness		Radius		Elliptical Ratio	Conical Apex Angle	Hemispherical Radius	Flat Diameter	Side to Pressure		Category A				
		Min.	Corr.	Crown	Knuckle					Convex	Concave	Type	Full	Spot	None	Eff.
(a)																
(b)																

If removable, bolts used (describe other fastening) _____
(Mat'l Spec. No., Grade, size, No.)

8. Type of jacket _____ Jacket closure _____
(Describe as ogree & weld, bar, etc.)

If bar, give dimensions _____ If bolted, describe or sketch.

9. MAWP 150 14.7 psi at max. temp. 350 °F Min. design metal temp. -20 °F at 150 psi.
(internal) (external) (internal) (external)

10. Impact test NONE PER UG-20 (f), UCS-66, AND UHA-51 at test temperature of _____ °F
(indicate yes or no and the component(s) impact tested)

11. Hydro., pneu., or comb. test press. HYDRO - 195 PSI Proof test _____

Items 12 and 13 to be completed for tube sections.

12. Tubesheet: SA-240, TP316 18 3/8" 1 1/2" 0" WELDED
Stationary (Mat'l Spec. No.) Dia., in. (subject to press.) Nom. thk., in. Corr. Allow., in. Attachment (welded or bolted)

SA-240, TP316 18 3/8" 1 1/2" 0" WELDED
Floating (Mat'l Spec. No.) Dia., in. Nom. thk., in. Corr. Allow., in. Attachment

13. Tubes: SA-249, TP316 WLD 3/4" 0.065" Avg. 145 STRAIGHT TUBES
Mat'l Spec. No., Grade or Type O.D., in. Nom. thk., in. or gauge Number Type (Straight or U)

Items 14 - 18 incl. to be completed for inner chambers of jacketed vessels or channels of heat exchangers.

14. Shell (a) No. of course(s): 2 (b) Overall length (ft & in.): 3' - 4 1/4"

No.	Course(s)		Material Spec./Grade or Type	Thickness		Type	Long Joint (Cat A)			Circum Joint (Cat A B & C)			Heat Treatment		
	Diameter, in.	Length (ft & in.)		Nom.	Corr.		Full	Spot	None	Eff	Type	Full	Spot	None	Eff
2	14"	1' - 8 1/8"	SA-240, TP316	0.1875"	0"	I	NONE		70%	I	NONE		70%		

15. Heads: (a) SA-240, TP316 (b) SA-240, TP316
(Mat'l Spec. No., Grade or Type) H.T. - Time & Temp (Mat'l Spec. No., Grade or Type) H.T. - Time & Temp

	Location (Top, Bottom, Ends)	Thickness		Radius		Elliptical Ratio	Conical Apex Angle	Hemispherical Radius	Flat Diameter	Side to Pressure		Category A		
		Min.	Corr.	Crown	Knuckle					Convex	Concave	Type	Full	Spot
(a)	L - END	0.125"	0"			2:1			14"		X	S	NONE	70%
(b)	R - END	0.125"	0"			2:1			14"		X	S	NONE	70%

If removable, bolts used (describe other fastening) 5/8" - 48 PCS OF SA-193-B7 STUDS AND 5/8" - 96 PCS OF SA-194-2H NUTS
(Mat'l Spec. No., Grade, Size, No.)