


PACKAGED UNIT

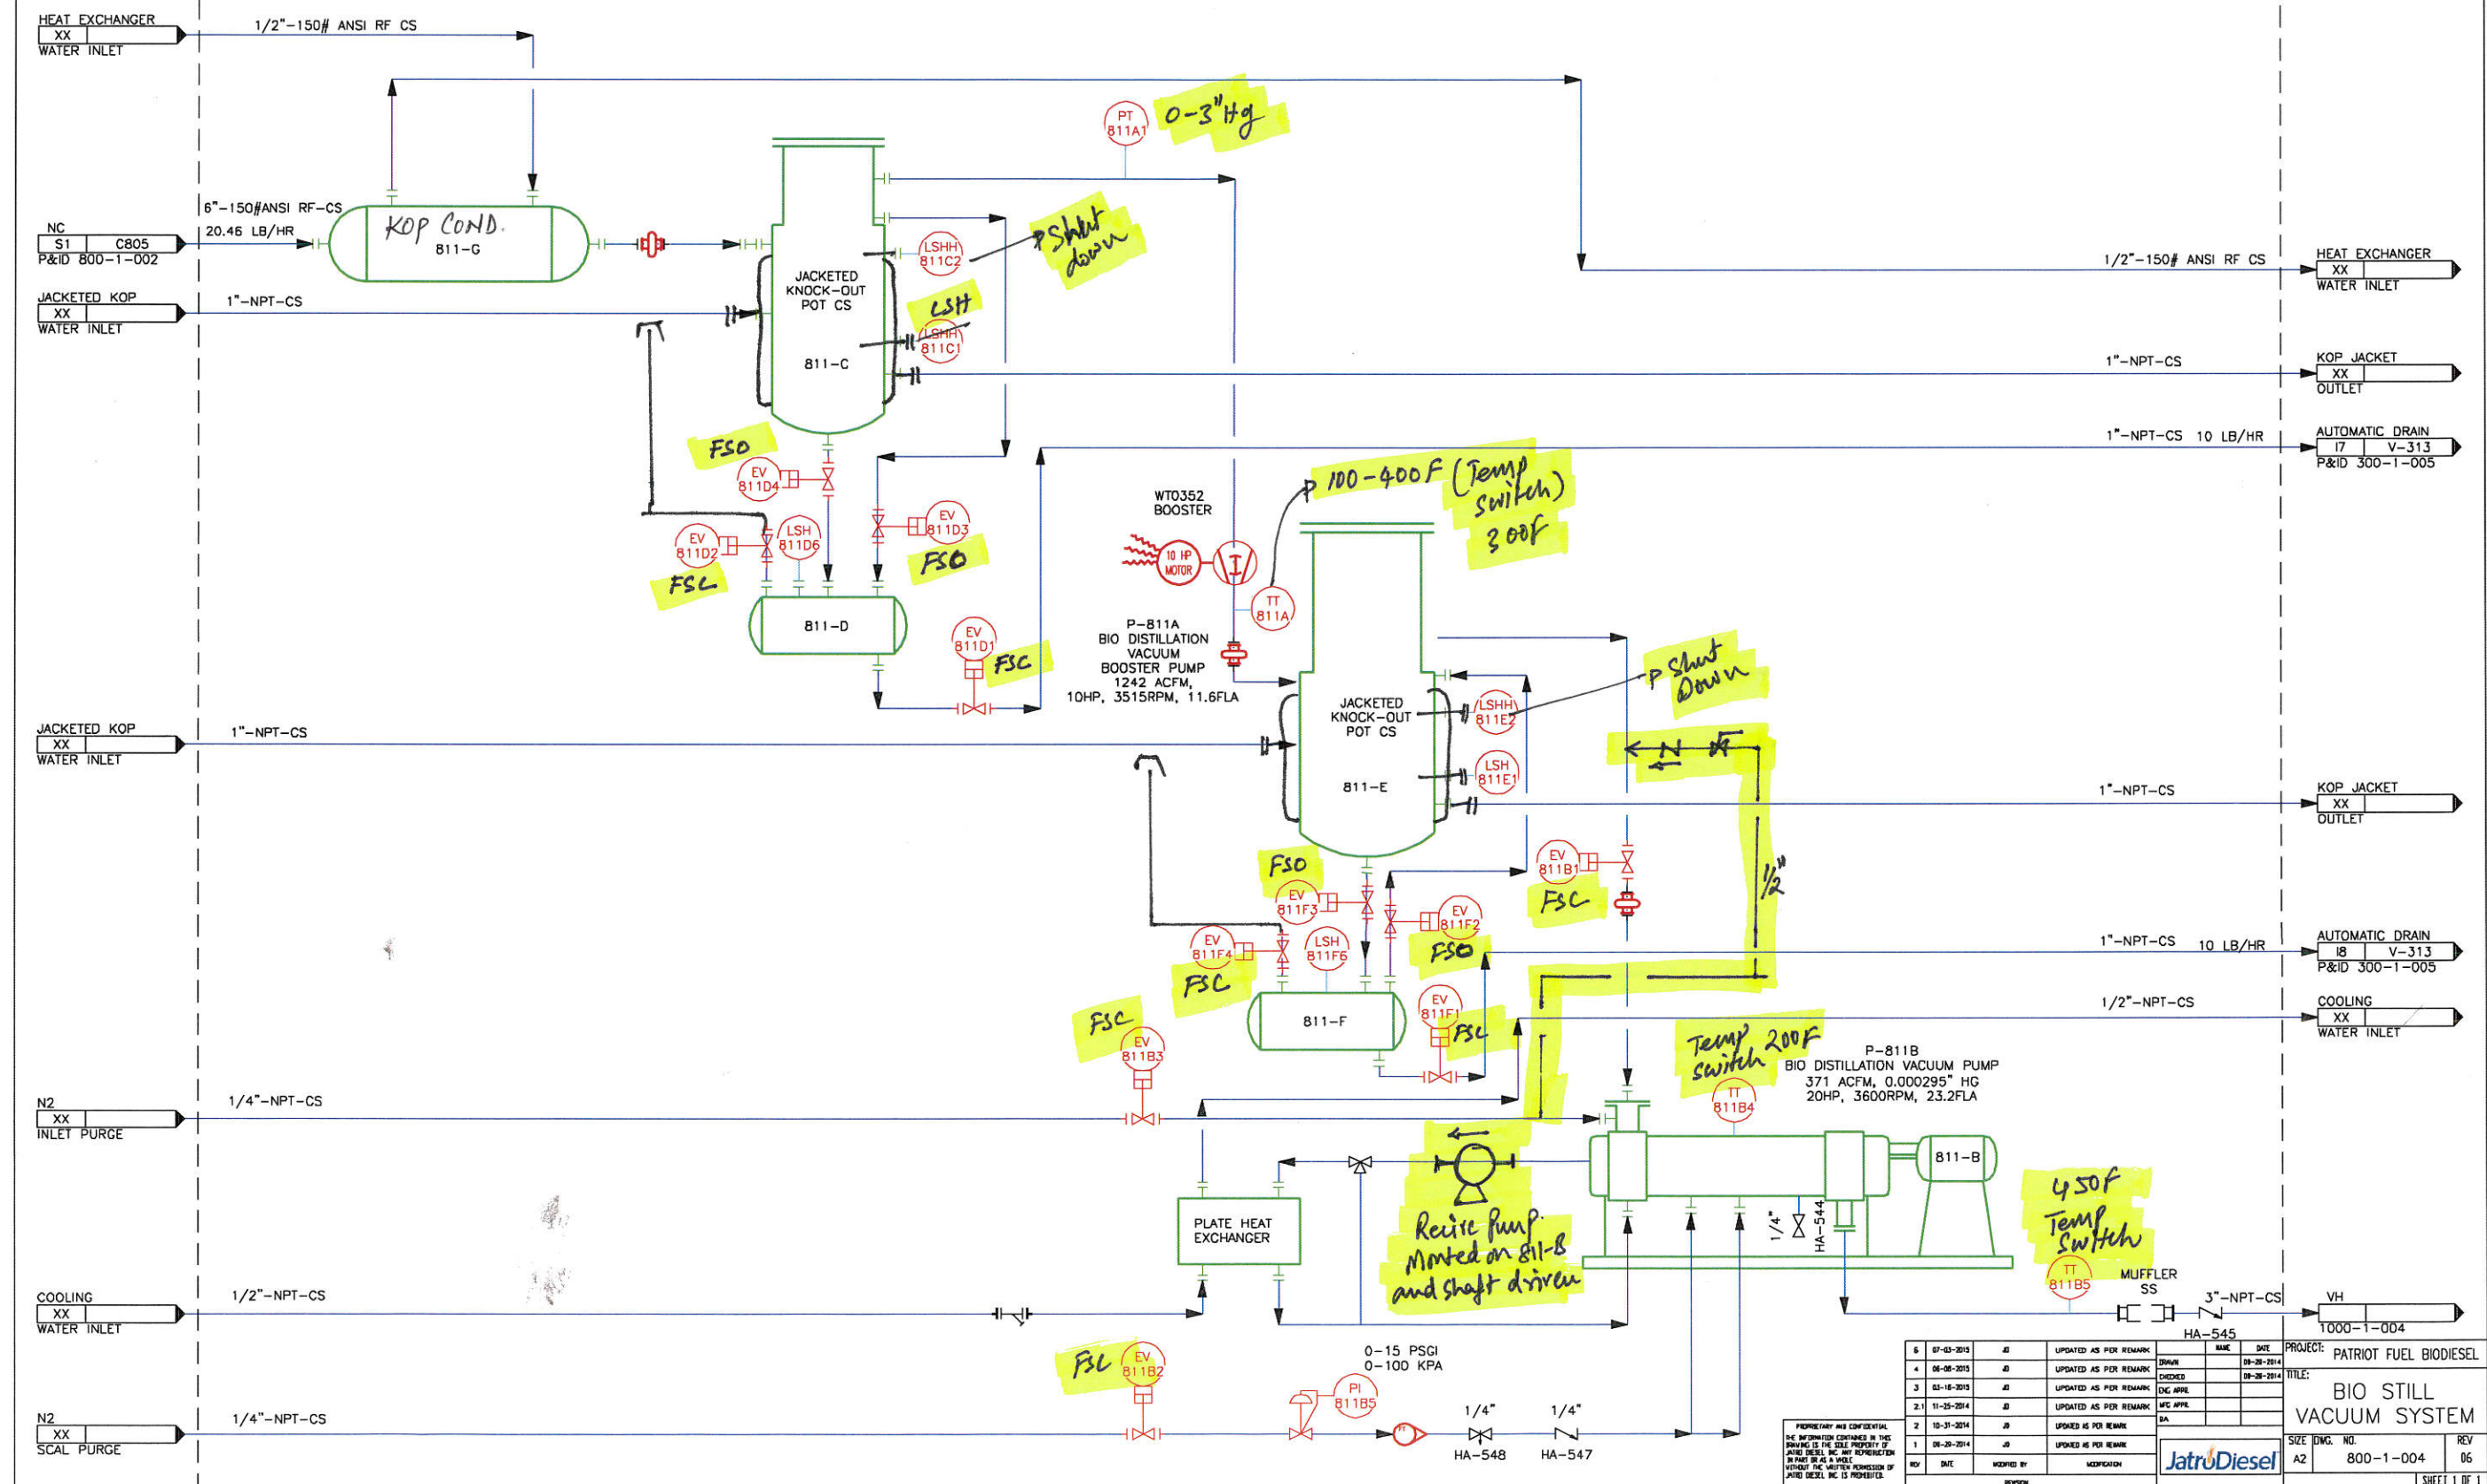

PROPRIETARY AND CONFIDENTIAL
THE INFORMATION CONTAINED IN THIS
DRAWING IS THE SOLE PROPERTY OF
JATRO DIESEL, INC. ANY REPRODUCTION
IN PART OR AS A WHOLE
WITHOUT THE WRITTEN PERMISSION OF
JATRO DIESEL, INC. IS PROHIBITED.

REV	DATE	MODIFIED BY	MODIFICATION	REVISION
6	07-03-2013	JL	UPDATED AS PER REMARK	
4	06-05-2013	JL	UPDATED AS PER REMARK	
3	03-16-2013	JL	UPDATED AS PER REMARK	
2.1	11-25-2014	JL	UPDATED AS PER REMARK	
2	10-31-2014	JL	UPDATED AS PER REMARK	
1	08-20-2014	JL	UPDATED AS PER REMARK	

NAME	DATE
DRAWN	08-28-2014
CHECKED	08-28-2014
ENG. APPR.	
MFG. APPR.	
QA	

PROJECT:	PATRIOT FUEL BIODIESEL
TITLE:	BIO STILL VACUUM SYSTEM
SIZE	DWG. NO.
A2	800-1-004
REV	06
SHEET 1 OF 1	