PRELIMINARY DRAWING
FOR APPROVAL ONLY

Precision Tank & Equipment Company, Inc.


Add 3rd saddle at center of tank (RH)

Signature

Date 11/4/05

Your order will not be futher processed without signing and dating this drawing. Please mark any changes and return. Thank You.

PARTS LIST			
ITEM	QTY	NUMBER	DESCRIPTION
1	2		5/16" X 144" FLG FLAT HEADS
2	5		1/4" X 72" X 452" SHELL
3	1		1/4" X 60" X 452" SHELL
4			
5	3		1" M/S HC.
6	1		10" 244-A FLG EMERG VENT
7	1		6" 150# FLG NOZZLE W/ STUB
8	1		24" STD BOLTED MANHOLE W/ STD GASK
9	6		4" 150# FLG NOZZLE W/ STUB
10	2		1/4" X 16" X 152" WEAR PLATE
11	2		5/8" X 12" X 149" TOP FLG
12	2		3/4" X 12" X 133" BASE PLATE
13	2		1/4" X 48" X 112" WEB PLATE
14	28		1/2" X 5" X CUT TO LENGTH STIFFENERS
15	2		C6 X 8.2# CHANNEL X 142" HEAD BRACE

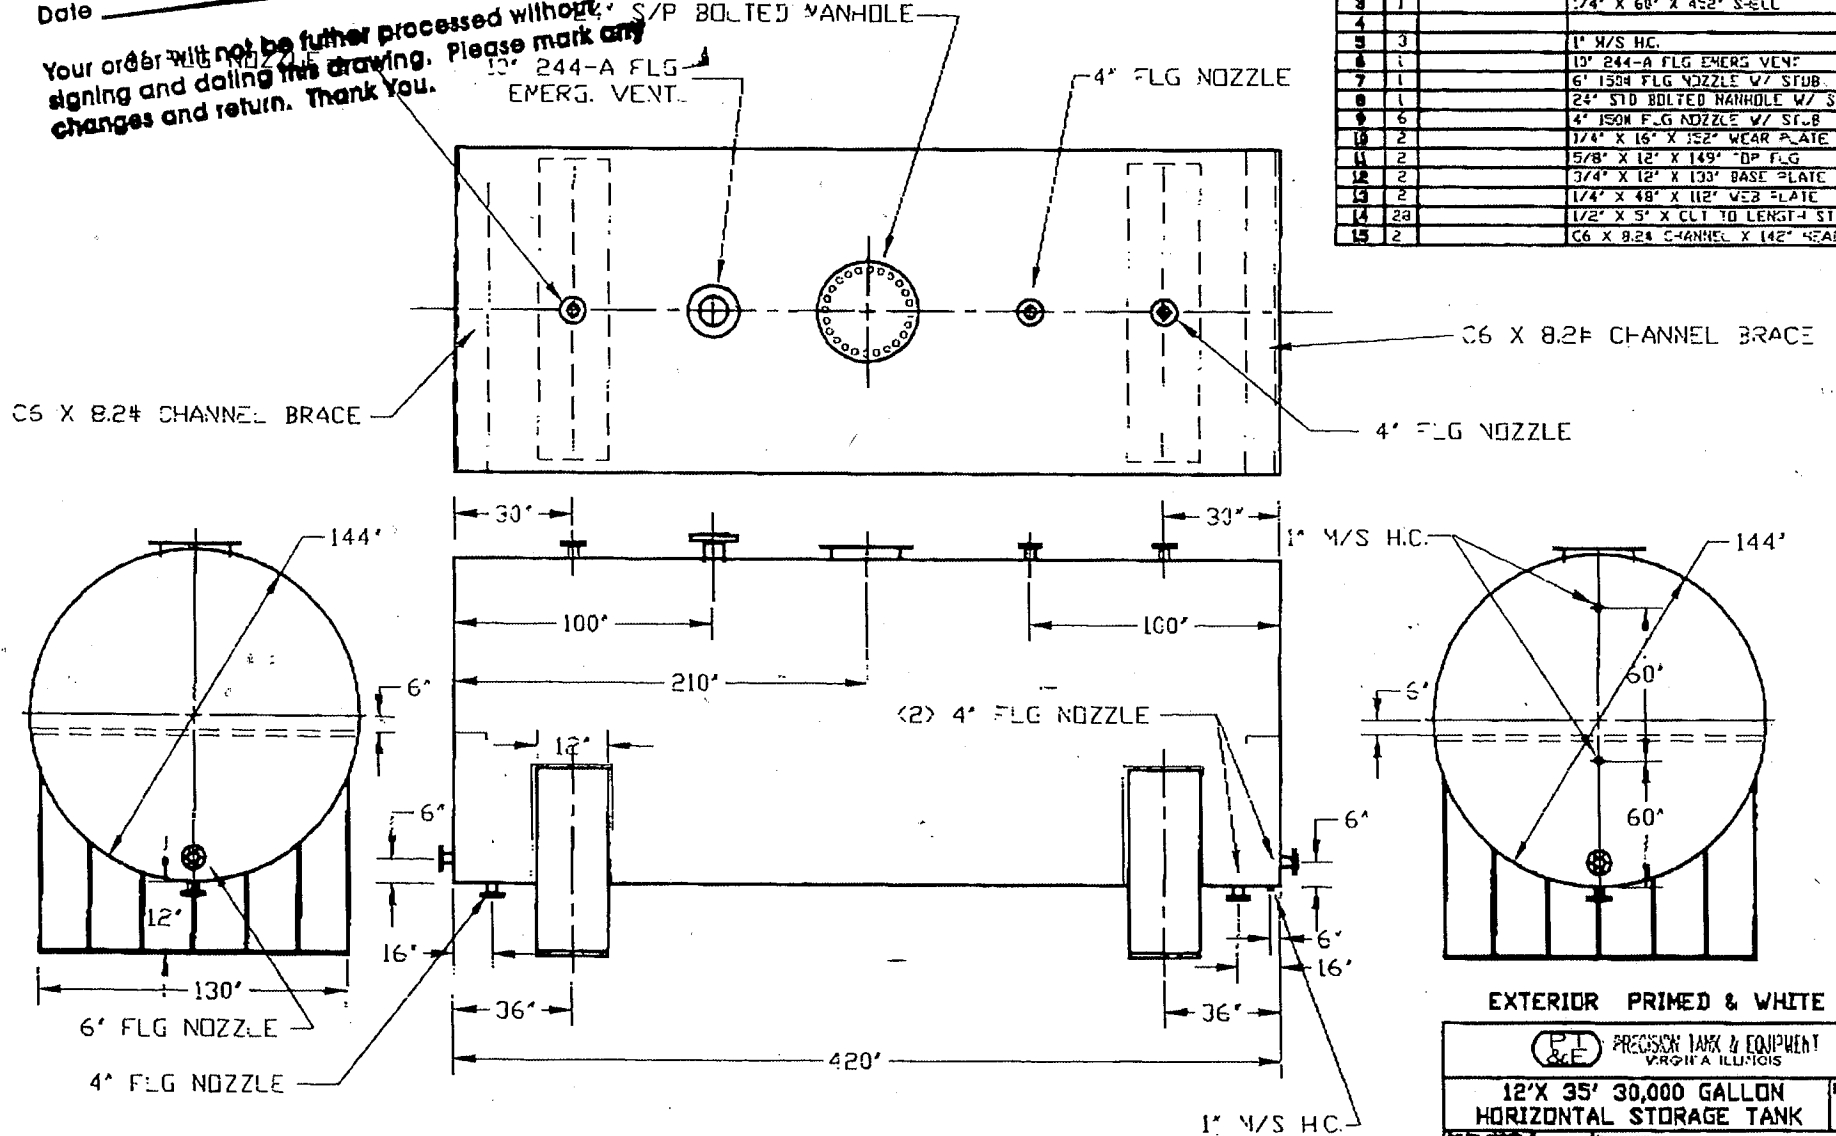

EXTERIOR PRIMED & WHITE

PRECISION TANK & EQUIPMENT VIRGINIA ILLINOIS

12'X 35' 30,000 GALLON HORIZONTAL STORAGE TANK

DATE 10/27/05

SALES ORDER # 155840

PURCHASER MASTER CRAFT STEEL
5295 E WILLOW CT
MONTICELLO IN 47960
574-870-2666

CONFIDENTIAL
THIS DRAWING AND THE INFORMATION CONTAINED THEREIN ARE CONFIDENTIAL AND PROPRIETARY TO PRECISION TANK, INC. THE DRAWING MAY NOT BE COPIED OR DISCLOSED TO OTHERS WITHOUT EXPRESS WRITTEN PERMISSION OF PRECISION TANK