


DESCRIPTION OF COMMENTS MADE ON THE SHOP DRAWING BY THE BUYER DO NOT RELIEVE SUPPLIER FROM COMPLIANCE WITH REQUIREMENTS OF THE DRAWINGS AND SPECIFICATIONS. THIS CHECK IS ONLY FOR GENERAL COMPLIANCE WITH THE DESIGN CONCEPT OF THE PRODUCT AND GENERAL COMPLIANCE WITH THE INFORMATION GIVEN IN THE DRAWING DOCUMENTS. THE SUPPLIER IS RESPONSIBLE FOR LUBRICATING POINTS, COORDINATING ALL QUANTITIES AND DIMENSIONS, SELECTING FABRICATION PROCESSES AND TECHNIQUES OF CONSTRUCTION, SUPERVISING HIS WORK WITH THAT OF ALL OTHER TRADES, AND PERFORMING HIS WORK IN A SAFE AND SATISFACTORY MANNER.

Large, Inc.
MEMPHIS, TN

Date 12/15/06 By [Signature]

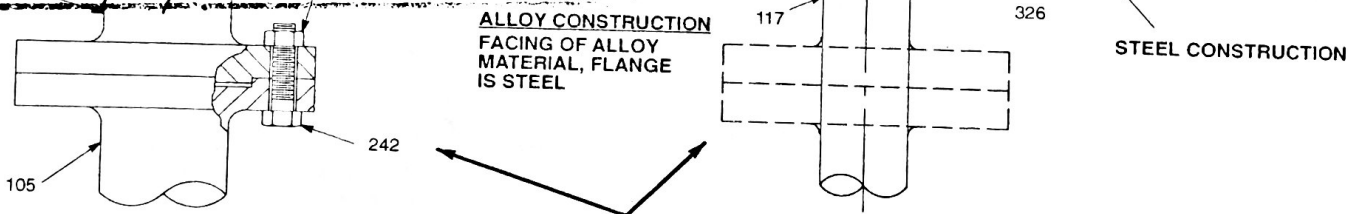

DETAIL "A"
COUPLING CONSTRUCTION
OPTIONAL AT EXTRA COST

WHEN ORDERING PARTS, SPECIFY:
DRAWING NO., PART NAME, ITEM
NO. AND MIXER SERIAL NUMBER

326	LOCATING PIN (4)
323	LOWER PEDESTAL COVER ASSY
244	HEX NUT
242	HEX HEAD CAP SCREW
241	LOCKWASHER
240	HEX HEAD CAP SCREW - NYLOK
238	HEX NUT
237	LOCKWASHER
236	HEX HEAD CAP SCREW
223	LOCKWASHER
222	HEX HEAD CAP SCREW - NYLOK
184	MOTOR PEDESTAL COVER ASSY
129	FLANGE ASSEMBLY
122	LOWER PEDESTAL
117	IMPELLER SHAFT
105	LOWER SHAFT (OPTIONAL)
101	MOTOR

ITEM	PART NAME
------	-----------

08018
CIE: ETHANOL
Canton, Illinois
RECEIVED NOV 01 2006

File: AT-9303
9503
0180014035

ALL EQUIPMENT DESIGN AND APPLICATION DATA SHOWN HEREIN AND RELATED KNOW-HOW IS CONFIDENTIAL AND THE PROPERTY OF THE LIGHTNIN GROUP OF COMPANIES. NO USE OR DISCLOSURE THEREOF MAY BE MADE WITHOUT OUR WRITTEN PERMISSION.

LIGHTNIN[®]
MIXERS AND AERATORS

ASSEMBLY DRAWING

MODEL 500C
CLOSED TANK MIXER
WITH C-FACE MOTOR



CERTIFIED
© LIGHTNIN
2001