




DETAIL BASE PLATE
MATERIAL: 1/2" THK. A36
SCALE: 1 1/2" = 12"

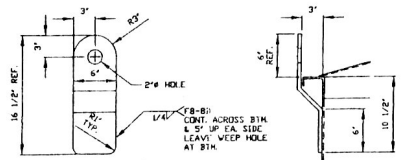


DETAIL LEFT LUG
ONE REQUIRED
TRAFFIC HGR. TO LOCATE
1/2" THK. A240-304 CLUG & REPAD
SCALE: 1 1/2" = 12"

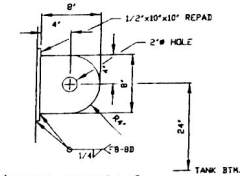


DETAIL TRAILING LUG
ONE REQUIRED
TRAFFIC HGR. TO LOCATE
1/2" THK. A240-304 CLUG & REPAD
SCALE: 1 1/2" = 12"

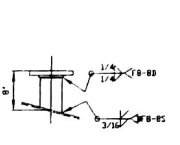


DETAIL NOZ. 'E'
SCALE: 1 = 12
CUT 4" SCH 40 PIPE @ 8 5/8" LG

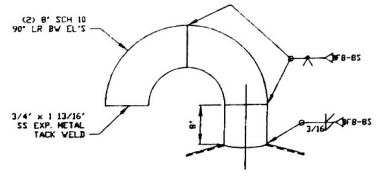


DETAIL NOZ. 'F'
SCALE: 1 = 12
CUT 6" SCH 40 PIPE @ 8 5/16" LG

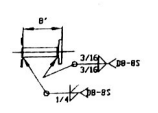


DETAIL NOZ. 'B & C'
SCALE: 1 = 12
CUT (2) 1 1/2" SCH 40 PIPE @ 8" LG. EA.

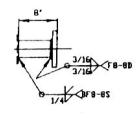


DETAIL NOZ. 'D'
SCALE: 1 = 12
CUT 3" SCH 40 PIPE @ 8" LG

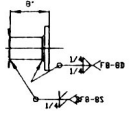

DETAIL NOZ. 'G'
SCALE: 1 = 12
CUT 4" SCH 40 PIPE @ 8" LG

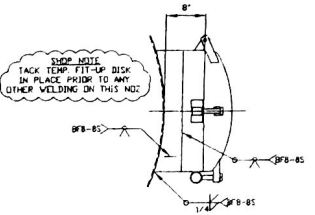

DETAIL NOZ. 'K'
SCALE: 1 = 12

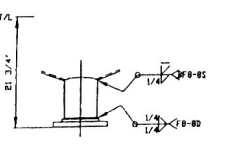

DETAIL NOZ. 'A'
SCALE: 1 = 12
CUT 6" SCH 40 PIPE @ 9" LG

08018
CIE: ETHANOL
Canton, Illinois
09.04.07
171-159504
018002006

CERTIFIED PRINT CHECK
CHK. BY: *Mark Andrew*
DATE: 9-6-07
LURGI, INC.

CERTIFIED AS BUILT DRAWING
KENNEDY TANK & MFG. CO., INC.
INDIANAPOLIS, INDIANA
BY: *Mark Andrew* DATE: 3/29/07

MAX ANDREW
MILWAUKEE
BY DESIGN
DATE: 11-30-04

MATERIALS	
ROOF:	5/16" THK. A240-304
SHELL:	1/4" THK. A240-304
BOTTOM:	5/16" THK. A240-304
FLANGES:	A192-304
REPADS:	N/A
NOZZLE NECKS (PIPE):	A312-304
NOZZLE NECKS (PLATE):	A240-304
WELD FITTINGS:	A403-304
VESSEL SUPPORT:	A36
STRUCTURAL:	A479-304, A36
BOLTS:	A307 ZINC PLATED
NUTS:	A307 ZINC PLATED
GASKETS:	1/8" VITON

DESIGN CONDITIONS	
DESIGN PRESSURE (IN. W.C.):	20 INT./5 EXT.
AT DESIGN TEMP. (°F):	150
OPERATING PRESSURE (IN. W.C.):	ATM
AT OPERATING TEMP. (°F):	80
CORROSION ALLOWANCE:	1/8"
LABEL:	KTAM (PER ASME VIII & API 650 WHERE APPL.)
STRESS RELIEVE:	NONE
RADIOGRAPH:	NONE
JOINT EFF.:	.70
HYDRO TEST:	N/A
AIR TEST:	2-3 PSIG
CUSTOMER INSPECTION:	YES
MTR COPIES:	1 KTAM, 1 CUSTOMER
NAMEPLATE FACSIMILE:	YES
SEISMIC & WIND DESIGN:	PER IBC 2003

WEIGHTS & CAPACITIES	
EST. CAPACITY, GALS.	
PER FT. STRAIGHT SIDE:	229.5
TOTAL (TD TO TOP ANGLE):	2,390
SP. GR. OF CONTENTS:	1.05
EST. WT. OF CONTENTS (LBS):	20,842
EST. WT. OF VESSEL (LBS):	4,000
TOTAL EST. WT. (LBS):	24,842

FITTING SCHEDULE			
NO.	SIZE	USE (TYPE/THICKNESS)	REMARKS
A	1"	6"/150#/RF/SD/SCH 40	DISCHARGE
B	1"	1/2"/150#/RF/SD/SCH 40	TEMPERATURE
C	1"	1/2"/150#/RF/SD/SCH 40	TEMPERATURE
D	1"	3"/150#/RF/SD/SCH 40	RECYCLE/INLET
E	1"	1/4"/150#/RF/SD/SCH 40	INLET
F	1"	8"/SCH 40 PIPE	LOUSENECK VENT
G	1"	1/4"/150#/RF/SD/SCH 40	OVERFLOW
H	1"	24"/CL75/TT SWINGBOLT	SIDE MANWAY LEVEL
K	1"	3"/150#/RF STUD PAD	LEVEL

NOTES	
1.	BOLT HOLES TO STRADDLE LINE PARALLEL TO 0°/180° AND 90°/270° CENTERLINES.
2.	FABRICATOR SHALL PROVIDE GASKETS, BOLTS, AND HEX NUTS FOR ALL MATING PARTS INCLUDING BLIND FLANGES WHERE NOTED.
3.	✓ INDICATES MACHINE FINISHED SURFACE.
4.	INSULATION SUPPORTS ARE NOT REQUIRED.
5.	FABRICATOR SHALL PROVIDE PROTECTIVE SHIELDS FOR ALL FLANGES AND OPENINGS.
6.	SHOP TOLERANCES DIMENSIONS ± 1/8" NOZZLES ± 1/2 DEGREE
7.	SANDBLAST: INTERNAL: NONE (PREFER WASH) EXTERNAL: SS BRUSH STABILBLAST EXTERNAL CS: SSPC-SP6
8.	LINING: NONE
9.	PAINT: ONE COAT INTERZINC 22 AT 2-3 MILS DFT. (CS ONLY)
10.	RADIUS WELDS & EDGES 1/8" MINIMUM

KENNEDY TANK & MANUFACTURING CO., INC.	
833 EAST SUMNER AVENUE INDIANAPOLIS, INDIANA 46227	
REVISIONS	DESCRIPTION
NO. DATE BY	75" I.D. x 10'-0" S-S ACID WASH TANK
12/01/06 M.L.M.	FOR: LURGI PSI / CIE, INC. CANTON, IL
3/29/07 T.L.P.	
1	ISSUED
2	REVISED
3	REVISED
