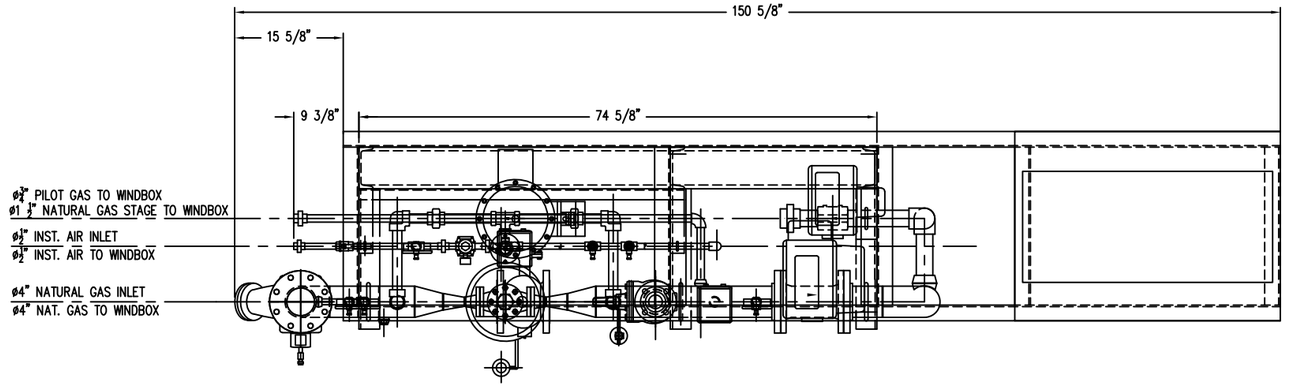

PLAN VIEW

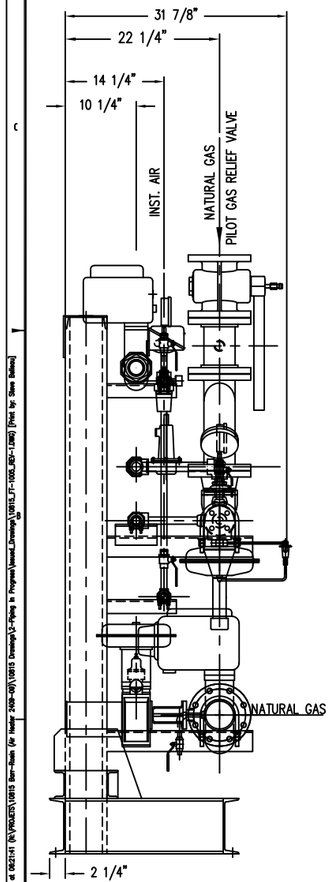

LH SIDE VIEW

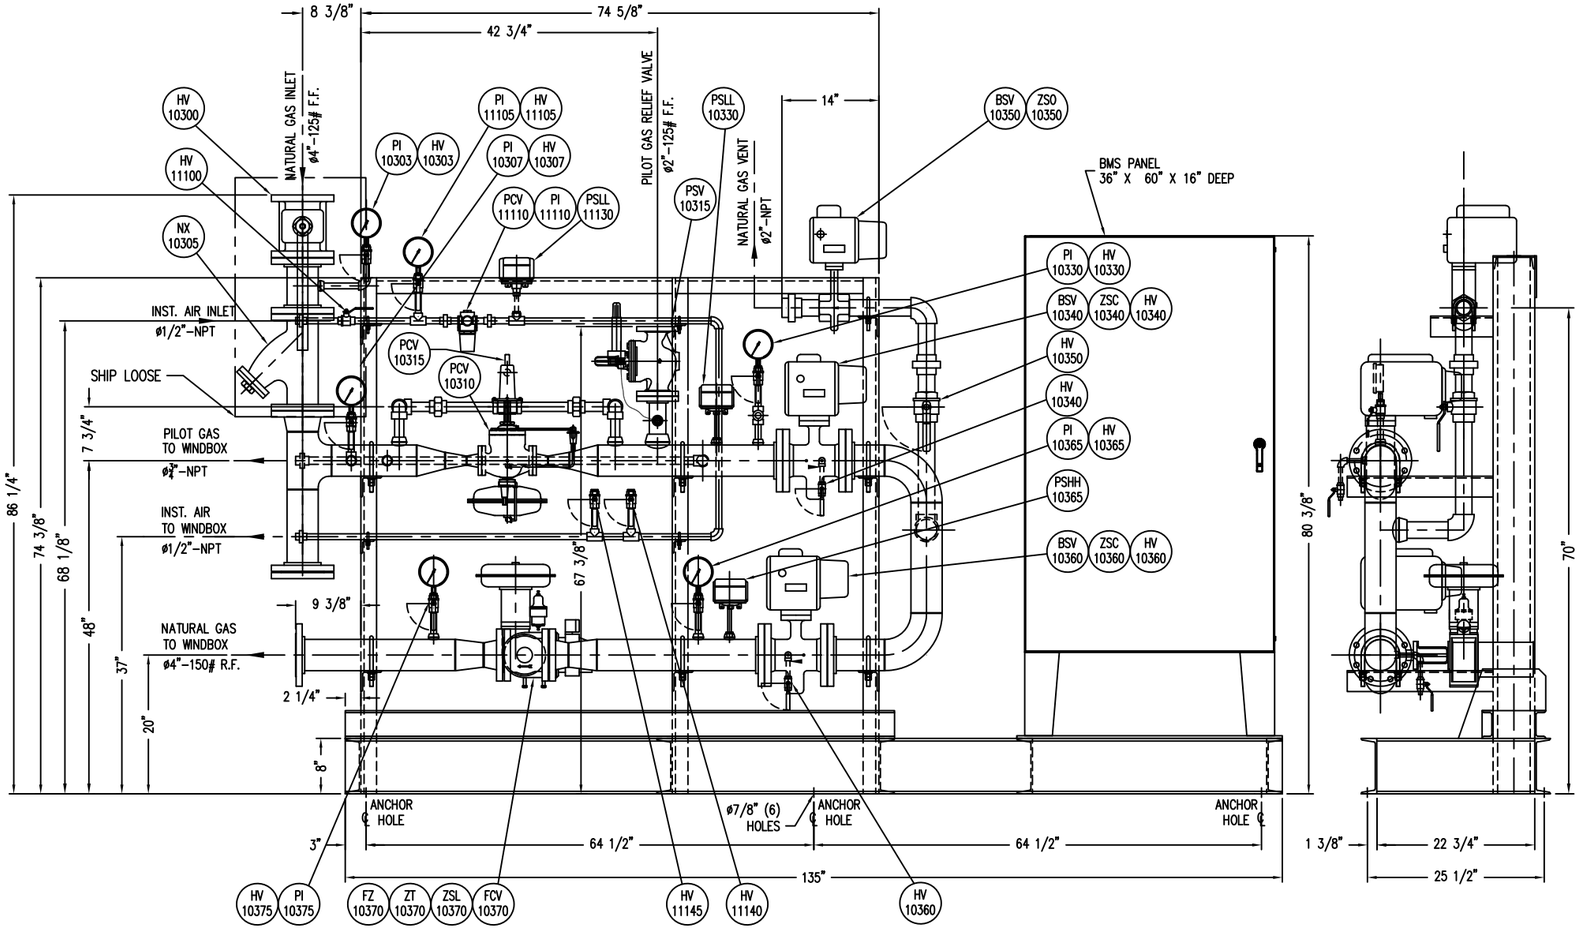

ELEVATION

RH SIDE VIEW
BMS PANEL NOT SHOWN FOR CLARITY

LISTE DE MATÉRIAUX - BILL OF MATERIALS

No	QT	DESCRIPTION	MATÉRIEL MATERIAL	DESSIN No. DRAWING No.	POIDS WEIGHT

REV	DESCRIPTION	DESSINÉ DRAWN	VÉRIF. CHECK.	APPRO.	DATE
3	ISSUED AS BUILT	Y.V.	S.B.	S.B.	07.10.25
2	MAXON MOVED ON WINDBOX ISSUED FOR CONSTRUCTION	Y.V.	S.B.	E.T.	07.05.25
1	ISSUED FOR APPROVAL	Y.T..	E.T.	S.B.	07.03.20

CB NATCOM
8515, Boul. Lafrenaie, St-Léonard (Québec) H1P 2B3, CANADA
Tel.: (514) 326-2571 Fax.: (514) 326-9347

LOGO CLIENT LOGO

TEL QUE CONSTRUIT
AS BUILT

AVIS DE CONFIDENTIALITÉ
Ce dessin et toute l'information contenu est et demeurera la propriété de CB-NATCOM; demeurera confidentielle; ne sera reproduite, copiée ou utilisée directement ou indirectement; et ne sera utilisée en totalité ou en partie sans la connaissance complète et le consentement écrit antérieur de CB-NATCOM.

CONFIDENTIALITY NOTICE
This drawing and all information thereon are and shall remain the property of CB-NATCOM; shall be held confidential;shall not be reproduced,copied or otherwise disposed of directly or indirectly;and shall not be used in whole or in part without the full knowledge and prior written consent of CB-NATCOM.

SCEAU INGÉNIEUR
ENGINEER SEAL

ÉCHELLE SCALE	3/32"=1"	
CONCEPTION DESIGN	Y.T.	07.03.20
DESSINÉ DRAWN	Y.T	07.03.20
VÉRIFIÉ CHECKED	S.B.	07.03.20
APPROUVÉ APPROVED	E.T.	07.03.20

TOLERANCES
SAUF INDICATIONS CONTRAIRES,TOUTES LES DIMENSIONS SONT EN POUCES. UNLESS OTHERWISE SPECIFIED,ALL DIMENSIONS ARE IN INCHES.

.XXXX	TEL QUE NOTÉ/AS NOTED
.XXX	±.005
.XX	±.010
Fract.	±1/8"
Angulaire / Angular	±1°

TITRE - TITLE

CB-NATCOM LOW NOx BURNER
Model No. P-96-G-23-1118
PIPE RACK ARRANGEMENT

PROJET - PROJECT

DELTA T / CORPORATION - BUNGE
BARR ROSIN PROJECT 2409

RÉFÉRENCE CLIENT REFERENCE	BRI-2409	CLIENT:	BARR ROSIN INC.
RÉFÉRENCE CB-NATCOM REFERENCE	DESSIN DRAWING No.	10815-FT-1005	REV. 3

CITY BY CONTRACT: 1

FT-1005 rev. 3 | Print date: 2007 Mar 25 at 08:21:41 (M:\PROJECTS\10815 Barr-Rosin (Air Heater 3000-40)\10815 Drawings\3-Piping to Program\Autocad_Drawings\10815_FT-1005_REV-1.DWG) [Plotted by: Steve Bélanger]

10815_FT-1005_REV-1